

REMEDIAL INVESTIGATION REPORT
OPERABLE UNIT 4: WEST SIDE AQUIFERS
NAS MOFFETT FIELD, CALIFORNIA

VOLUME 3
APPENDIX C

AUGUST 1992

Prepared by:

IT Corporation
312 Directors Drive
Knoxville, Tennessee 37923

Submitted by:

The Hazardous Waste Remedial Actions Program
Martin Marietta Energy Systems, Inc.
Oak Ridge, Tennessee 37831-6501

for:

U.S. Department of Energy
Contract DE-AC05-840R21400

Submitted to:

Department of the Navy
Western Division
Naval Facilities Engineering Command
San Bruno, California 94066-2402

N00296.001452
MOFFETT FIELD
SSIC NO. 5090.3

REMEDIAL INVESTIGATION REPORT
OPERABLE UNIT 4: WEST SIDE AQUIFERS

DATED 01 AUGUST 1992

THIS RECORD CONTAINS MULTIPLE VOLUMES
WHICH HAVE BEEN ENTERED SEPARATELY

VOLUME 1 OF 4 IS FILED AS ADMINISTRATIVE
RECORD NO. N00296.001450

VOLUME 2 OF 4 IS FILED AS ADMINISTRATIVE
RECORD NO. N00296.001451

VOLUME 4 OF 4 IS FILED AS ADMINISTRATIVE
RECORD NO. N00296.001453

Table of Contents

List of Tables	vi
List of Figures	x
Volume 2, Appendix A Contents	xvii
Volume 2, Appendix B Contents	xxi
Volume 3, Appendix C Contents	xxii
Volume 4, Appendix D Contents	xxvii
Volume 4, Appendix E and F Contents	xxviii
List of Acronyms	xxix
Executive Summary	ES-1
1.0 Introduction	1-1
1.1 Approach and Objectives	1-1
1.2 Report Organization	1-1
1.3 Site Description and History	1-2
1.4 Archaeological Sites	1-5
1.5 Operable Unit Definition	1-6
1.6 Possible On-Site Sources	1-6
1.6.1 Site 8 - Waste Oil Transfer Area	1-7
1.6.2 Site 9 - Oil Fuel Farm and Old NEX Gas Station	1-8
1.6.3 Site 10 - Chase Park and Runway Areas	1-10
1.6.4 Site 12 - Fire Fighting Training Area	1-11
1.6.5 Site 14 - Abandoned Tank 19, 20, 57, 67, and 68	1-12
1.6.6 Site 15 - Sump and Oil/Water Separators	1-13
1.6.7 Site 16 - Public Works Steam Cleaning Rack Sump 60	1-14
1.6.8 Site 17 - Public Works Paint Shop Sump 61	1-14
1.6.9 Site 18 - Dry Cleaners' Sump 66	1-14
1.6.10 Site 19 - Leaking Tank 14	1-15
2.0 Study Area Investigations	2-1
2.1 Previous Studies	2-1
2.2 Other Ongoing Investigations	2-5
2.3 Hydrogeological Investigations	2-10
2.3.1 Contaminant Source Investigations	2-14
2.3.1.1 Introduction	2-14
2.3.1.2 On-Site Sources	2-14
2.3.1.3 Off-Site Sources	2-19
2.4 Surface Water and Sediment Investigations	2-22
2.5 Aquifer Testing	2-22
3.0 Physical Characteristics of Moffett Field	3-1
3.1 Surface Features	3-1
3.2 Meteorology	3-1
3.3 Surface Water	3-2

Table of Contents (Continued)

3.3.1	Seawater	3-2
3.3.2	Wetlands	3-2
3.3.3	Fresh Water	3-3
3.4	Geology	3-4
3.4.1	Regional Geology	3-4
3.4.2	Local Geology	3-6
3.4.3	Depositional Environments	3-7
3.4.4	Site-Specific Geology	3-9
3.4.5	Conclusion/Geologic Model	3-11
3.5	Soils and Surface Sediments	3-11
3.6	Hydrogeology	3-13
3.6.1	Regional Hydrogeology	3-13
3.6.2	Local Hydrogeology	3-14
3.6.3	Site Hydrogeology	3-16
3.6.4	Groundwater Hydraulics	3-22
3.6.5	Pumping Test Results	3-24
3.6.6	Hydrogeologic Conclusions	3-28
3.7	Ecology	3-30
4.0	Nature and Extent of Contamination	4-1
4.1	Objectives	4-1
4.1.1	Analytical Data Treatment	4-2
4.1.1.1	Contract Laboratory Program (CLP) Laboratories	4-2
4.1.1.2	Third Party Validation Guidelines	4-4
4.1.1.3	IT Corporation: Phase I and II Remedial Investigations	4-4
4.1.1.4	PRC, Environmental Management, Inc.: Building 29, Area Field Investigation Technical Memorandum (PRC, 1991a)	4-7
4.1.1.5	PRC, Environmental Management, Inc.: Draft Tank and Sump Removal Summary Report (PRC, 1991b)	4-8
4.1.1.6	PRC, Environmental Management, Inc.: Site 9, Area Field Investigation Technical Memorandum (PRC, 1991c)	4-9
4.1.1.7	Earth Sciences Associates (ESA): Assessment of Potential for Public/Private Wells at Moffett Field NAS to Act as Conduits for Inter-Aquifer Cross-Contamination (1986a)	4-9
4.2	Evaluation of OU4 Analytical Data	4-10
4.2.1	OU4 Background	4-10
4.2.1.1	Degradation of Chlorinated Solvents	4-11

Table of Contents (Continued)

4.2.2	4.2.1.2 Identification of Background Wells	4-12
	A1-Aquifer Zone	4-13
	4.2.2.1 Chlorinated Organic Compounds	4-13
	4.2.2.2 Other Organic Compounds	4-19
	4.2.2.3 Inorganic Compounds	4-21
4.2.3	A2-Aquifer Zone	4-24
	4.2.3.1 Chlorinated Organic Compounds	4-24
	4.2.3.2 Other Organic Compounds	4-27
	4.2.3.3 Inorganics	4-28
4.2.4	B2-Aquifer Zone	4-33
	4.2.4.1 Chlorinated Organic Compounds	4-33
	4.2.4.2 Other Organic Compounds	4-34
	4.2.4.3 Inorganics	4-34
4.2.5	B3-Aquifer Zone	4-35
4.2.6	C-Aquifer Zone	4-36
	4.2.6.1 Organic Compounds	4-36
	4.2.6.2 Inorganic Compounds	4-36
4.3	Conclusions	4-36
5.0	Modeling of Flow and Contaminant Transport	5-1
5.1	Contaminant Persistence	5-1
5.2	Contaminant Migration	5-2
	5.2.1 Modeling Objectives	5-3
	5.2.2 Modeling Approach	5-3
	5.2.3 Model Description	5-4
	5.2.4 Conceptual Model: Aquifer Parameter Estimation	5-9
	5.2.5 Flow Model Calibration	5-11
	5.2.6 Flow Model Results	5-12
	5.2.7 Transport Model	5-13
5.3	Summary of Flow and Fate and Transport Modeling	5-16
6.0	Risk Assessment	6-1
6.1	Introduction	6-1
	6.1.1 Overview	6-1
	6.1.2 Site Background	6-2
	6.1.2.1 Sites Encompassed by the Area of OU4	6-5
	6.1.2.2 Potential Off-Site Source Areas	6-9
	6.1.3 Scope of the Baseline Risk Assessment	6-11
	6.1.4 Organization of the Baseline Risk Assessment	6-11
6.2	Identification of Chemicals of Potential Concern	6-12
	6.2.1 Data Collection and Evaluation	6-12
	6.2.1.1 Data Collection	6-13
	6.2.1.2 Data Evaluation and Validation	6-13

Table of Contents (Continued)

6.2.2	General Selection Process for Chemicals of Potential Concern	6-15
6.2.3	Selection of Chemicals of Potential Concern	6-17
6.2.3.1	Chemicals of Potential Concern in A1-Aquifer Zone	6-17
6.2.3.2	Chemicals of Potential Concern in A2-Aquifer Zone	6-18
6.2.3.3	Chemicals of Potential Concern in B2-Aquifer Zone	6-19
6.2.3.4	Chemicals of Potential Concern in B3-Aquifer Zone	6-19
6.2.3.5	Chemicals of Potential Concern in C-Aquifer Zone	6-20
6.2.4	Summary of Chemicals of Potential Concern	6-20
6.2.5	Uncertainties	6-20
6.3	Exposure Assessment	6-21
6.3.1	Characterization of Exposure Setting	6-22
6.3.1.1	Physical Setting	6-22
6.3.1.2	Potentially Exposed Populations	6-33
6.3.2	Identification of Potential Exposure Pathways	6-35
6.3.3	Estimation of Exposure	6-37
6.3.3.1	Exposure Models	6-38
6.3.3.2	Exposure Parameters	6-39
6.3.4	Results	6-40
6.3.5	Uncertainties	6-41
6.4	Toxicity Assessment	6-41
6.4.1	Lead	6-43
6.4.2	Copper	6-44
6.4.3	2-Methylnaphthalene	6-44
6.4.4	JP-5	6-44
6.4.5	Uncertainties	6-44
6.5	Risk Characterization	6-45
6.5.1	Known or Suspected Carcinogens	6-46
6.5.1.1	Selection of a Reasonable Probability of Risk of Cancer	6-46
6.5.1.2	Estimation of Carcinogenic Risk	6-47
6.5.2	Noncarcinogens	6-50
6.5.3	Uncertainties	6-52
6.6	Summary and Conclusions	6-52
6.7	Environmental Assessment	6-55
6.7.1	Receptor Assessment	6-56
6.7.1.1	Flora	6-56
6.7.1.2	Fauna	6-57
6.7.1.3	Endangered, Threatened, and Rare Species	6-59
6.7.2	Potential Exposure Pathways	6-61
6.7.3	Conclusions	6-62
7.0	Summary and Conclusions	7-1
8.0	References	8-1

Table of Contents (Continued)

- Appendix A - Water Level Measurements
 - Hydrographs
 - Potentiometric Maps
- Appendix B - Analytical Data
- Appendix C - Boring Logs
 - Geophysical Logs
- Appendix D - Groundwater Flow Model
 - Solute Transport Model
- Appendix E - Risk Assessment Models
- Appendix F - West Side Aquifer Test Analysis

List of Tables

Table	Title	Follows Tab
1.5-1	Potentially Contaminated Sites, by Site Number, Site Name, and Type of Waste	Tables
2.1-1	Status of Underground Tanks Being Investigated Under the IRP	
2.1-2	Status of Sumps and Ponds Being Investigated Under the IRP	
2.1-3	List of Potentially Contaminated Sites for Remedial Investigation	
2.3-1	Unified Soil Classification System	
2.3-2	Existing Monitoring Wells Used in Monthly Water Level Program	
2.3-3	Summary of Monitoring Wells Sampled and Analytical Parameters Analyzed for During Phase I and Phase II Investigation	
2.3-4	List of RI Analytical Parameters	
3.4-1	Generalized Local Geologic Column	
3.5-1	Background Inorganic Chemistry of Soils in the Moffett Field Area	
3.6-1	Typical Depth Intervals of Hydrogeologic Units	
3.6-2	Summary of Hydraulic Parameters, Pump Test 7, Site 8	
3.6-3	Summary of Hydraulic Parameters, Pump Tests 1, 3, 5, and 8, Site 9	
3.6-4	Summary of Hydraulic Parameters, A1/A2 Aquitard, Site 9	
4.1-1	Methylene Chloride Groundwater Analytical Results	
4.2-1	Average Concentrations of Inorganic Species in Background Monitoring Wells	
4.2-2	Selected Organic Compounds - Groundwater Analysis, A1 Aquifer Zone	

List of Tables (Continued)

Table	Title	Follows Tab
4.2-2A	Other Site 9 Wells, TPH and BTEX Groundwater Analytical Results ($\mu\text{g/L}$), Sample Date: July 1991	Tables
4.2-3	Statistical Summary of Inorganics, Sites 8 and 9, A1 Aquifer Zone	
4.2-4	Selected Organic Compounds - Groundwater Analysis, A2 Aquifer Zone	
4.2-5	Statistical Summary of Inorganics, Sites 8 and 9, A2 Aquifer Zone	
4.2-6	Selected Organic Compounds - Groundwater Analysis - B2, B3, and C Aquifer Zones	
4.2-7	Statistical Summary of Inorganics, B2 Aquifer Zone - Site 9	
5.2-1	Ranges of Hydraulic Conductivities for Aquifer Materials	
5.2-2	Summary of Input Data for the Calibrated MODFLOW Model	
5.2-3	Well Locations, Water Elevations, and Differences for Groundwater Flow Modeling	
5.2-4	Summary of Input Data for TCE Transport Model	
5.2-5	Comparison of Model Results and Observed Concentrations of TCE in Monitoring Wells	
6.2-1	Evaluation of Chemicals of Potential Concern in the Groundwater for OU4 at Moffett Field: Aquifer A1	
6.2-2	Evaluation of Chemicals of Potential Concern in the Groundwater for OU4 at Moffett Field: Aquifer A2	
6.2-3	Evaluation of Chemicals of Potential Concern in the Groundwater for OU4 at Moffett Field: Aquifer B2	
6.2-4	Evaluation of Chemicals of Potential Concern in the Groundwater for OU4 at Moffett Field: Aquifer B3	

List of Tables (Continued)

Table	Title	Follows Tab
6.2-5	Evaluation of Chemicals of Potential Concern in the Groundwater for OU4 at Moffett Field: Aquifer C	Tables
6.2-6	Summary of Chemicals of Potential Concern in the Groundwater for OU4	
6.3-1	Summary of Potential Exposure Pathways Moffett Field: OU4	
6.3-2	Preliminary Parameters Used to Estimate Exposure Moffett Field: OU4	
6.3-3	Results of the Exposure Assessment for A1 Aquifer: Future Land Use	
6.3-4	Results of the Exposure Assessment for A2 Aquifer: Future Land Use	
6.3-5	Results of the Exposure Assessment for B2 Aquifer: Future Land Use	
6.3-6	Results of the Exposure Assessment for B3 Aquifer: Future Land Use	
6.4-1	Summary of Cancer Slope Factors for Chemicals Found at Moffett Field OU4	
6.4-2	Summary of Noncarcinogenic Reference Doses for Chemicals at Moffett Field OU4	
6.5-1	Summary of Potential Incremental Lifetime Cancer Risks (ILCR) Associated with the A1 Aquifer Zone: Future Land Use	
6.5-2	Summary of Potential Incremental Lifetime Cancer Risks (ILCR) Associated with the A2 Aquifer Zone: Future Land Use	
6.5-3	Summary of Potential Incremental Lifetime Cancer Risks (ILCR) Associated with the B2 Aquifer Zone: Future Land Use	
6.5-4	Summary of Potential Incremental Lifetime Cancer Risks (ILCR) Associated with the B3 Aquifer Zone: Future Land Use	

List of Tables (Continued)

<i>Table</i>	<i>Title</i>	<i>Follows Tab</i>
6.5-5	Potential Risks Associated with Drinking Water Exposure to Background Metals in Groundwater	Tables
6.5-6	Potential Risks Associated with Drinking Water Exposure to Chemicals in Groundwater at the Contract Required Detection Limits	
6.5-7	Summary of Potential Hazard Quotients (HQ) Associated with the A1 Aquifer Zone: Future Land Use	
6.5-8	Summary of Potential Hazard Quotients (HQ) Associated with the A2 Aquifer Zone: Future Land Use	
6.5-9	Summary of Potential Hazard Quotients (HQ) Associated with the B2 Aquifer Zone: Future Land Use	

List of Figures

Figure	Title	Follows Tab
1.3-1	Regional Site Location Map	Figures
1.3-2	NAS Moffett Field Boundary Map	
1.5-1	Installation Restoration Program (IRP) Sites	
1.6-1	Site 8 Waste Oil Transfer Area	
1.6-2	Site 9 Old Fuel Farm and Old NEX Gas Station	
1.6-3A	Site 10 Chase Park and Runway Areas	
1.6-3B	Site 10 Chase Park Area (Inset)	
1.6-4	Site 12 Fire Fighting Training Area	
1.6-5	Site 14 Abandoned Tank Nos. 19, 20 and 57	
1.6-6	Site 15 Sumps and Oil/Water Separators	
1.6-7	Site 16 Public Works Steam Cleaning Rack, Sump No. 60	
1.6-8	Site 17 Public Works Paint Shop Sump No. 61	
1.6-9	Site 18 Dry Cleaners' Sump No. 66	
1.6-10	Site 19 Leaking Tank No. 14	
2.1-1	Approximate Locations of Potential Vertical Conduit Wells	
2.3-1	Site 8 Waste Oil Transfer Area Monitoring Well Location Map	
2.3-2	Site 9 Old Fuel Farm and Old NEX Gas Station Monitoring Well Location Map	
2.3-3	Site 10 Chase Park Area Monitoring Well Location Map	
2.3-4	Site 12 Fire Fighting Training Area Monitoring Well Location Map	

List of Figures (Continued)

<i>Figure</i>	<i>Title</i>	<i>Follows Tab</i>
2.3-5	Site 14 Tanks 19, 20, 57, 67, and 68 Monitoring Well Location Map	Figures
2.3-6	Site 15 Sumps and Oil/Water Separators	
2.3-7	Site 16 Public Works Steam Cleaning Rack, Sump No. 60 Monitoring Well Location Map	
2.3-8	Site 17 Public Works Paint Shop Sump No. 61	
2.3-9	Site 18 Dry Cleaners' Sump No. 66, Monitoring Well Location Map	
2.3-10	Middlefield-Ellis-Whisman (MEW) Area	
2.3-11	NASA-Ames Site Map	
2.3-12	Lockheed Missiles and Space Company Site Map	
2.5-1	Pump Test Locations	
3.3-1	Surface and Storm Water Drainage Map	
3.4-1	Generalized Geologic Cross Section Showing Aquifers	
3.4-2	Conceptual Model of Paleo-Depositional Environments in the Moffett Field/Mountain View Area	
3.4-2A	Location Map for Geologic Cross Sections A-A' to D-D'	
3.4-3	Geological Cross Section A-A'	
3.4-4	Geological Cross Section B-B'	
3.4-5	Geological Cross Section C-C'	
3.4-6	Geological Cross Section D-D'	
3.4-7	Cross Section Locations E, F, G, H, I, and J	

List of Figures (Continued)

Figure	Title	Follows Tab
3.4-8	Geological Cross Section E-E' for Site 9	Figures
3.4-9	Geological Cross Section F-F' for Site 9	
3.4-10	Geological Cross Section G-G' for Site 9	
3.4-11	Geological Cross Section H-H' for Site 9	
3.4-12	Geological Cross Section I-I' for Site 8	
3.4-13	Geological Cross Section J-J' for Site 8	
3.4-14	Gravel/Sand Isopach Map for the A1 Aquifer Zone	
3.4-15	Gravel/Sand Isopach Map for the A2 Aquifer Zone	
3.4-16	Geomorphic and Sedimentary Characteristics of Bed-Load, Mixed-Load, and Suspended-Load Channel Segments and Their Deposits	
3.4-17	Schematic Three-Dimensional Geometry, Lateral Relationships, and Internal Bedding Architecture of Reservoir Sand Bodies	
3.5-1	General Soil Associations	
3.6-1	Moffett Field and MEW Regional Hydrogeologic Interpretation	
3.6-2	West Side Aquifer Zone Inferred Paleochannels 5-15-feet (BLS) Interval at Sites 8, 9, 12, and 14	
3.6-3	West Side Aquifer Zone Inferred Paleochannels 15-25-feet (BLS) Interval at Sites 8, 9, 12, and 14	
3.6-4	West Side Aquifer Zone Inferred Paleochannels 25-35-feet (BLS) Interval at Sites 9 and 14, and 25-45-feet (BLS) Interval at Sites 8 and 12	
3.6-5	West Side Aquifer Zone Inferred Paleochannels 30-40-feet (BLS) Interval at Sites 9 and 14, and 25-45-feet (BLS) Interval at Sites 8 and 12	

List of Figures (Continued)

Figure	Title	Follows Tab
3.6-6	Sites 8 and 9, August 1991 Water Level Versus Coordinates for the A1 and A2 Aquifer Zone Monitoring Wells	Figures
4.2-1	Anaerobic Transformation of PCE, TCE, and TCA	
4.2-2	Operable Unit No. 4 Background Wells	
4.2-3	West Side Aquifer PCE Groundwater Concentration Contour Map, A1 Aquifer Zone, Phase II, 2nd Quarter 1991	
4.2-4A	West Side Aquifer TCE Groundwater Concentration Contour Map, A1 Aquifer Zone, Phase II, 2nd Quarter 1991	
4.2-4B	Site 8 TCE Groundwater Concentration Contour Map, A1 Aquifer Zone, Phase II, 2nd Quarter 1991	
4.2-4C	MEW and Moffett Field TCE Groundwater Concentration Contour Map (ppm), A1 (A)-Aquifer, October 1986 - June 1987	
4.2-4D	MEW (Inset) TCE Groundwater Concentration Contour Map (ppm), A1 (A)-Aquifer October 1986 - June 1987	
4.2-5A	West Side Aquifer 1,2-DCE Groundwater Concentration Contour Map, A1 Aquifer Zone, Phase II, 2nd Quarter 1991	
4.2-5B	MEW and Moffett Field Total 1,2-DCE Groundwater Concentration Contour Map (ppm), A1 (A)-Aquifer, October 1986 - June 1987	
4.2-5C	MEW (Inset) Total 1,2-DCE Groundwater Concentration Contour Map (ppm), A1 (A)-Aquifer, October 1986 - June 1987	
4.2-6	West Side Aquifer 1,1-DCE Groundwater Concentration Contour Map, A1 Aquifer Zone, Phase II, 2nd Quarter 1991	
4.2-7A	West Side Aquifer 1,1,1-TCA Groundwater Concentration Contour Map, A1 Aquifer Zone, Phase II, 2nd Quarter 1991	
4.2-7B	MEW and Moffett Field 1,1,1-TCA Groundwater Concentration Contour Map (ppm), A1 (A)-Aquifer, October 1986 - June 1987	

List of Figures (Continued)

Figure	Title	Follows Tab
4.2-7C	MEW (Inset) 1,1,1-TCA Groundwater Concentration Contour Map (ppm), A1 (A)-Aquifer, October 1986 - June 1987	Figures
4.2-8	West Side Aquifer 1,1-DCA Groundwater Concentration Contour Map, A1 Aquifer Zone, Phase II, 2nd Quarter 1991	
4.2-8A	Site 9 TPH Groundwater Concentration Contour Map, A1 Aquifer Zone, July 1991	
4.2-8B	Site 14 TPH Groundwater Concentration Contour Map, A1 Aquifer Zone, February 1991	
4.2-9	West Side Aquifer PCE Groundwater Concentration Contour Map, A2 Aquifer Zone, Phase II, 2nd Quarter 1991	
4.2-10A	West Side Aquifer TCE Groundwater Concentration Contour Map, A2 Aquifer Zone, Phase II, 2nd Quarter 1991	
4.2-10B	MEW and Moffett Field TCE Groundwater Concentration Contour Map (ppm), A2(B1)-Aquifer, October 1986-June 1987	
4.2-10C	MEW (Inset) TCE Groundwater Concentration Contour Map (ppm), A2(B1)-Aquifer, October 1986 - June 1987	
4.2-11A	West Side Aquifer 1,2-DCE Groundwater Concentration Contour Map A2 Aquifer Zone, Phase II, 2nd Quarter 1991	
4.2-11B	MEW and Moffett Field Total 1,2-DCE Groundwater Concentration Contour Map (ppm), A2(B1)-Aquifer, October 1986 - June 1987	
4.2-11C	MEW (Inset) Total 1,2-DCE Groundwater Concentration Contour Map (ppm), A2(B1)-Aquifer, October 1986 - June 1987	
4.2-12	West Side Aquifer 1,1-DCE Groundwater Concentration Contour Map, A2 Aquifer Zone, Phase II, 2nd Quarter, 1991	
4.2-13A	West Side Aquifer 1,1,1-TCA Groundwater Concentration Contour Map, A2 Aquifer Zone, Phase II, 2nd Quarter 1991	

List of Figures (Continued)

Figure	Title	Follows Tab
4.2-13B	MEW and Moffett Field 1,1,1-TCA Groundwater Concentration Contour Map, (ppm), A2(B1)-Aquifer, October 1986 - June 1987	Figures
4.2-13C	MEW (Inset) 1,1,1-TCA Groundwater Concentration Contour Map (ppm), A2(B1)-Aquifer, October 1986 - June 1987	
4.2-14	West Side Aquifer 1,1-DCA Groundwater Concentration Contour Map, A2 Aquifer Zone, Phase II, 2nd Quarter 1991	
4.2.15	B2 Aquifer Monitoring Well Location Map	
5.2-1	Generalized Geologic Cross-Sections A-A' and B-B'	
5.2-2	Groundwater Flow Model Grid Showing Row and Column Identifications	
5.2-3	Location of Sand Channels in the A1 Model Aquifer	
5.2-4	Location of Sand Channels in the A2 Model Aquifer	
5.2-5	Model Water Level Contour Map for the A1 Aquifer Zone	
5.2-6	Model Water Level Contour Map for the A2 Aquifer Zone	
5.2-7	Model Water Level Contour Map for the B2 Aquifer Zone	
5.2-8	Model Water Level Contour Map for the B3 Aquifer Zone	
5.2-9	Transport Model Grid Showing Relative Location of Model Observation Points and Row and Column Identification	
5.2-10	Model TCE Concentration, No Linear Adsorption, R = 1 Source at Boundary Only	
5.2-11	Model TCE Concentration, Linear Adsorption, R = 2.02 Source at Boundary Only	
5.2-12	Model TCE Concentration, No Linear Adsorption, R = 1 Boundary and Additional Source	

List of Figures (Continued)

<i>Figure</i>	<i>Title</i>	<i>Follows Tab</i>
5.2-13	Model TCE Concentration, Linear Adsorption $R = 2.02$ Boundary and Additional Source	Figures
5.2-14	A Aquifer, Model TCE Concentration Map, Boundary Source, Without Adsorption, $R = 1$	
5.2-15	A Aquifer, Model TCE Concentration Map, Boundary Source, With Adsorption, $R = 2.02$	
5.2-16	A Aquifer, Model TCE Concentration Map, Boundary and Additional Sources, Without Adsorption, $R = 1$	
5.2-17	A Aquifer, Model TCE Concentration Map, Boundary and Additional Sources, With Adsorption, $R = 2.02$	
6.3-1	Conceptual Model for Future Potential Exposures at Moffett Field OU4	

VOLUME 2, APPENDIX A
WATER LEVEL MEASUREMENTS

FOLLOWS TAB

2nd Quarter, 1990

A (Water Level
Measurements)

3rd Quarter, 1990

4th Quarter, 1990

1st Quarter, 1991

2nd Quarter, 1991

HYDROGRAPHS

NUMBER

- | | | |
|------|---|-----------------|
| D-1 | Hydrograph of Site 01, A-Aquifer Wells | A (Hydrographs) |
| D-2 | Hydrograph of Site 01, A-Aquifer Wells (continued) | |
| D-3 | Hydrograph of Site 01, Leachate Wells | |
| D-4 | Hydrograph of Site 02, A-Aquifer Wells | |
| D-5 | Hydrograph of Site 02, Leachate Wells | |
| D-6 | Hydrograph of Site 03, A1-Aquifer Wells | |
| D-7 | Hydrograph of Site 03, A1-Aquifer Wells (continued) | |
| D-8 | Hydrograph of Site 03, A2-Aquifer Wells | |
| D-9 | Hydrograph of Site 03, B-Aquifer Wells | |
| D-10 | Hydrograph of Site 03, C-Aquifer Wells | |
| D-11 | Hydrograph of Site 04, A1-Aquifer Wells | |
| D-12 | Hydrograph of Site 04, A1-Aquifer Wells (continued) | |
| D-13 | Hydrograph of Site 04, A2-Aquifer Wells | |

VOLUME 2, APPENDIX A (Continued)
HYDROGRAPHS (Continued)

<u>NUMBER</u>	<u>FOLLOWS TAB</u>
D-14 Hydrograph of Site 04, B-Aquifer Wells	A (Hydrographs)
D-15 Hydrograph of Site 04, C-Aquifer Wells	
D-16 Hydrograph of Site 05, A1-Aquifer Wells	
D-17 Hydrograph of Site 05, A1-Aquifer Wells (continued)	
D-18 Hydrograph of Site 05, A1-Aquifer Wells (continued)	
D-19 Hydrograph of Site 05, A1-Aquifer Wells (continued)	
D-20 Hydrograph of Site 05, A2-Aquifer Wells	
D-21 Hydrograph of Site 05, B-Aquifer Wells	
D-22 Hydrograph of Site 05, C-Aquifer Wells	
D-23 Hydrograph of Site 05, Free Product Wells	
D-24 Hydrograph of Site 05, Free Product Wells (continued)	
D-25 Hydrograph of Site 06, A-Aquifer Wells	
D-26 Hydrograph of Site 07, A1-Aquifer Wells	
D-27 Hydrograph of Site 07, A1-Aquifer Wells (Continued)	
D-28 Hydrograph of Site 07, A2-Aquifer Wells	
D-29 Hydrograph of Site 07, C-Aquifer Wells	
D-30 Hydrograph of Site 08, A1-Aquifer Wells	
D-31 Hydrograph of Site 08, A1-Aquifer Wells (Continued)	
D-32 Hydrograph of Site 08, A2-Aquifer Wells	
D-33 Hydrograph of Site 08, C-Aquifer Wells	
D-34 Hydrograph of Site 09, A1-Aquifer Wells	

VOLUME 2, APPENDIX A (Continued)
HYDROGRAPHS (Continued)

<u>NUMBER</u>	<u>FOLLOWS TAB</u>
D-35 Hydrograph of Site 09, A1-Aquifer Wells (continued)	A (Hydrographs)
D-36 Hydrograph of Site 09, A1-Aquifer Wells (continued)	
D-37 Hydrograph of Site 09, A1-Aquifer Wells (continued)	
D-38 Hydrograph of Site 09, A1-Aquifer Wells (continued)	
D-39 Hydrograph of Site 09, A2-Aquifer Wells	
D-40 Hydrograph of Site 09, A2-Aquifer Wells (continued)	
D-41 Hydrograph of Site 09, A2-Aquifer Wells (continued)	
D-42 Hydrograph of Site 09, A2-Aquifer Wells (continued)	
D-43 Hydrograph of Site 09, A2-Aquifer Wells (continued)	
D-44 Hydrograph of Site 09, B-Aquifer Wells	
D-45 Hydrograph of site 09, B-Aquifer Wells (continued)	
D-46 Hydrograph of Site 09, C-Aquifer Wells	
D-47 Hydrograph of Site 10, A-Aquifer Wells	
D-48 Hydrograph of Site 10, B-Aquifer Wells	
D-49 Hydrograph of Site 10, C-Aquifer Wells	
D-50 Hydrograph of Site 11, A1-Aquifer Wells	
D-51 Hydrograph of Site 12, A1-Aquifer Wells	
D-52 Hydrograph of Site 14, A1-Aquifer Wells	
D-53 Hydrograph of Site 14, A2-Aquifer Wells	
D-54 Hydrograph of Site 19, A-Aquifer Wells	

VOLUME 2, APPENDIX A (Continued)
HYDROGRAPHS (Continued)

<u>NUMBER</u>	<u>FOLLOWS TAB</u>
Potentiometric Surface Contour Map, A-Aquifer West, May 1990	(Potentiometric Maps)
Potentiometric Surface Contour Map, A-Aquifer East, May 1990	
Potentiometric Surface Contour Map, A-Aquifer, May 1990, Sites 1 and 2	
Potentiometric Surface Contour Map, A1-Aquifer, August 1990	
Potentiometric Surface Contour Map, A2-Aquifer, August 1990	
Potentiometric Surface Contour Map, A1-Aquifer, November/December 1990	
Potentiometric Surface Contour Map, A2-Aquifer, November/December 1990	
Potentiometric Surface Contour Map, A1-Aquifer, March 1991	
Potentiometric Surface Contour Map, A2-Aquifer, March 1991	
Potentiometric Surface Contour Map, A1-Aquifer, May 1991	
Potentiometric Surface Contour Map, A2-Aquifer, May 1991	

**VOLUME 2, APPENDIX B
ANALYTICAL DATA**

FOLLOWS TAB

Analytical Data	B
Results of Validated Sample Analyses	<u>Tab/Page</u>
Site 8 - Aquifer A1	Site 8/B8-1
- Aquifer A2	/B8-14
- Aquifer C	/B8-31
Results of Validated Sample Analyses	
Site 9 - Aquifer A1	Site 9/B9-1
- Aquifer A2	/B9-84
- Aquifer B2	/B9-160
- Aquifer B3	/B9-184
- Aquifer C	/B9-186
Results of Validated Sample Analyses	
Site 12 - Aquifer A1	Site 12/B12-1
Results of Validated Sample Analyses	
Site 14 - Aquifer A1	Site 14/B14-1
- Aquifer A2	/B14-7
Results of Validated Sample Analyses	
Site CLEAN - Aquifer A1	CLEAN/BCLN-1
- Aquifer A2	/BCLN-11
Results of Validated Sample Analyses	
Site MEW - Aquifer A1	MEW/BMEW-1
- Aquifer A2	/BMEW-21
- Aquifer B2	/BMEW-37

VOLUME 3, APPENDIX C
BORING LOGS/CPT

FOLLOWS TAB

Legend for Log of Borings and Test Pits

C (Boring Logs)

SITE 8 - WELLS (IT)

Site 8 - Wells
(IT)

W8-2(A2)
W8-3(C)
W8-4(A1)
W8-6(A1)
W8-8(A1)
W8-10(A2)
W8-11(A2)
W8-12(A2)

CPT-(IT)

Site 8 - CPT
(IT)

CPT8-3
CPT8-5
CPT8-7
CPT8-10
CPT8-12
CPT8-14
CPT8-18
CPT8-19
CPT8-21

CPT - (CLEAN)

Site 8 - CPT
(CLEAN)

CPT-2
CPT-4
CPT-5
CPT-10
CPT-11
CPT-14
CPT-20
CPT-39
CPT-46
CPT-60

VOLUME 3, APPENDIX C
BORING LOGS/CPT (Continued)

SITE 9 - WELLS (IT)

W9-3(C)
W9-4(B2)
W9-5(B3)
W9-7(A1)
W9-9(A2)
W9-13(A2)
W9-14(A2)
W9-15(B2)
W9-20(A2)
W9-21(A2)
W9-22(A2)
W9-23(A1)
W9-25(A2)
W9-27(A2)
W9-33(A2)
W9-34(A2)
W9-35(A1)
W9-37(A1)
W9-38(A1)
W9-39(B2)
W9-41(A2)
W9-42(A2)
PT9-3(A2)

**Site 9 - Wells
(IT)**

WELLS - (CLEAN)

W29-1(A)
W29-7(A2)
W29-10(A2)
W89-1(A)
W89-2(A)
W89-11(B1)
W89-12(B1)

**Site 9 - Wells
(CLEAN)**

WELLS - (MEW)

MEW-2(C)
MEW-3(B)
MEW-3(C)
MEW-4(B)
RW-9

**Site 9 - Wells
(MEW)**

VOLUME 3, APPENDIX C
BORING LOGS/CPT (Continued)

MEW-10(B)
MEW-12(B)
MEW-45(A)
MEW-46(A)
MEW-49(A)
MEW-54(A)
MEW-57(A)
MEW-61(A)
MEW-64(B)
MEW-65(A)
MEW-79(A)
MEW-82(A)

CPT - (IT)

**Site 9 - CPT
(IT)**

CPT-9-5
CPT-9-6
CPT-9-9
CPT-9-11
CPT-9-21
CPT-9-22
CPT-9-25
CPT-9-26
CPT-9-32
CPT-9-36
CPT-9-39
CPT-9-40
CPT-9-44

CPT - (CLEAN)

**Site 9 - CPT
(CLEAN)**

CPT-89-5
CPT-89-13
CPT-29-18
CPT-29-40

VOLUME 3, APPENDIX C (Continued)
GEOPHYSICAL LOGS

FOLLOWS TAB

SITE 1	C (Geophysical Logs, Site 1)
GB-4	
GB-5	
GB-6	
SITE 2	Site 2
GB-1	
GB-2	
GB-3	
SITE 3	Site 3
GB-13	
GB-14	
GB-15	
GB-16	
GB-17	
SITE 4	Site 4
GB-18	
GB-19	
GB-20	
SITE 5	Site 5
GB-21	
GB-22	
GB-23	
SITE 6	Site 6
SITE 7	Site 7
GB-24	
SITE 8	Site 8
GB-25	
GB-26	

VOLUME 3, APPENDIX C (Continued)
GEOPHYSICAL LOGS (Continued)

FOLLOWS TAB

SITE 9	Site 9
GB-7	
GB-8	
GB-9	
GB-10	
GB-11	
GB-12	
SITE 10	Site 10
GB-27	
GB-30	
SITE 11	Site 11
SITE 12	Site 12
SITE 13	Site 13
SITE 14	Site 14
GB-28	
SITE 15	Site 15
SITE 16	Site 16
SITE 17	Site 17
SITE 18	Site 18
SITE 19	Site 19
GB-29	

VOLUME 4, APPENDIX D
GROUNDWATER FLOW MODEL

FOLLOWS TAB

MODFLOW Input

D, Groundwater
Flow Model

MODFLOW Output

SOLUTE TRANSPORT MODEL

FOLLOWS TAB

Boundary Source Only,
No Retardation

D, Solute Transport
Model

Boundary Source Only,
Retardation = 2.02
Additional Source,
Without Retardation

Additional Source,
Retardation = 2.02

**VOLUME 4, APPENDIX E
RISK ASSESSMENT MODELS**

FOLLOWS TAB

**Indoor Air Modeling
Concentration in Vegetables**

E

**VOLUME 4, APPENDIX F
AQUIFER TESTS**

FOLLOWS TAB

Westside Aquifer Test Analysis

F

VOLUME 3, APPENDIX C

BORING LOGS


GEOPHYSICAL LOGS

VOLUME 3, APPENDIX C


BORING LOGS

USCS CLASSIFICATION OF COARSE GRAINED MATERIAL

DRAWN BY F.C.R. CHECKED BY S.H.B. APPROVED BY S.H.B. DRAWING 409616 - 87
11:14-88 11:14-88 NUMBER

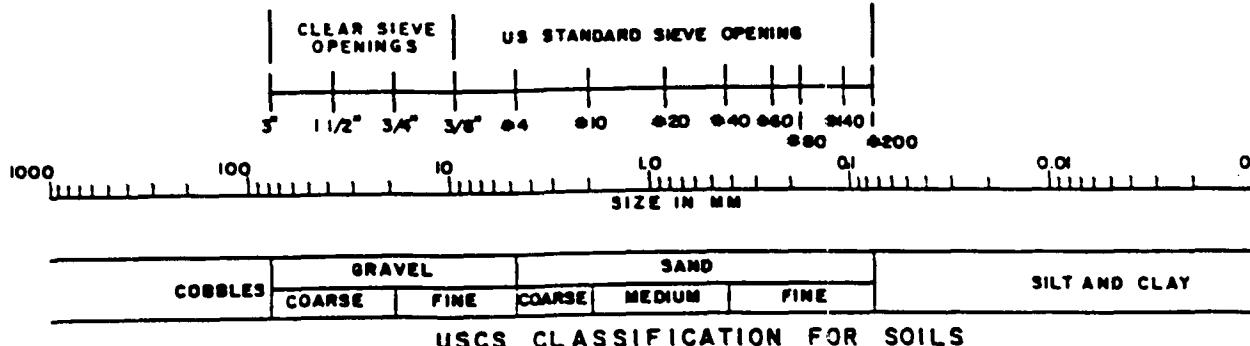

USCS CLASSIFICATION OF FINE GRAINED MATERIAL

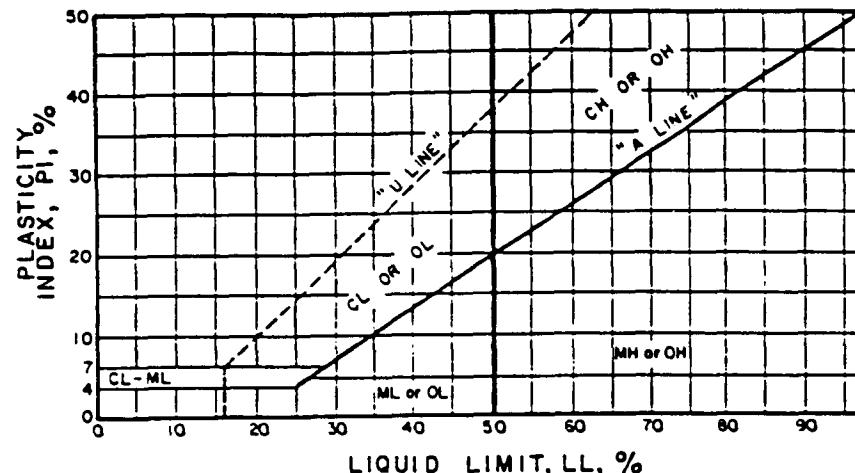

DENSITY OF GRANULAR SOIL

DESIGNATION	SPT BLOWS PER FOOT
VERY LOOSE	0 — 4
LOOSE	5 — 10
MEDIUM DENSITY	11 — 30
DENSE	31 — 50
VERY DENSE	OVER 50

CONSISTENCY OF COHESIVE SOIL

CONSISTENCY	FIELD IDENTIFICATION	UNCONFINED COMPRESSIVE STRENGTH q_u (TONS/SQ. FT.)
VERY SOFT	EASILY PENETRATED SEVERAL INCHES BY FIST	LESS THAN 0.25
SOFT	EASILY PENETRATED SEVERAL INCHES BY THUMB	0.25—0.5
MEDIUM STIFF	PENETRATED SEVERAL INCHES BY THUMB WITH MODERATE PRESSURE	0.5—1.0
STIFF	READILY INDENTED BY THUMB BUT PENETRATED WITH GREAT EFFORT	1.0—2.0
VERY STIFF	READILY INDENTED BY THUMBNAIL	2.0—4.0
HARD	INDENTED WITH DIFFICULTY BY THUMBNAIL	OVER 4.0

ABBREVIATIONS FOR LABORATORY TESTS

COMP - COMPACTION TEST
PI - ATTERBERG LIMITS
SA - SIEVE ANALYSIS
MA - MECHANICAL ANALYSIS
HYD - HYDROMETER ANALYSIS
CONS - CONSOLIDATION TEST

SAMPLE TYPE

<u>3" RING SAMPLER</u>	<u>SHELBY TUBE</u>	<u>PITCHER BARREL</u>	<u>2" SPLIT BARREL</u>	<u>BULK SAMPLER</u>
IVELY STURBED				
ED				
COVERTY				

UNIFIED SOIL CLASSIFICATION SYSTEM (USCS) (ASTM D2487-83)

MAJOR DIVISIONS			GROUP SYMBOLS	GRAFTING SYMBOLS	TYPICAL NAMES
COARSE-GRAINED SOILS MORE THAN 50% RETAINED ON NO. 200 SIEVE*	GRAVELS 50% or More of Coarse Fraction Retained on No. 4 Sieve	CLEAN GRAVELS	GW		Well-graded gravels and gravel-sand mixtures, little or no fines
			GP		Poorly graded gravels and gravel-sand mixtures, little or no fines
		GRAVELS WITH FINES	GM		Silty gravels, gravel-sand-silt mixtures
			GC		Clayey gravels, gravel-sand-clay mixtures
	SANDS More Than 50% of Coarse Fraction Passes No. 4 Sieve	CLEAN SANDS	SM		Well-graded sands and gravelly sands, little or no fines
			SP		Poorly graded sands and gravelly sands, little or no fines
		SANDS WITH FINES	SM		Silty sands, sand-silt mixtures
			SC		Clayey sands, sand-clay mixtures
		SILTS AND CLAYS Liquid Limit 50% or Less	IL		Inorganic silts, very fine sands, rock flour, silty or clayey fine sands
			CL		Inorganic clays of low to medium plasticity, gravelly clays, sandy clays, silty clays, lean clays
			OL		Organic silts or organic clays of low plasticity
			MH		Inorganic silts, siliceous or diatomaceous fine sands or silts, elastic silts
FINE-GRAINED SOILS 50% OR MORE PASSES NO. 200 SIEVE*	SILTS AND CLAYS Liquid Limit Greater Than 50%	MH	CH		Inorganic clays of high plasticity, fat clay
			OM		Organic clays or organic silts of medium to high plasticity
			PT		Peat, muck and other highly organic soils

• BASED ON THE MATERIAL PASSING THE 3-INCH (75-mm) SIEVE
REFERENCE: ASTM STANDARD D2887

19

- (1) UPPER CASE USED FOR LABORATORY VERIFIED USCS CLASSIFICATIONS.
 - (2) LOWER CASE USED FOR FIELD USCS CLASSIFICATIONS.
 - (3) DUAL USCS SYMBOL, SUCH AS (SP-SM) DENOTES 5 TO 12% OF MINOR CONSTITUENT.
 - (4) BORDER LINE SYMBOL, SUCH AS (CL/CH) DENOTES SOIL HAVING PROPERTIES THAT DO NOT DISTINCTLY PLACE THE SOIL IN A SPECIFIC GROUP.
 - (5) SUBSURFACE INFORMATION FROM BORING AND TEST PIT LOGS DEPICT CONDITIONS ONLY AT THE SPECIFIC LOCATIONS AND DATES INDICATED. SOIL CONDITIONS AND WATER LEVELS AT OTHER LOCATIONS MAY DIFFER FROM CONDITIONS AT THESE LOCATIONS. ALSO THE CONDITIONS AT THESE LOCATIONS MAY CHANGE WITH TIME.
 - (6) BLOW COUNTS ON LOGS ARE THE NUMBER OF BLOWS TO DRIVE THE SAMPLER 12 INCHES WITH A 140 POUND HAMMER FALLING 30 INCHES.



 1-1-84 WATER LEVEL AND RATE MEAS.

**LEGEND FOR LOG OF
BORINGS AND TEST PITS**

PREPARED FOR

**NAVAL AIR STATION
MOFFETT FIELD, CALIFORNIA**



... Creating a Safer Tomorrow

N00296.001452
MOFFETT FIELD
SSIC NO. 5090.3

**APPENDIX C – BORING LOGS
GEOPHYSICAL LOGS**

SITE 8 – WELLS (IT)

**REMEDIAL INVESTIGATION REPORT
OPERABLE UNIT 4: WEST SIDE AQUIFERS**

DATED 01 AUGUST 1992

DEPTH IN FEET	SAMPLE TYPE & NUMBER	RECOVERY (IN.)	WELL SUMMARY	BLOWS ON SAMPLER (PER 6')	USCS SYMBOL	PROFILE	BORING NO. W8-2(A2)	
							FIELD GEOLOGIST Wagner	COORDINATES N 338,964.9 E 1,547,887.0
0					FILL			
	MD#1	6/18	12" Christy box 8"x5" standpipe top of casing	2.3.2				
5	MD#2	12/18		3.3.3				
	MD#3	12/18		3.8.9	CL			
10								
15					SC			
20			4" sch. 40 steel casing					
25			Bentonite/ cement grout		SM- SC			
30					CL			
35			Bentonite pellets 36 to 39 ft		GW			
40			Centralizer		SW			
45			4" .010 S.S. screen from 43 to 48 ft		CL- CH			
50			Centralizer		SW			
55			#1C sand		CH			
60			Bentonite backfill		GC			
65					CH			
70					CH			
					GW			
				9.6"				TOTAL DEPTH 65 FEET

DRILLING CO.: Water Development Co.
DRILLING METHOD: Air Rotary

SAMPLING METHODS: MD=California Modified
S=Split Barrel

PROJECT NO.: 409616
CLIENT: Moffett Naval Air Station
Moffett Field, California



...Creating a Safer Tomorrow

SEE LEGEND FOR LOGS AND TEST PITS
FOR EXPLANATION OF SYMBOLS AND TERMS

DEPTH IN FEET	SAMPLE TYPE & NUMBER	RECOVERY (in.)	WELL SUMMARY	ON BORING (PER 6')	USES SYMBOL	PROFILE	BORING NO. W8-3(C)	
							FIELD GEOLOGIST: <u>Weaver</u>	COORDINATES N 33° 725.0 E 124° 048.0
0			Top of casing 8"x5' standpipe	FILL	SANDY CLAY; top soil.		EDITED BY <u>D. H. Cox</u>	DATE BEGAN <u>10/28/88</u>
5					SILTY CLAY; dark grey, moderately moist, very soft, very high plasticity.		CHECKED BY <u>S. Bartling</u>	DATE FINISHED <u>11/1/88</u>
10					SILTY, SANDY CLAY; dusky yellow, moist, very soft, medium plasticity.		TOTAL DEPTH <u>188.8 feet</u>	GROUND SURFACE EL <u>7.9 ft.</u>
15					SANDY CLAY; dusky yellow, moist, very soft, low plasticity.			
20								
25								
30								
35			4" sch. 40 steel casing		SANDY CLAY; orange brown, moderately moist, very soft, high plasticity.			
38			Bentonite/ cement grout		SILTY CLAY; reddish brown, moderately moist, hard, low plasticity, some coarse siltstone inclusions.			
40					SANDY CLAY; light brown, moist, very soft, very low plasticity.			
45					SILTY CLAY; light grey, moist, soft, medium to low plasticity.			
50					CLAYEY GRAVEL; light grey, wet, subangular, appreciable amount of fines.			
55					SILTY CLAY; light grey, moist, soft, low plasticity, some coarse inclusions.			
60					SILTY CLAY; olive grey, moderately moist, soft, low to medium plasticity, sticky, coarse inclusions.			
65					SILTY CLAY; light grey, moist, soft, moderately plastic, coarse inclusions.			
70				SC	CLAYEY SAND; very fine grained, wet, slurry.			

DRILLING CO.: Water Development Co.
DRILLING METHOD: Air Rotary

SAMPLING METHODS: MD=California Modified
S=Split Barrel

PROJECT NO.: 409616
CLIENT: Moffett Naval Air Station
Moffett Field, California

PAGE 1 OF 3



...Creating a Safer Tomorrow

SEE LEGEND FOR LOGS AND TEST PITS
FOR EXPLANATION OF SYMBOLS AND TERMS

DEPTH IN FEET	SAMPLE TYPE & NUMBER	RECOVERY (IN.)	WELL SUMMARY	BLOWS ON SAMPLER (PER FT.)	USCS SYMBOL	PROFILE	BORING NO. W8-3(C)	
							FIELD GEOLOGIST <u>Wegener</u>	COORDINATES N 33° 725.0 E 134° 7.848.0
70					SC		EDITED BY <u>D. H. Cox</u>	DATE BEGAN <u>10/28/88</u>
75					CL-CH		CHECKED BY <u>S. Bartling</u>	DATE FINISHED <u>11/1/88</u>
80					SC-SM		TOTAL DEPTH <u>166.6</u> feet	GROUND SURFACE EL <u>7.9</u> ft.
85							DESCRIPTION	
90							CLAYEY SAND; wet, slurry, very fine grained.	
95							SILTY CLAY/CLAY; light gray, moist, soft to very soft, medium plasticity, sticky.	
100							SAND/CLAYEY SAND; wet, loose, fine to medium grained, surrounded, silty clay stringers throughout.	
105			4" sch. 40 steel casing		CL		SILTY CLAY; grey, moderately moist, stiff, medium plasticity, platy.	
110			Bentonite/cement grout		SP-CL		SAND; clean, wet, unconsolidated with silty clay stringers, very fine grained.	
115					CL-CH		SILTY CLAY; greenish grey, moist, soft to stiff, high plasticity, medium grained inclusions.	
120					CL-CH		SILTY CLAY / CLAY; greenish grey, moderately moist, hard, medium plasticity.	
125					ML-CL		SANDY SILTY CLAY; light grey, very soft, non plastic, slurry.	
130			Centerline		CL		SILTY CLAY; greenish grey, moderately moist, hard to stiff, medium plasticity, some coarse inclusions.	
135								
140								

DRILLING CO.: Water Development Co.
DRILLING METHOD: Air Rotary

SAMPLING METHODS: MD=California Modified
S=Split Barrel


PROJECT NO.: 409616
CLIENT: Moffett Naval Air Station
Moffett Field, California

PAGE 2 OF 3



...Creating a Safer Tomorrow

SEE LEGEND FOR LOGS AND TEST PITS
FOR EXPLANATION OF SYMBOLS AND TERMS

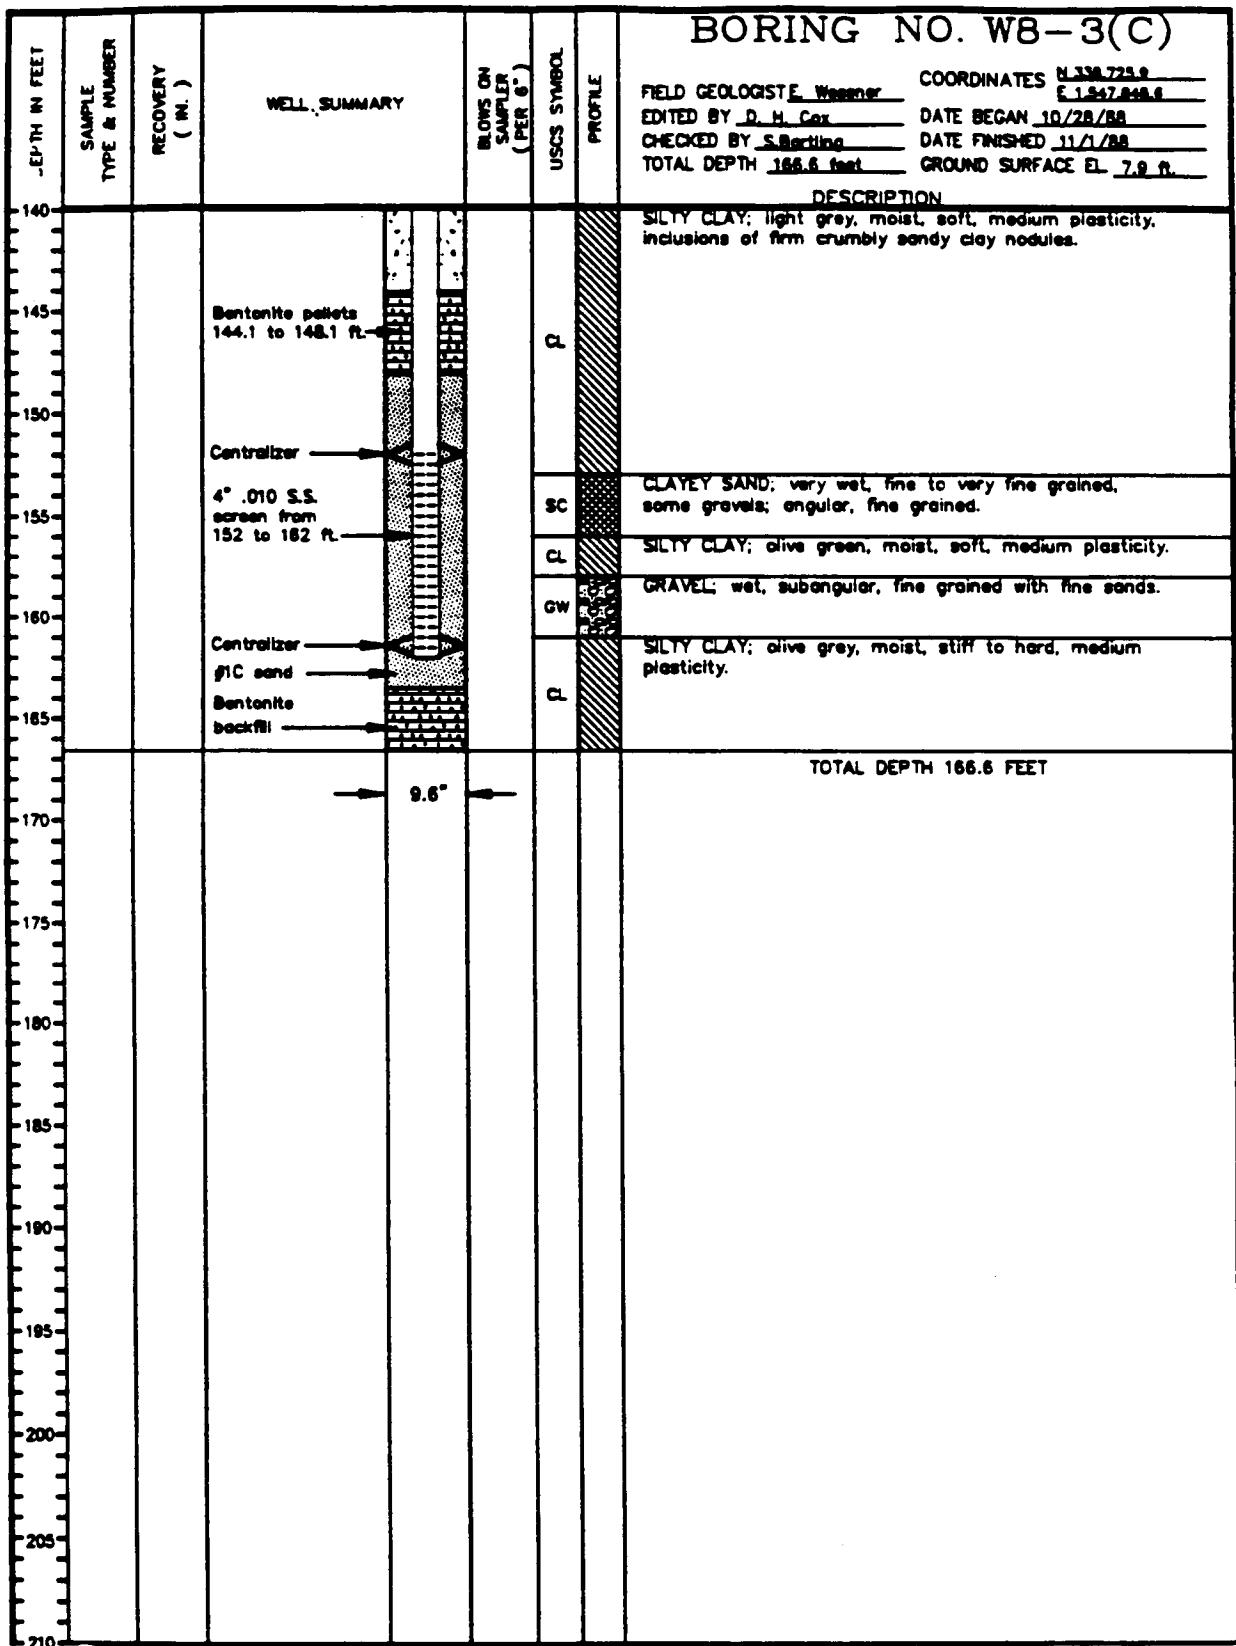

DRILLING CO.: Water Development Co.
DRILLING METHOD: Air Rotary


SAMPLING METHODS: MD=California Modified
S=Split Barrel

PROJECT NO.: 409616
CLIENT: Moffett Naval Air Station
Moffett Field, California



...Creating a Safer Tomorrow

SEE LEGEND FOR LOGS AND TEST PITS
FOR EXPLANATION OF SYMBOLS AND TERMS

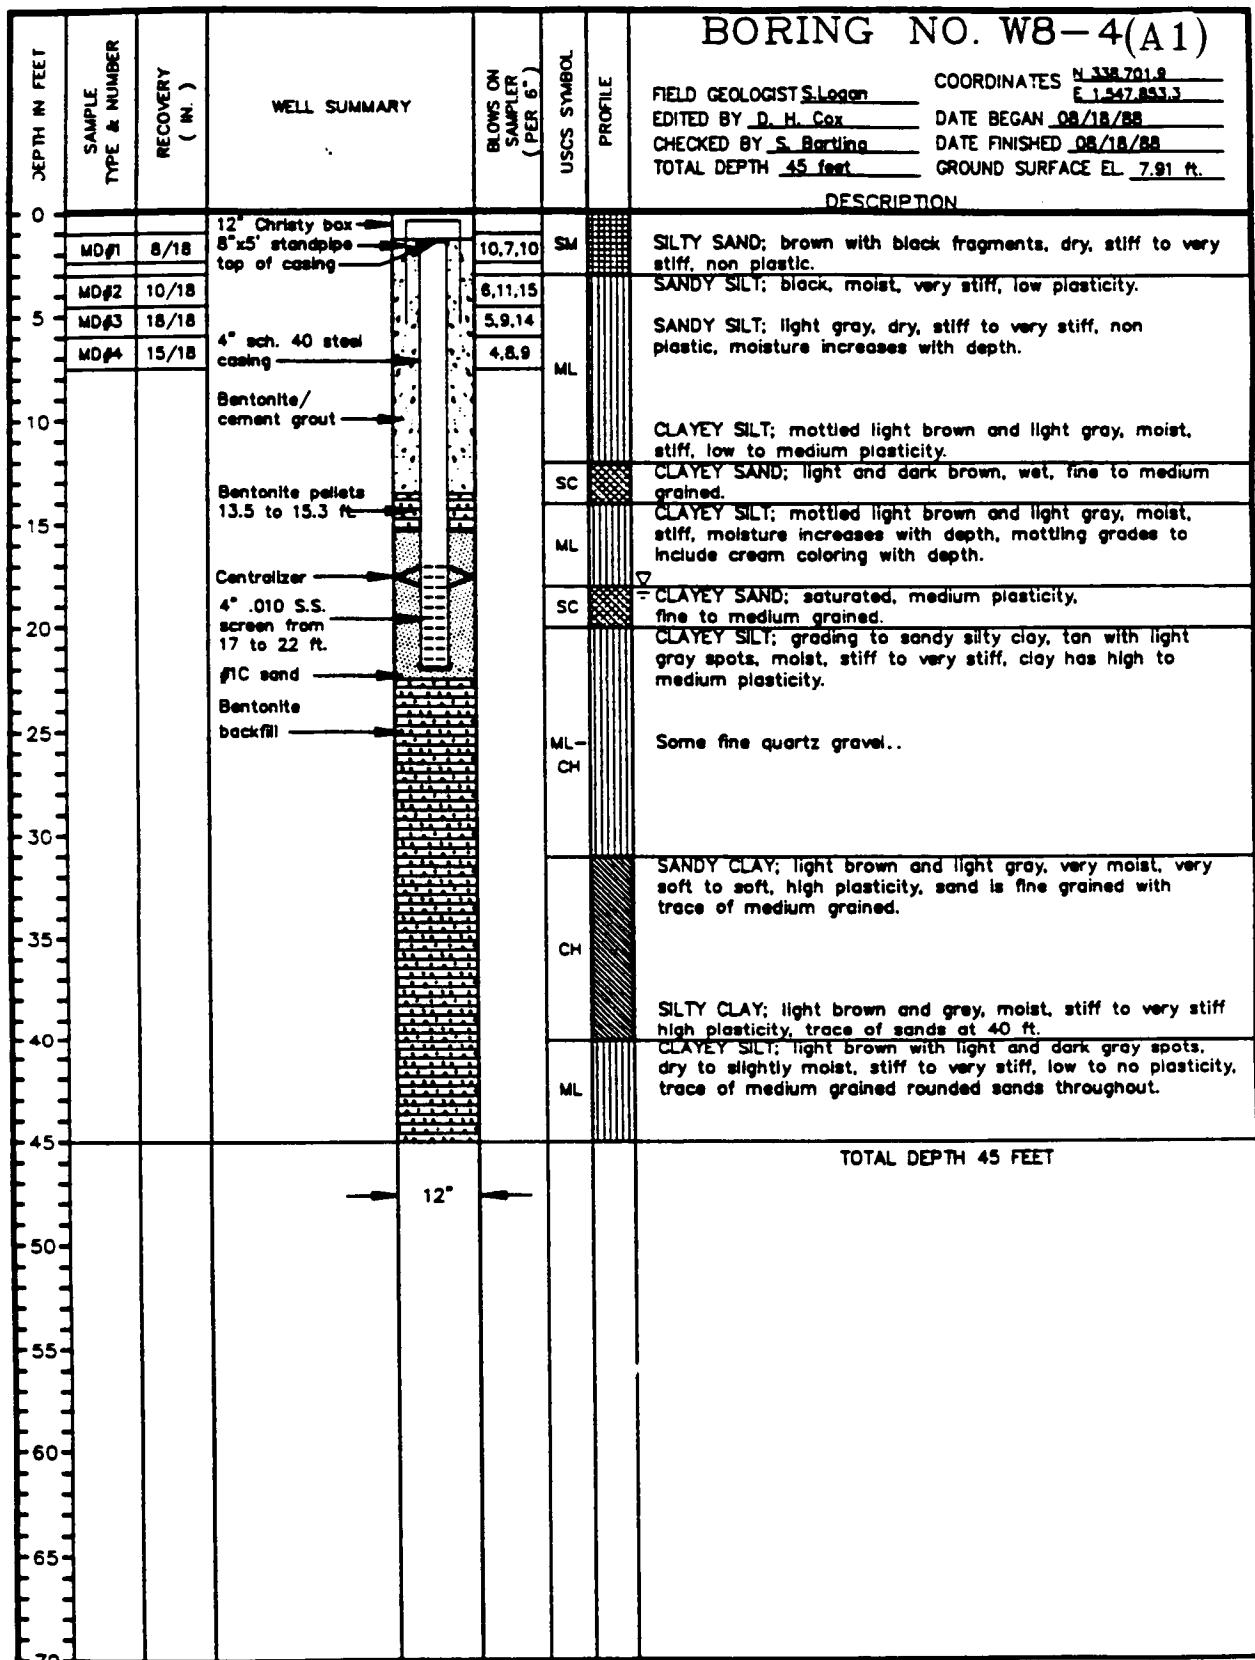

DRILLING CO.: Water Development Co.
 DRILLING METHOD: Hollow Stem Auger

SAMPLING METHODS: MD=California Modified
 S=Split Barrel

PROJECT NO.: 409616
 CLIENT: Moffett Naval Air Station
 Moffett Field, California


AutoCAD FILE: W8-4A(MF-27)

PAGE 1 OF 1



...Creating a Safer Tomorrow

SEE LEGEND FOR LOGS AND TEST PITS
 FOR EXPLANATION OF SYMBOLS AND TERMS

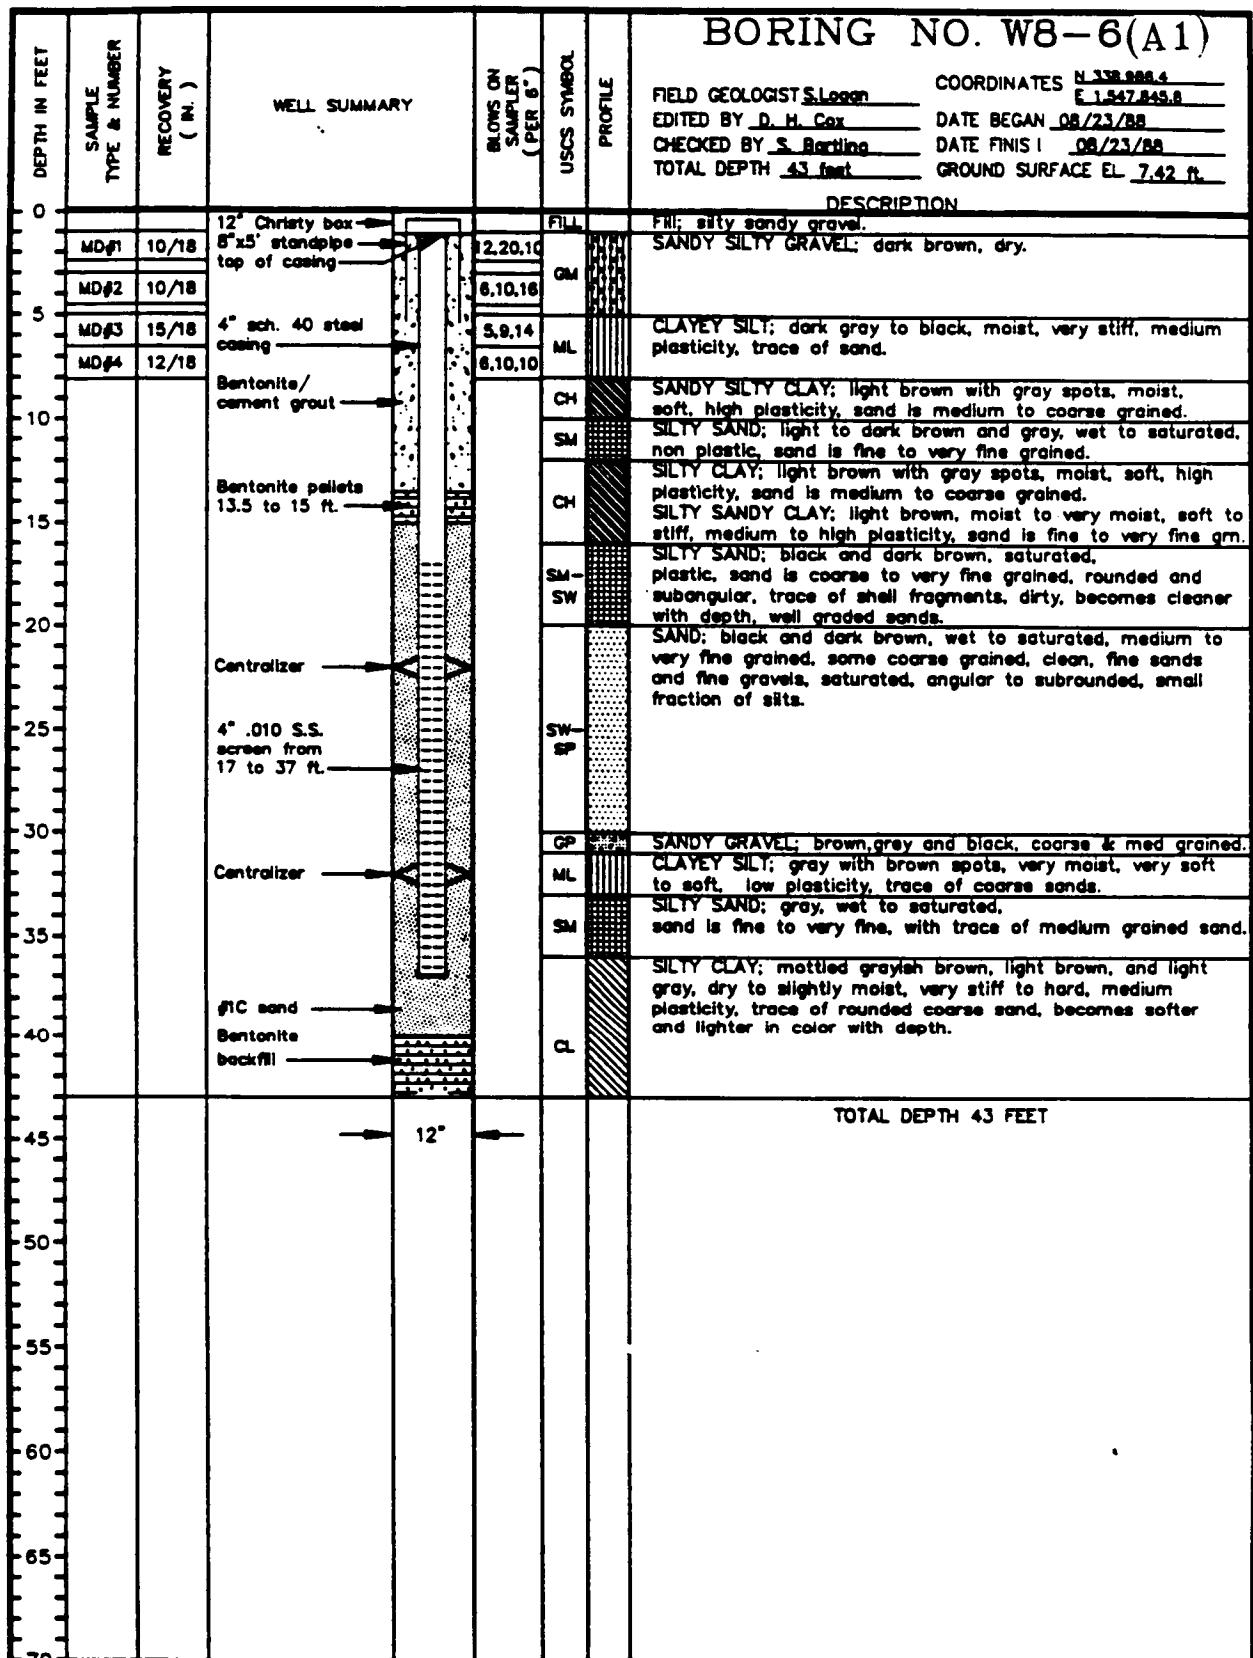

DRILLING CO.: Water Development Co.
DRILLING METHOD: Hollow Stem Auger

PAGE 1 OF 1

SAMPLING METHODS: MD=California Modified
S=Split Barrel



...Creating a Safer Tomorrow

PROJECT NO.: 409616
CLIENT: Moffett Naval Air Station
Moffett Field, California

SEE LEGEND FOR LOGS AND TEST PITS
FOR EXPLANATION OF SYMBOLS AND TERMS


DEPTH IN FEET	SAMPLE TYPE & NUMBER	RECOVERY/DRIVE (in.)	WELL SUMMARY			BLOWS ON SAMPLER	USCS	PROFILE	BORING NO. W8-8(A1)	
									PROJ. GEOL S. Bartling	COORDINATES N _____
0			Christy Box						FIELD GEOLOGIST Wessner	E _____
	MD1 12/18		Standpipe			7/11/16			EDITED BY T. Ault	DATE BEGAN 5/11/90
	MD2 12/18		Top of Casing with Locking Cap			5/7/9			CHECKED BY W. Garber	DATE FINISHED 5/11/90
5	MD3 18/18		5% Bentonite-Cement Grout			3/3/5	CL		TOTAL DEPTH 30 ft	GROUND SURFACE EL _____
			4" dia. sch. 40 Steel Casing				ML/SC		SILTY CLAY; top soil, dry crumbly.	
10			Bentonite Pellets				CL		SILTY CLAY; olive black, slightly moist, medium stiff, slightly to moderately plastic.	
			12" Borehole dia.				SC		SILTY CLAY; dusky yellow, moderately moist, soft, high plasticity, some coarse sand inclusions.	
15			#1C Sand				CL		SILTY CLAY-CLAYEY SILT; dusky yellow, moderately moist, soft, medium plasticity, fine to medium pebble inclusions of calcite.	8.0'
20			Centralizer				SP		CLAYEY SANDY SILT; dusky yellow, moist, very soft, low plasticity, some fine pebble inclusions.	10.5'
			4" dia. sch. 40 S.S. Screen .020" Slot				CL		CLAY (drill rate).	
25							CL		Cutting returns intermittent slurry.	14.0'
							CL		SAND zone (drill rate).	16.0'
30							CL		SILTY CLAY, (drill rate), soft.	
							CL		SAND, returns mixed slurry with fine grained sands.	20.0'
							CL		CLAY (drill rate).	27.0'
							CL		SILTY CLAY; moderately yellowish brown, moist, soft, plastic.	
									TOTAL DEPTH 30 FEET	
35										
40										
45										
50										
55										
60										
65										
70										

DRILLING CO.: Water Developement
DRILL METHOD: Hollow Stem Auger (Rig CME-55)

PAGE 1 OF 1

PROJECT NO.: 409700
CLIENT: Moffett Naval Air Station
LOCATION: Moffett Field, California

SEE LEGEND FOR LOGS AND TEST PITS
FOR EXPLANATION OF SYMBOLS AND TERMS

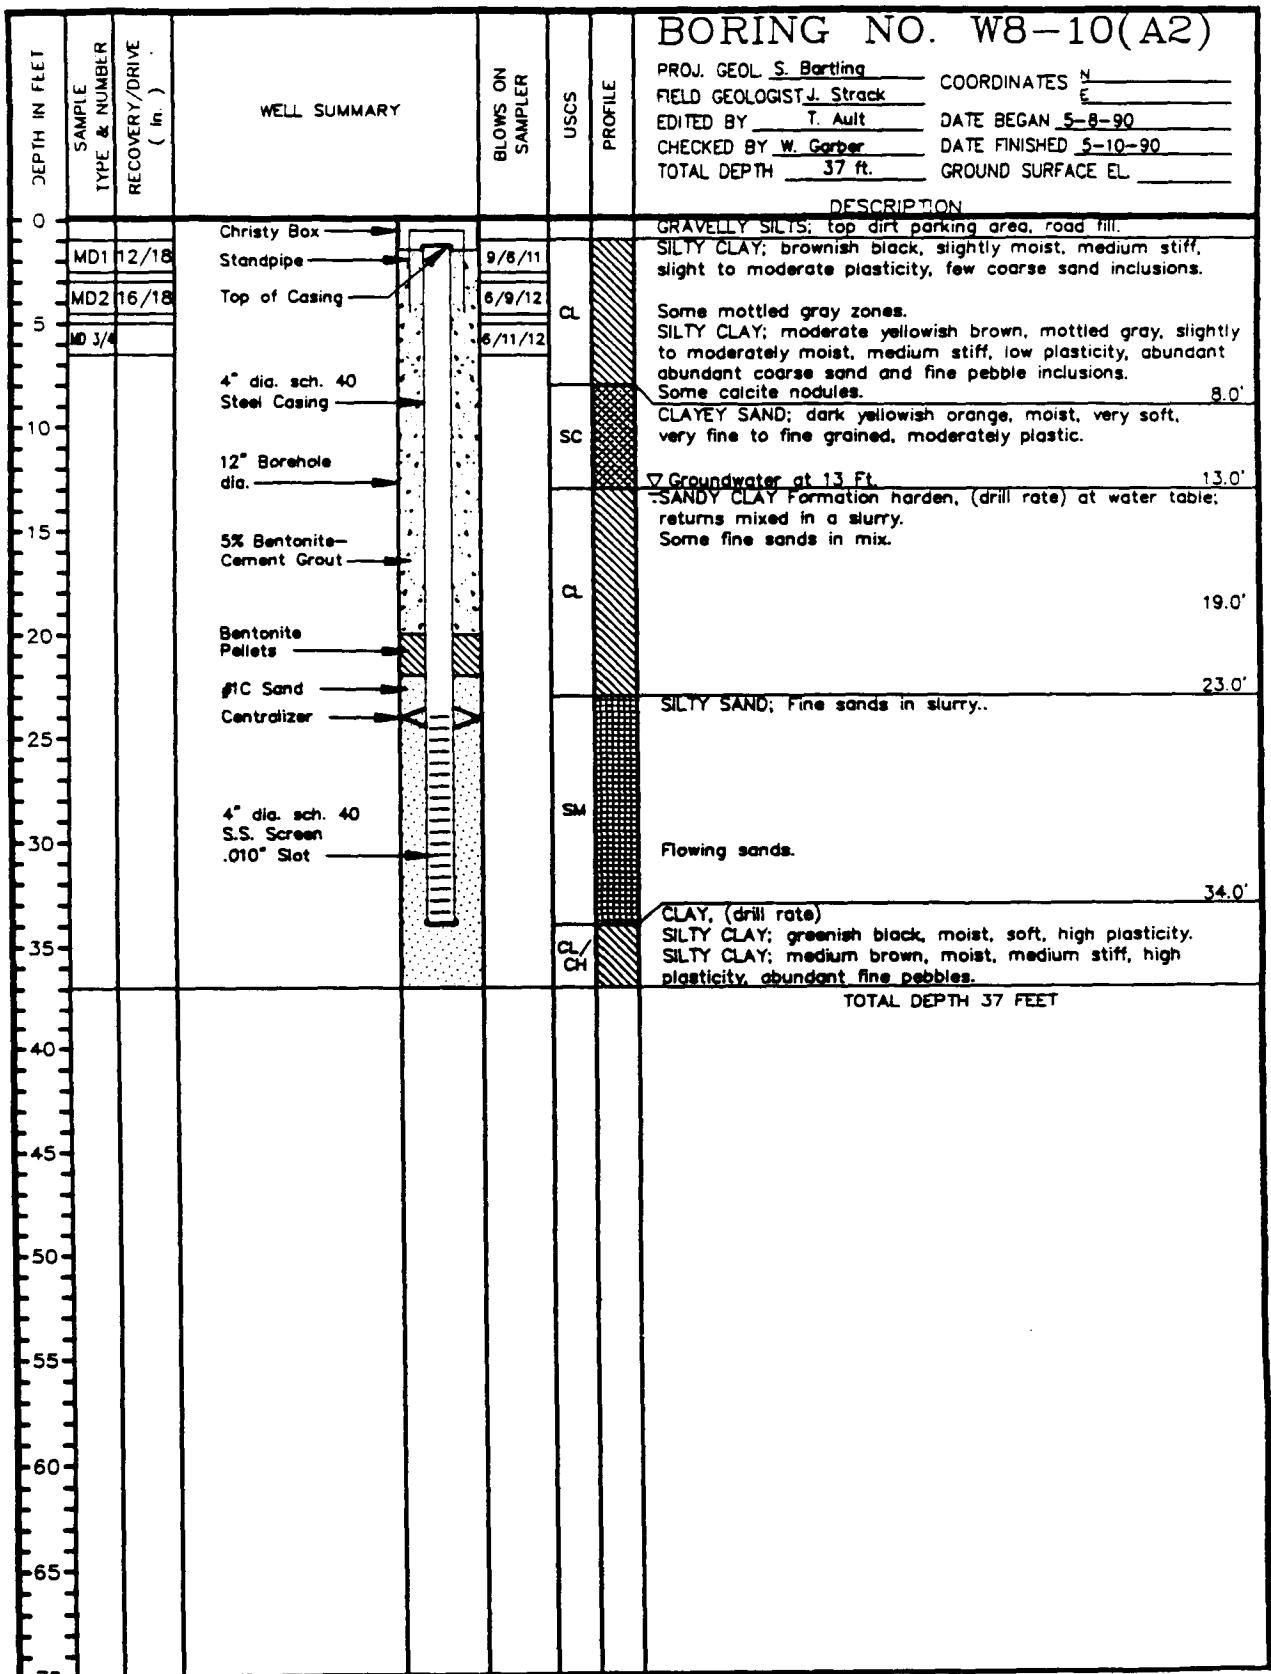


DRILLING CO.: Water Developement
DRILL METHOD: Hollow Stem Auger (Rig CME-55)

PAGE 1 OF 1

PROJECT NO.: 409700
CLIENT: Moffett Naval Air Station
LOCATION: Moffett Field, California

SEE LEGEND FOR LOGS AND TEST PITS
FOR EXPLANATION OF SYMBOLS AND TERMS

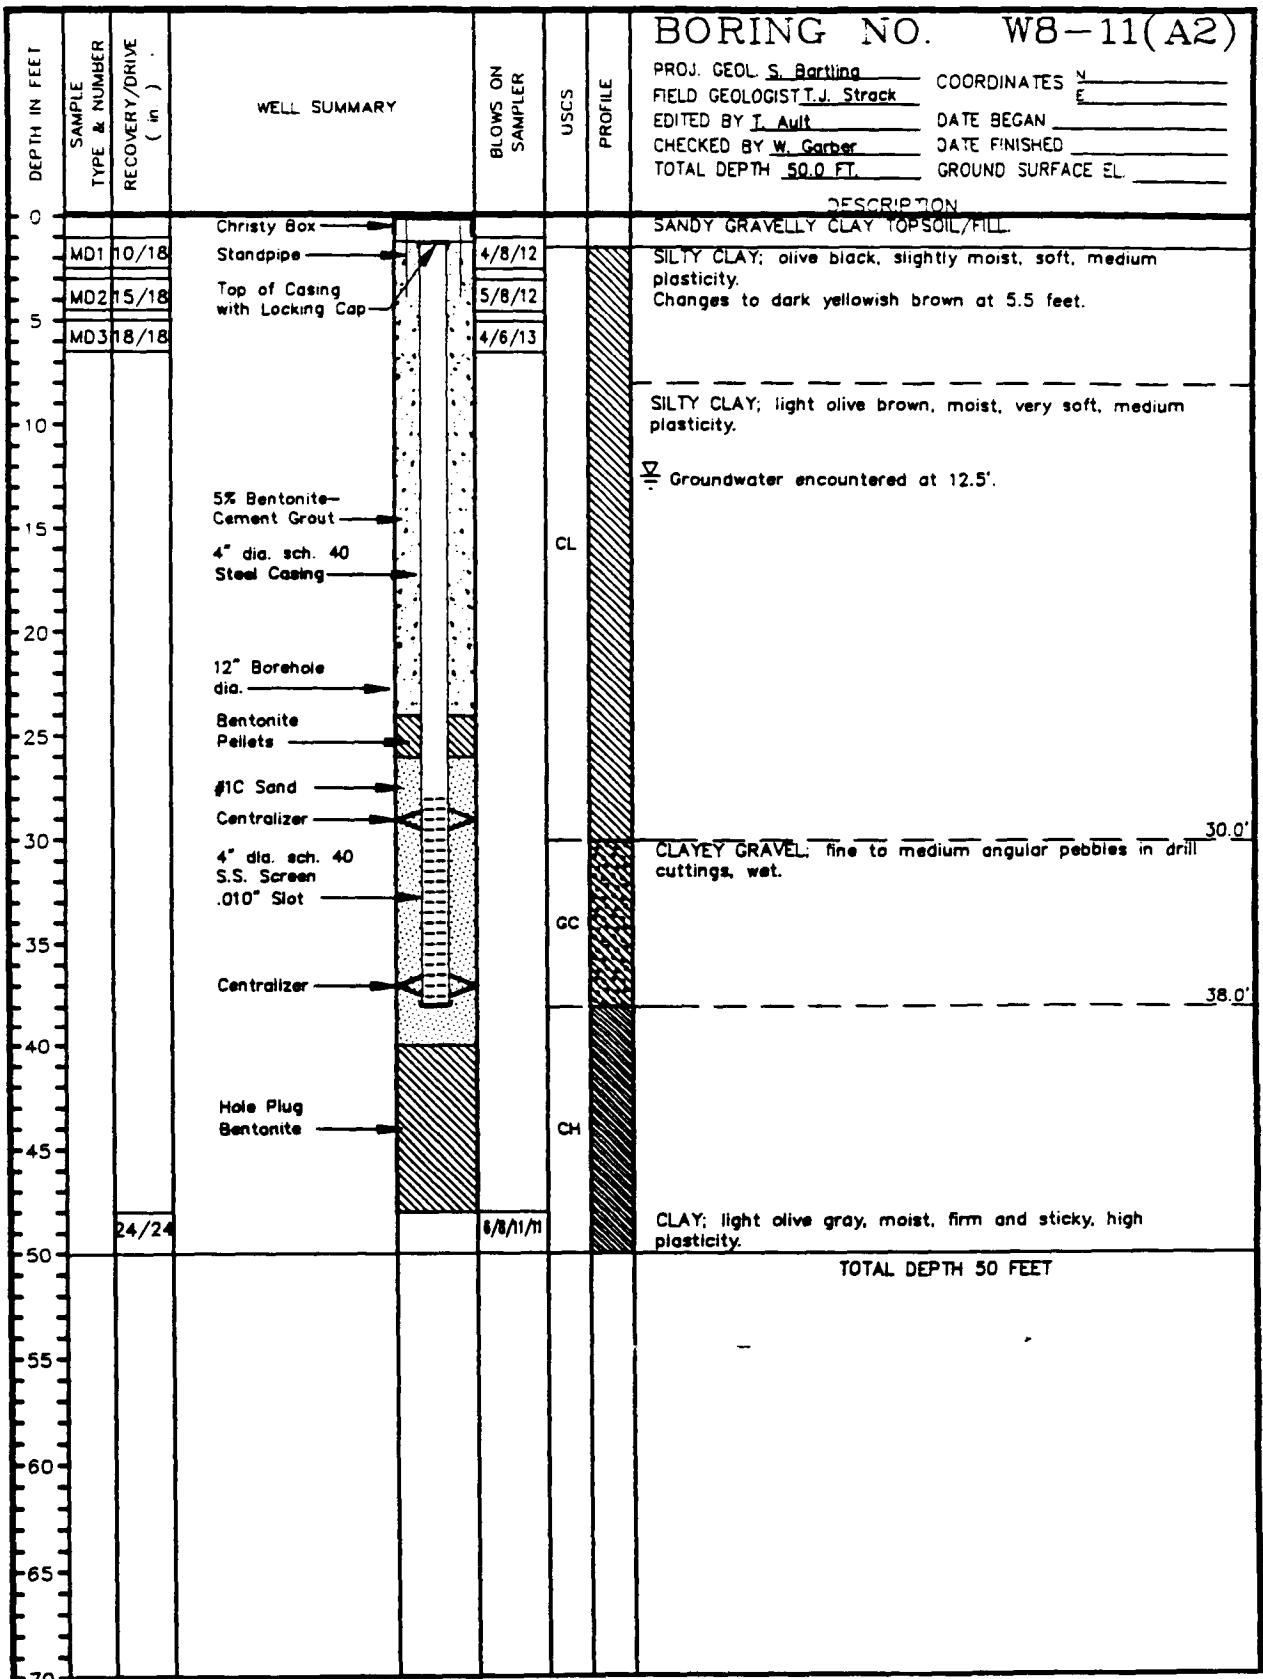

DRILLING CO.: Water Development
DRILL METHOD: Hollow Stem Auger (RIG CME-75)


PAGE 1 OF 1

PROJECT NO.: 409700
CLIENT: Moffett Naval Air Station
LOCATION: Moffett Field, California

SEE LEGEND FOR LOGS AND TEST PITS
FOR EXPLANATION OF SYMBOLS AND TERMS



**INTERNATIONAL
TECHNOLOGY
CORPORATION**

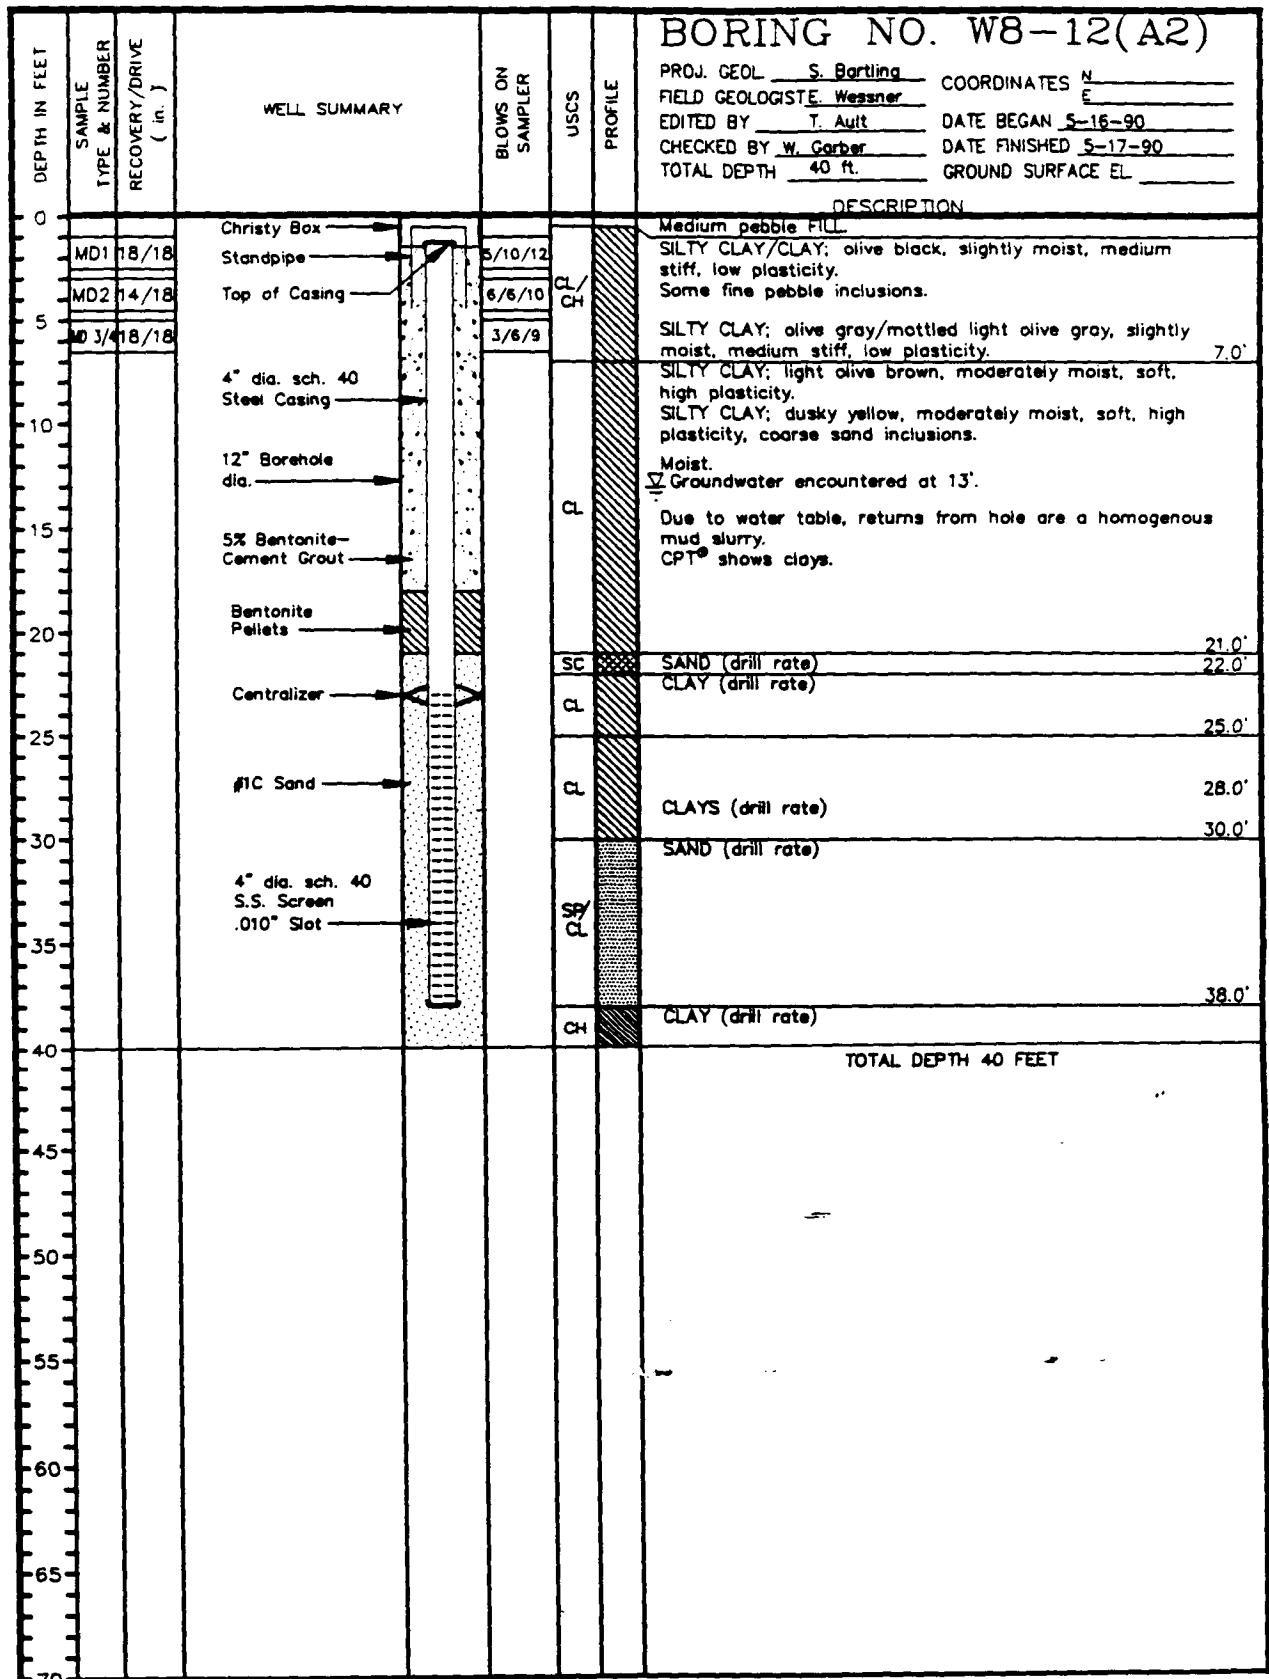


DRILLING CO.: Water Development
DRILL METHOD: Hollow Stem Auger (Rig CME-55)

PROJECT NO.: 409700
CLIENT: Moffett Naval Air Station
LOCATION: Moffett Field, California

MF-W8-12(MF14)

SEE LEGEND FOR LOGS AND TEST PITS
FOR EXPLANATION OF SYMBOLS AND TERMS

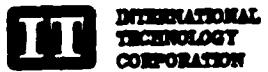

N00296.001452
MOFFETT FIELD
SSIC NO. 5090.3


**APPENDIX C – BORING LOGS
GEOPHYSICAL LOGS**

SITE 8 – CPT (IT)


**REMEDIAL INVESTIGATION REPORT
OPERABLE UNIT 4: WEST SIDE AQUIFERS**

DATED 01 AUGUST 1992


JOB # : 409700
DATE : 02/13/90
LOCATION : CPT/B-3
FILE # : 44

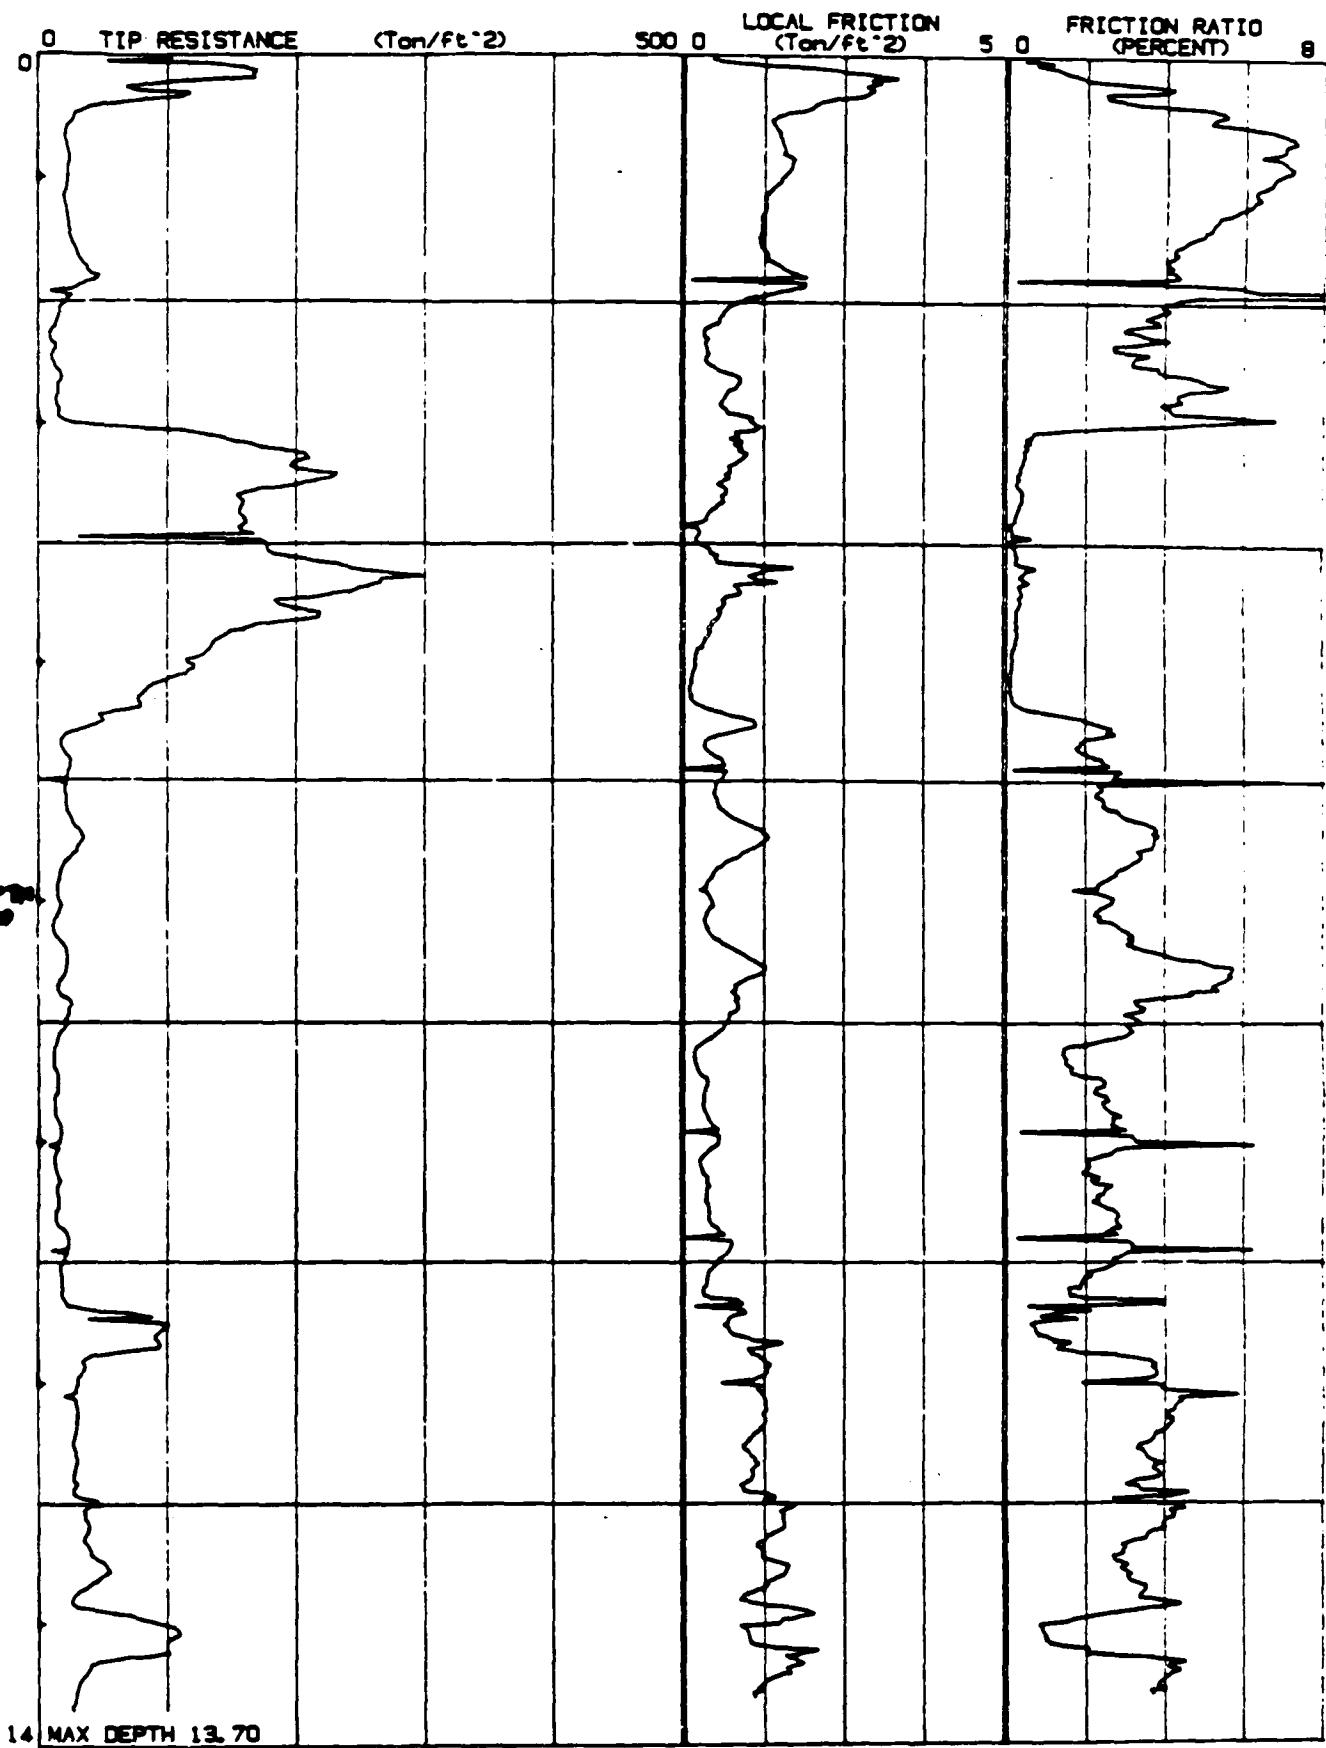


JOB # : 408700
DATE : 02/13/80
LOCATION : CPT/B-3
FILE # : 44

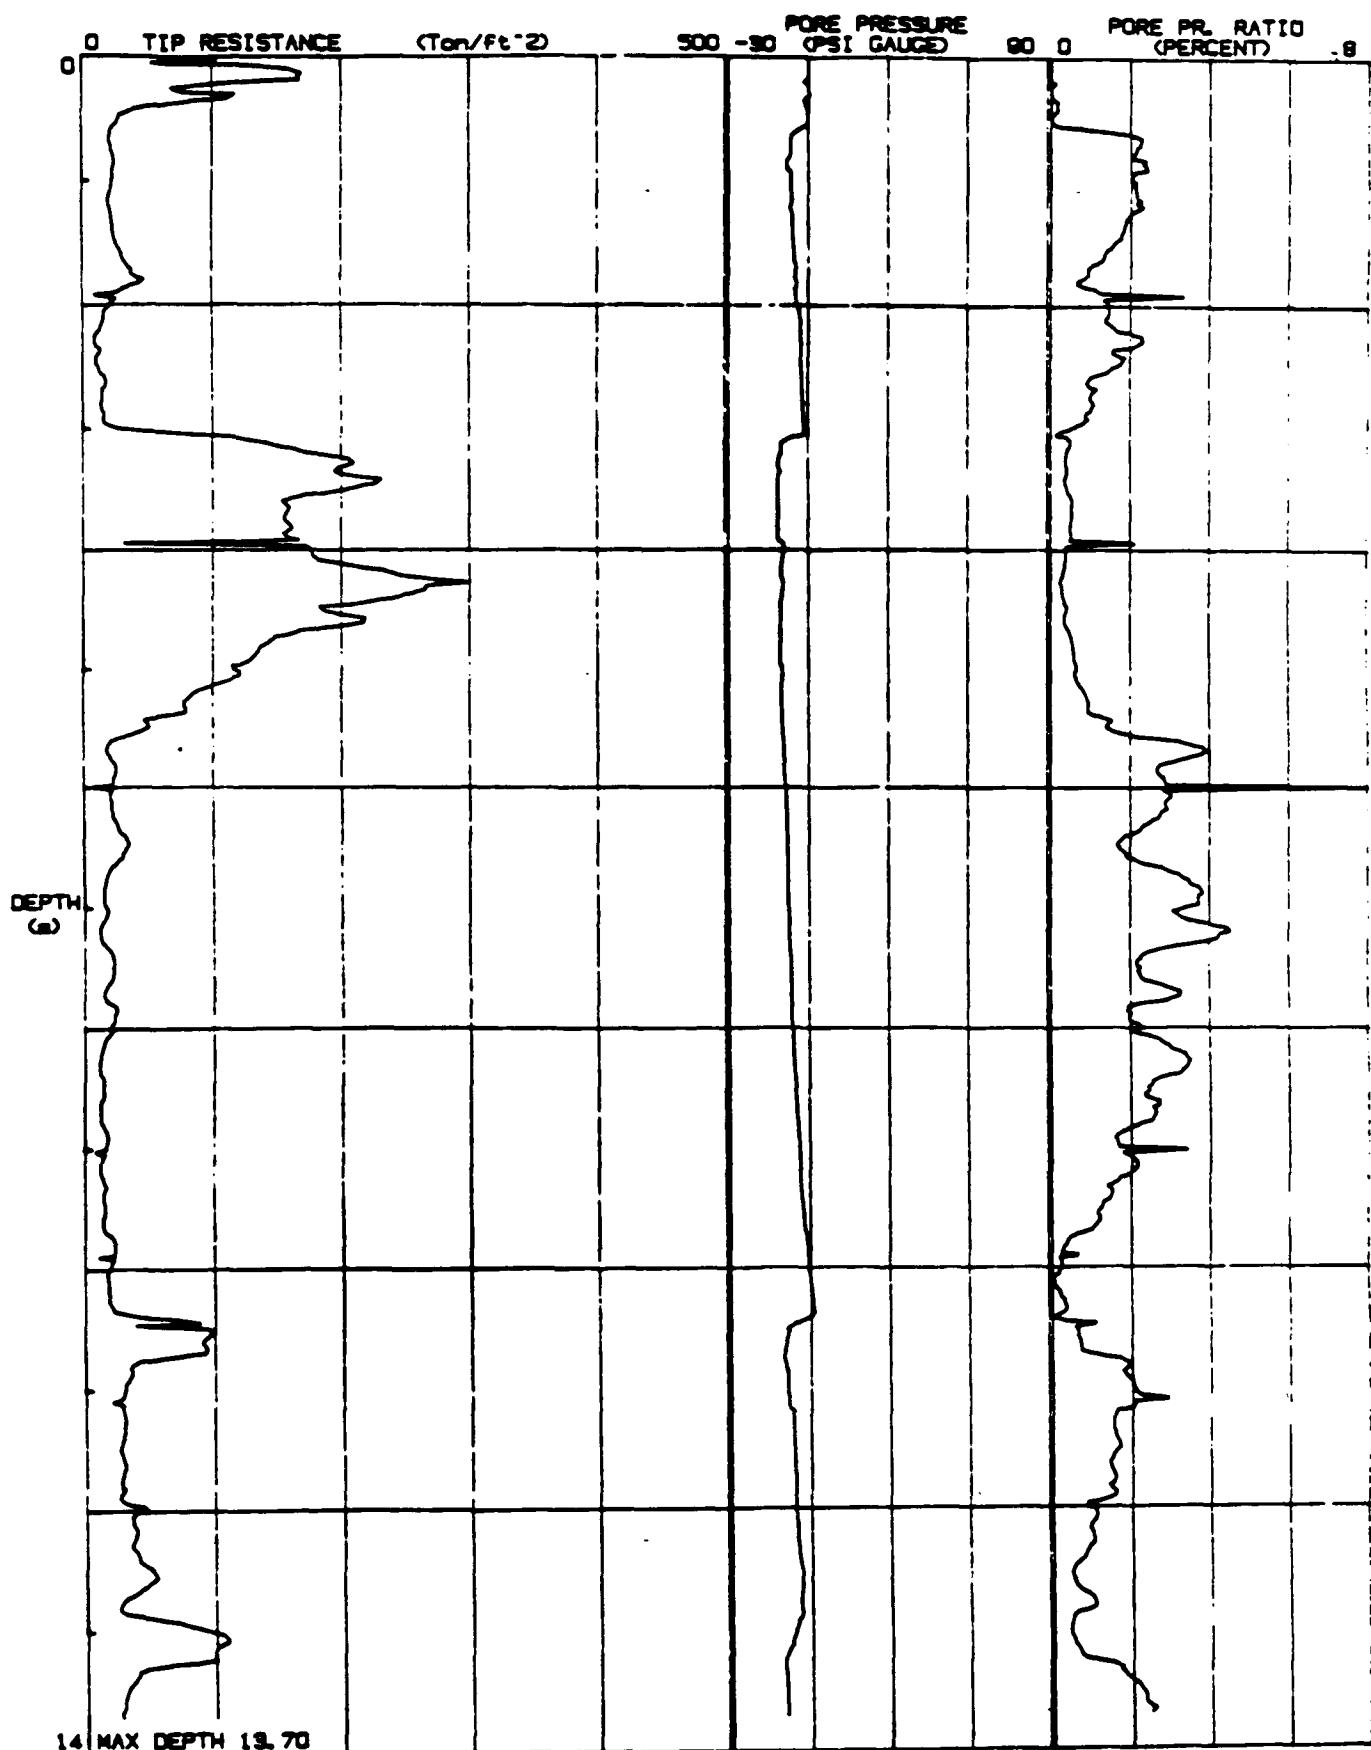


JOB # : 4C97CC
DATE : 02/08/90
LOCATION : CPT/B-5
FILE # : 36

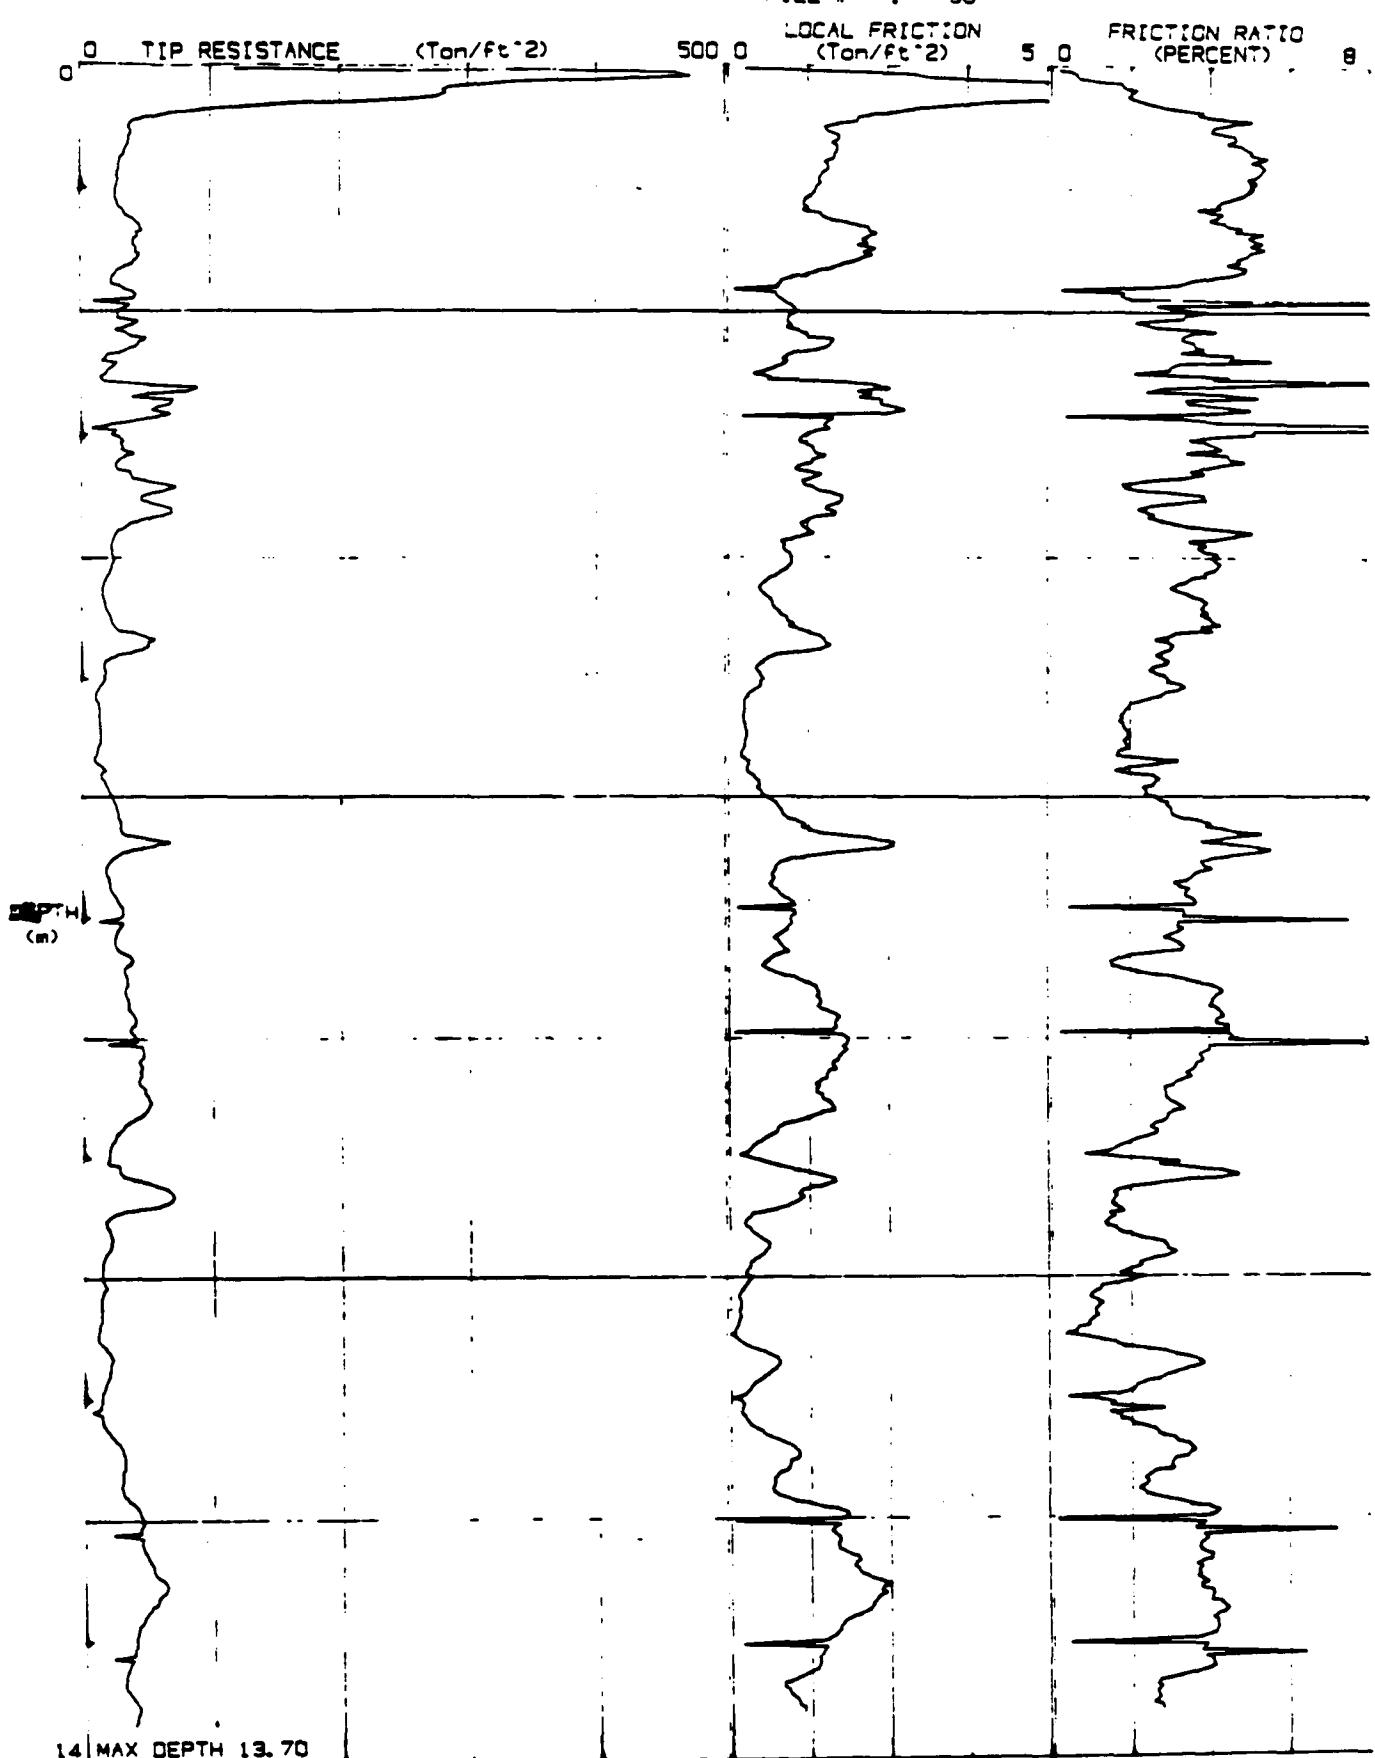


JOB # : 409700
DATE : 02/08/80
LOCATION : CPT/8-5
FILE # : 38

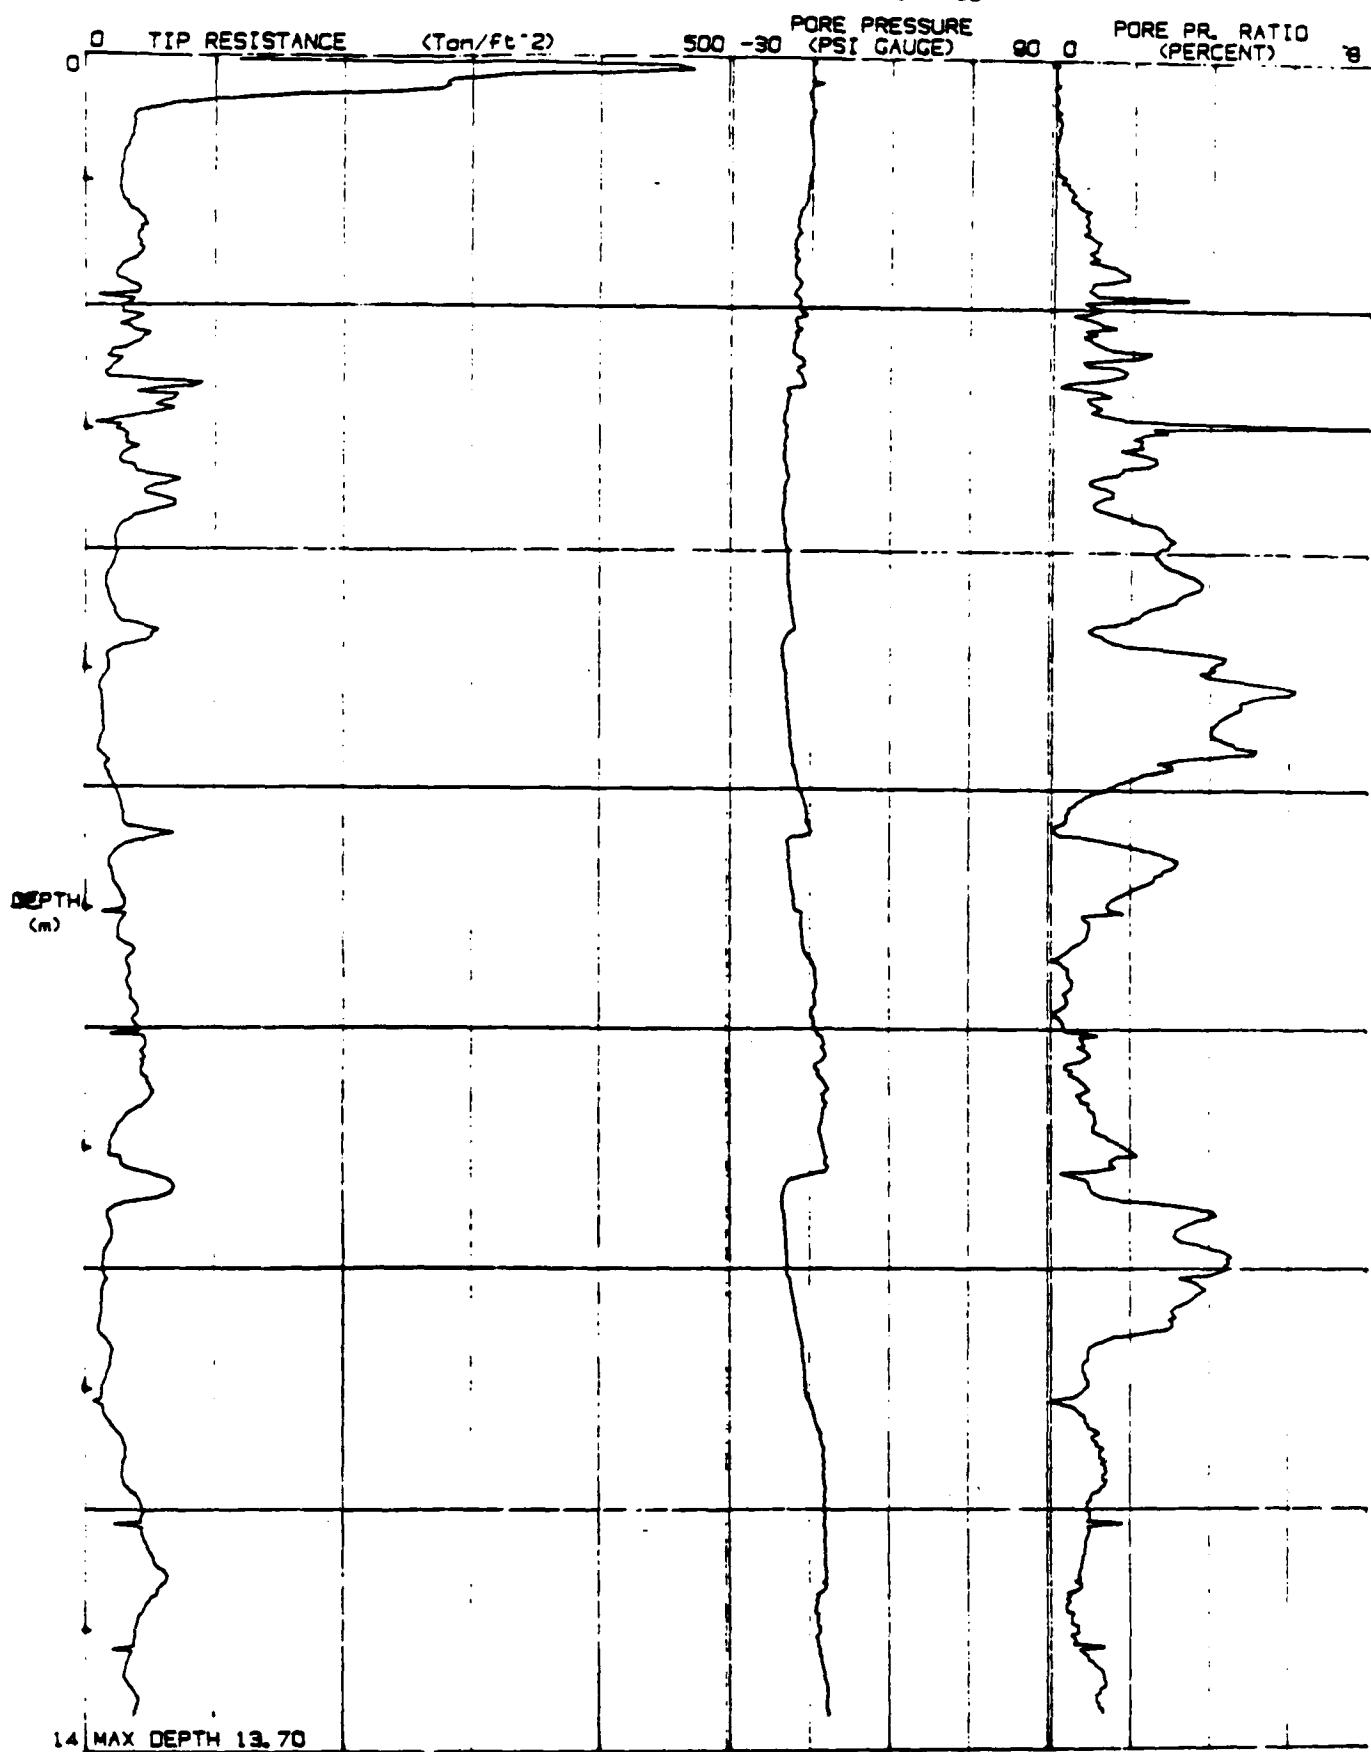


JOB # : 409700
DATE : 02/09/90
LOCATION : CPT/8-7
FILE # : 40

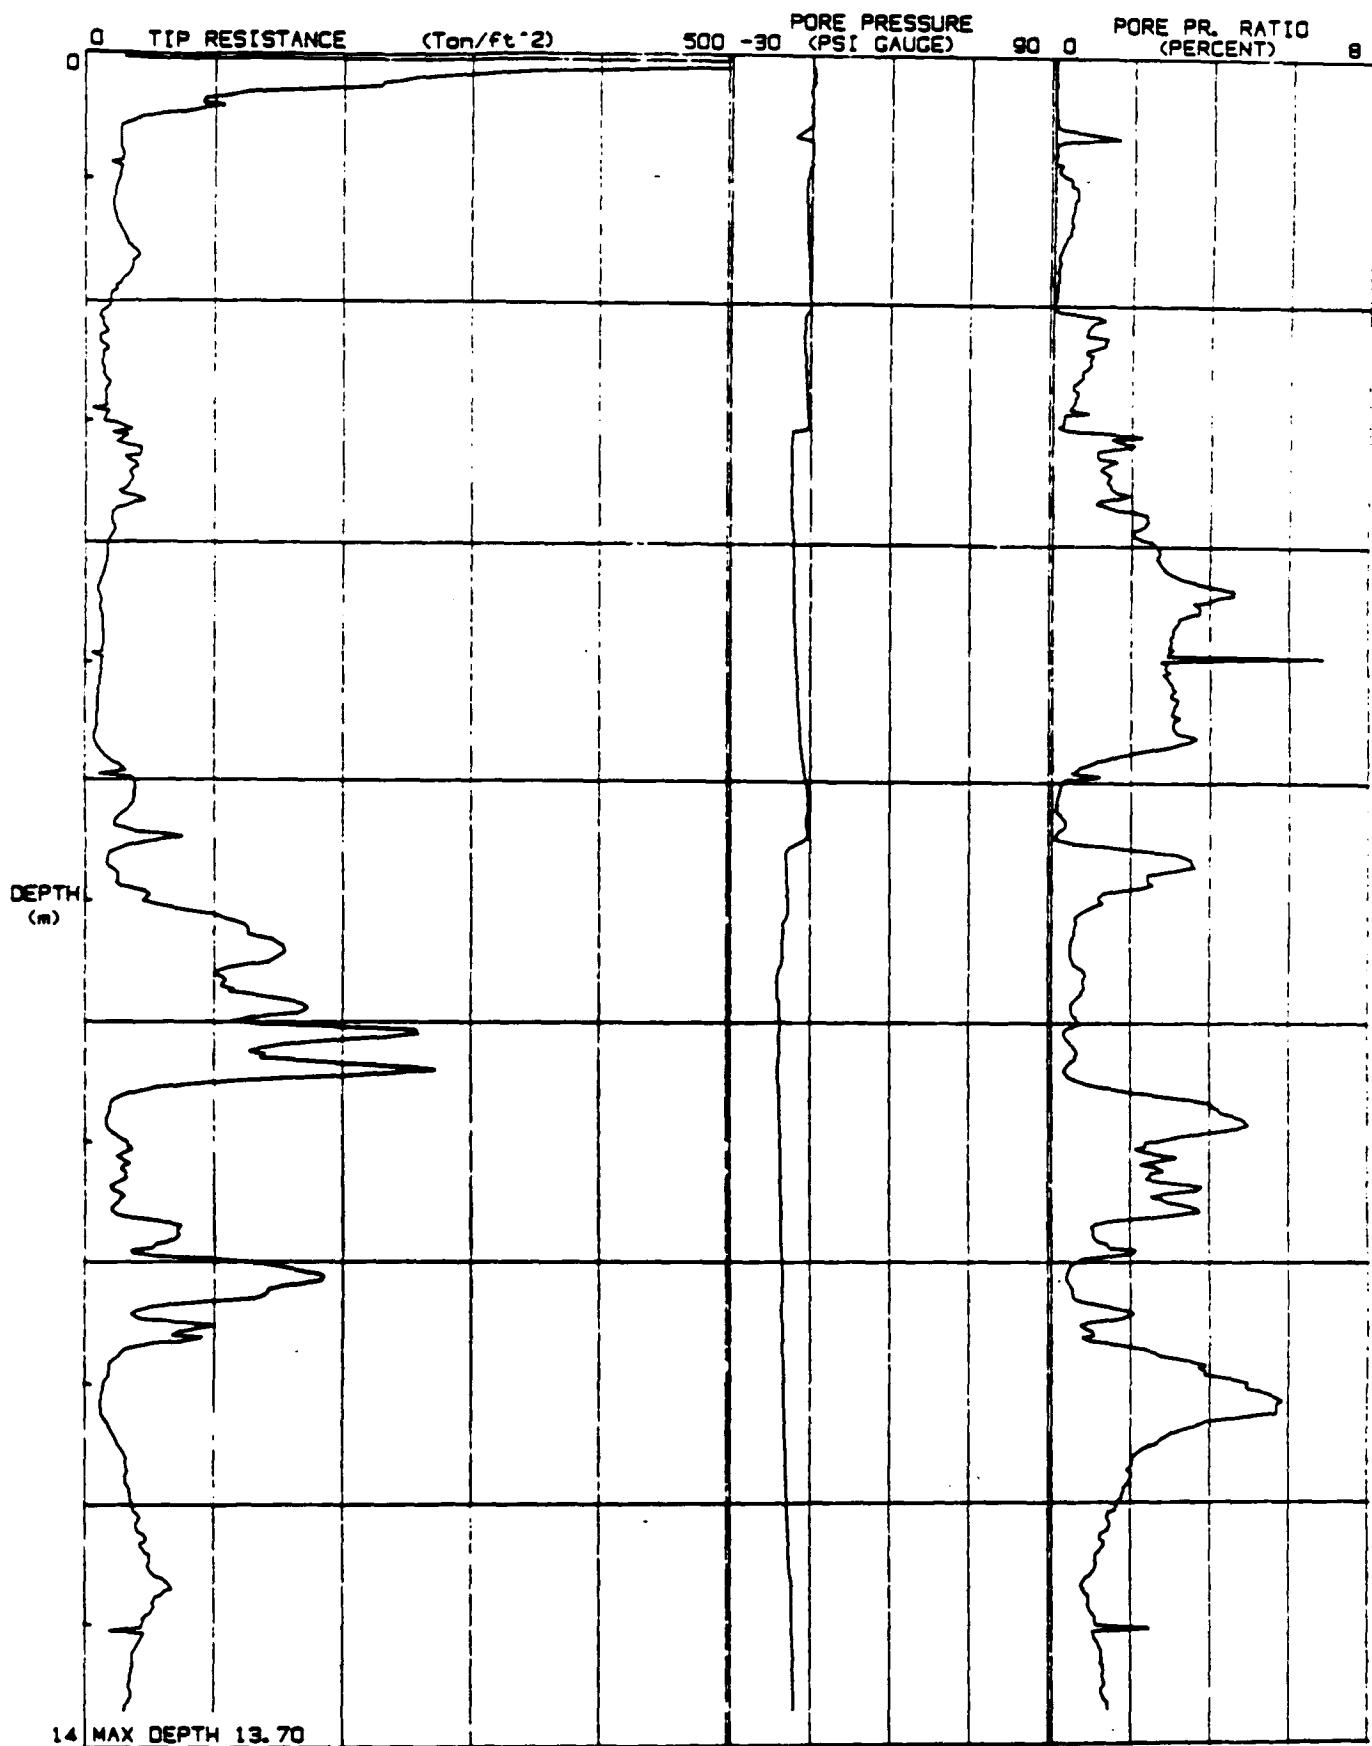


JOB # : 409700
DATE : 02/09/90
LOCATION : CPT/B-7
FILE # : 40

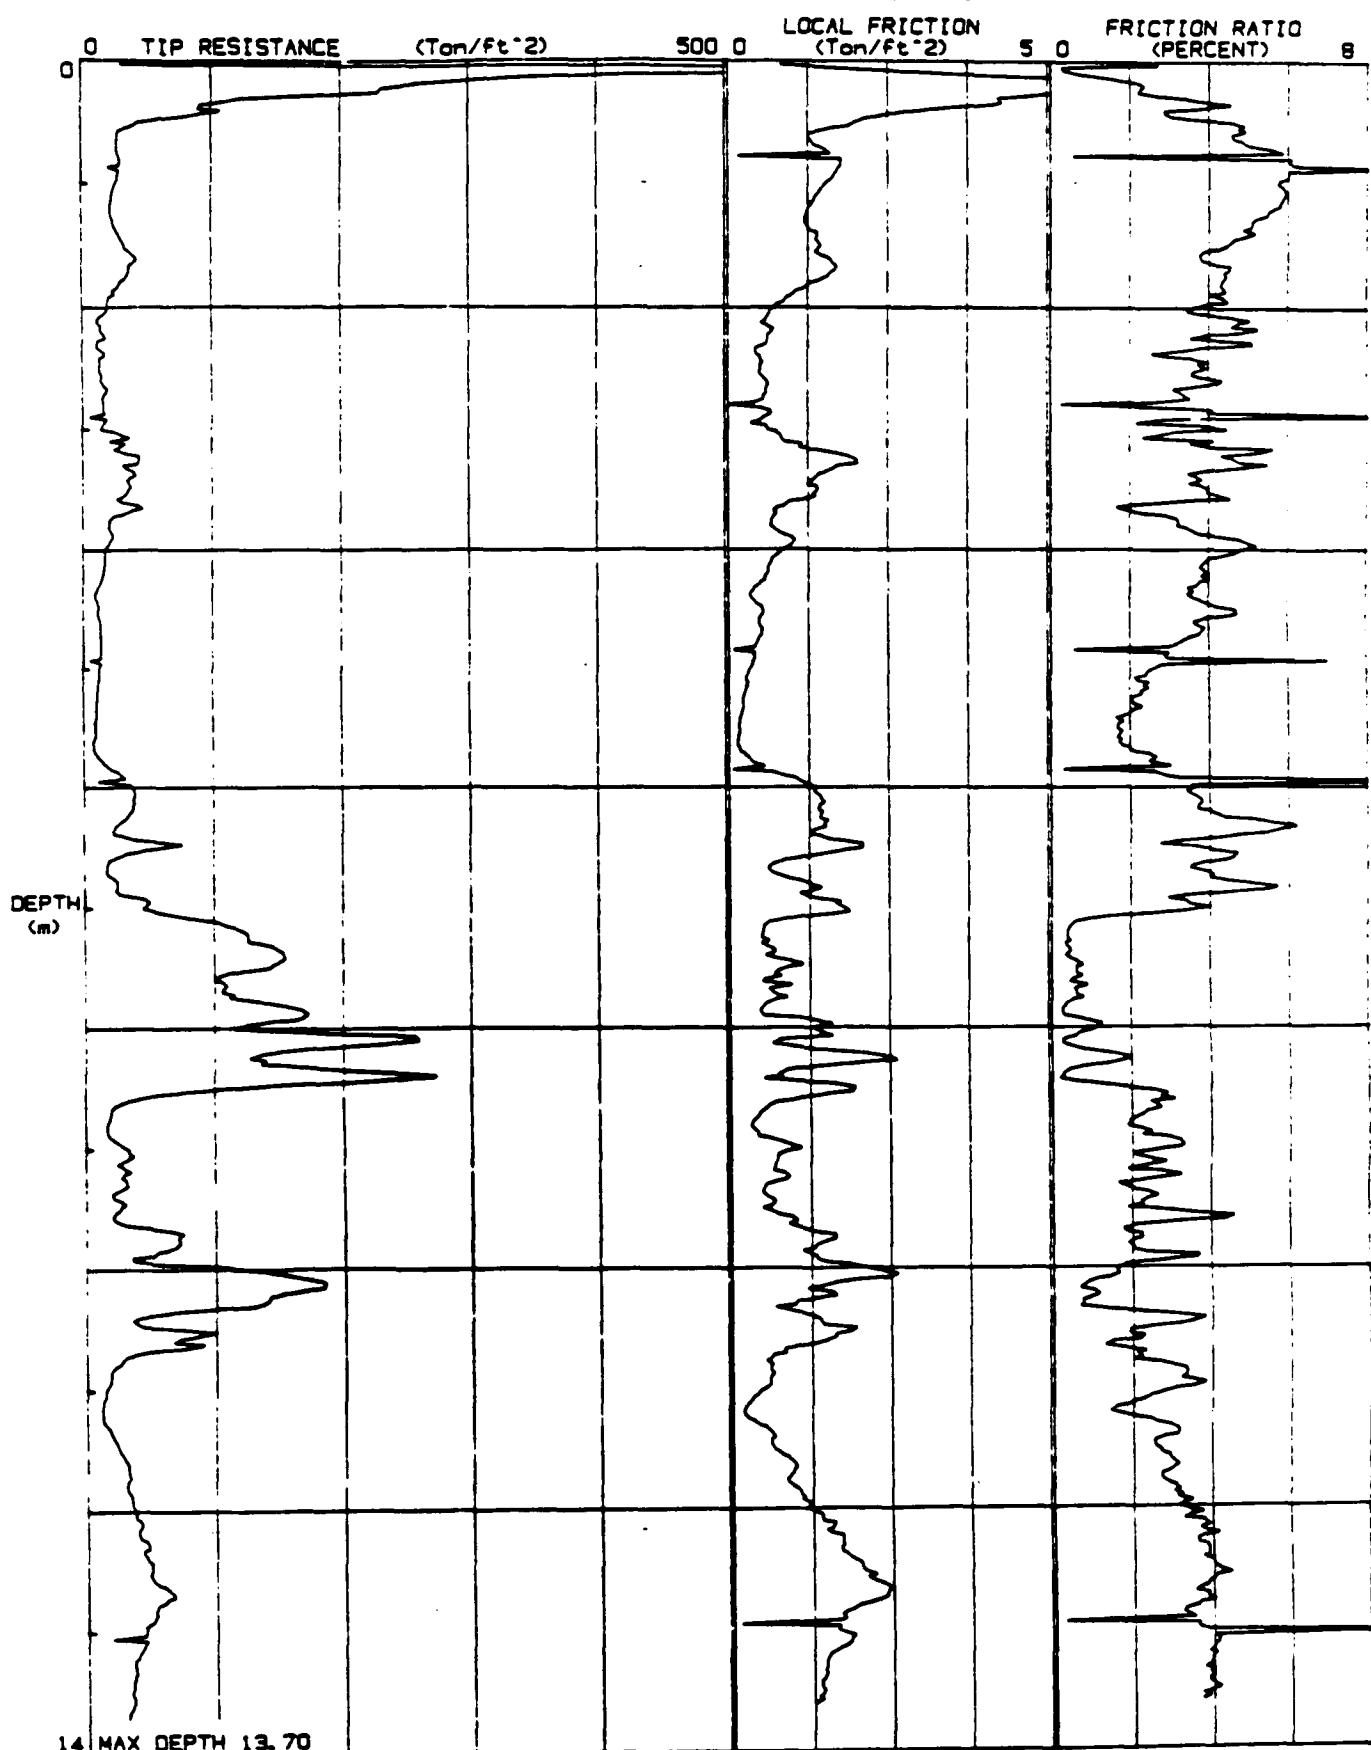


JOB # : 408700
DATE : 02/13/80
LOCATION : CPT/8-10
FILE # : 45

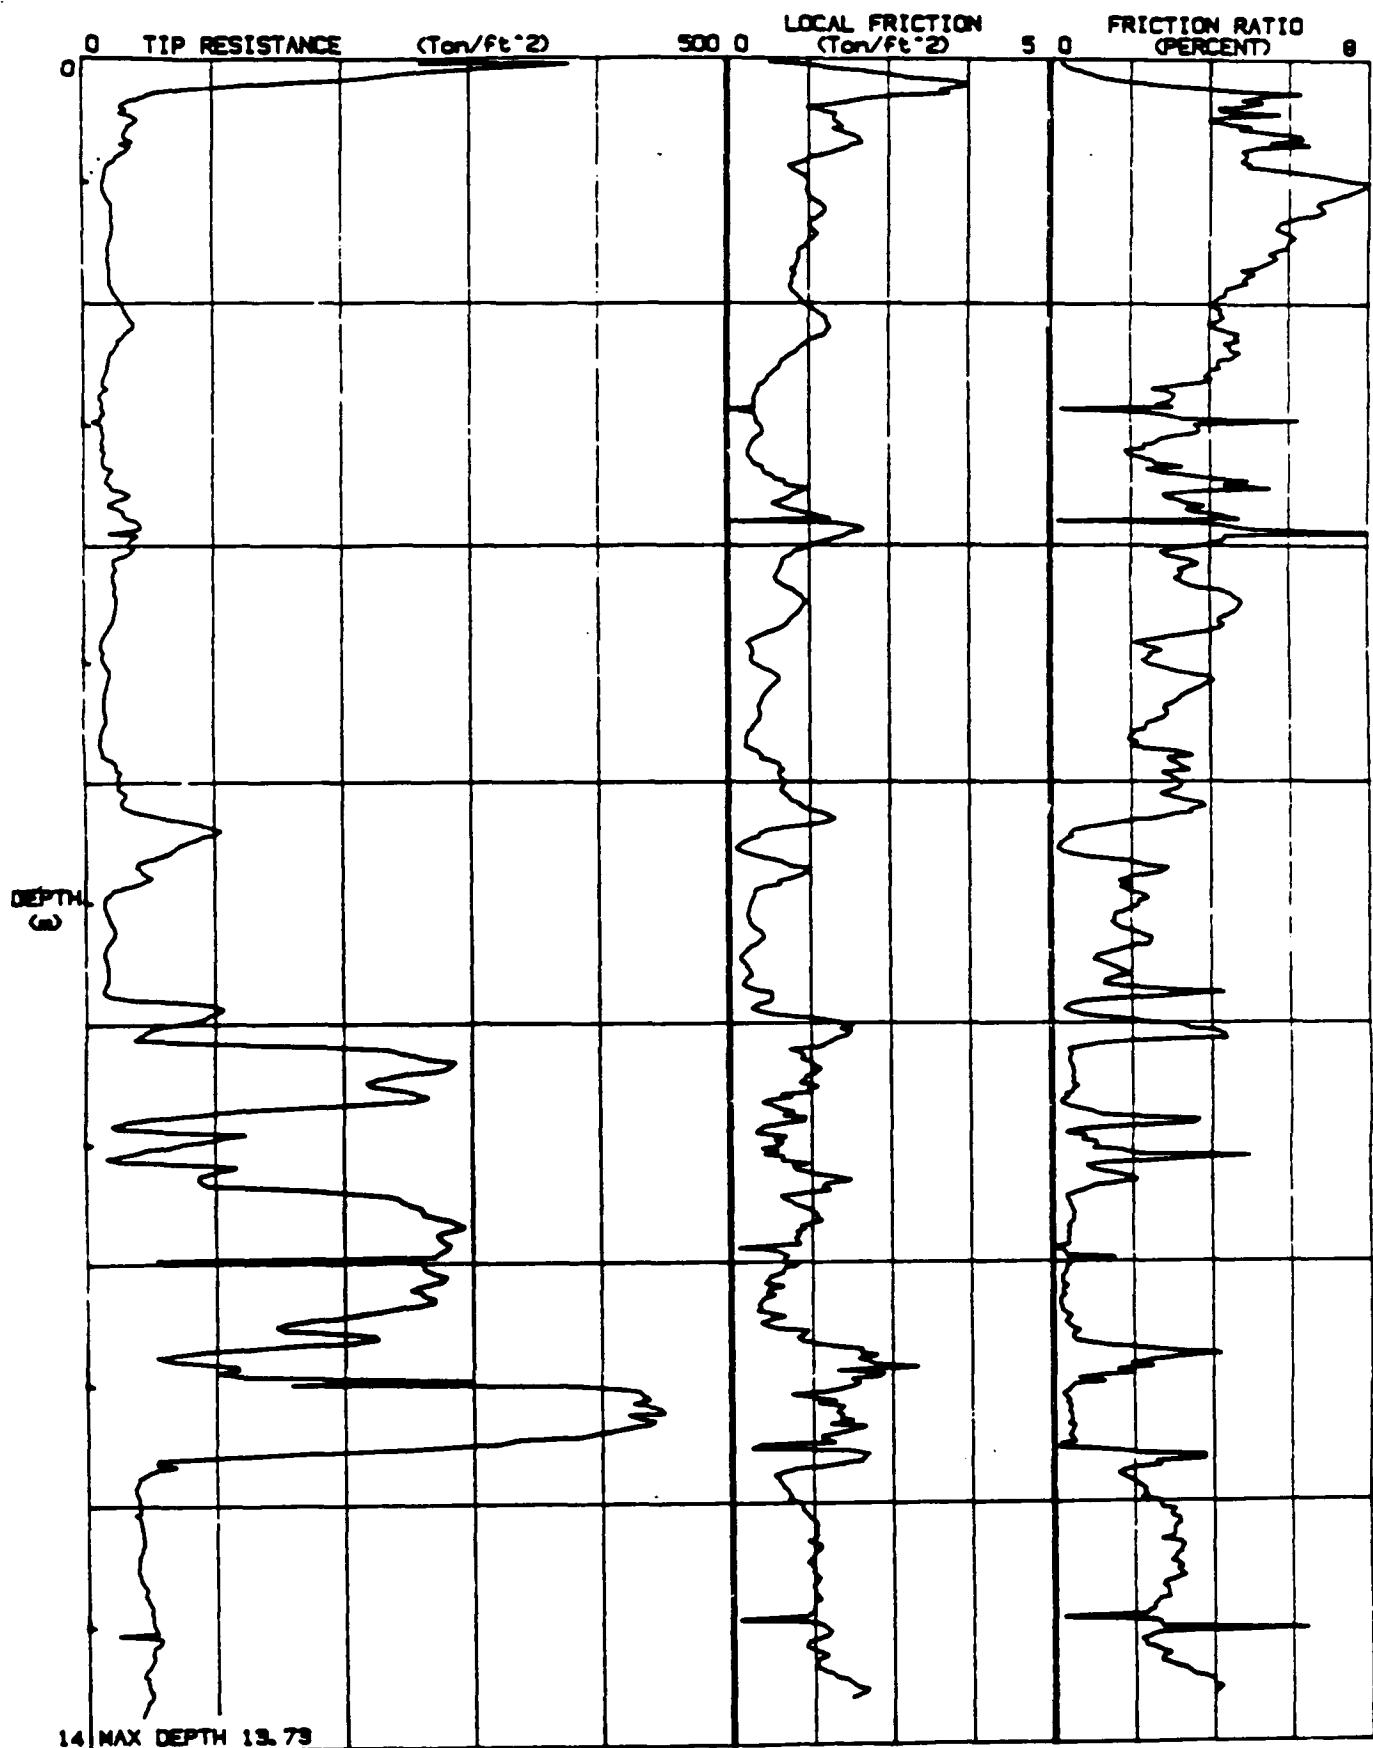


JOB # : 408700
DATE : 02/13/80
LOCATION : CPT/8-10
FILE # : 45

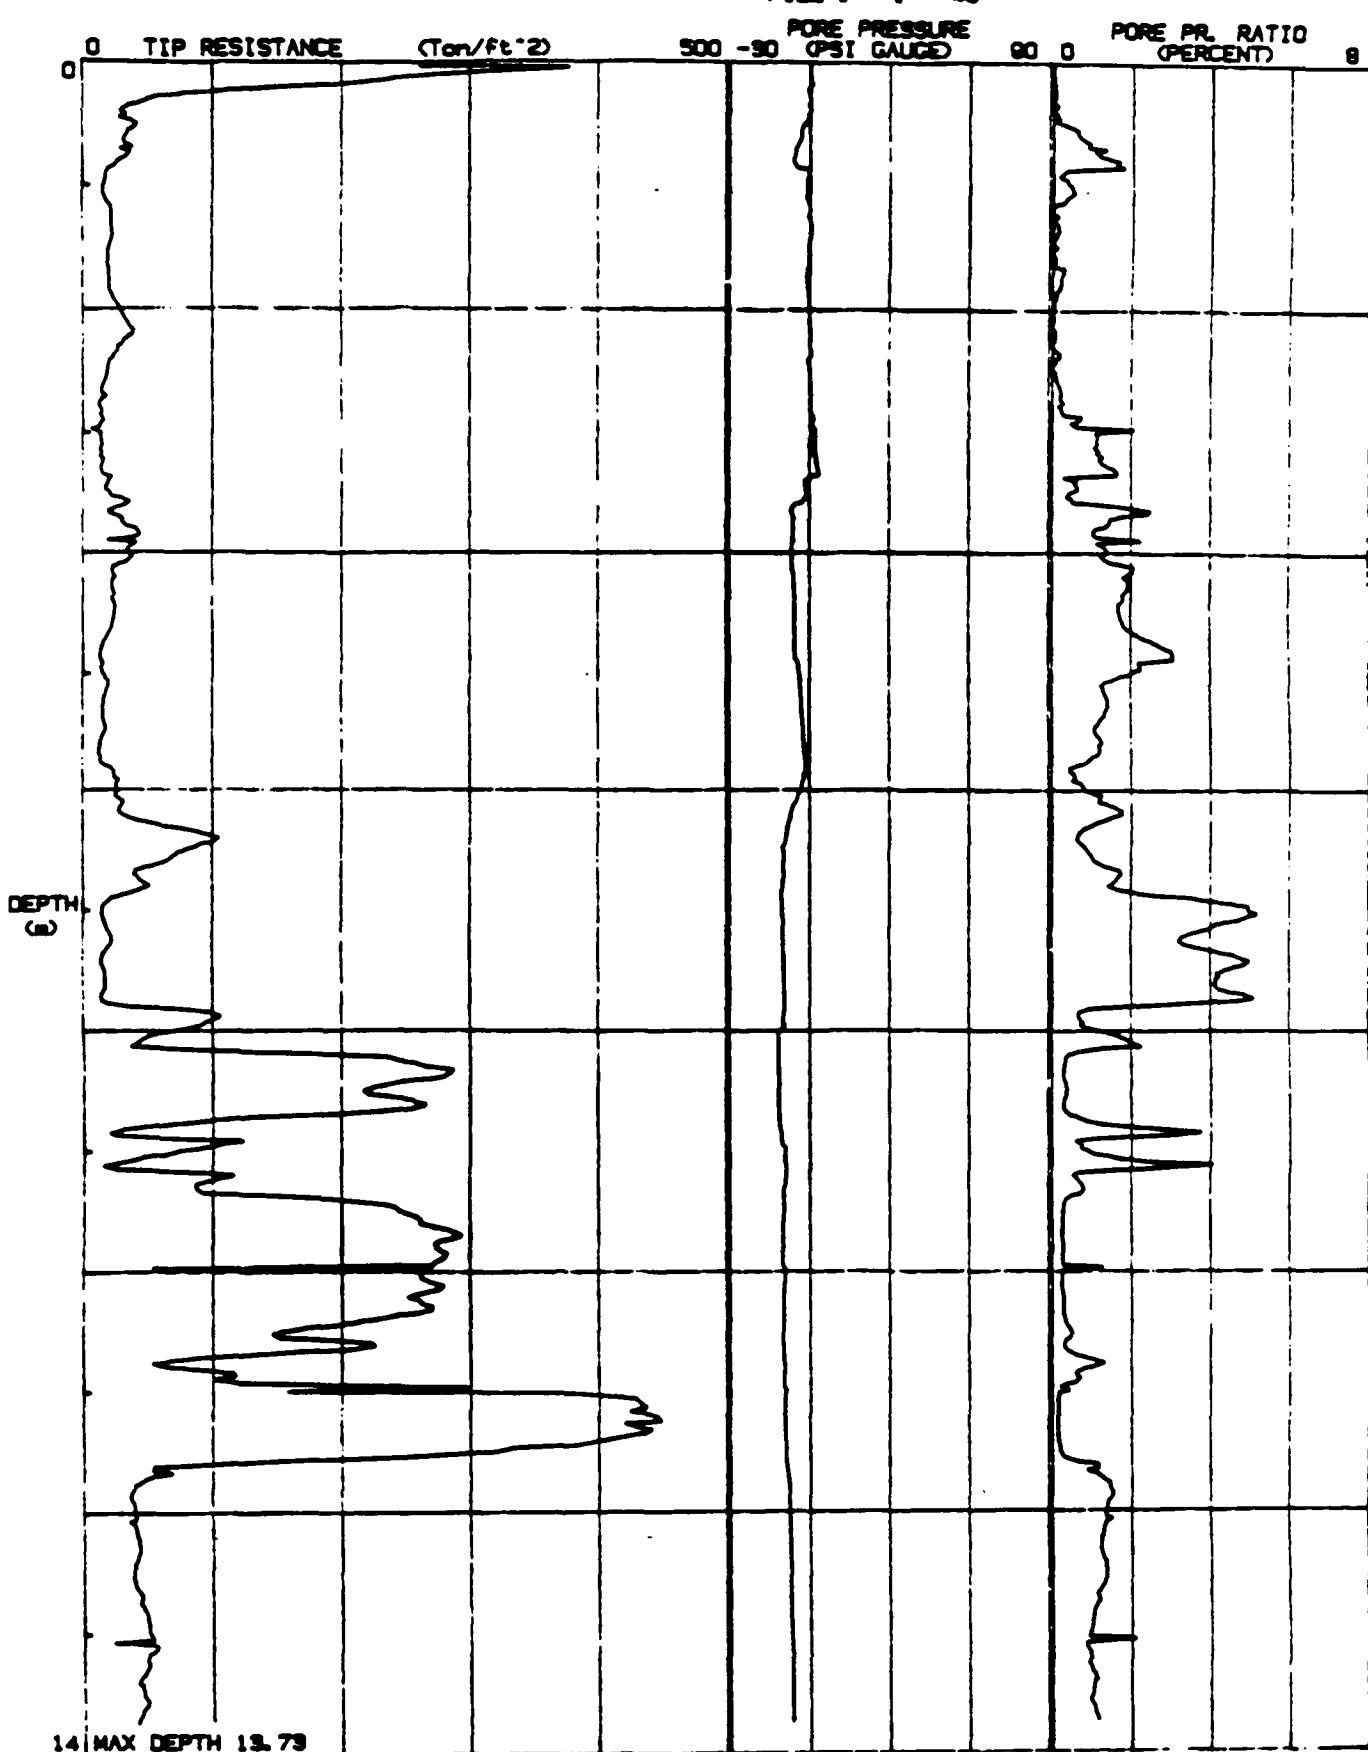


JOB # : 409700
DATE : 02/08/90
LOCATION : CPT/B-12
FILE # : 29

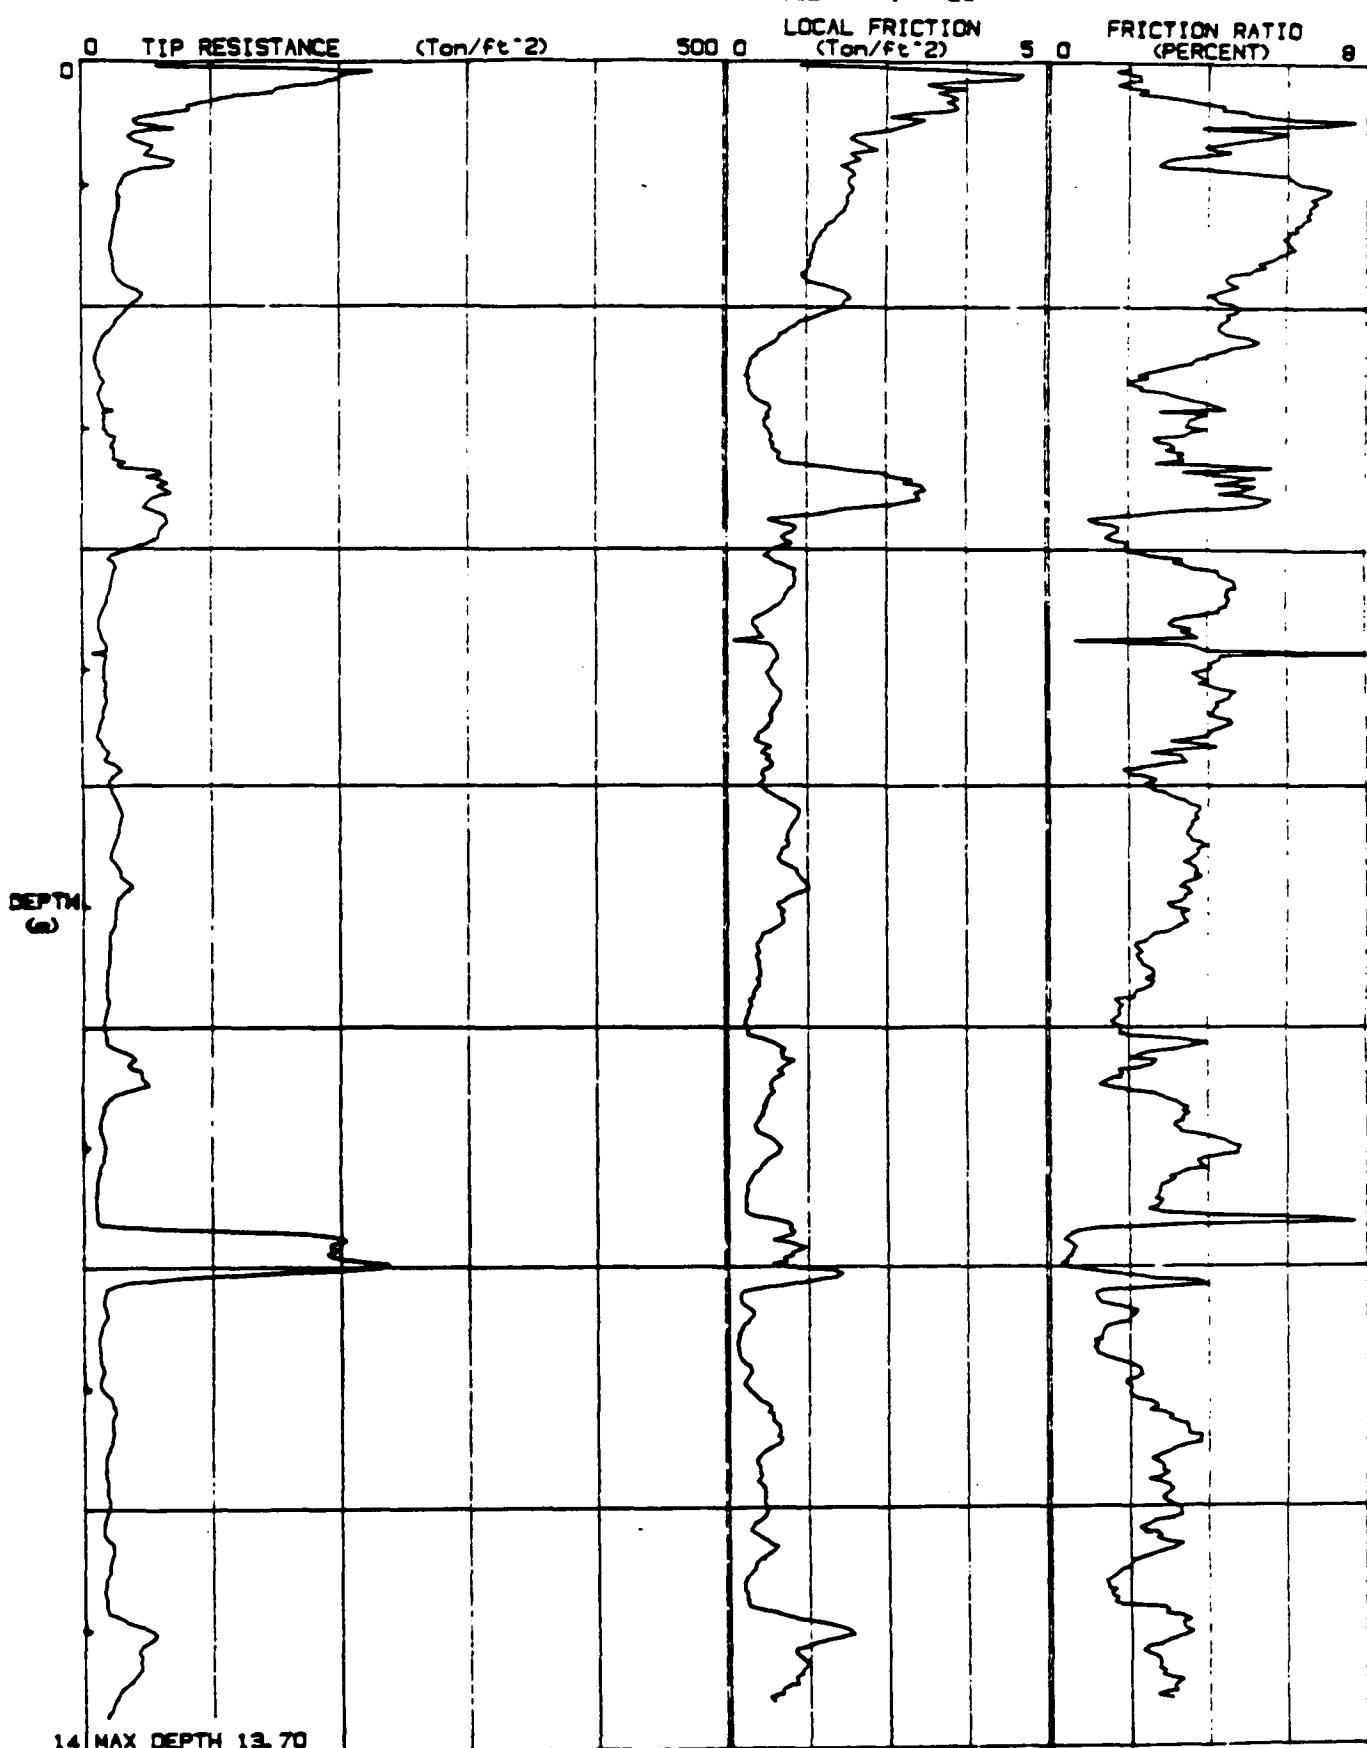


JOB # : 408700
DATE : 02/06/90
LOCATION : CPT/8-12
FILE # : 29

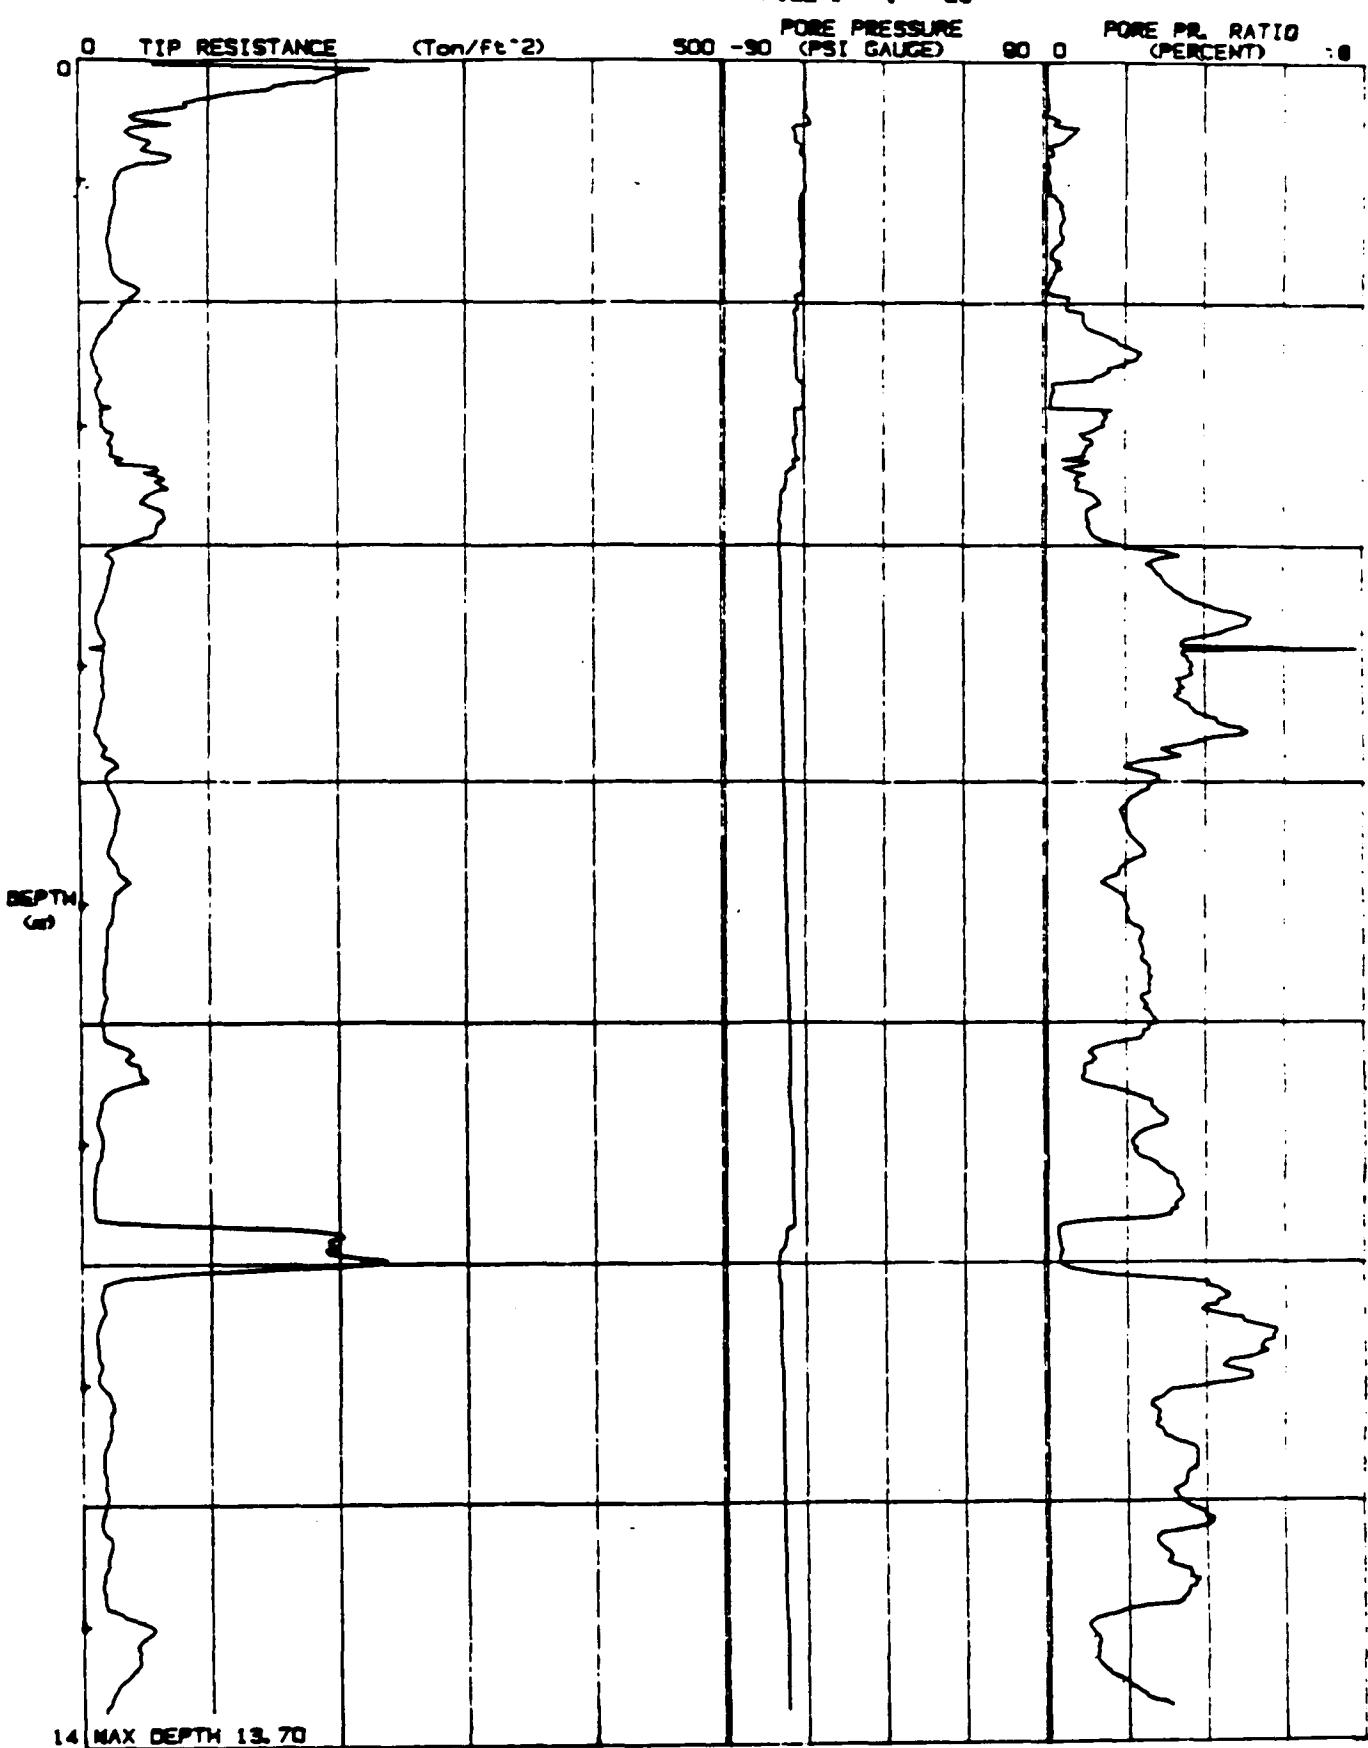


JOB # : 408700
DATE : 02/06/90
LOCATION : CPT/S-14
FILE # : 30

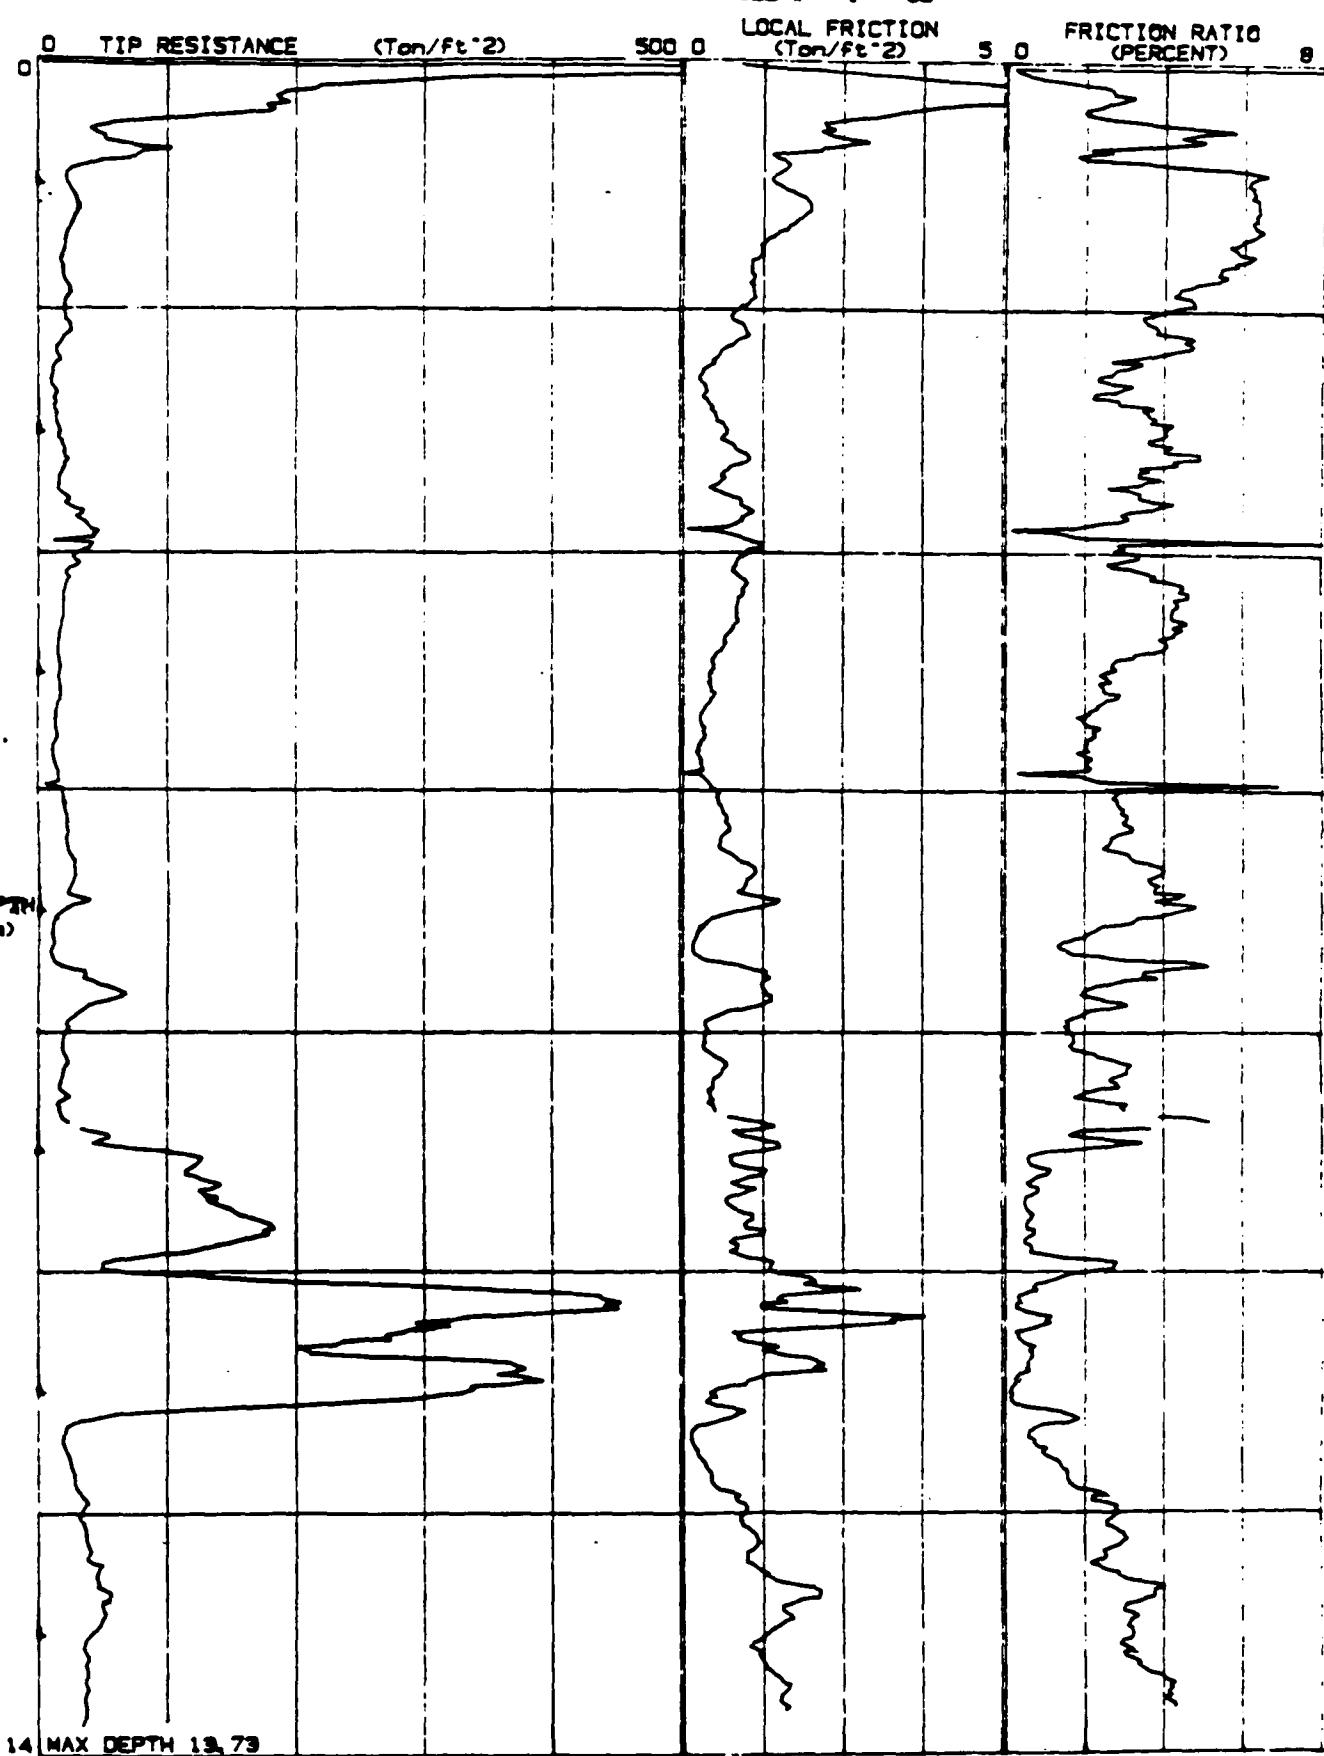


JOB # : 409700
DATE : 02/06/90
LOCATION : CPT/8-14
FILE # : 30

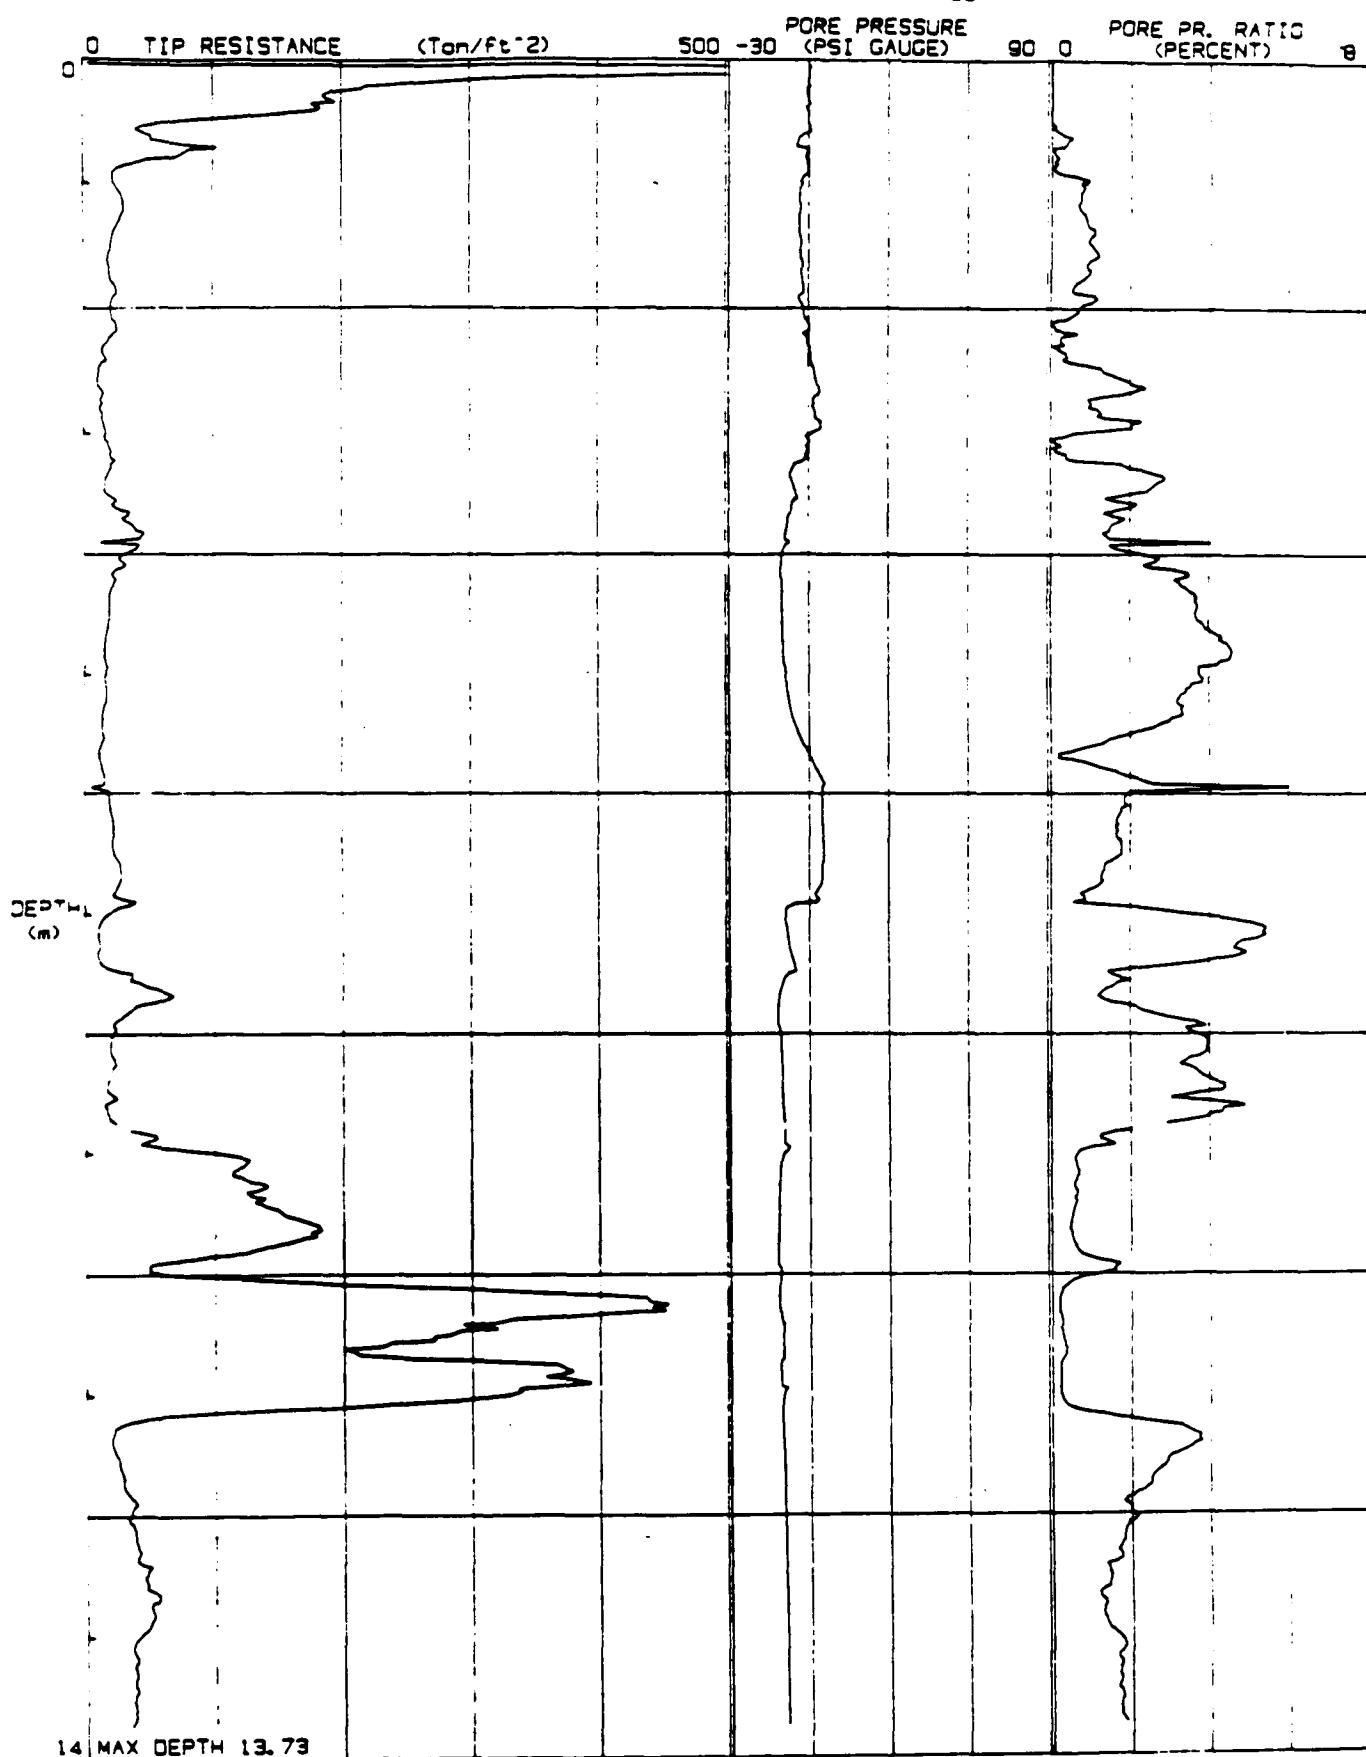


JOB # : 409700
DATE : 04/10/90/12:05
LOCATION : CPT8-18
FILE : FIL158

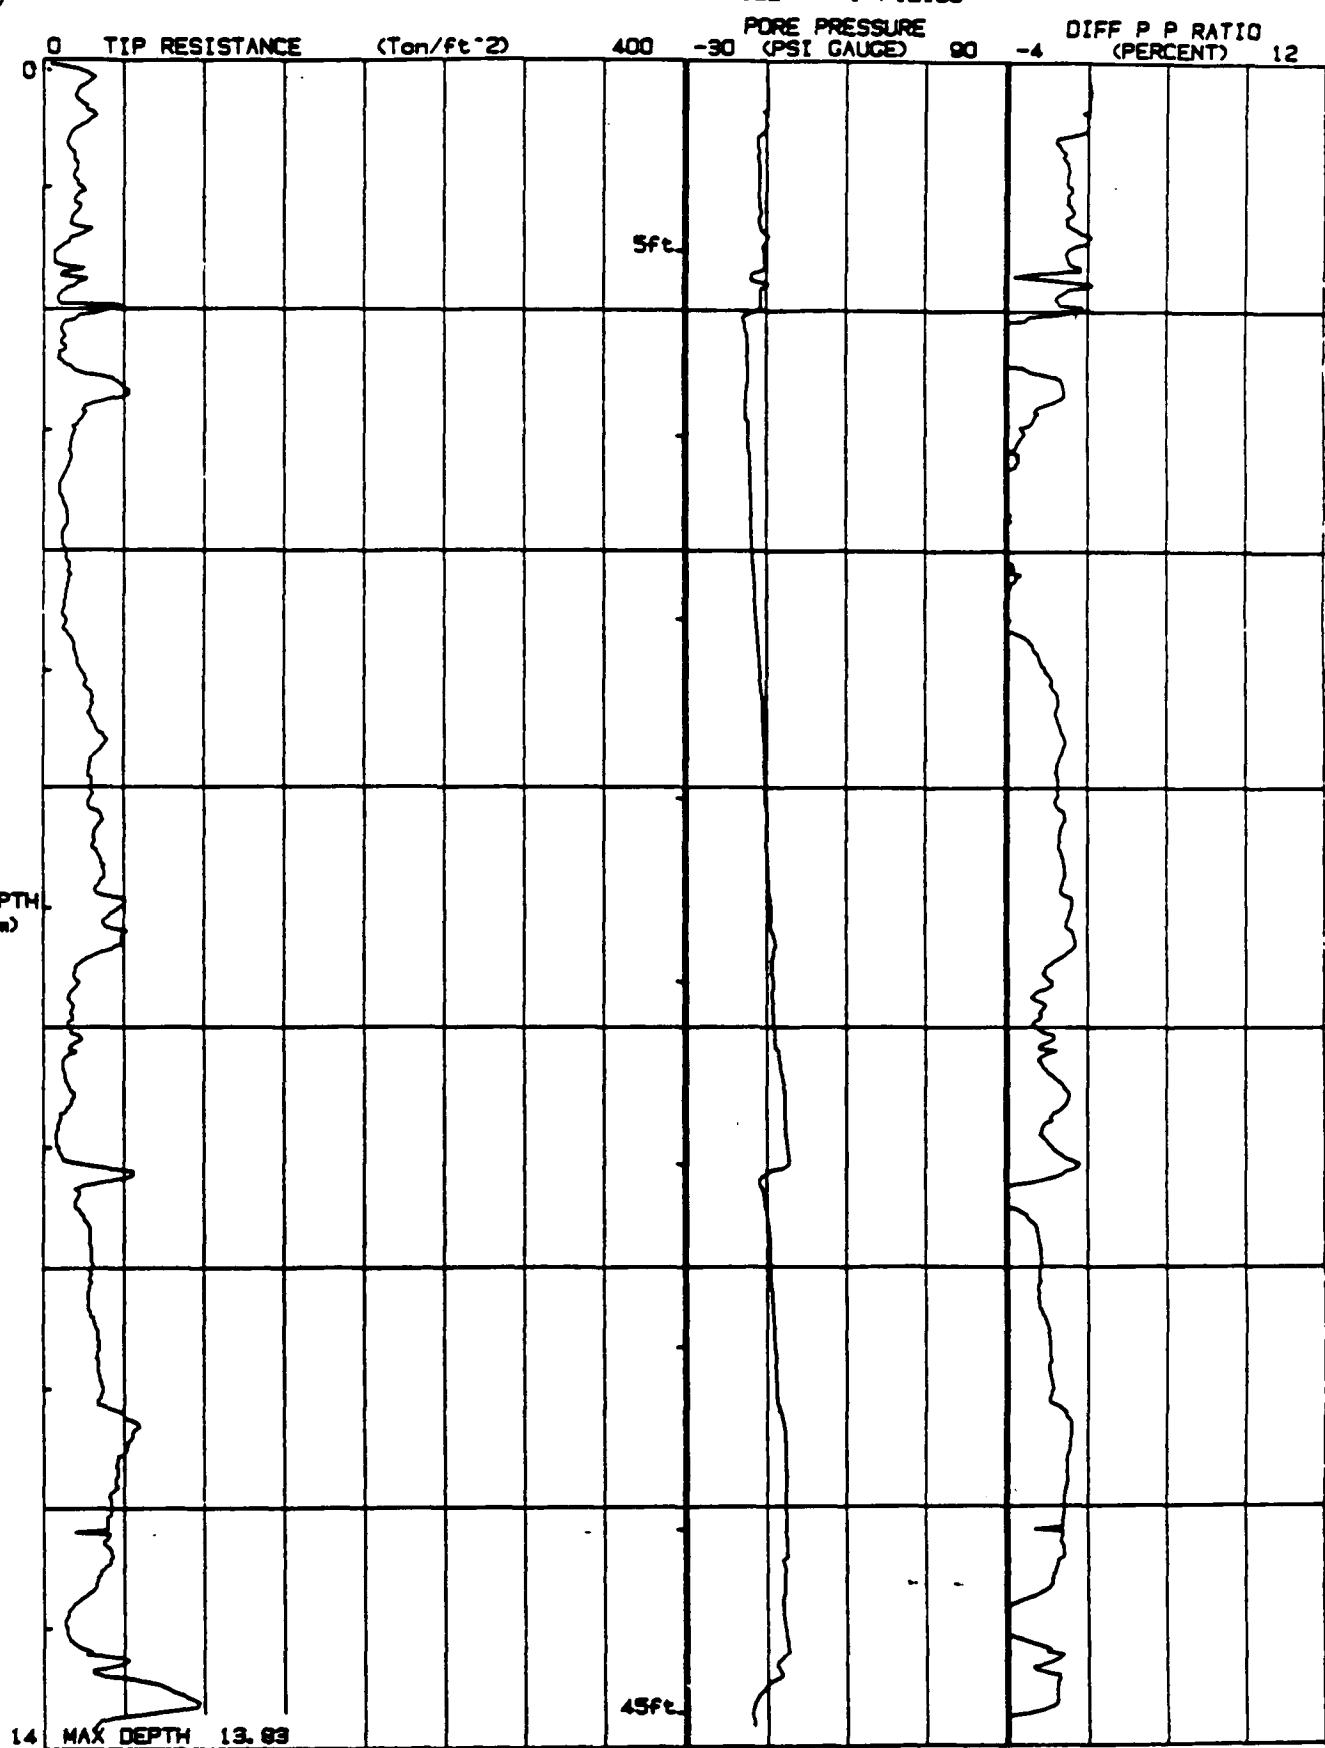


JOB # : 409700
DATE : 04/10/90/12:05
LOCATION : CPTB-18
FILE : FIL158

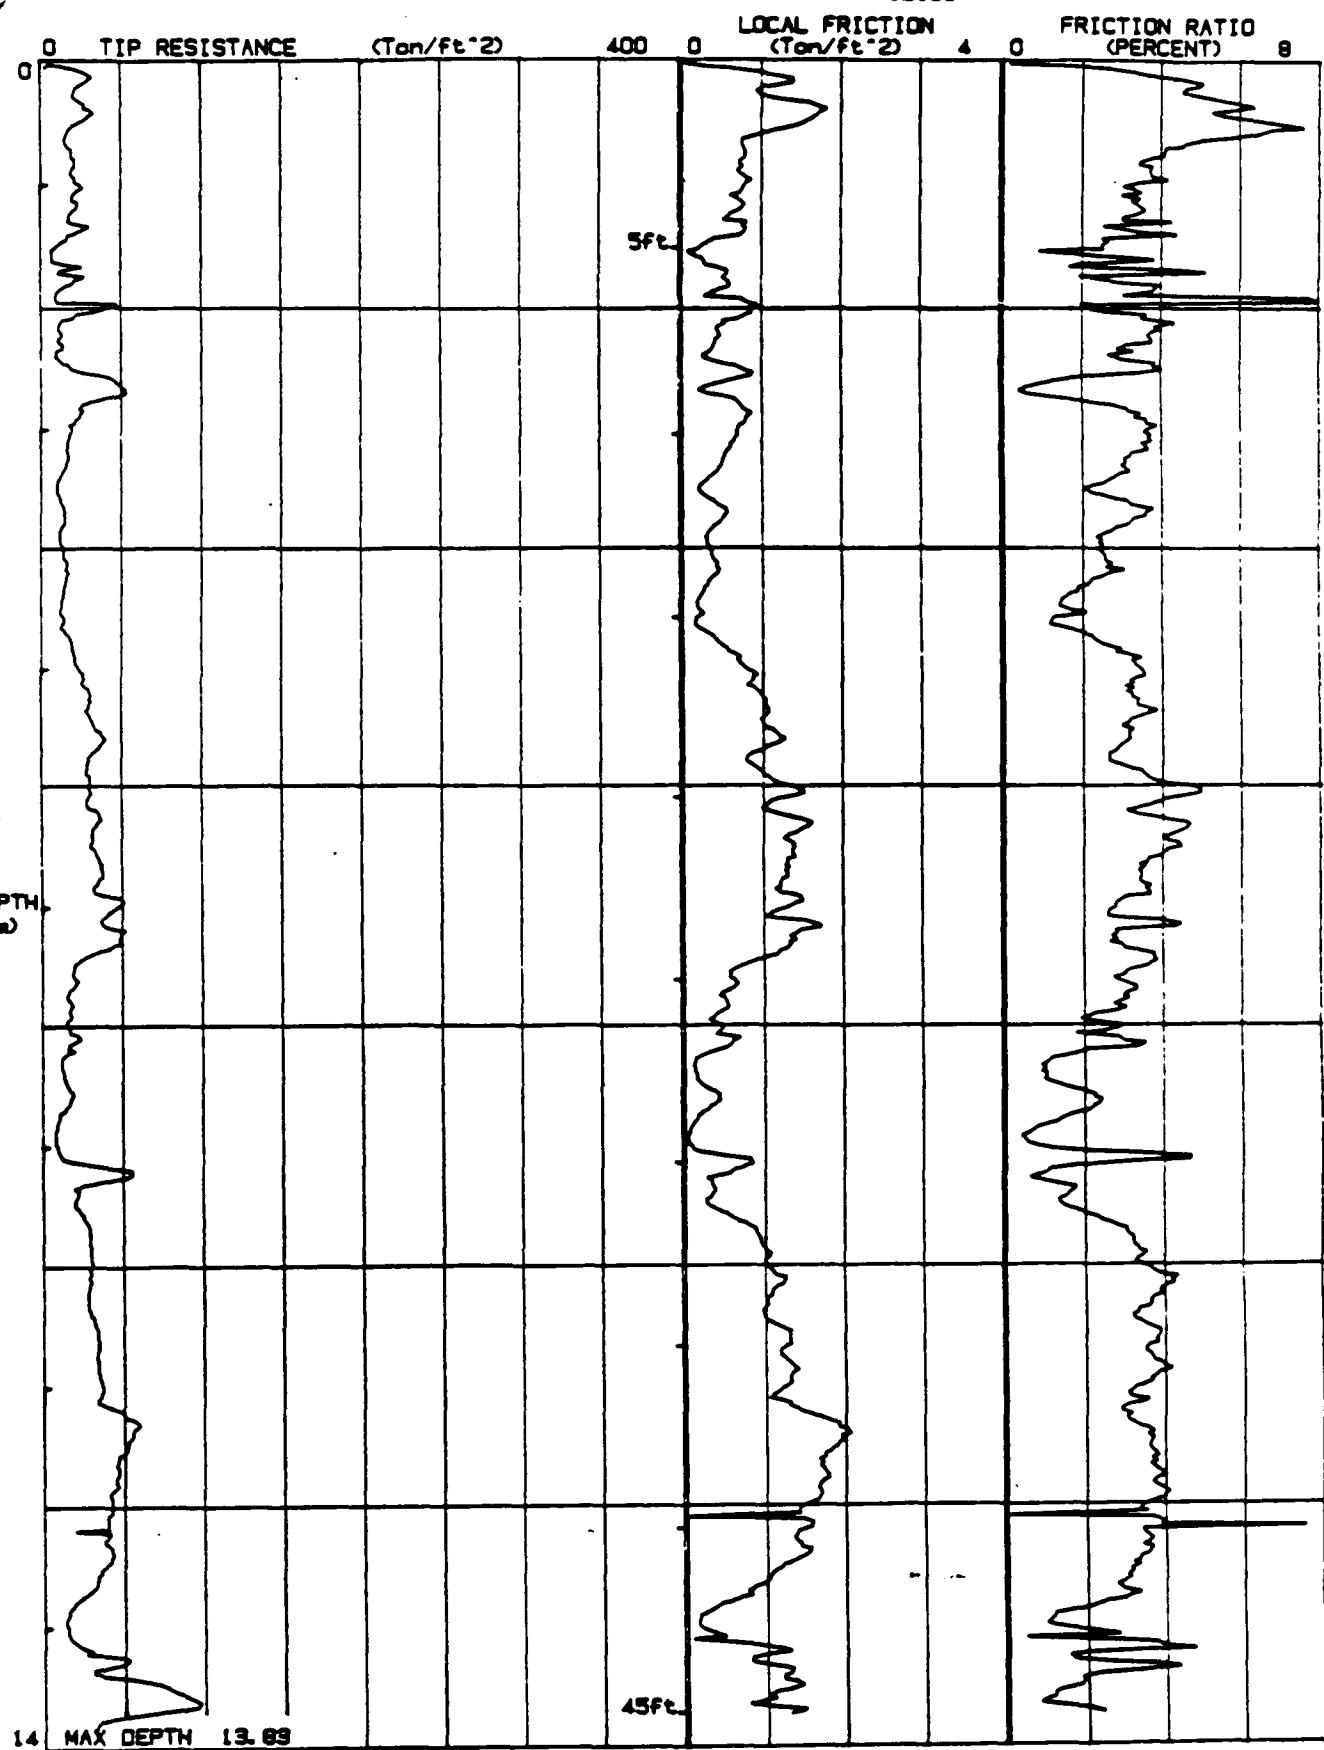


JOB # : 409700
DATE : 04/10/90 10:33
LOCATION : CPT8-19
FILE : FIL155

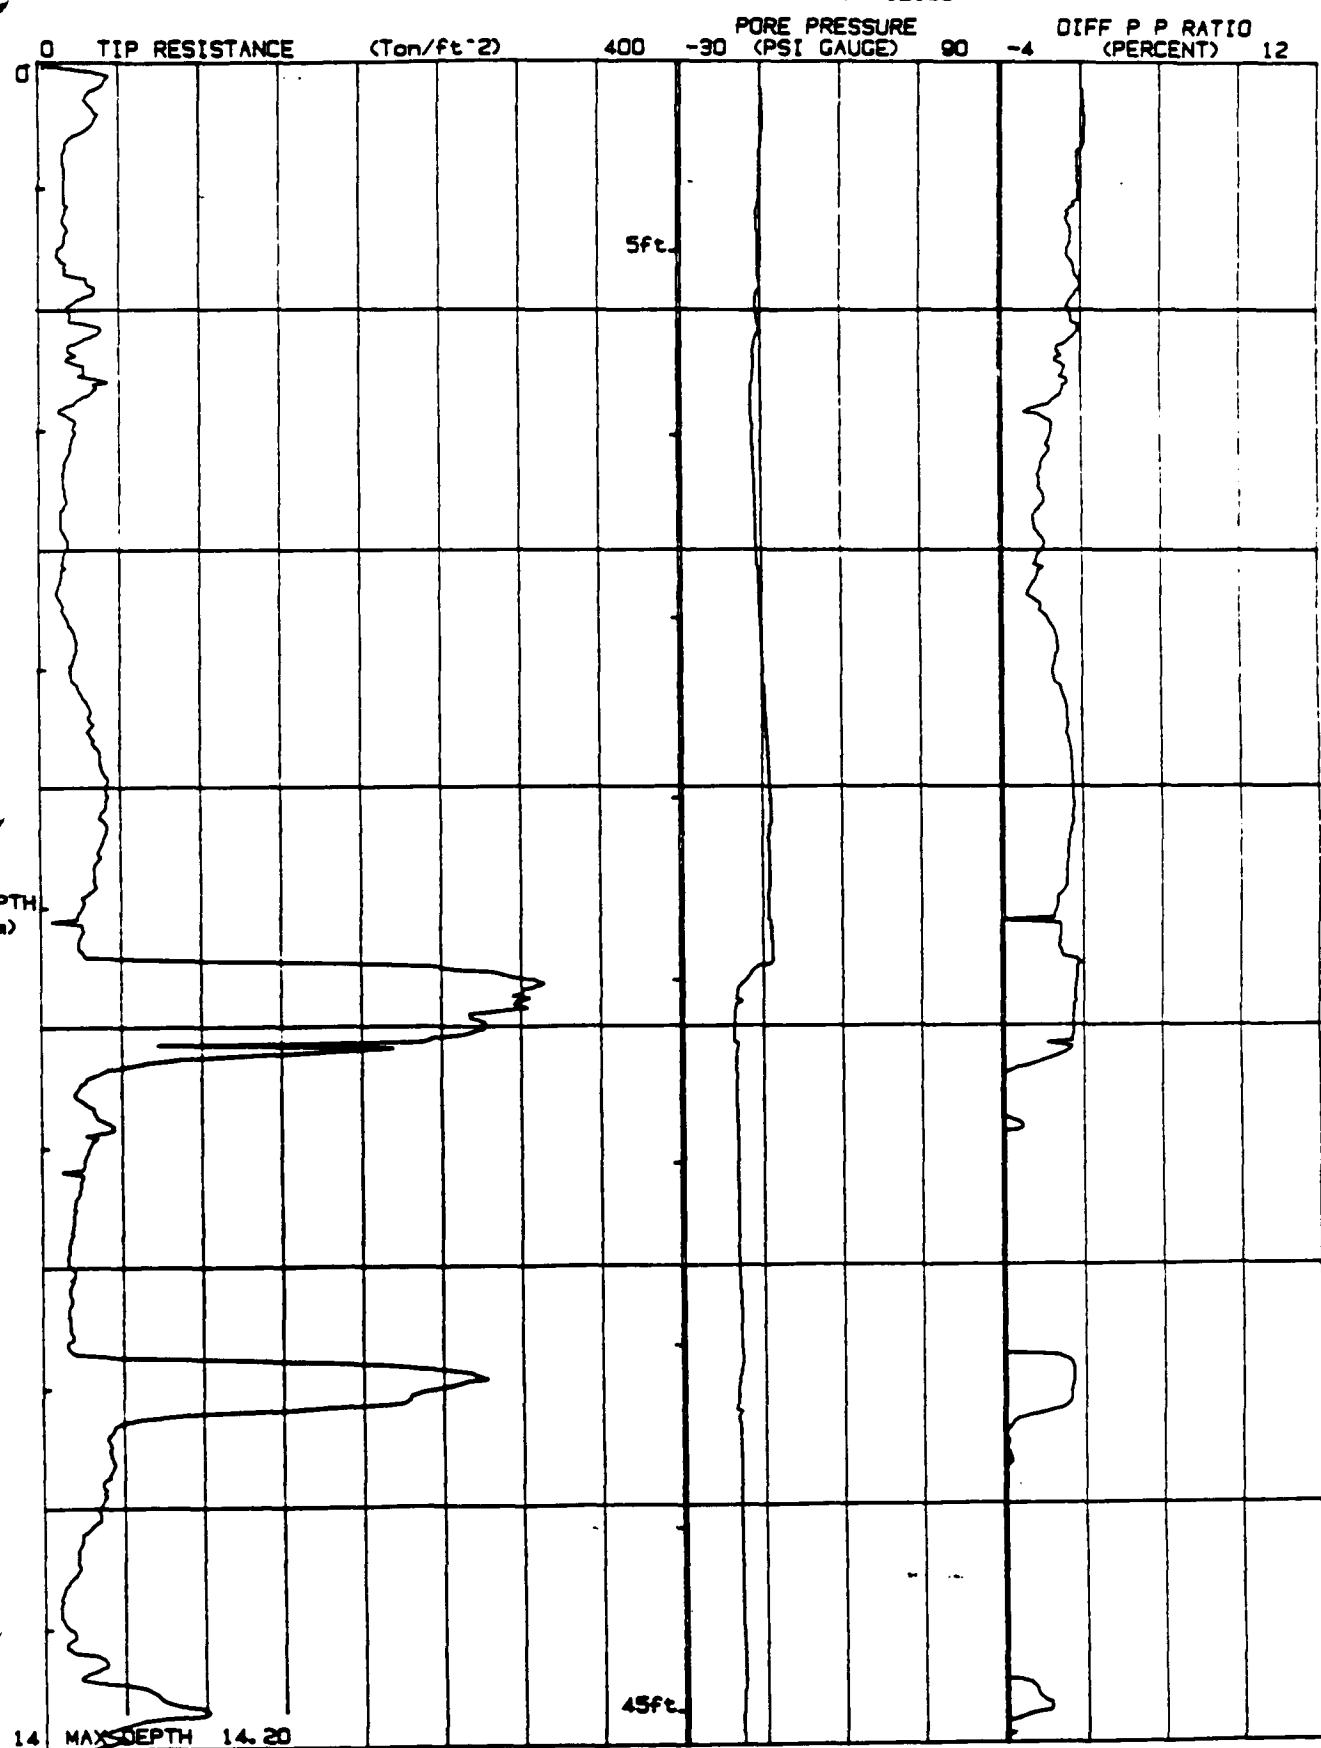


JOB # : 409700
DATE : 04/10/90 10:33
LOCATION : CPT8-19
FILE : FIL155

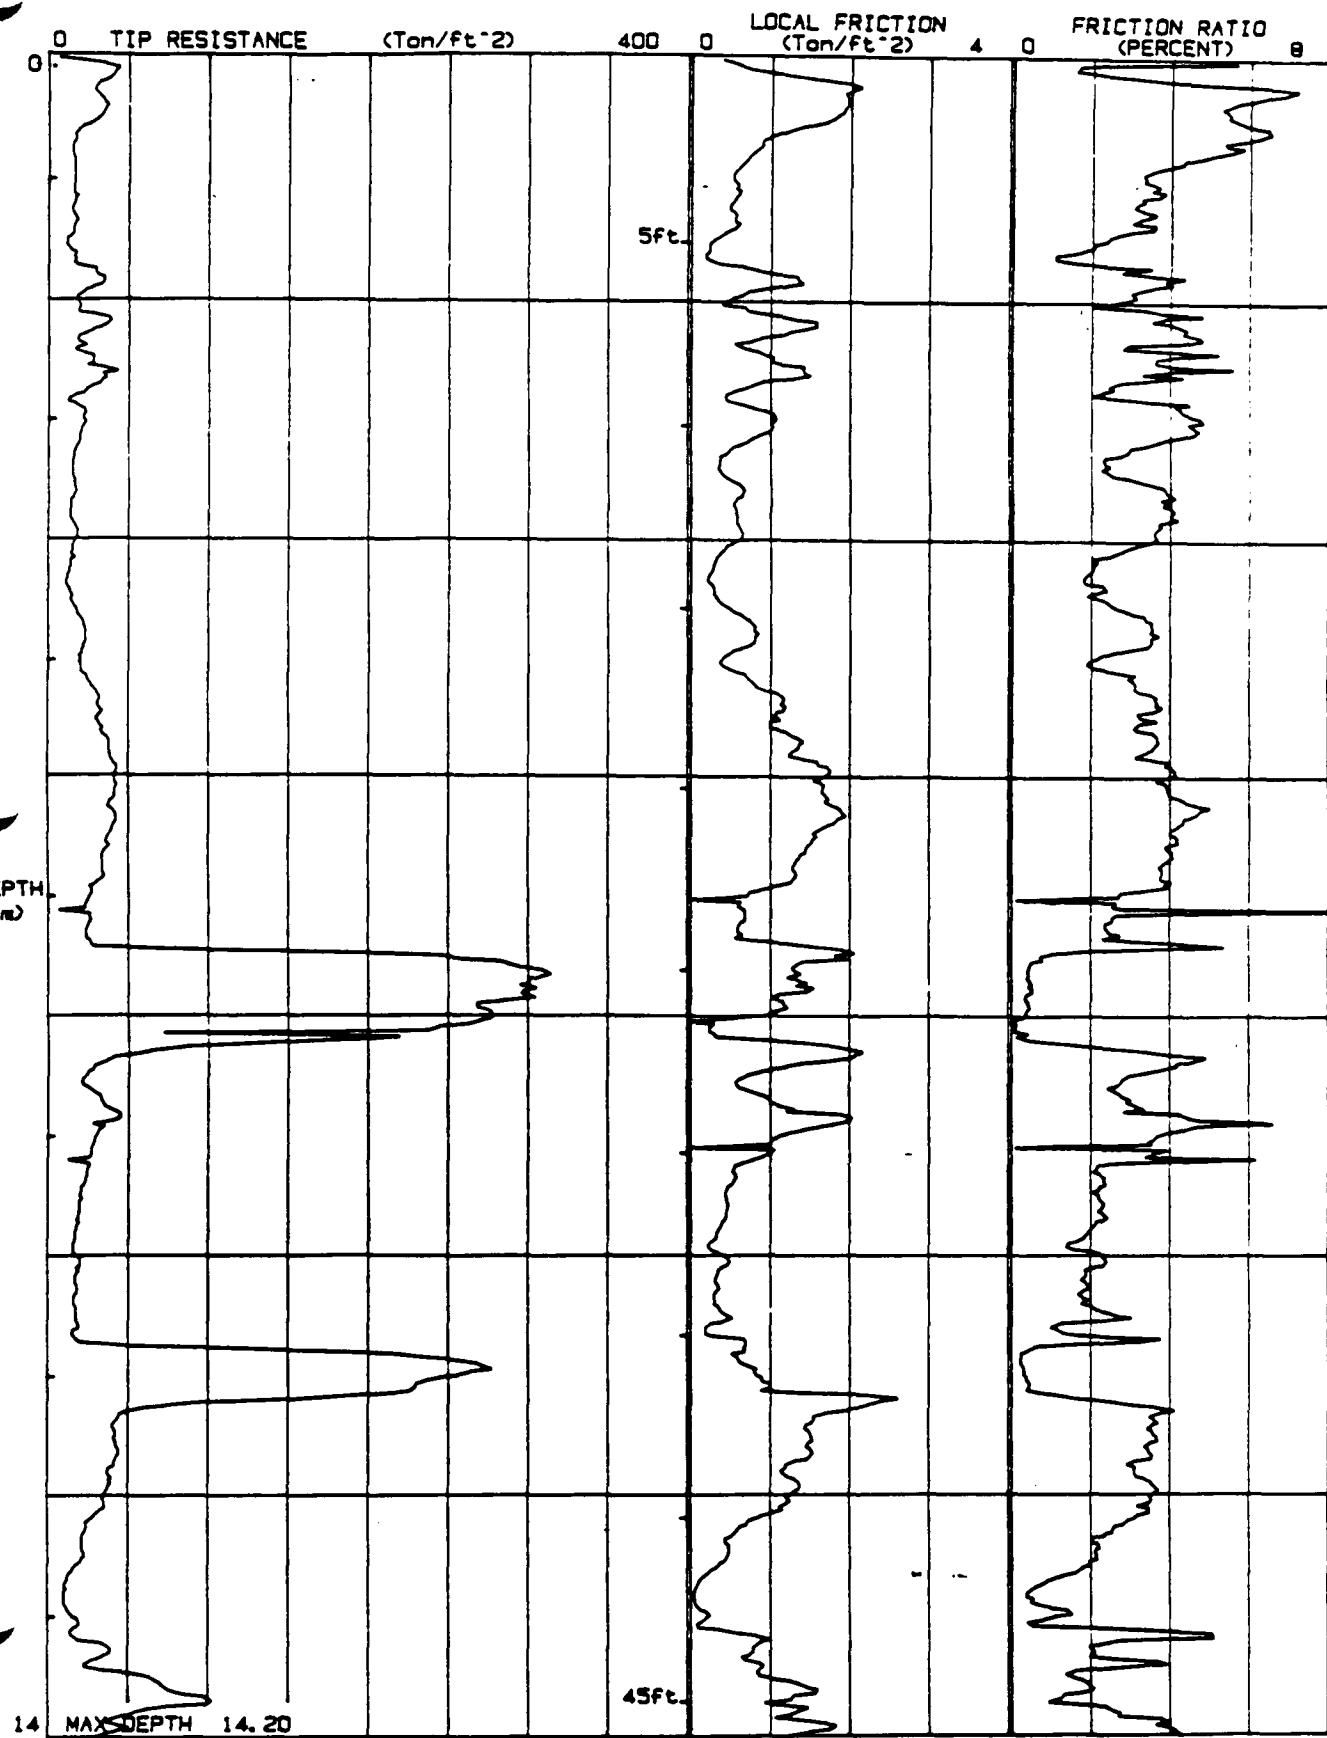

JOB # : 409700
DATE : 04/23/90 15:22
LOCATION : CPTB-21
FILE : FIL179

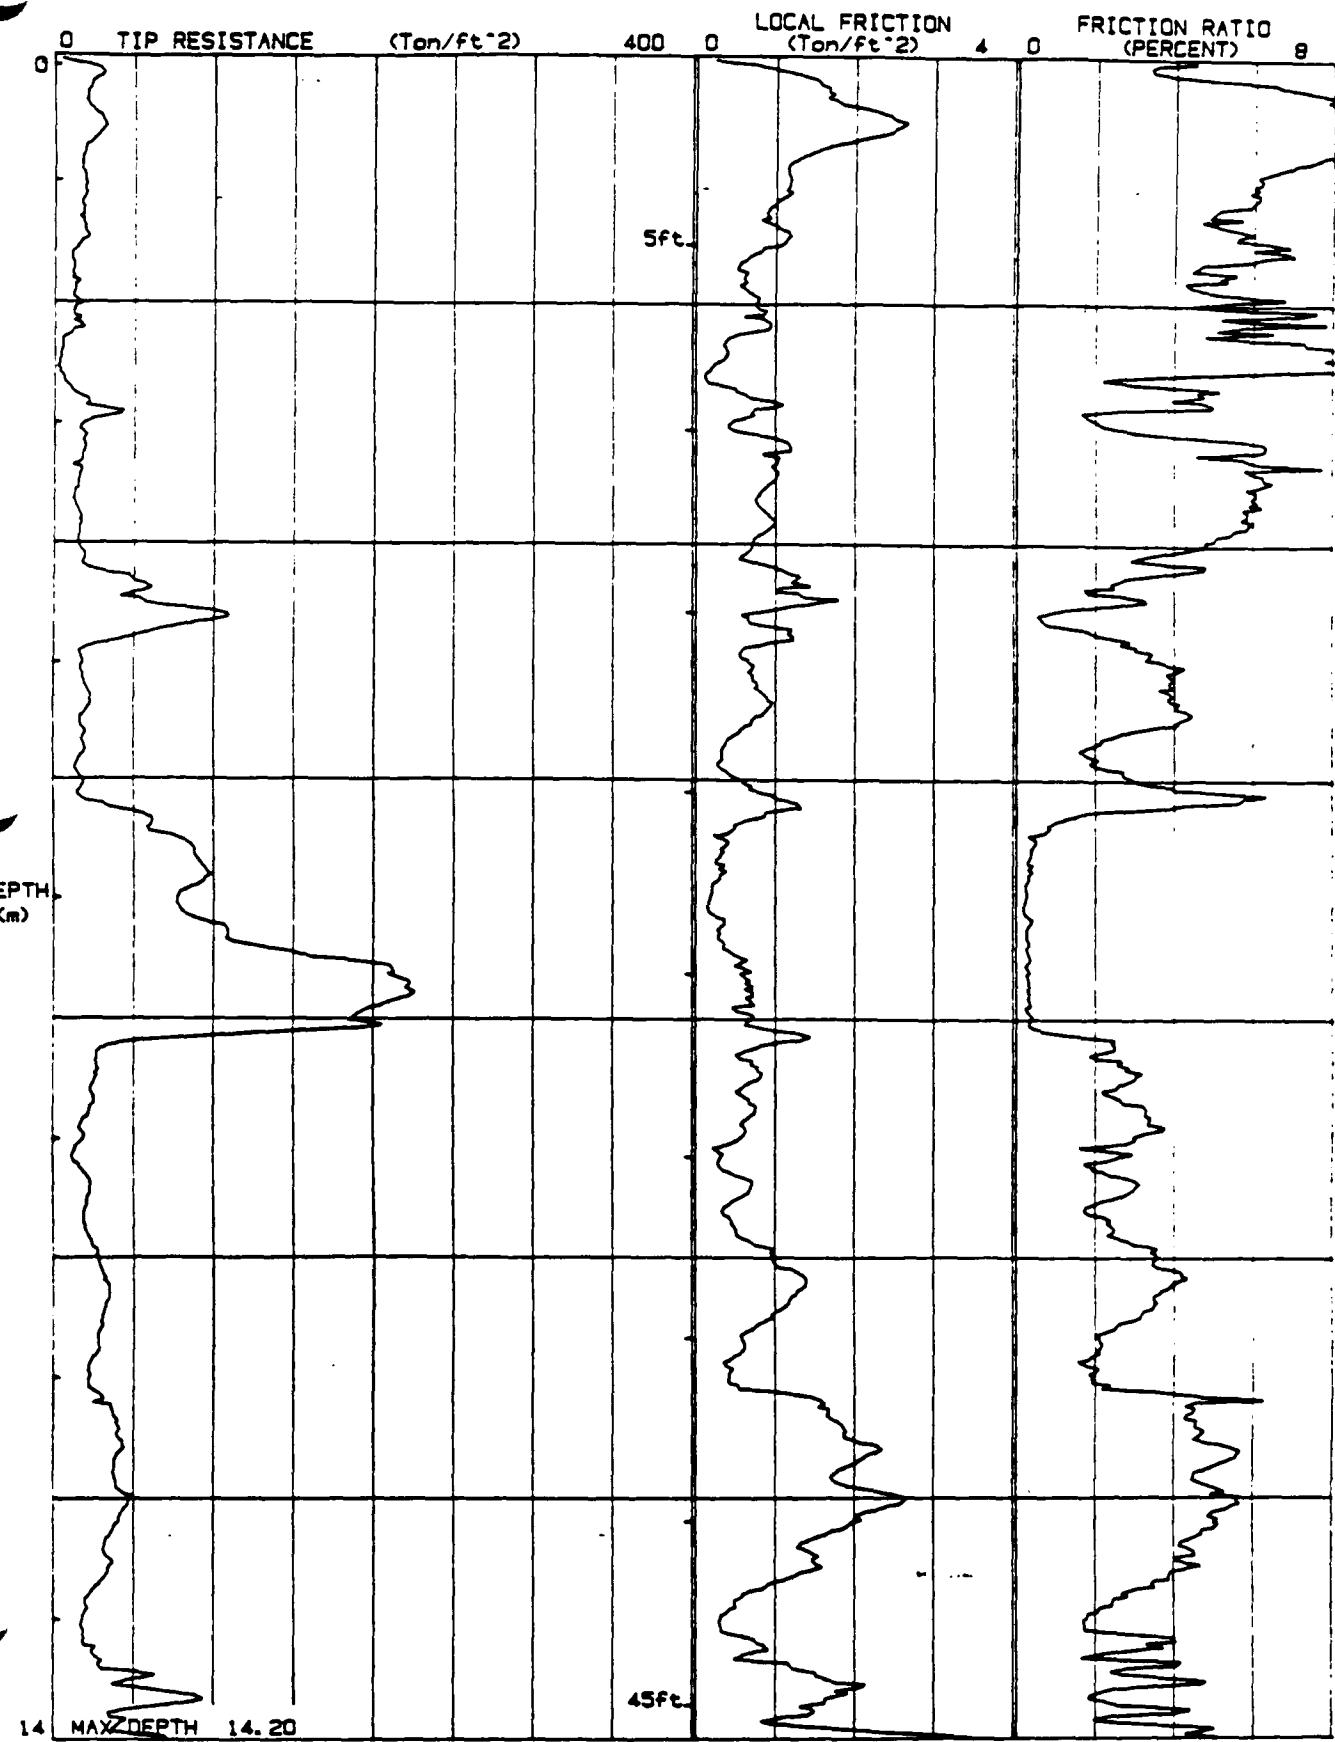

JOB # : 409700
DATE : 04/23/90/15:22
LOCATION : CPT8-21
FILE : FIL179

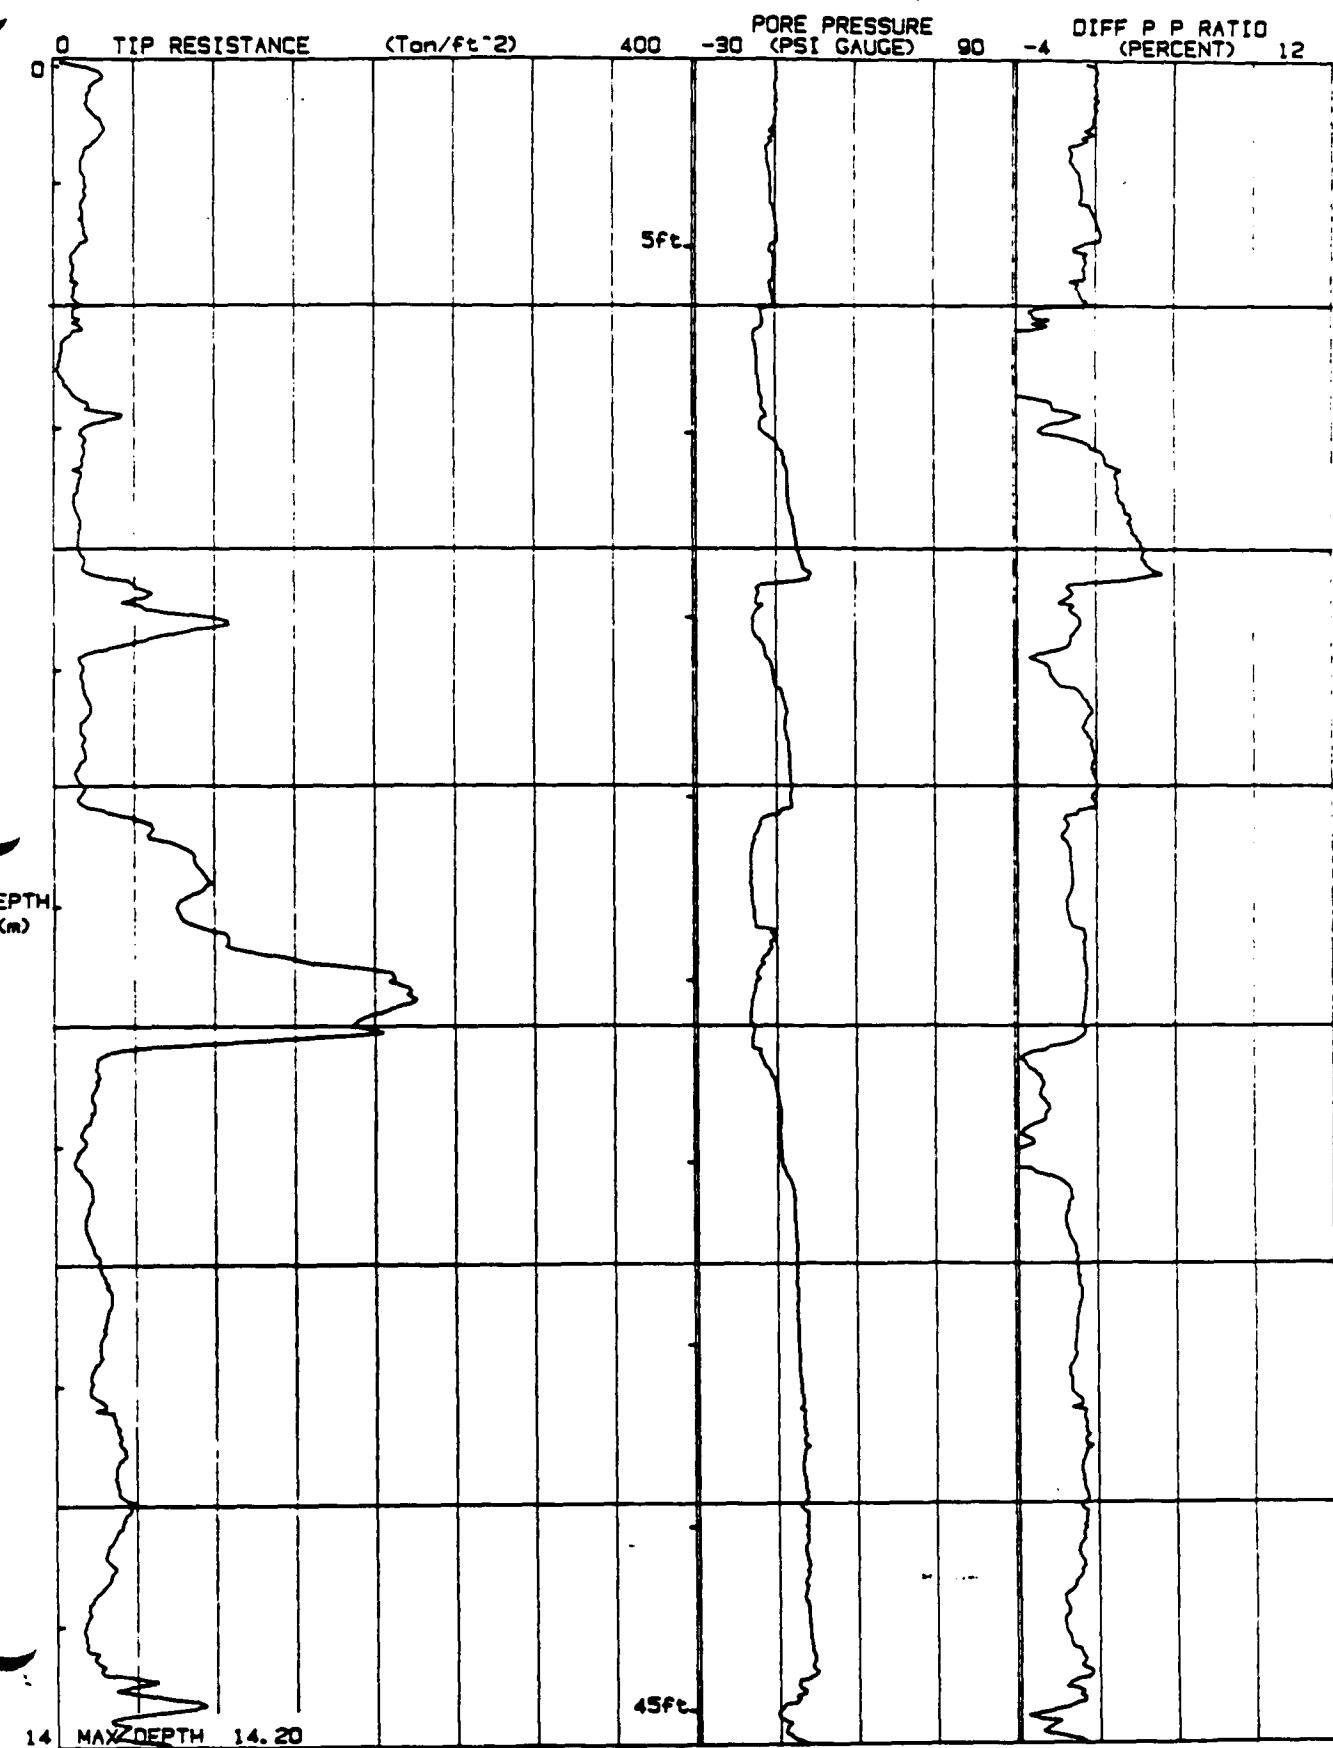


N00296.001452
MOFFETT FIELD
SSIC NO. 5090.3

**APPENDIX C – BORING LOGS
GEOPHYSICAL LOGS**

SITE 8 – CPT (CLEAN)

**REMEDIAL INVESTIGATION REPORT
OPERABLE UNIT 4: WEST SIDE AQUIFERS**

DATED 01 AUGUST 1992

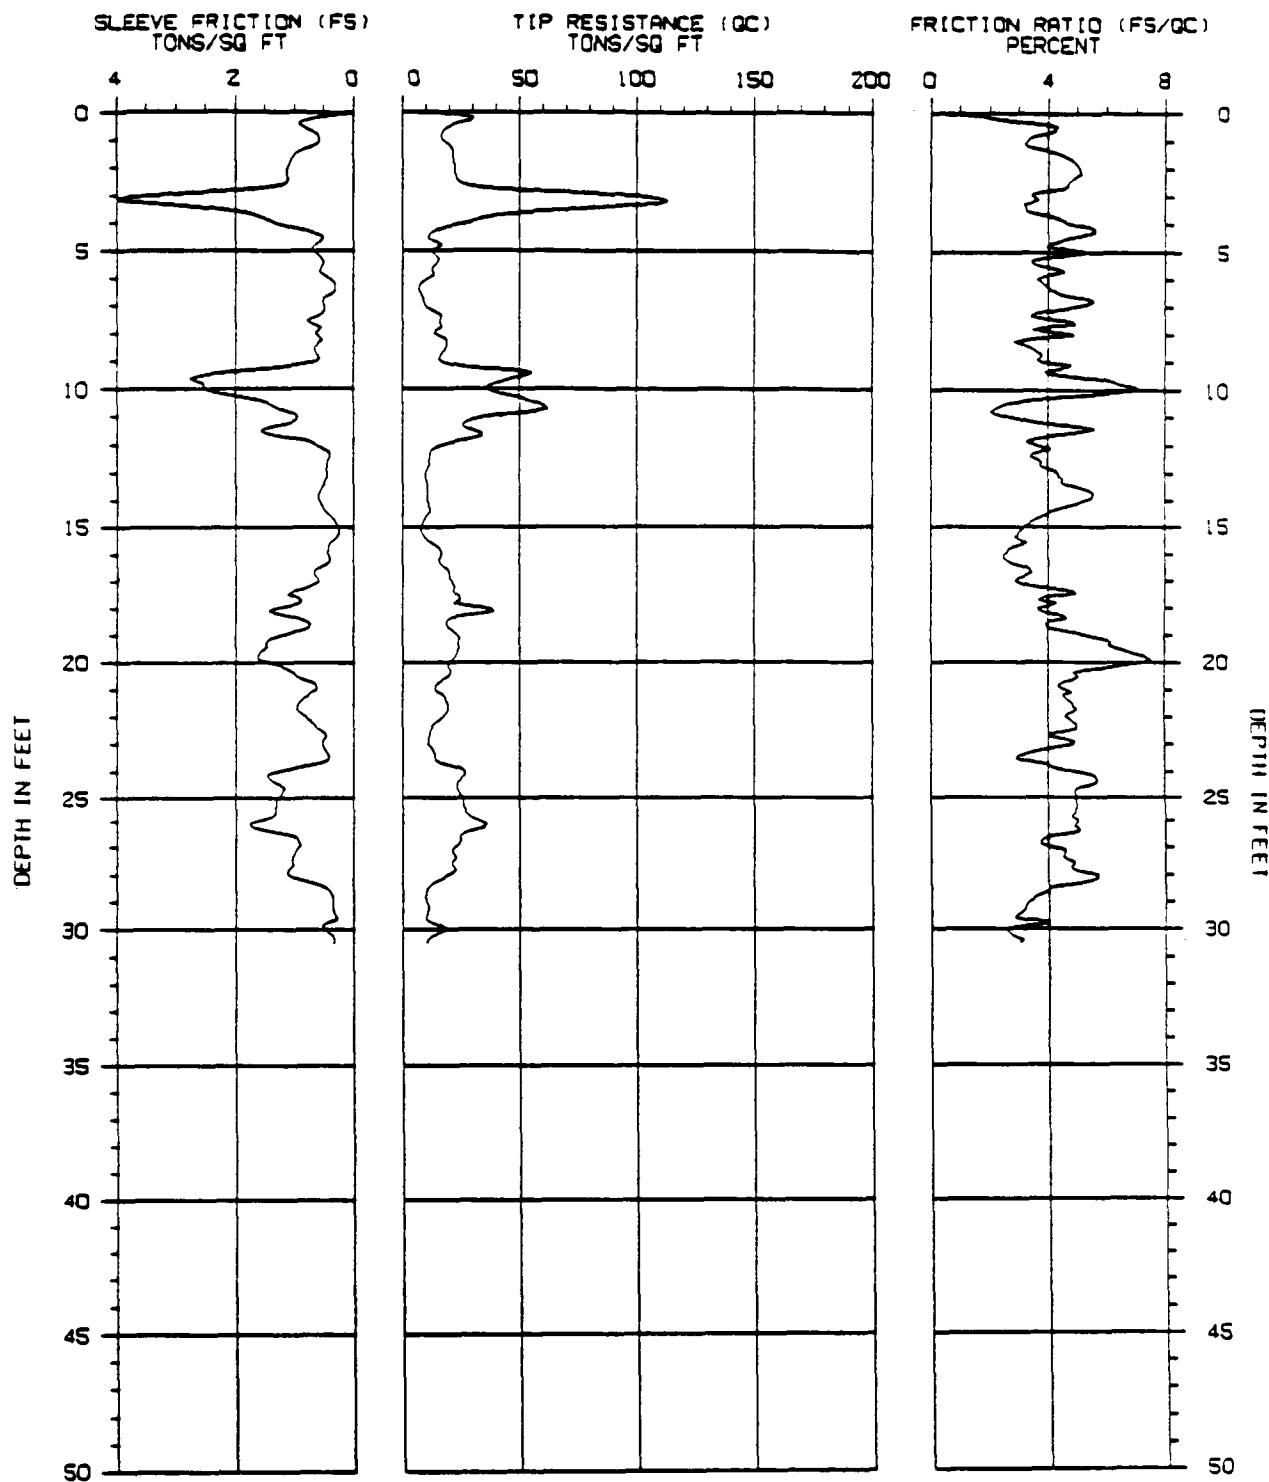


CONE PENETRATION TEST

SOUNDING NUMBER: CPT-2

PROJECT NAME : JMM/MOFFETT NAS
PROJECT NUMBER : 9110-07002

LOCATION : SUNNYVALE
DATE : 05-08-1991

 THE EARTH TECHNOLOGY
CORPORATION

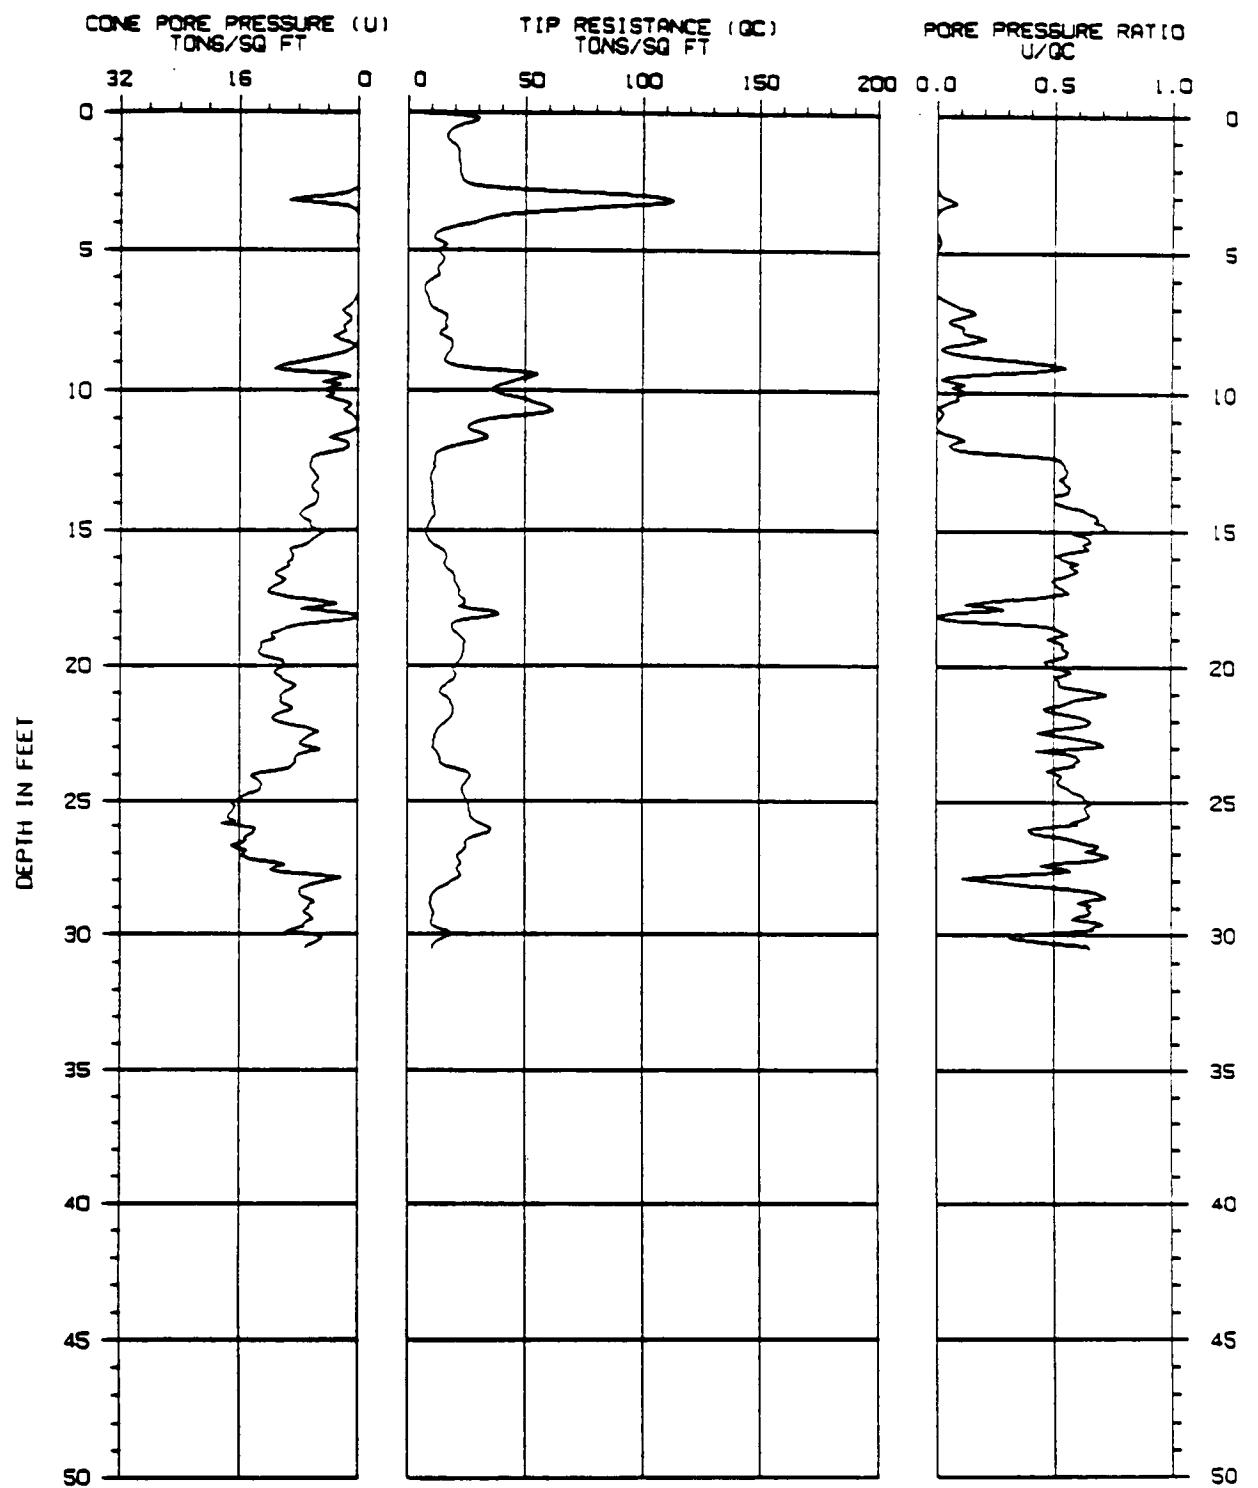


CONE PENETRATION TEST

SOUNDING NUMBER: CPT-2

PROJECT NAME : JMM/MOFFETT NAS
PROJECT NUMBER : 9110-07002

LOCATION : SUNNYVALE
DATE : 05-08-1991

 THE EARTH TECHNOLOGY CORPORATION

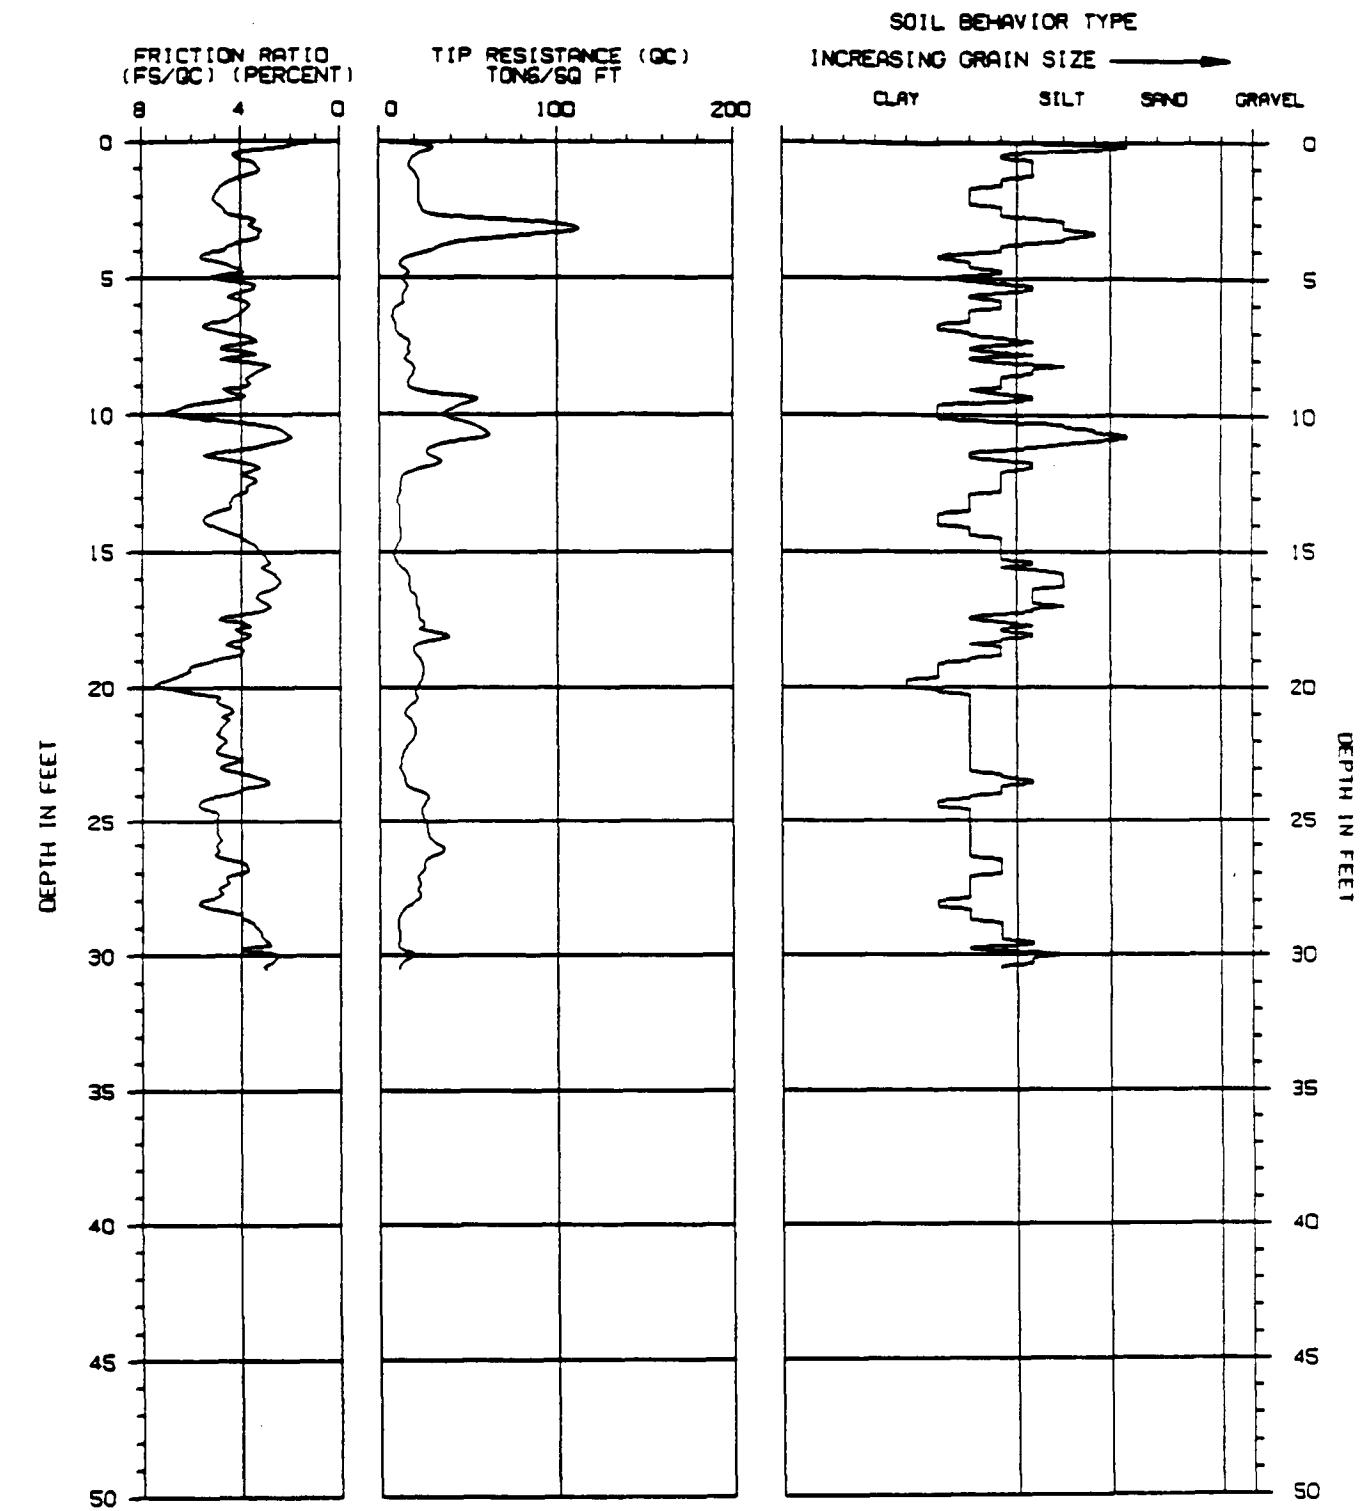

ASSUMED TOTAL UNIT WT = 110 PCF

ASSUMED DEPTH OF WATER TABLE = 6.0 FT


CONE PENETRATION TEST

SOUNDING NUMBER: CPT-2

PROJECT NAME : JMM/MOFFETT NAS
PROJECT NUMBER : 9110-07002

LOCATION : SUNNYVALE
DATE : 05-08-1991

 THE EARTH TECHNOLOGY CORPORATION

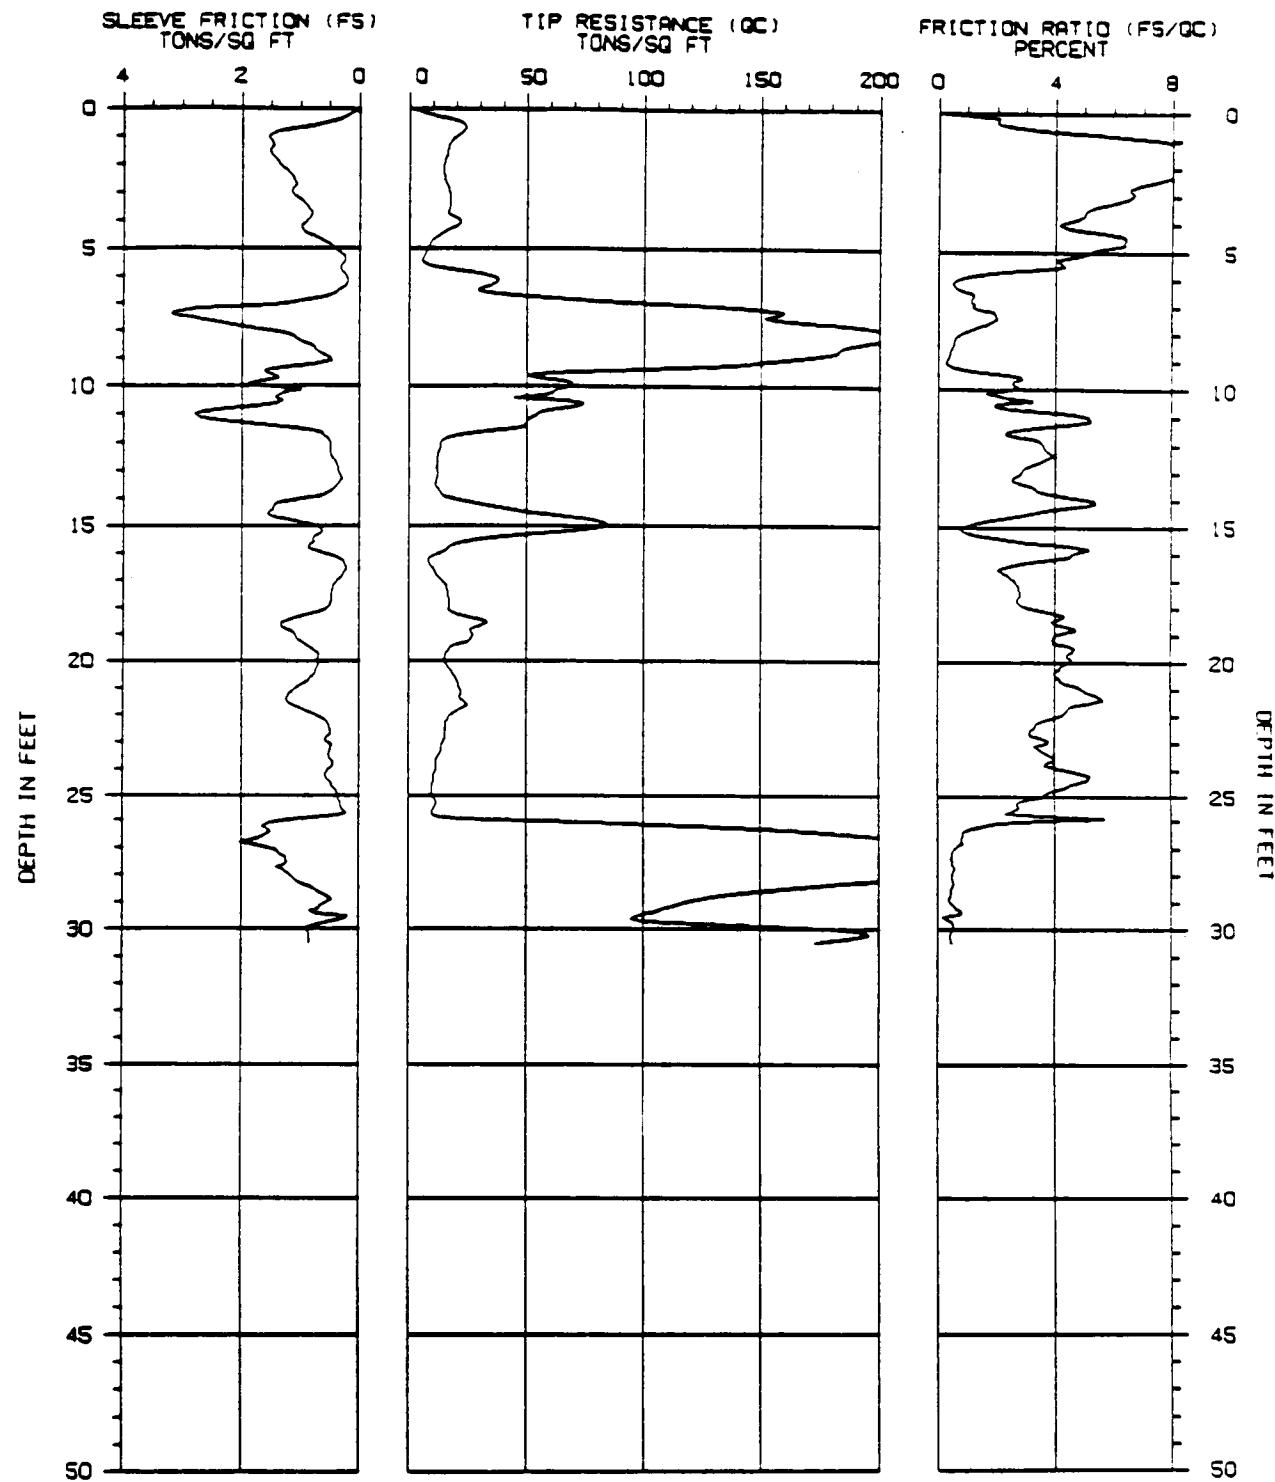


CONE PENETRATION TEST

SOUNDING NUMBER: CPT-4

PROJECT NAME : JMM/MOFFETT NAS
PROJECT NUMBER : 9110-07002

LOCATION : SUNNYVALE
DATE : 05-08-1991

 THE EARTH TECHNOLOGY CORPORATION

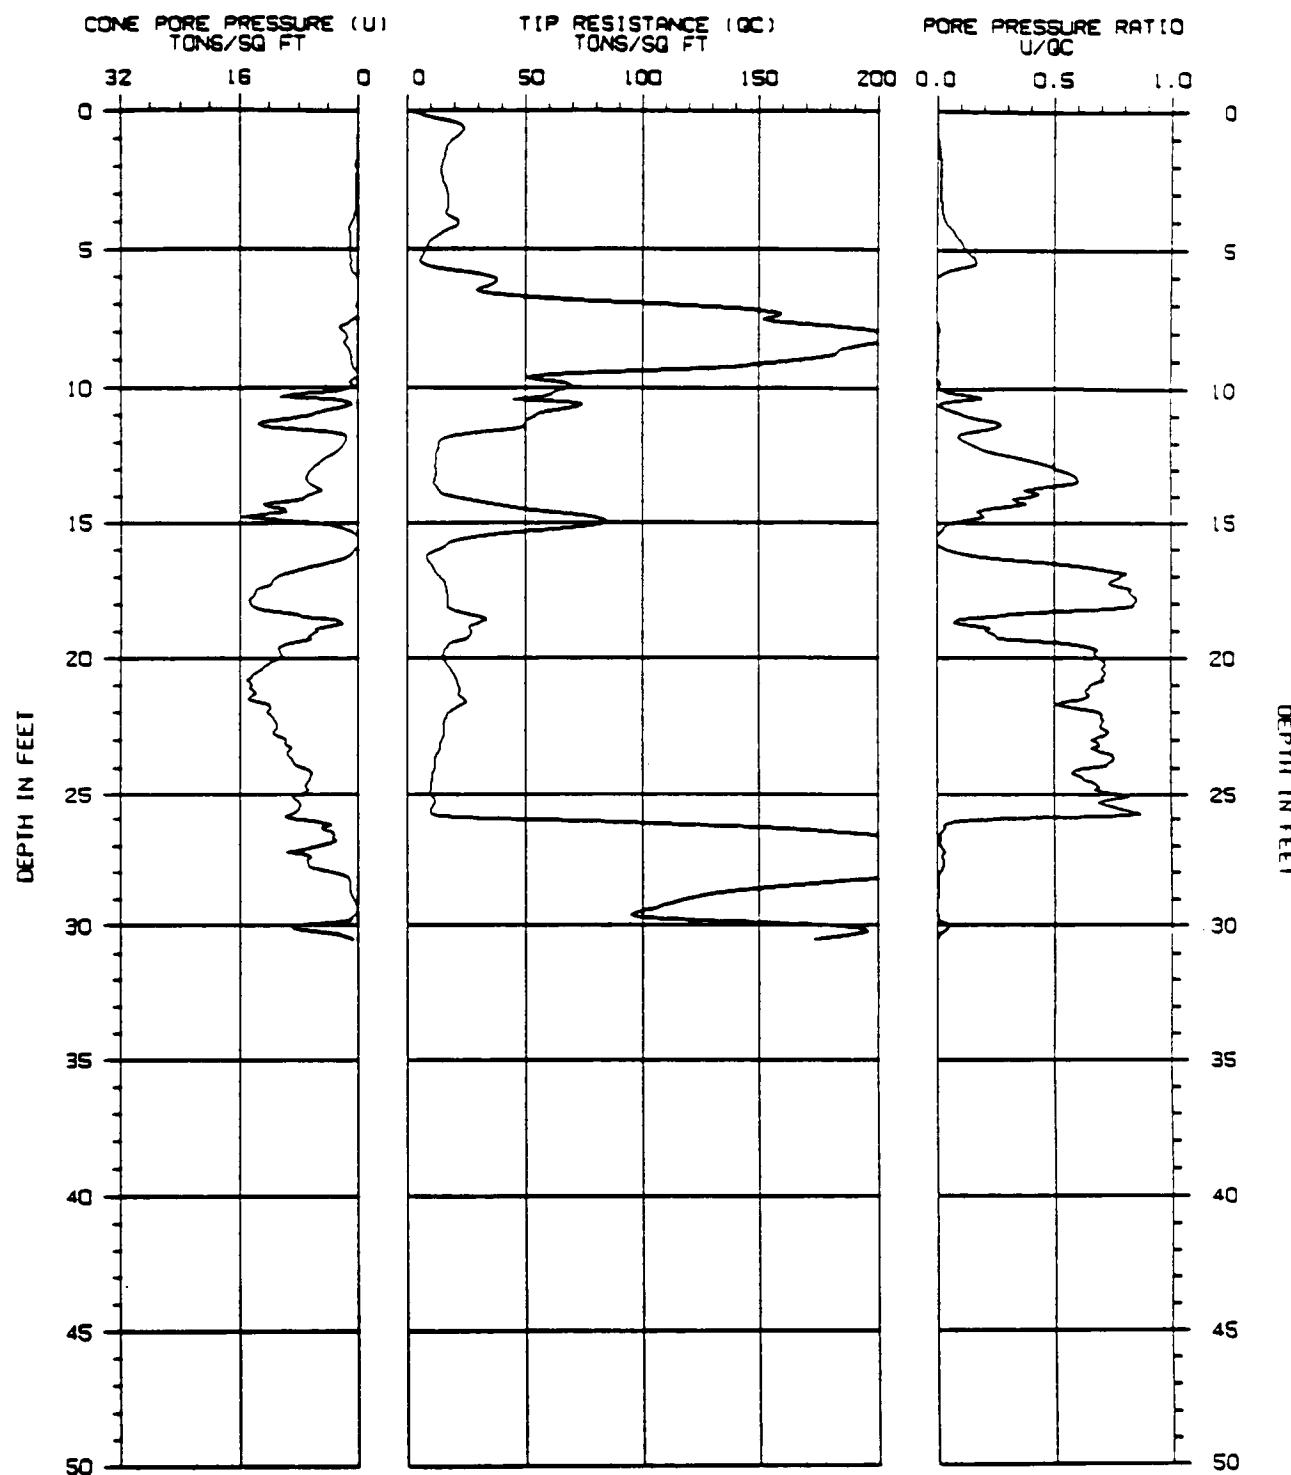


CONE PENETRATION TEST

SOUNDING NUMBER: CPT-4

PROJECT NAME : JMM/MOFFETT NAS
PROJECT NUMBER : 9110-07002

LOCATION : SUNNYVALE
DATE : 05-08-1991

 THE EARTH TECHNOLOGY CORPORATION

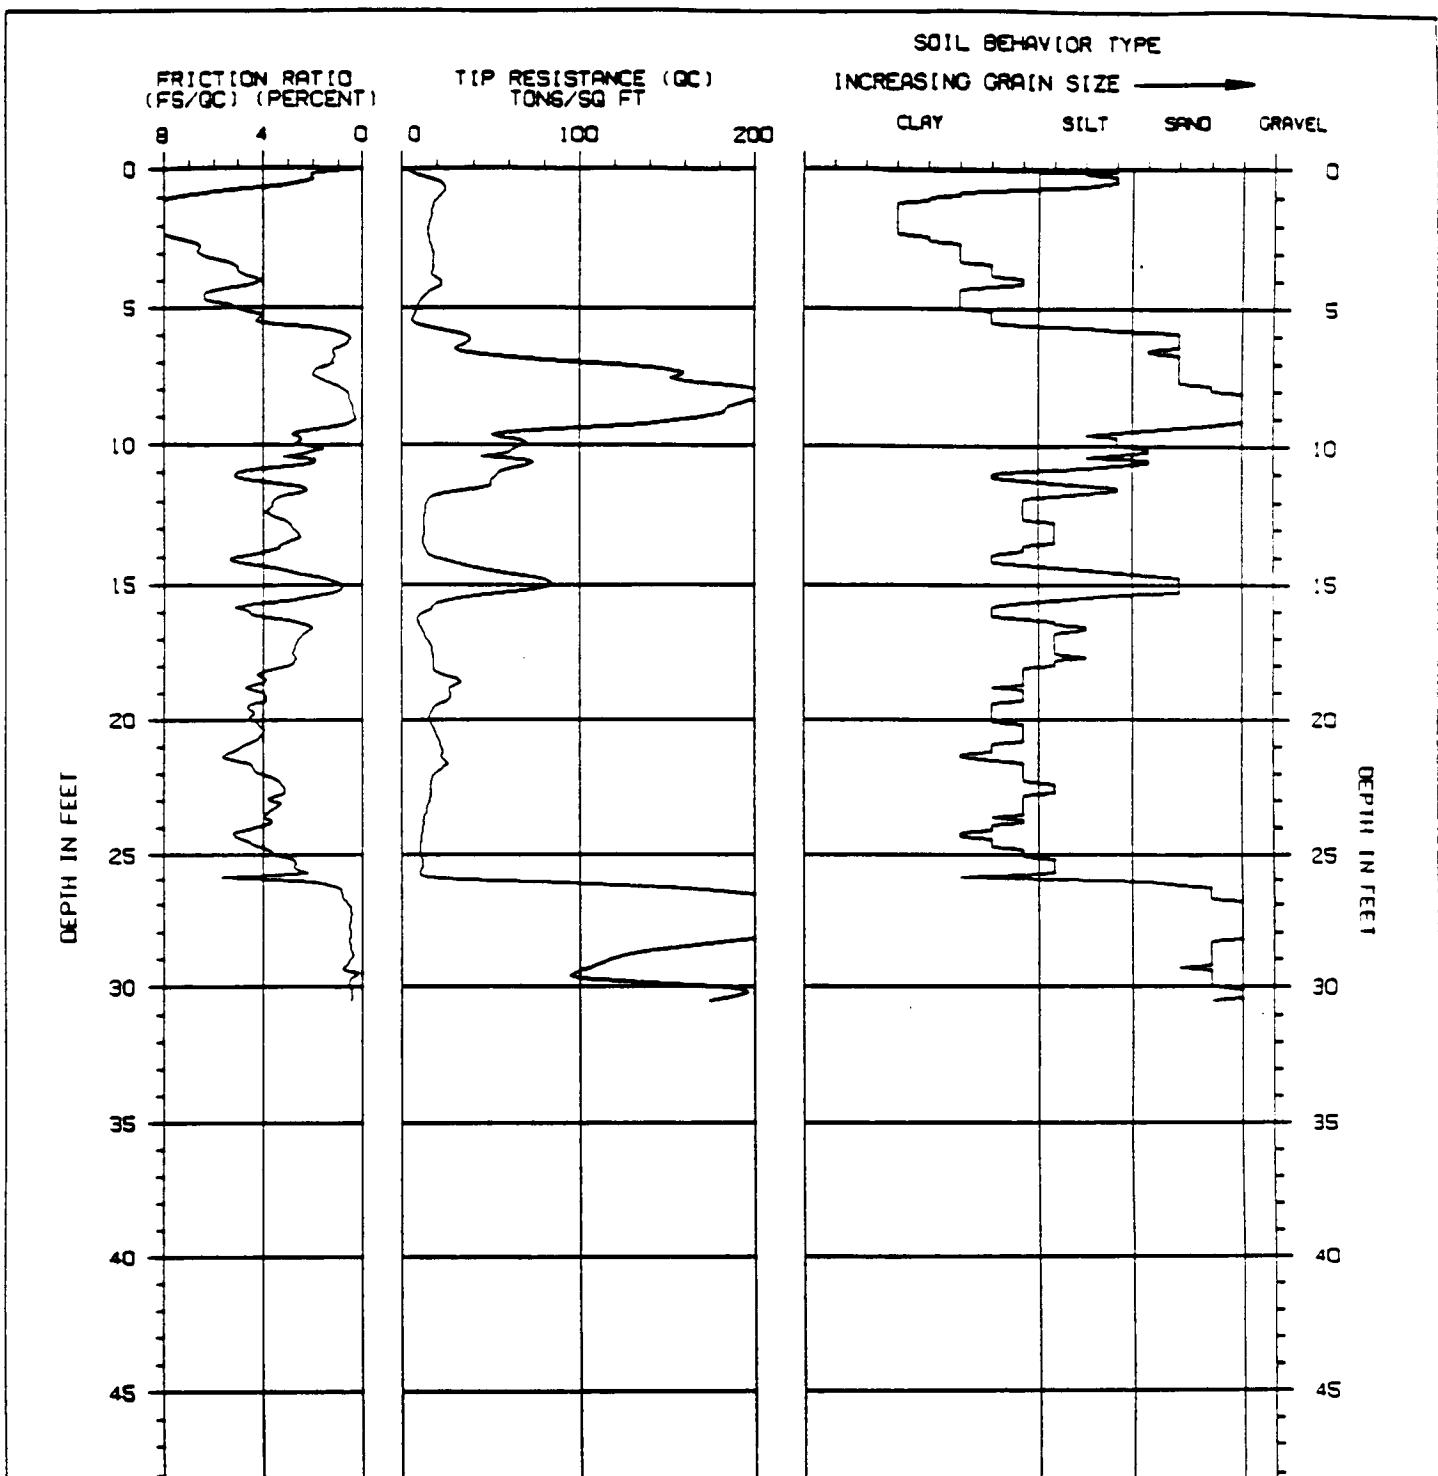


ASSUMED TOTAL UNIT WT = 110 PCF


ASSUMED DEPTH OF WATER TABLE = 6.0 FT

CONE PENETRATION TEST		SOUNDING NUMBER: CPT-4	
PROJECT NAME : JMM/MOFFETT NAS	LOCATION : SUNNYVALE	DATE : 05-08-1991	THE EARTH TECHNOLOGY CORPORATION
PROJECT NUMBER : 9110-07002			


SLEEVE FRICTION (FS)
TONS/SQ FT

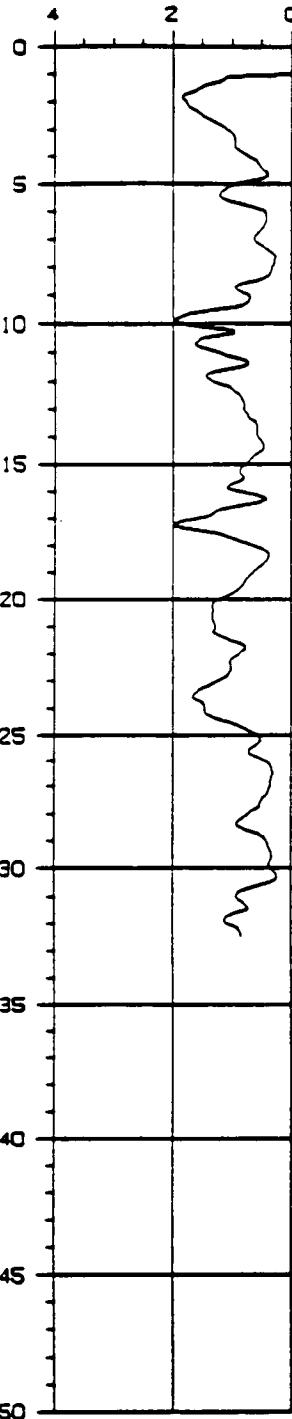

TIP RESISTANCE (QC)
TONS/SQ FT

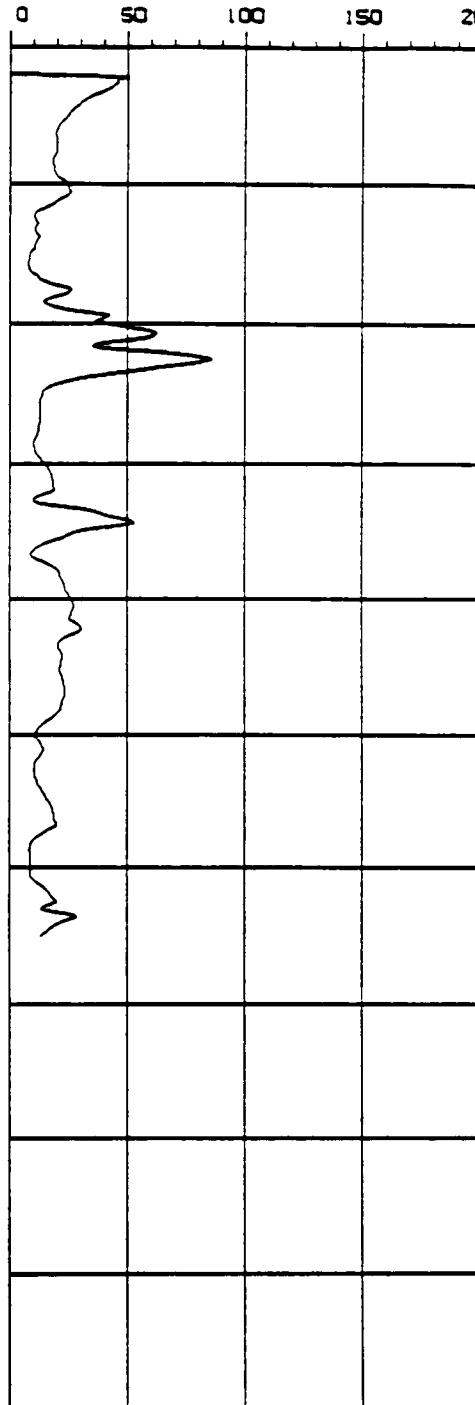

FRICTION RATIO (FS/QC)
PERCENT

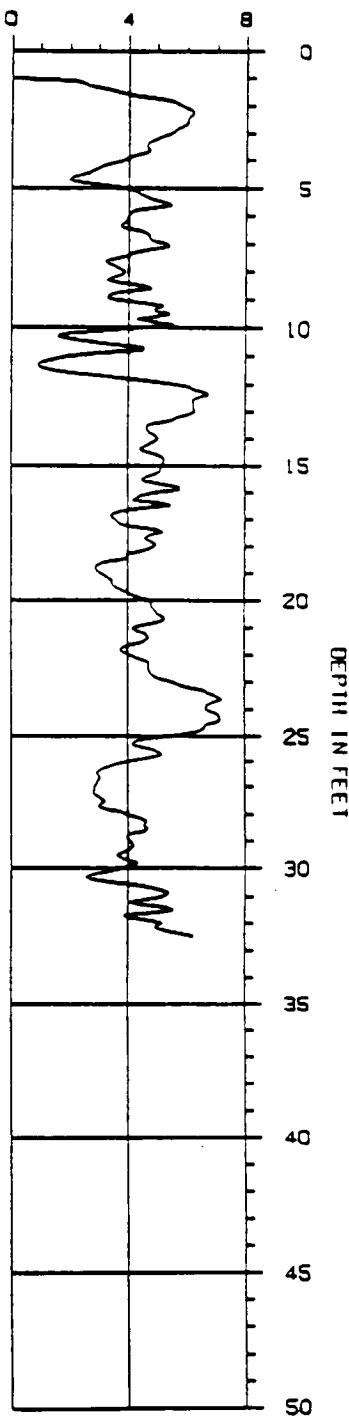

DEPTH IN FEET

TOP 1.0 FT IS DISTURBED SOIL

CONE PENETRATION TEST

SOUNDING NUMBER: CPT-5

PROJECT NAME : JMM/MOFFETT NAS


LOCATION : SUNNYVALE

PROJECT NUMBER : 9110-07002


DATE : 05-08-1991

 THE EARTH TECHNOLOGY
CORPORATION


CONE PORE PRESSURE (U)
TONS/SQ FT

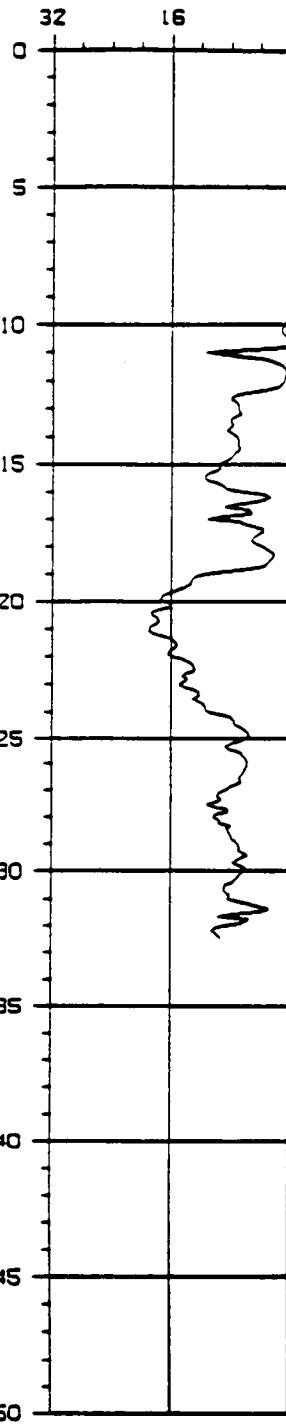

TIP RESISTANCE (QC)
TONS/SQ FT

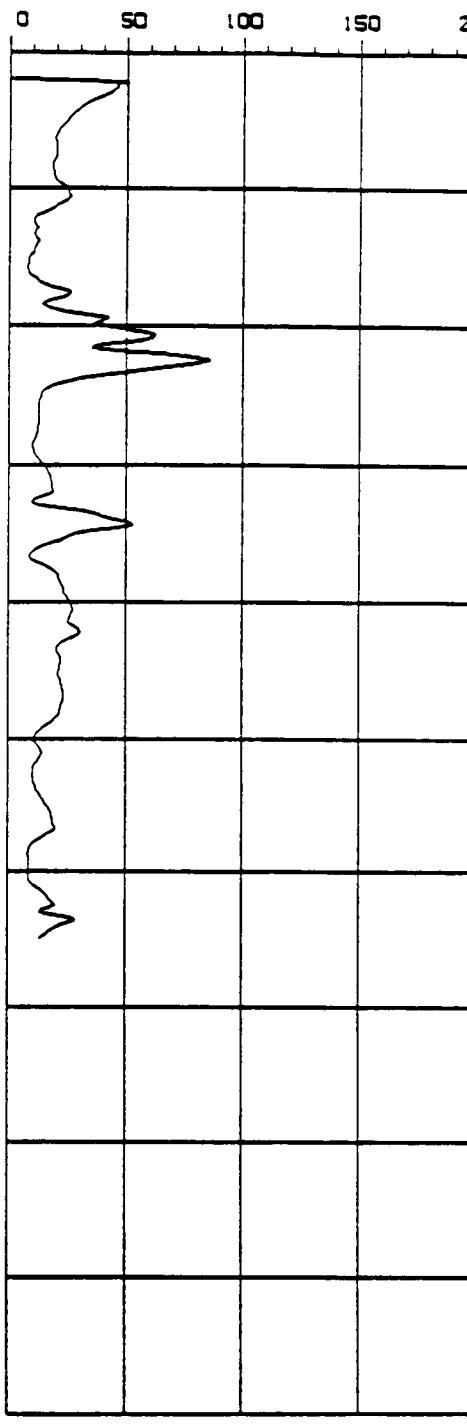

PORE PRESSURE RATIO
U/QC

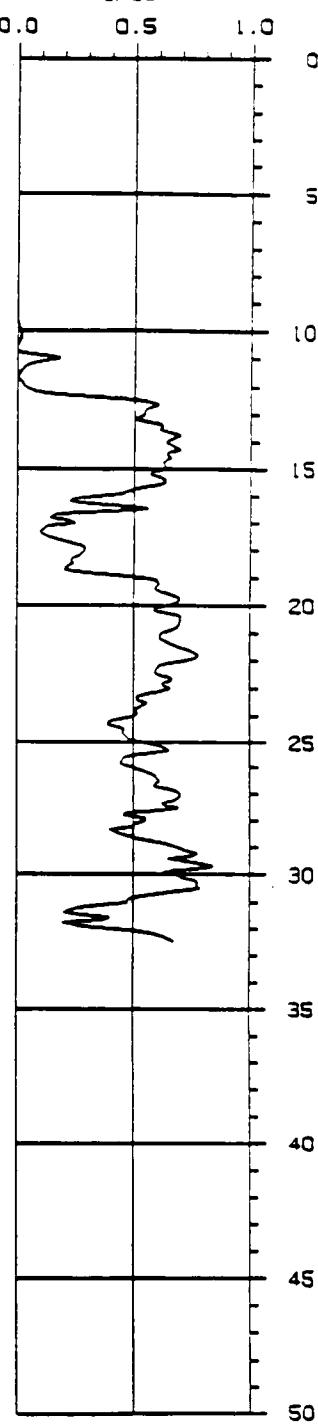

DEPTH IN FEET

DEPTH IN FEET

TOP 1.0 FT IS DISTURBED SOIL


CONE PENETRATION TEST

SOUNDING NUMBER: CPT-5

PROJECT NAME : JMM/MOFFETT NAS
PROJECT NUMBER : 9110-07002

LOCATION : SUNNYVALE
DATE : 05-08-1991

THE EARTH TECHNOLOGY
CORPORATION

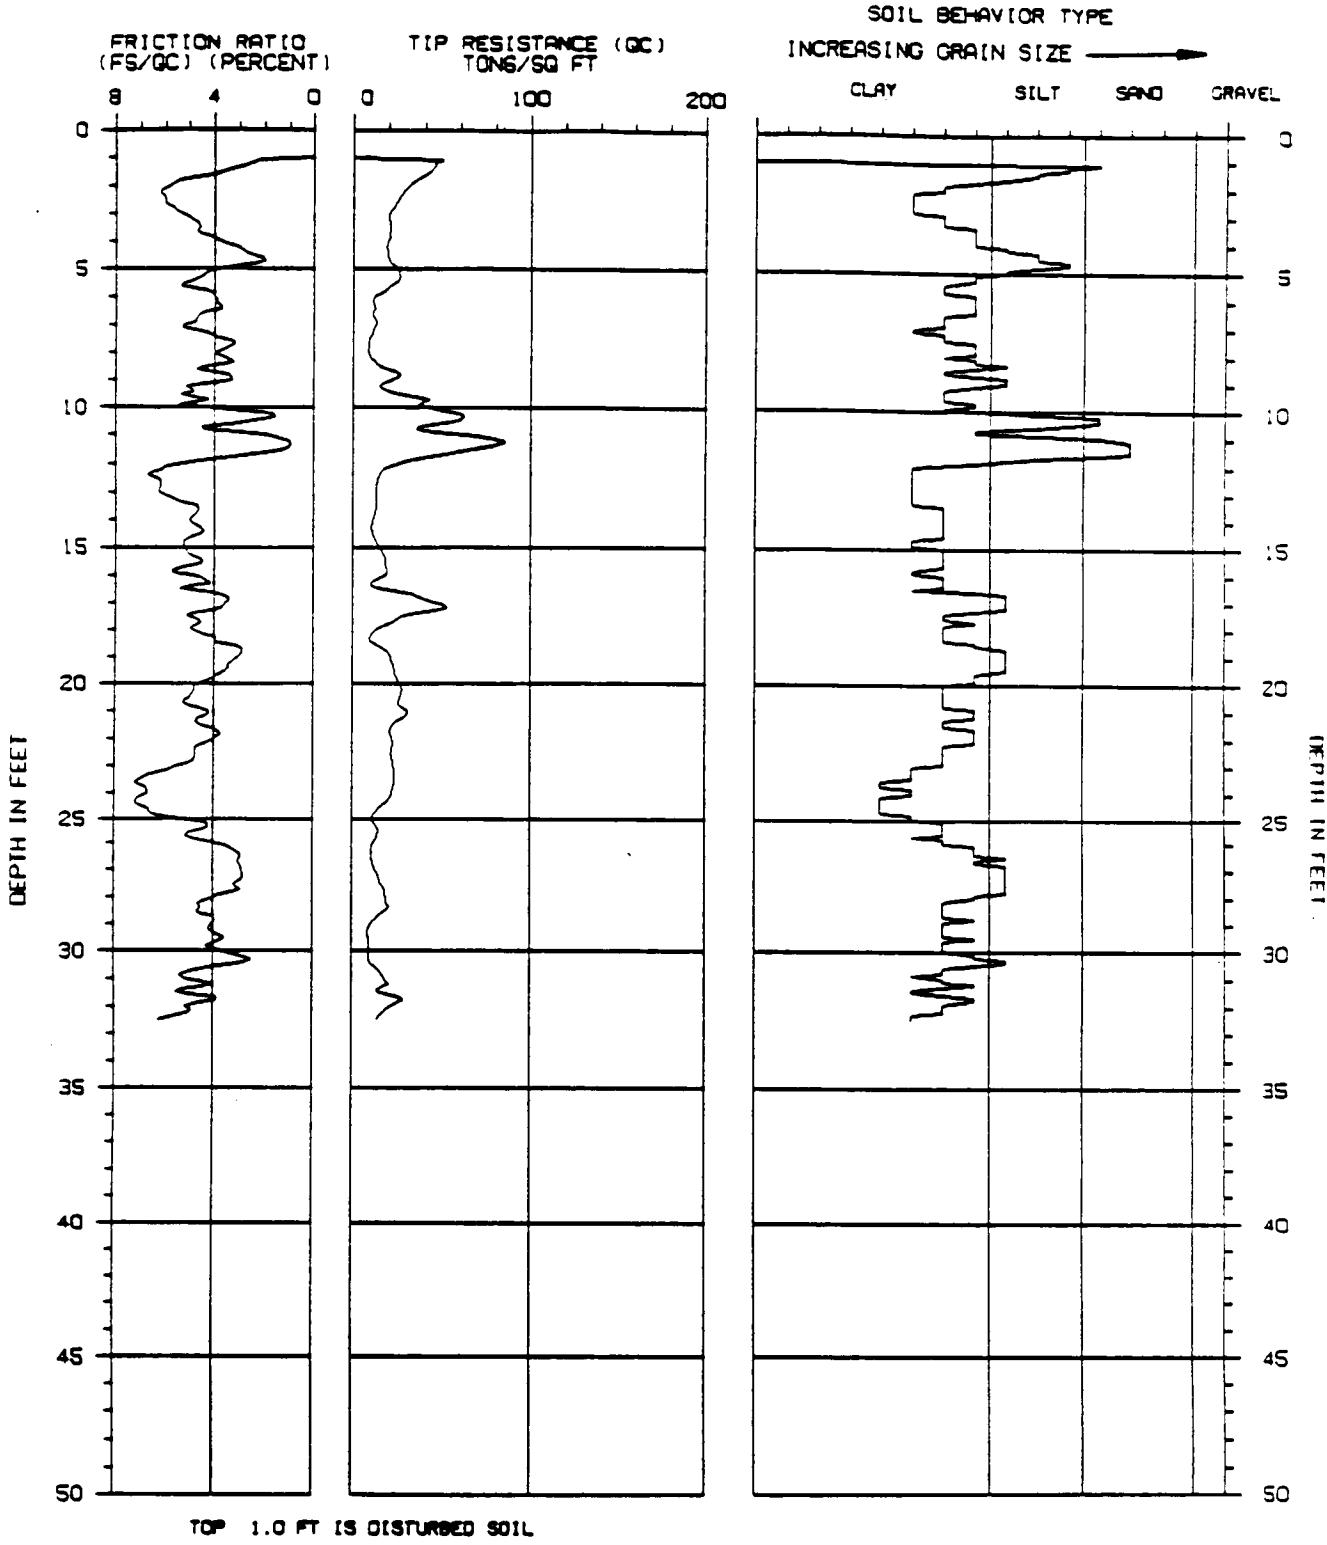

ASSUMED TOTAL UNIT WT = 110 PCF

ASSUMED DEPTH OF WATER TABLE = 6.0 FT


CONE PENETRATION TEST

SOUNDING NUMBER: CPT-5

PROJECT NAME : JMM/MOFFETT NAS
PROJECT NUMBER : 9110-07002

LOCATION : SUNNYVALE
DATE : 05-08-1991

 THE EARTH TECHNOLOGY CORPORATION

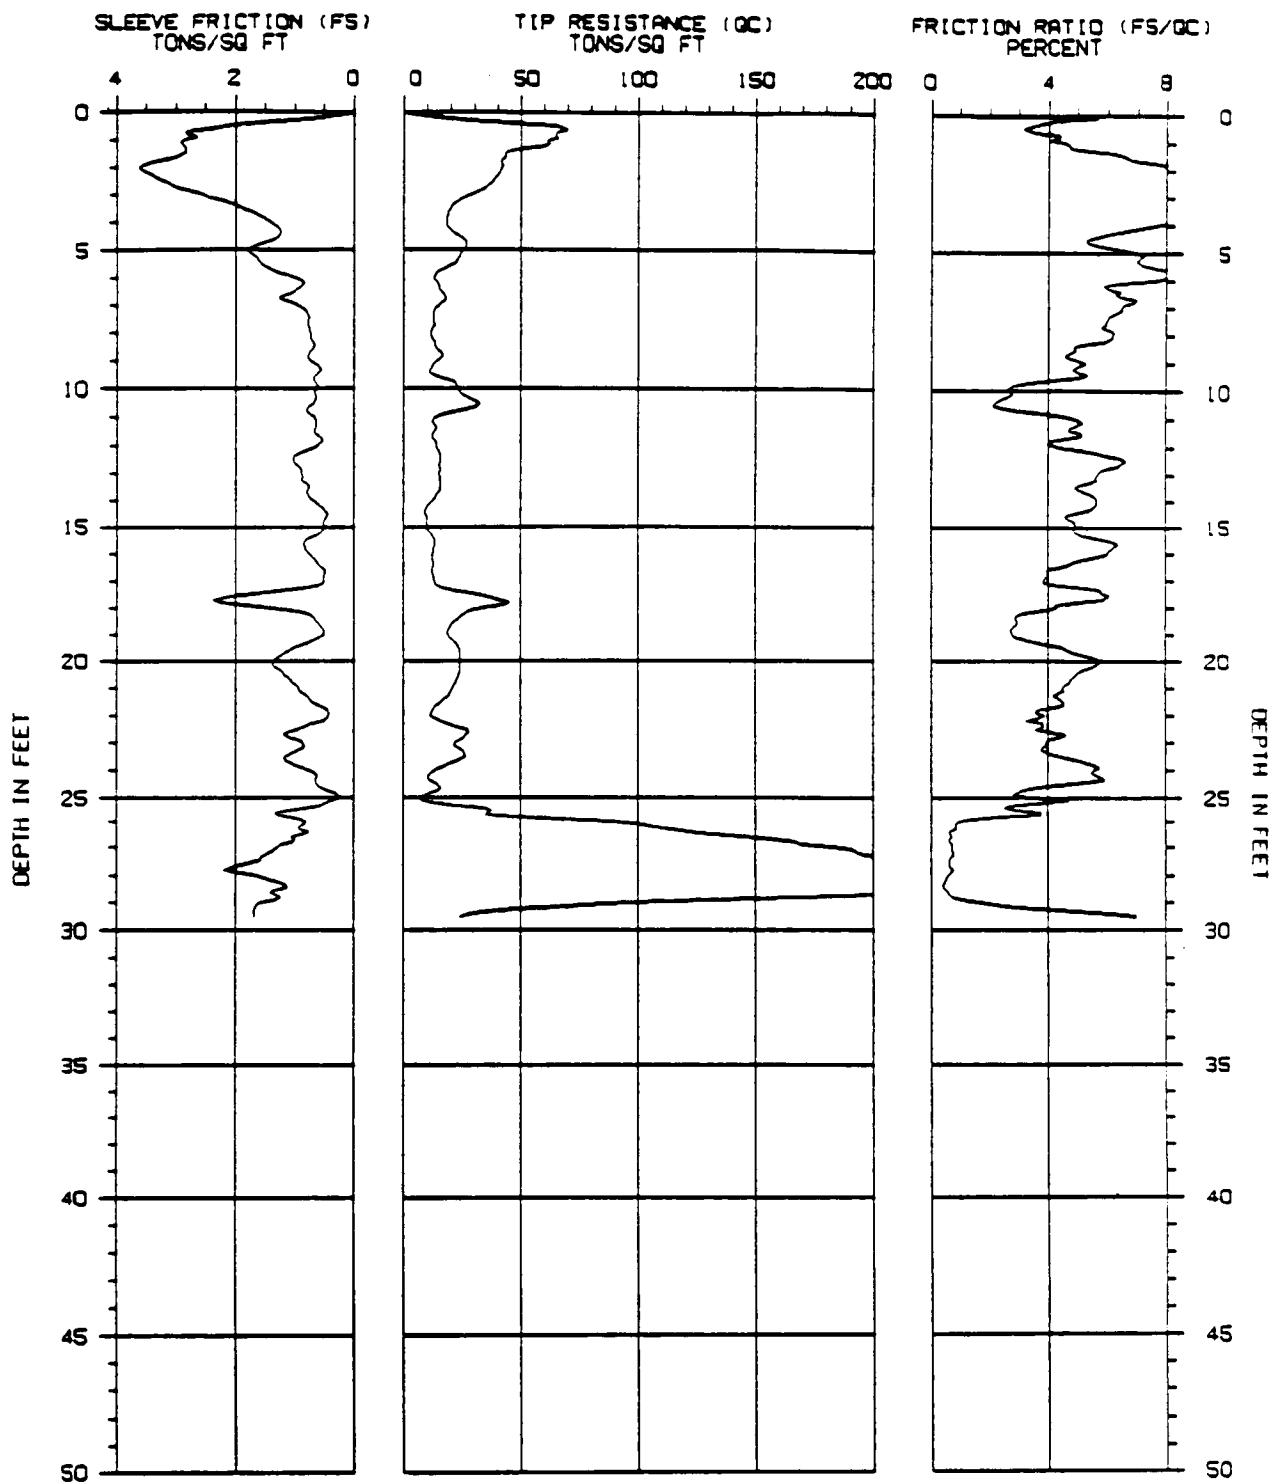

CONE PENETRATION TEST

SOUNDING NUMBER: CPT-10

PROJECT NAME : JMM/MOFFETT NAS
PROJECT NUMBER : 9110-07002




LOCATION : SUNNYVALE
DATE : 05-07-1991

 THE EARTH TECHNOLOGY
CORPORATION

CONE PORE PRESSURE (U)
TONS/SQ FT

TIP RESISTANCE (qc)
TONS/SQ FT

PORE PRESSURE RATIO
 U/qc

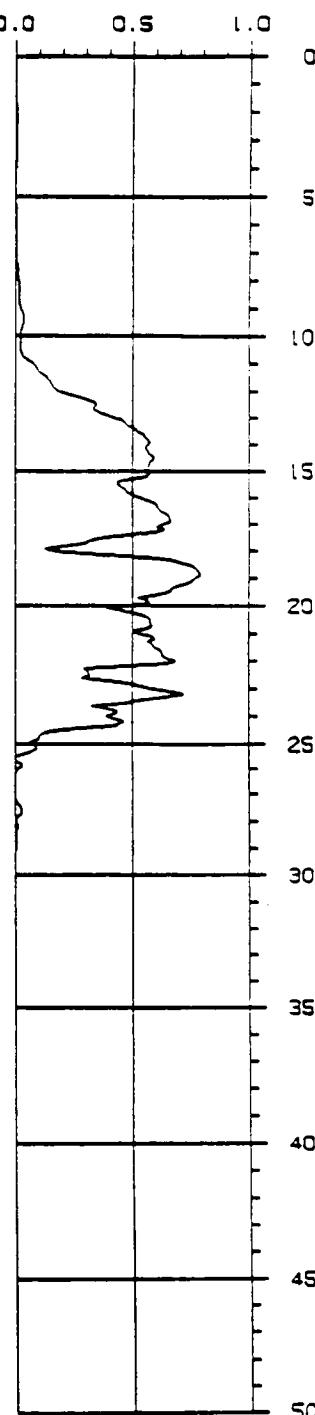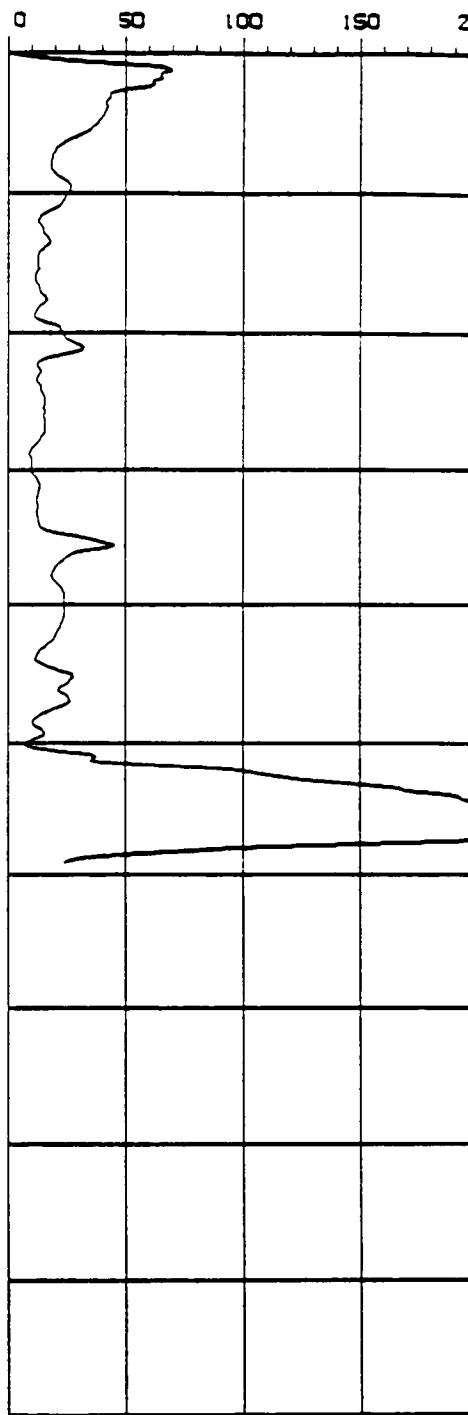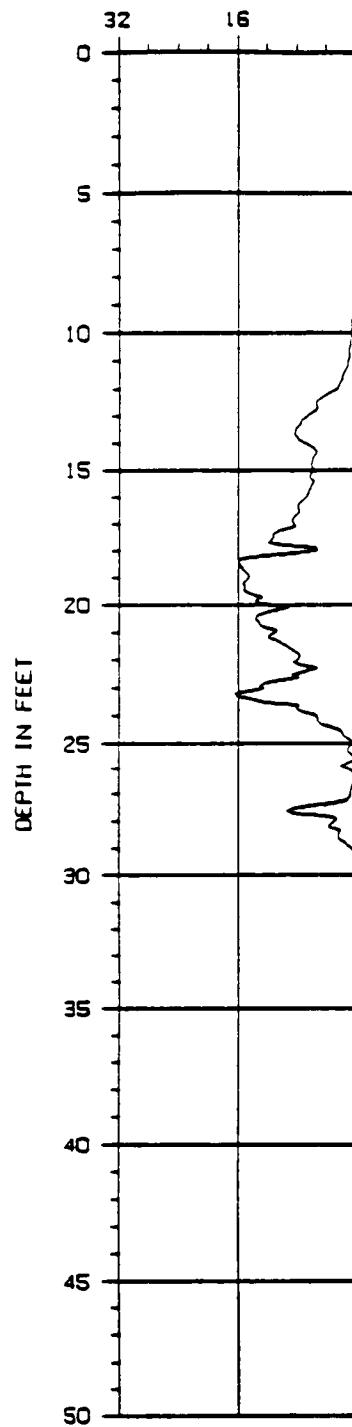


CONE PENETRATION TEST

SOUNDING NUMBER: CPT-10

PROJECT NAME : JMM/MOFFETT NAS
PROJECT NUMBER : 9110-07002

LOCATION : SUNNYVALE
DATE : 05-07-1991

 THE EARTH TECHNOLOGY
CORPORATION

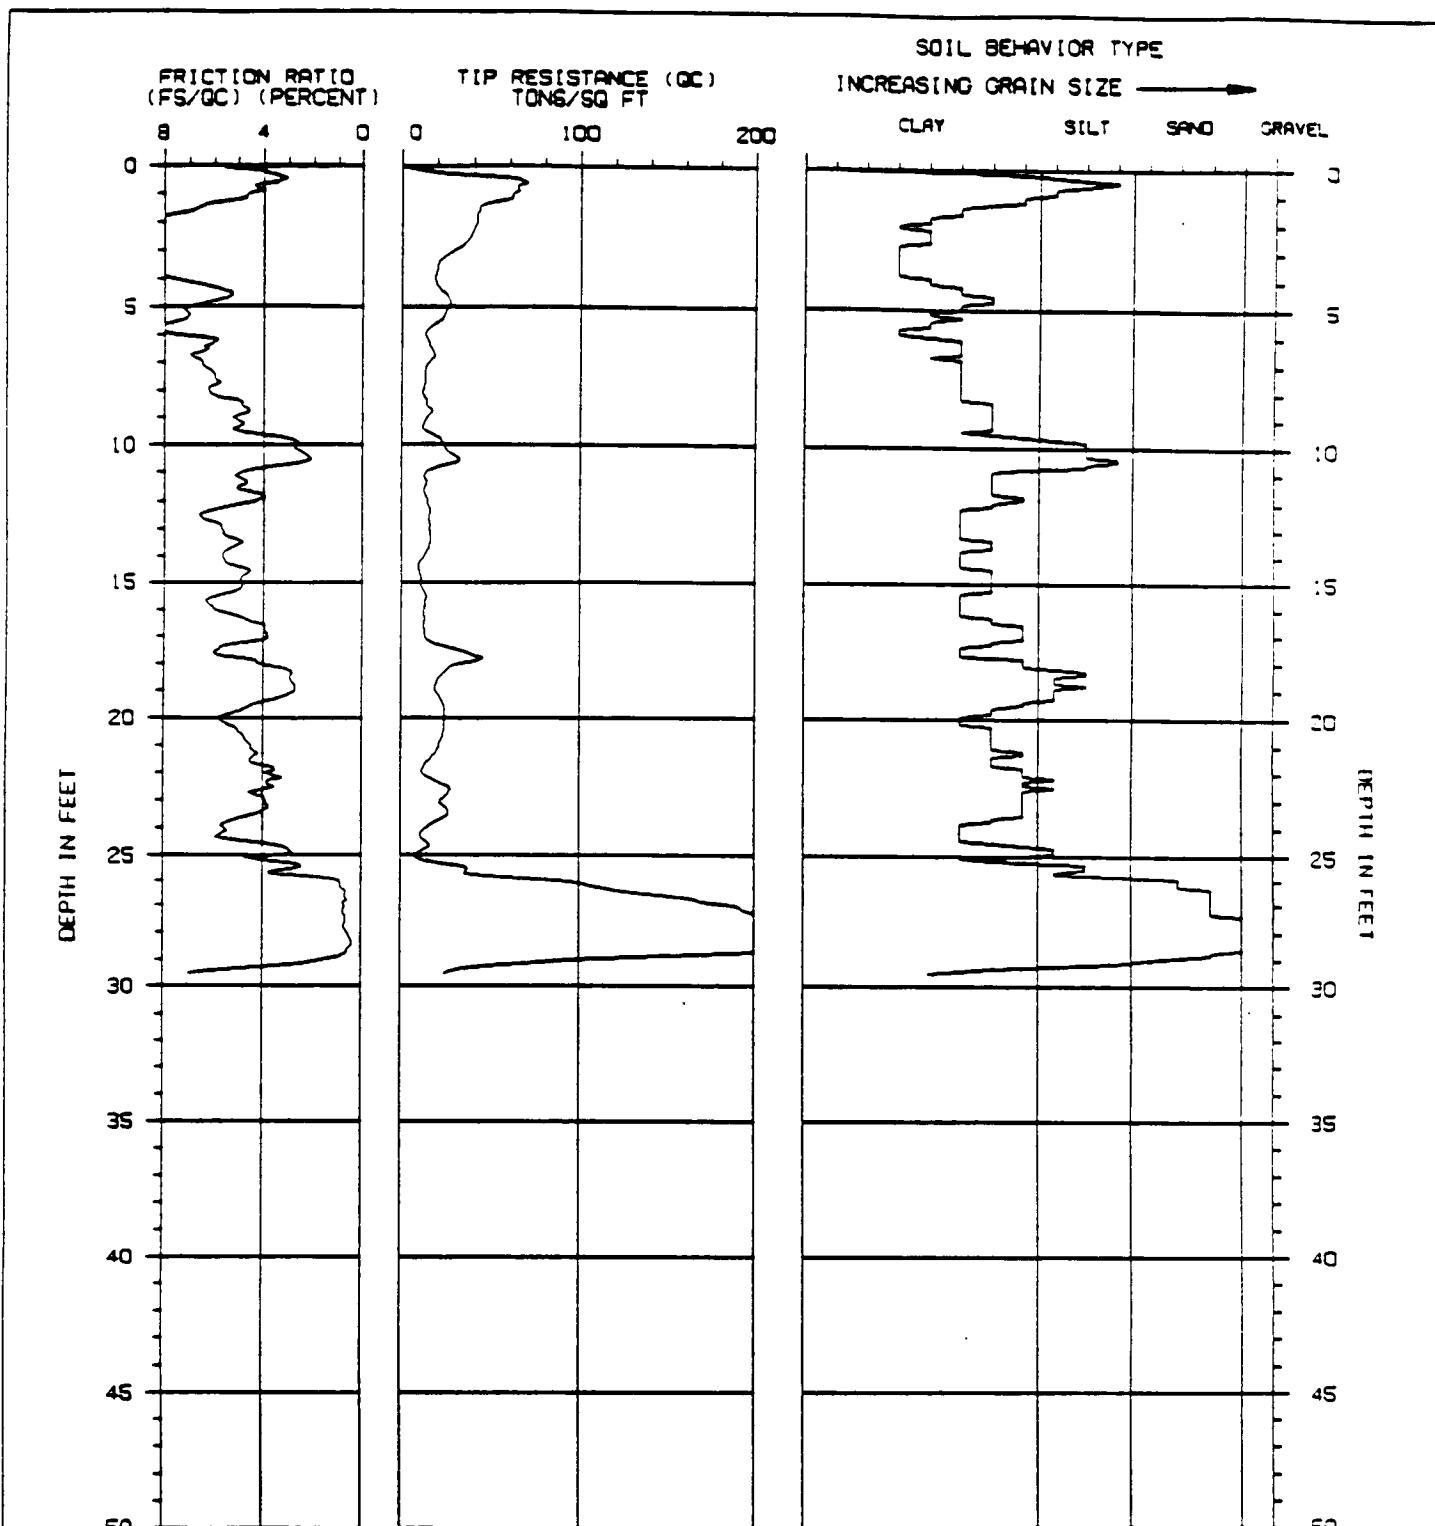

ASSUMED TOTAL UNIT WT = 110 PCF

ASSUMED DEPTH OF WATER TABLE = 5.0 FT


CONE PENETRATION TEST

SOUNDING NUMBER: CPT-10

PROJECT NAME : JMM/MOFFETT NAS
PROJECT NUMBER : 9110-07002

LOCATION : SUNNYVALE
DATE : 05-07-1991

 THE EARTH TECHNOLOGY
CORPORATION

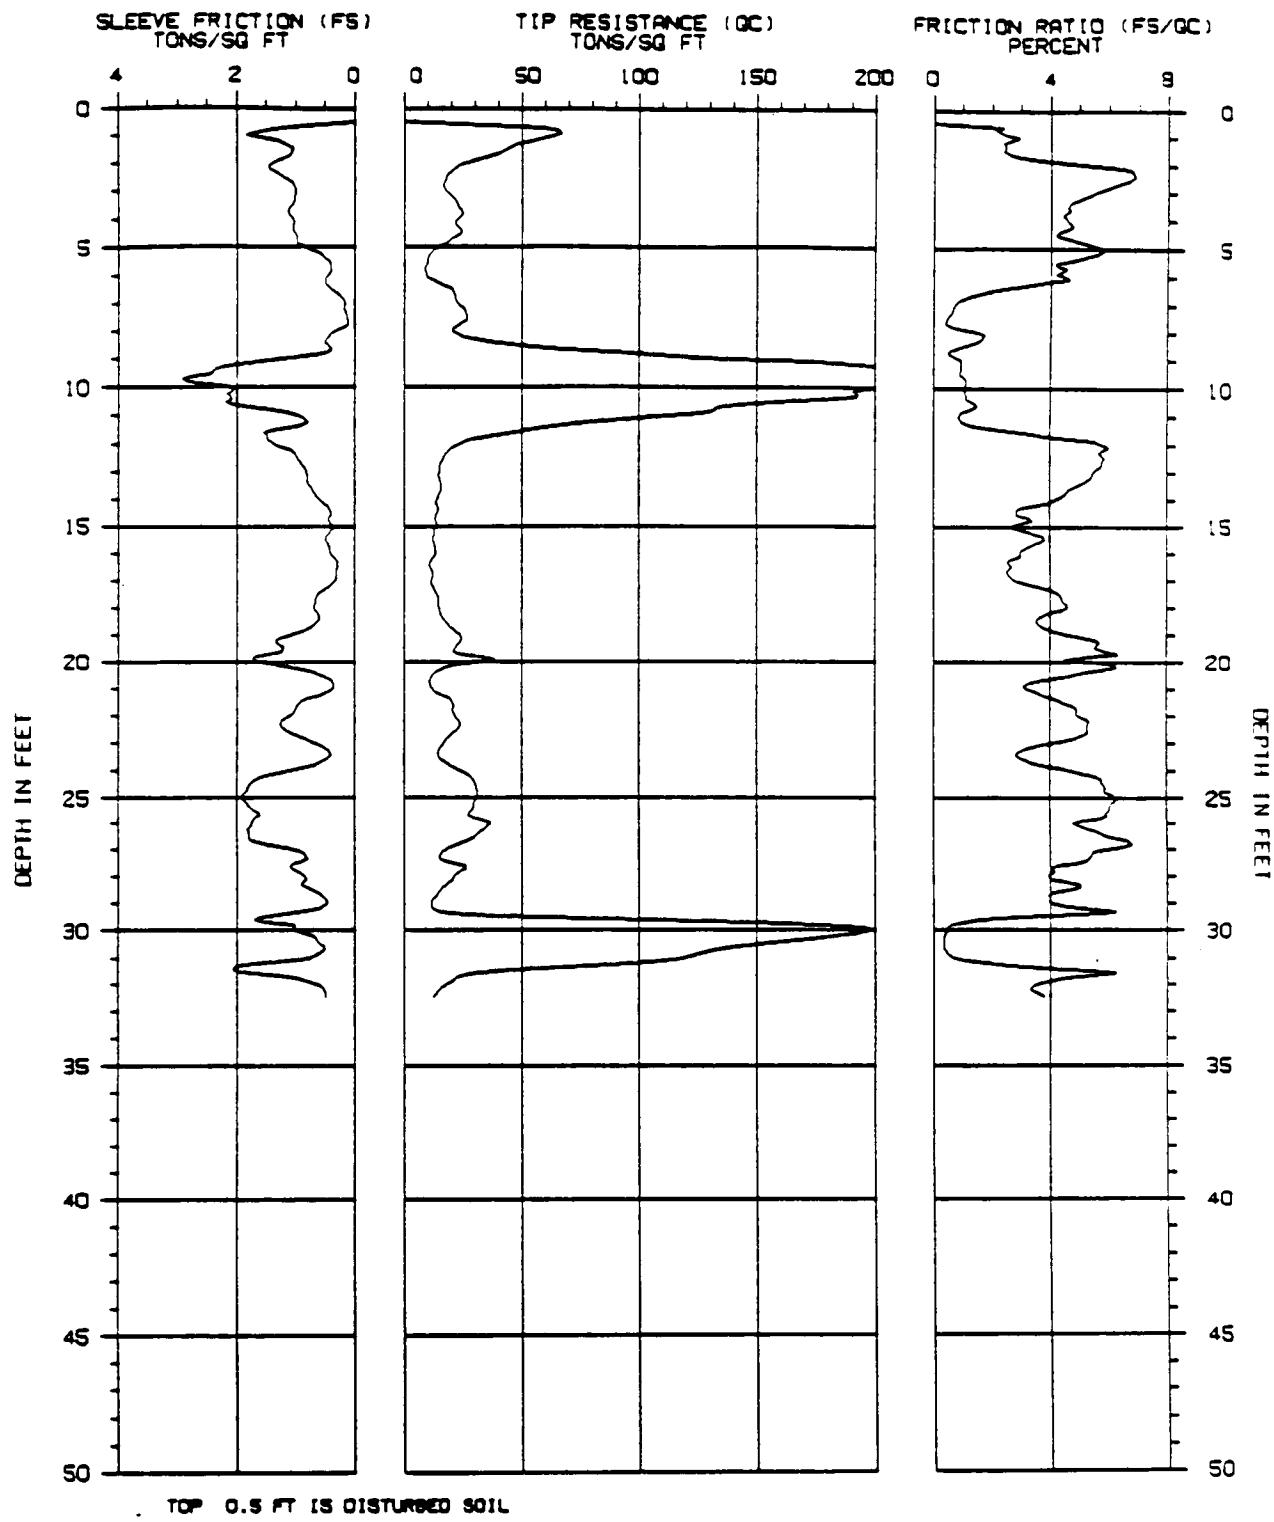

CONE PENETRATION TEST


SOUNDING NUMBER: CPT-11

PROJECT NAME : JMM/MOFFETT NAS
 PROJECT NUMBER : 9110-07002


LOCATION : SUNNYVALE
 DATE : 05-08-1991

 THE EARTH TECHNOLOGY
CORPORATION


CONE PORE PRESSURE (U)
TONS/SQ FT

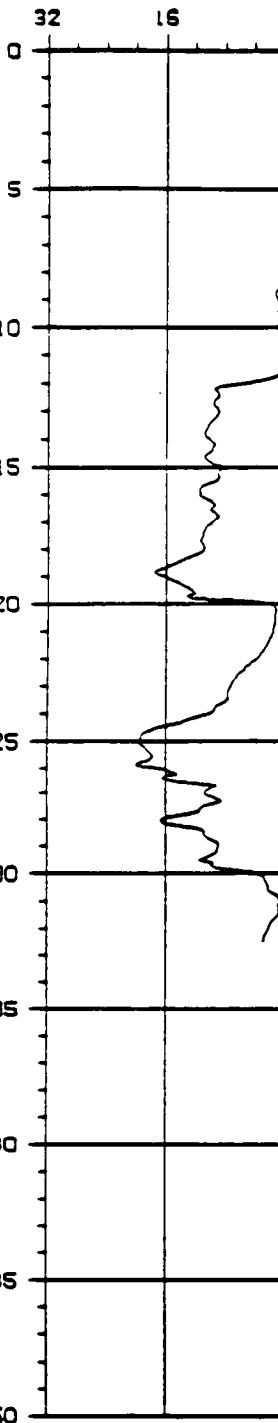

TIP RESISTANCE (QC)
TONS/SQ FT

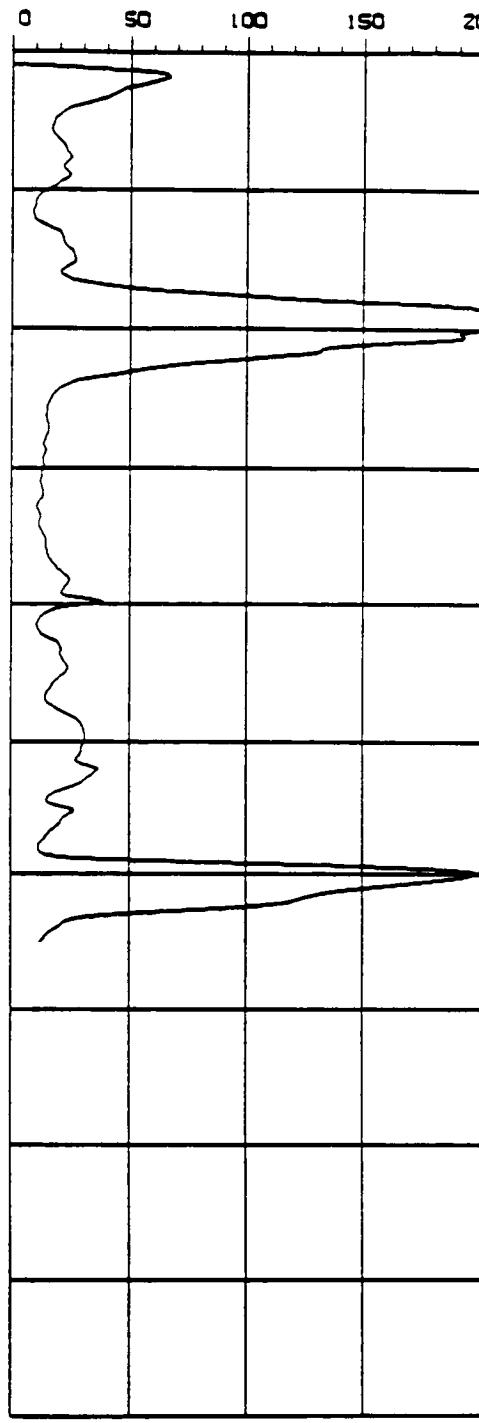

PORE PRESSURE RATIO
U/QC

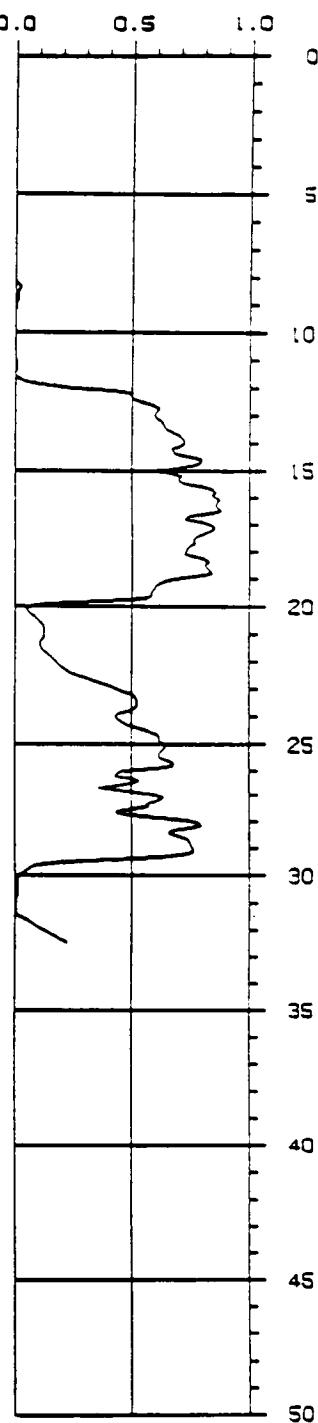

DEPTH IN FEET

DEPTH IN FEET

TOP 0.5 FT IS DISTURBED SOIL


CONE PENETRATION TEST

SOUNDING NUMBER: CPT-11

PROJECT NAME : JMM/MOFFETT NAS
PROJECT NUMBER : 9110-07002

LOCATION : SUNNYVALE
DATE : 05-08-1991

 THE EARTH TECHNOLOGY
CORPORATION

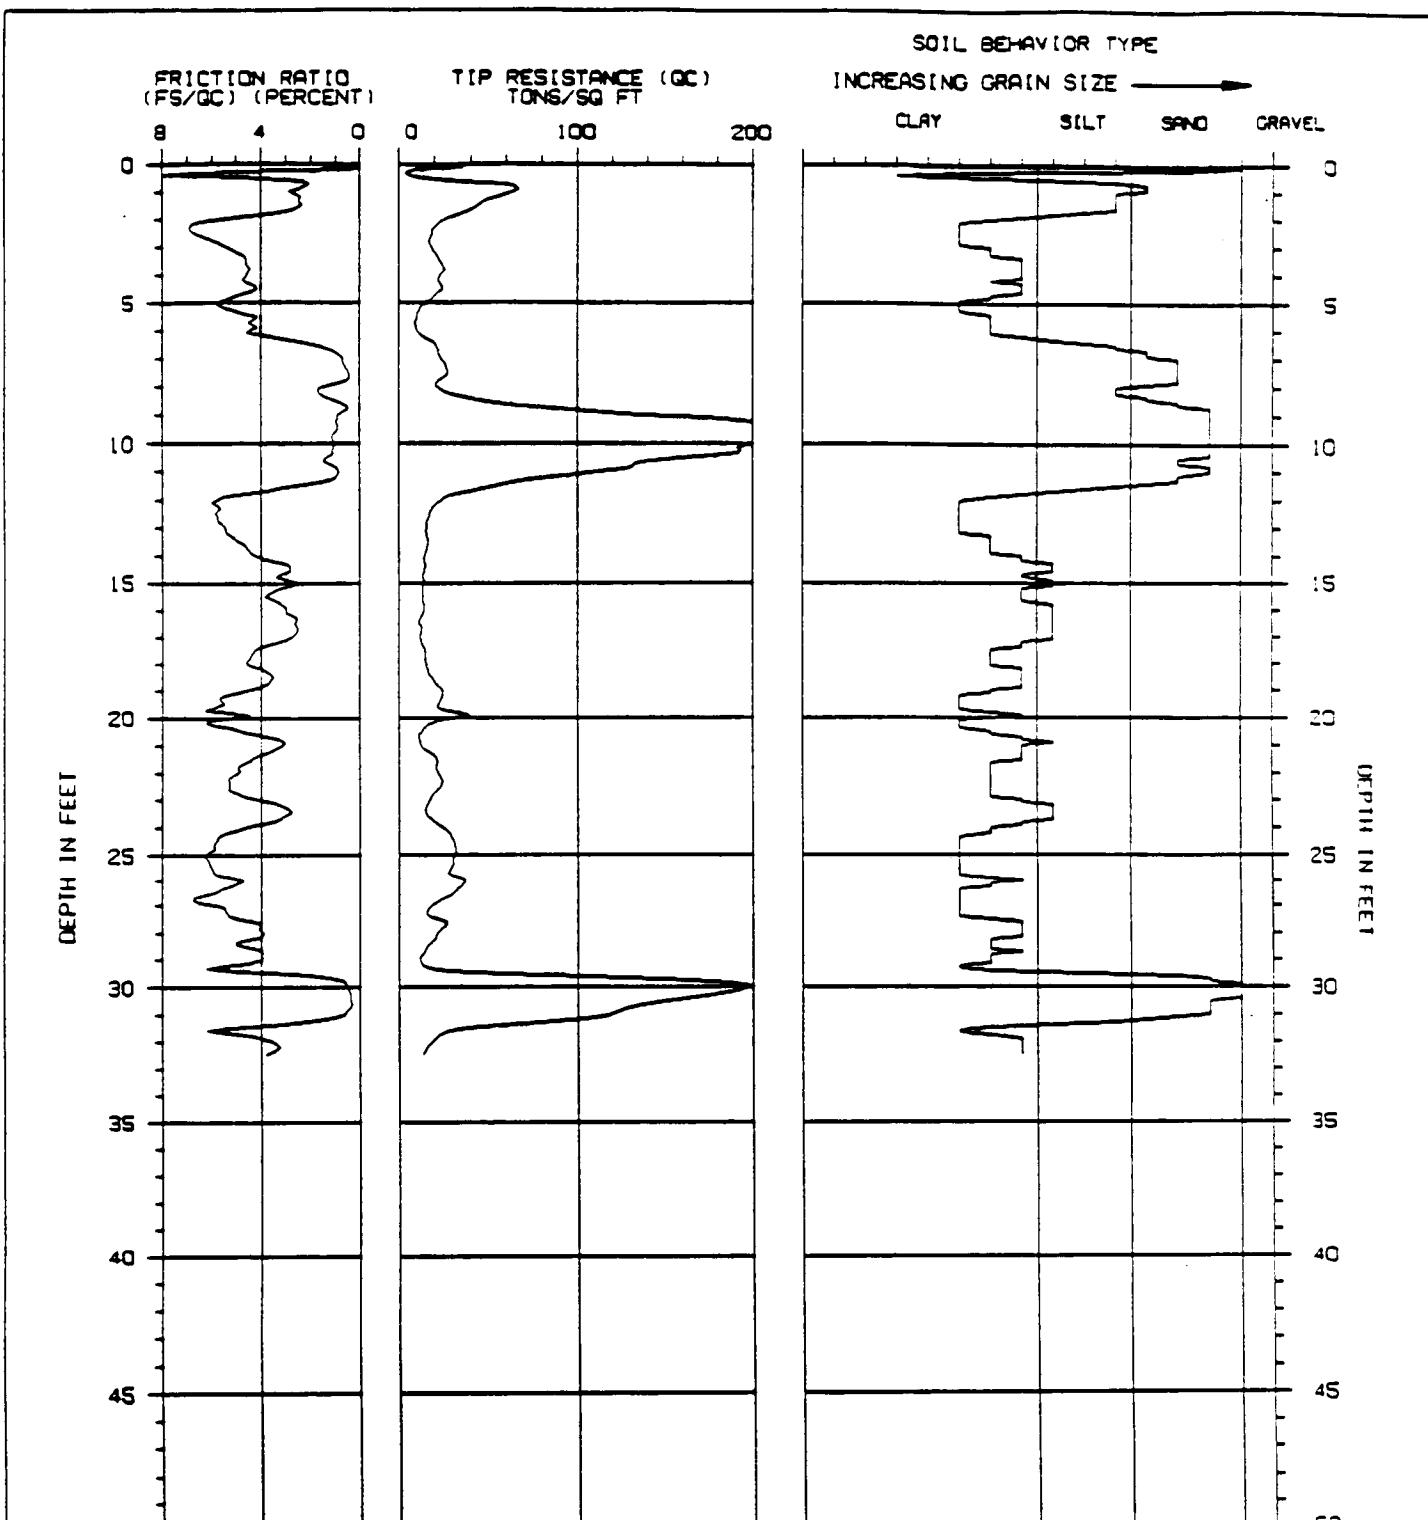

ASSUMED TOTAL UNIT WT = 110 PCF

ASSUMED DEPTH OF WATER TABLE = 5.0 FT

CONE PENETRATION TEST


SOUNDING NUMBER: CPT-11

PROJECT NAME : JMM/MOFFETT NAS
PROJECT NUMBER : 9110-07002


LOCATION : SUNNYVALE
DATE : 05-08-1991

 THE EARTH TECHNOLOGY CORPORATION


CONE PORE PRESSURE (U)
TONS/SQ FT

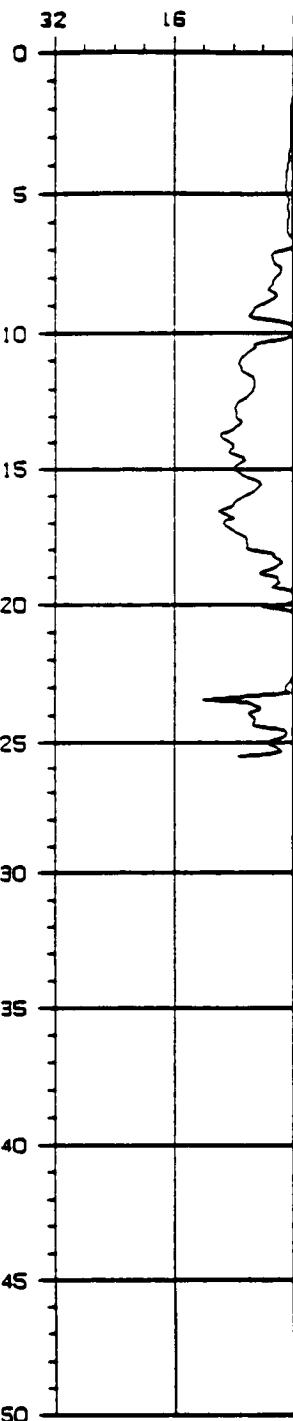

TIP RESISTANCE (QC)
TONS/SQ FT

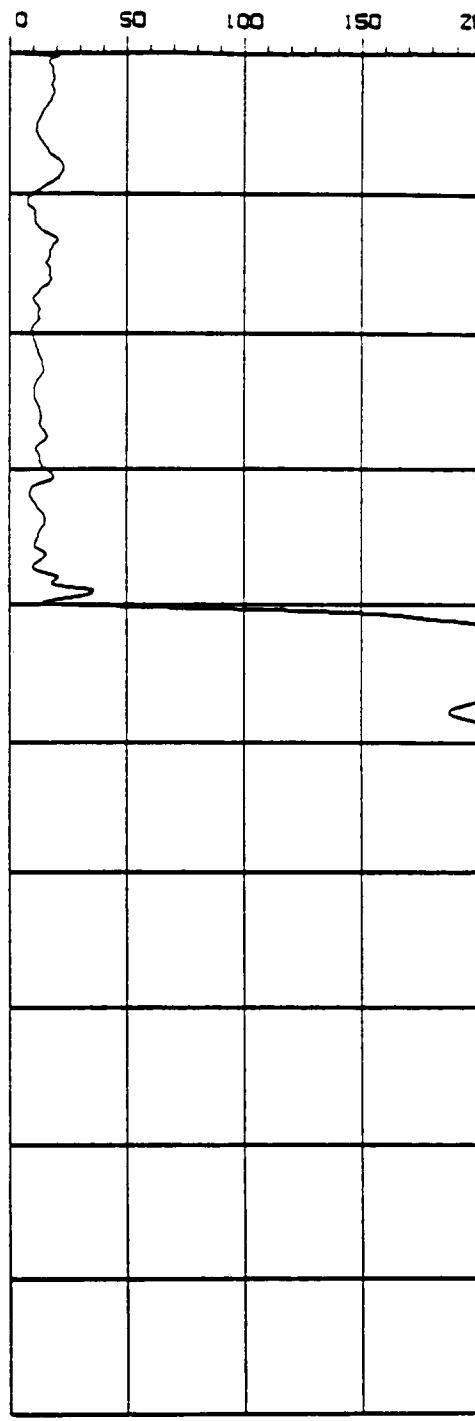

PORE PRESSURE RATIO
U/QC

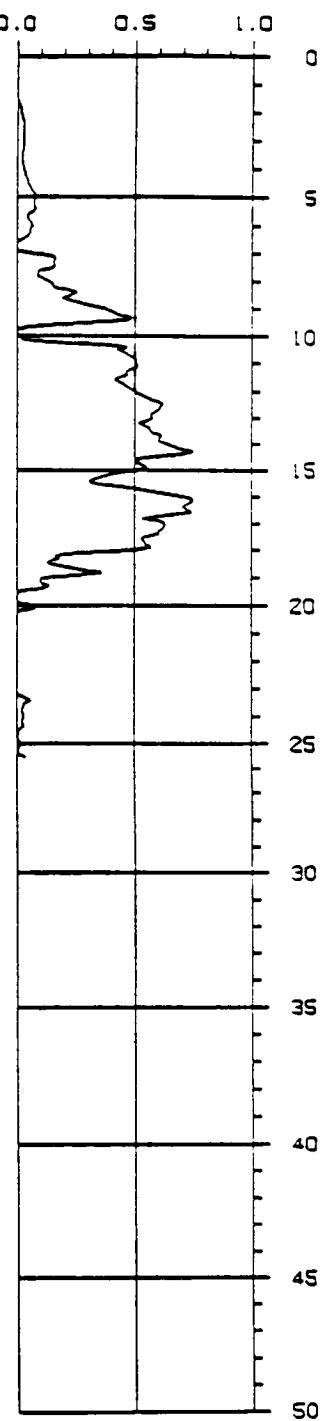

CONE PENETRATION TEST


SOUNDING NUMBER: CPT-14

PROJECT NAME : JMM/MOFFETT NAS
PROJECT NUMBER : 9110-07002


LOCATION : SUNNYVALE
DATE : 05-08-1991

 THE EARTH TECHNOLOGY
CORPORATION


SLEEVE FRICTION (FS)
TONS/SQ FT

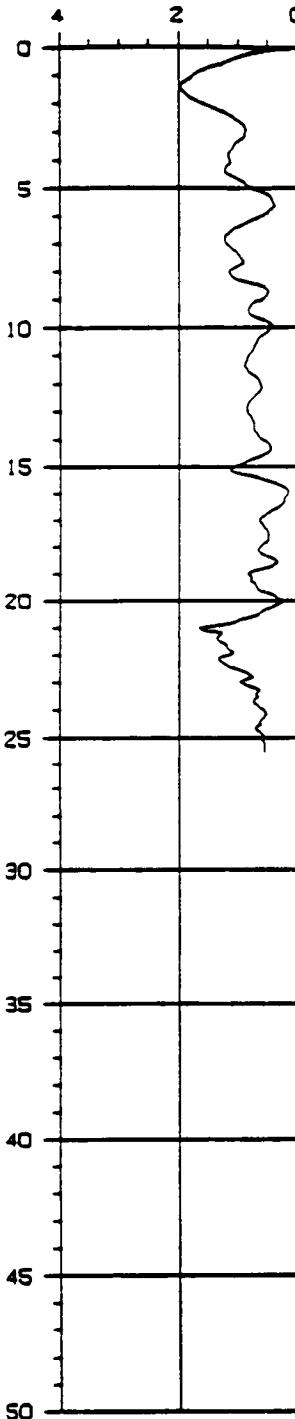

TIP RESISTANCE (QC)
TONS/SQ FT

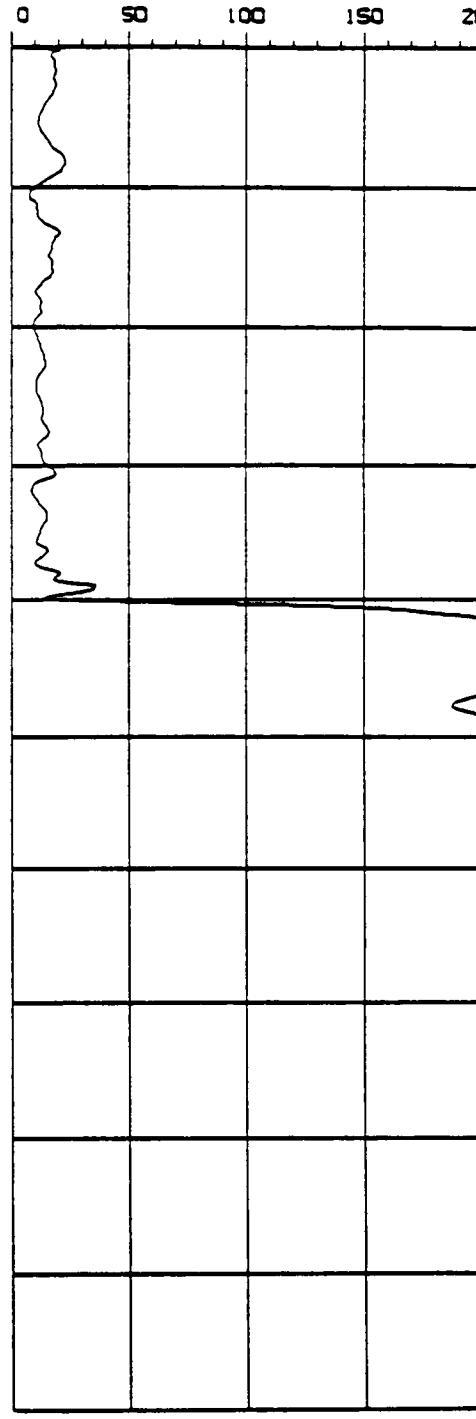

FRICTION RATIO (FS/QC)
PERCENT

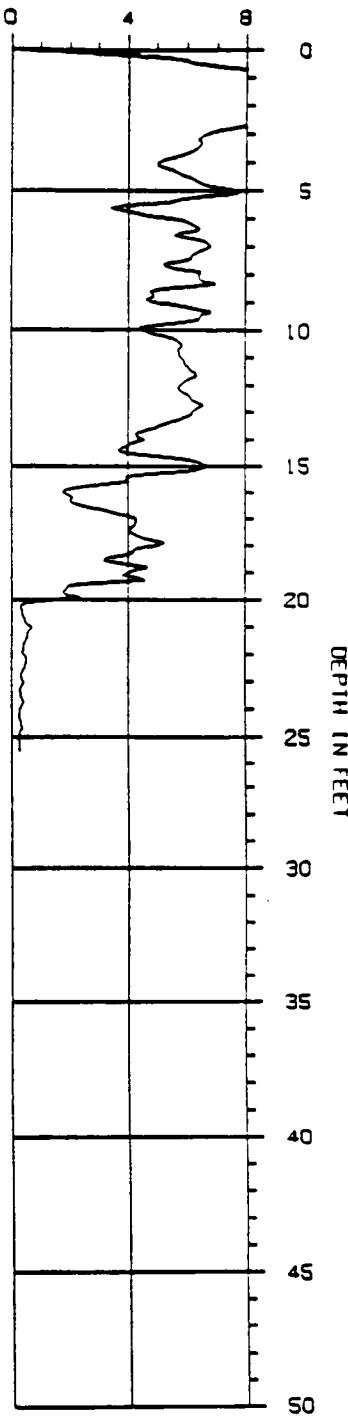


CONE PENETRATION TEST

SOUNDING NUMBER: CPT-14

PROJECT NAME : JMM/MOFFETT NAS
PROJECT NUMBER : 9110-07002

LOCATION : SUNNYVALE
DATE : 05-08-1991

 THE EARTH TECHNOLOGY
CORPORATION

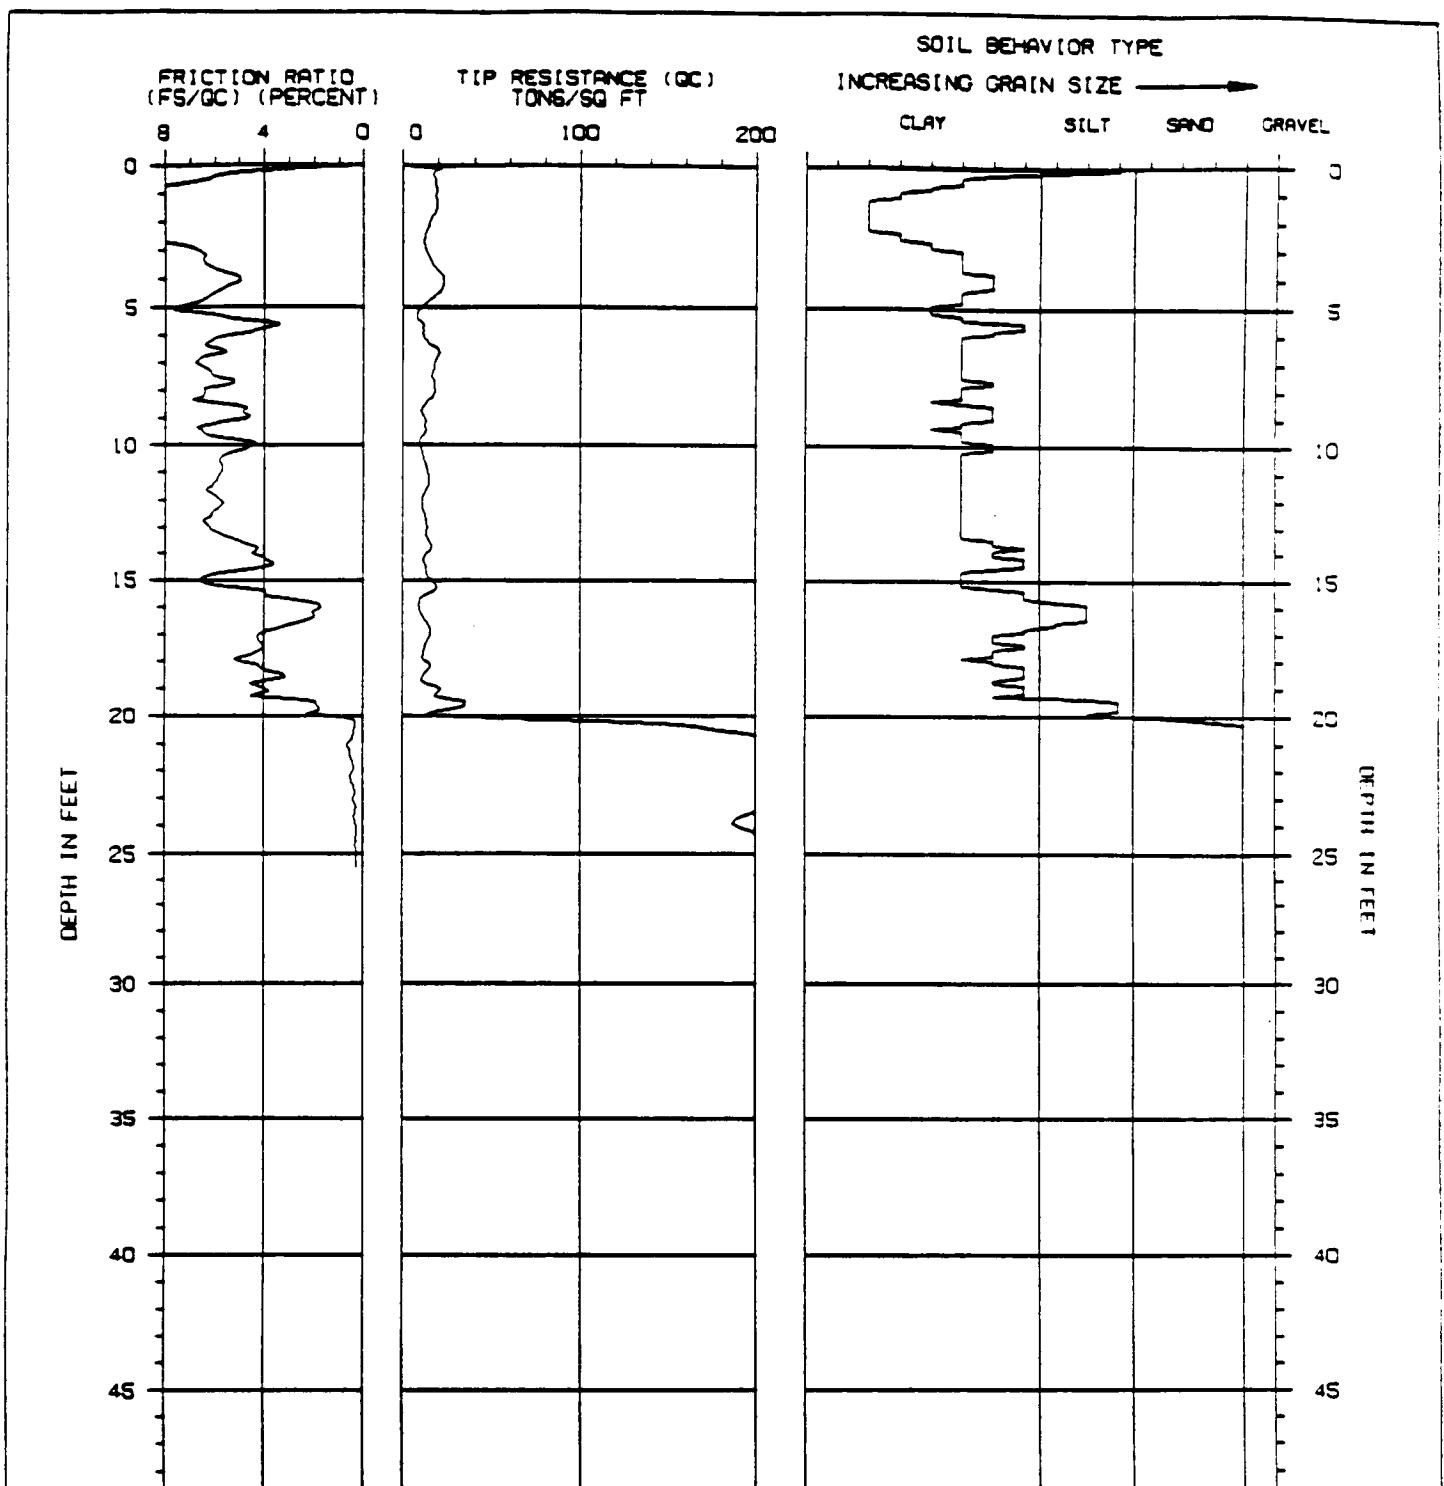

ASSUMED TOTAL UNIT WT = 110 PCF

ASSUMED DEPTH OF WATER TABLE = 5.0 FT

CONE PENETRATION TEST


SOUNDING NUMBER: CPT-14

PROJECT NAME : JMM/MOFFETT NAS
PROJECT NUMBER : 9110-07002


LOCATION : SUNNYVALE
DATE : 05-08-1991

 THE EARTH TECHNOLOGY CORPORATION


SLEEVE FRICTION (FS)
TONS/SQ FT

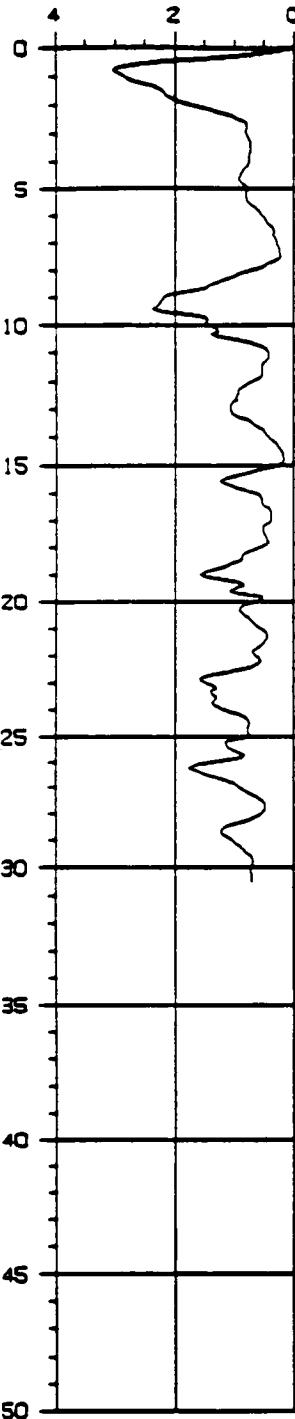

TIP RESISTANCE (QC)
TONS/SQ FT

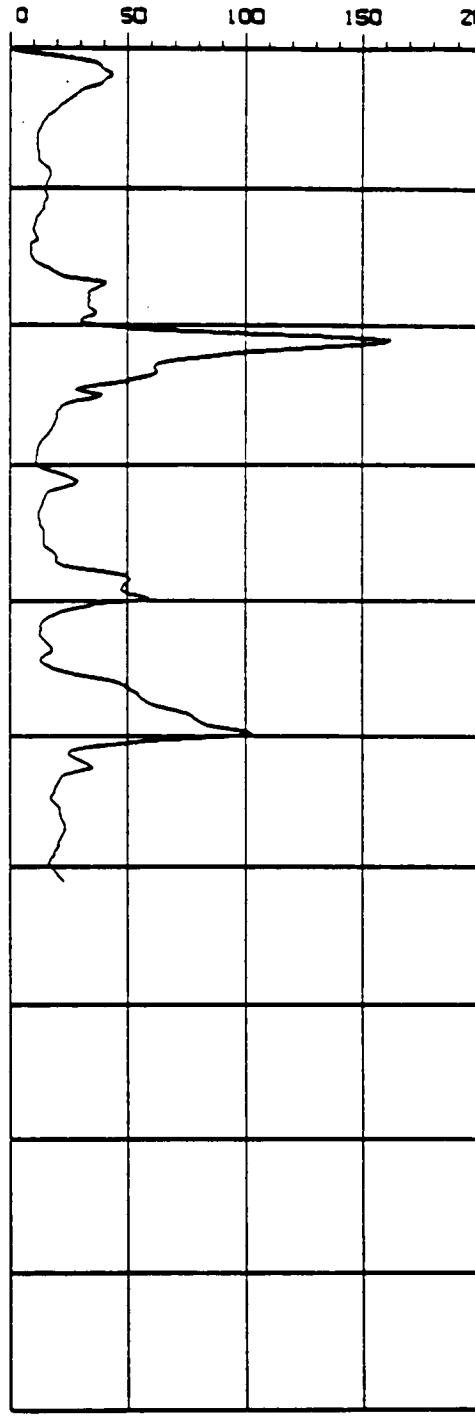

FRICTION RATIO (FS/QC)
PERCENT

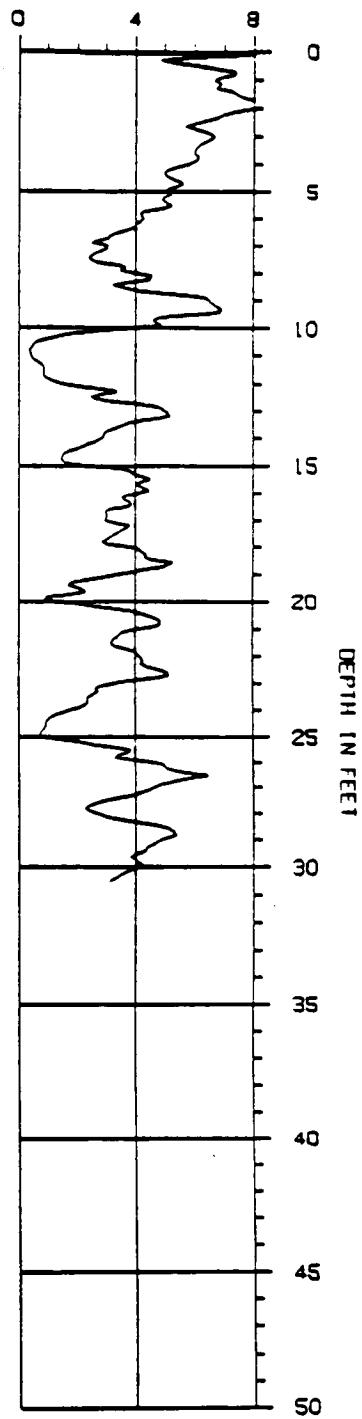

CONE PENETRATION TEST


SOUNDING NUMBER: CPT-20

PROJECT NAME : JMM/MOFFETT NAS
PROJECT NUMBER : 9110-07002


LOCATION : SUNNYVALE
DATE : 05-06-1991

 THE EARTH TECHNOLOGY
CORPORATION


CONE PORE PRESSURE (U)
TONS/SQ FT

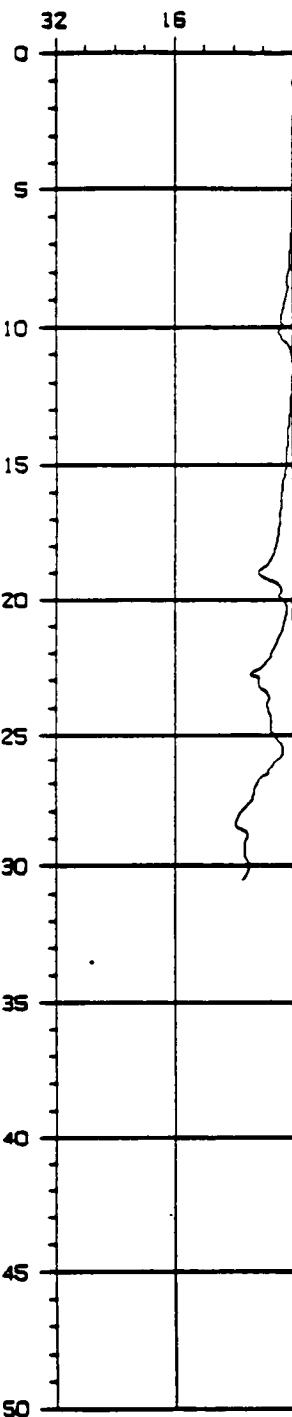

TIP RESISTANCE (qc)
TONS/SQ FT

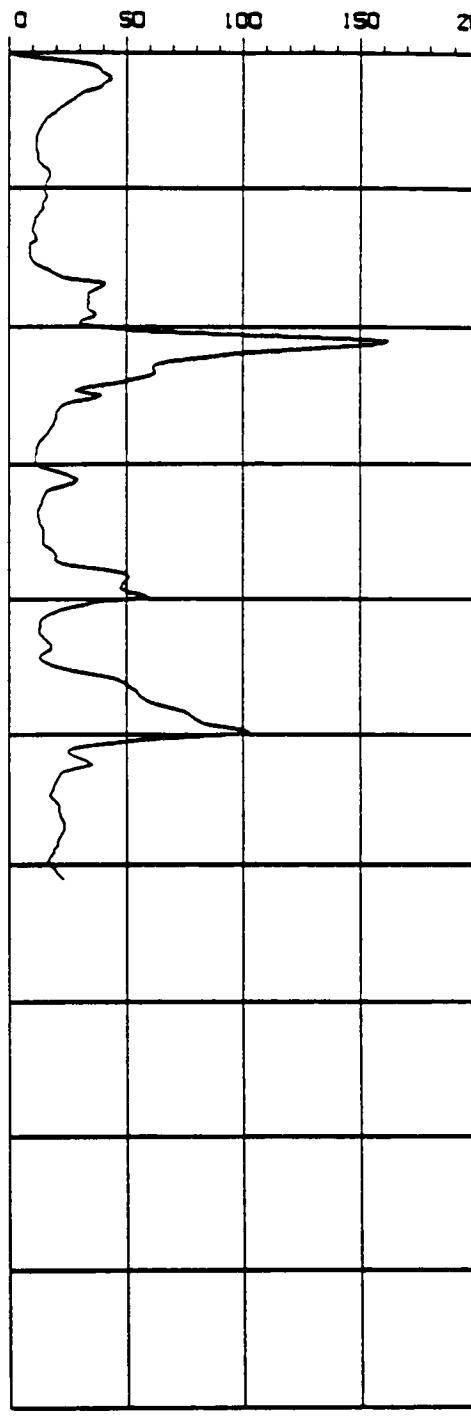

PORE PRESSURE RATIO
 U/qc

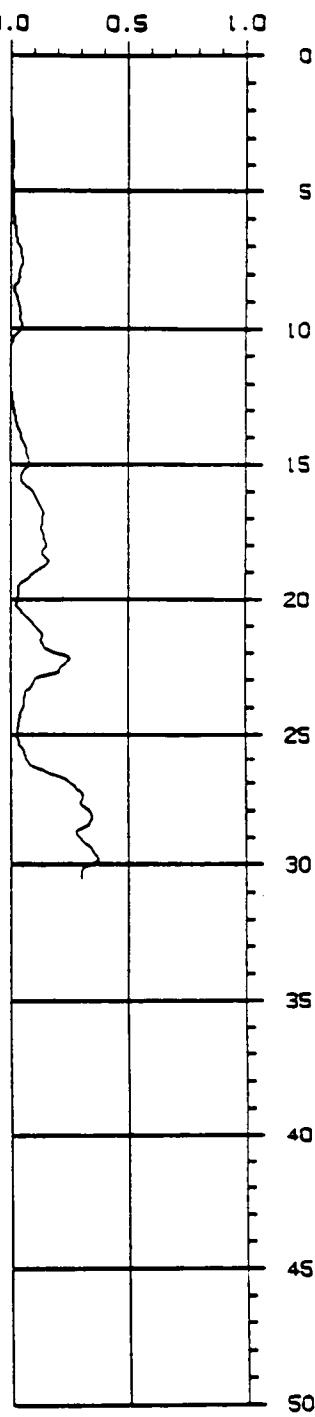




CONE PENETRATION TEST

SOUNDING NUMBER: CPT-20

PROJECT NAME : JMM/MOFFETT NAS
PROJECT NUMBER : 9110-07002

LOCATION : SUNNYVALE
DATE : 05-06-1991

THE EARTH TECHNOLOGY
CORPORATION

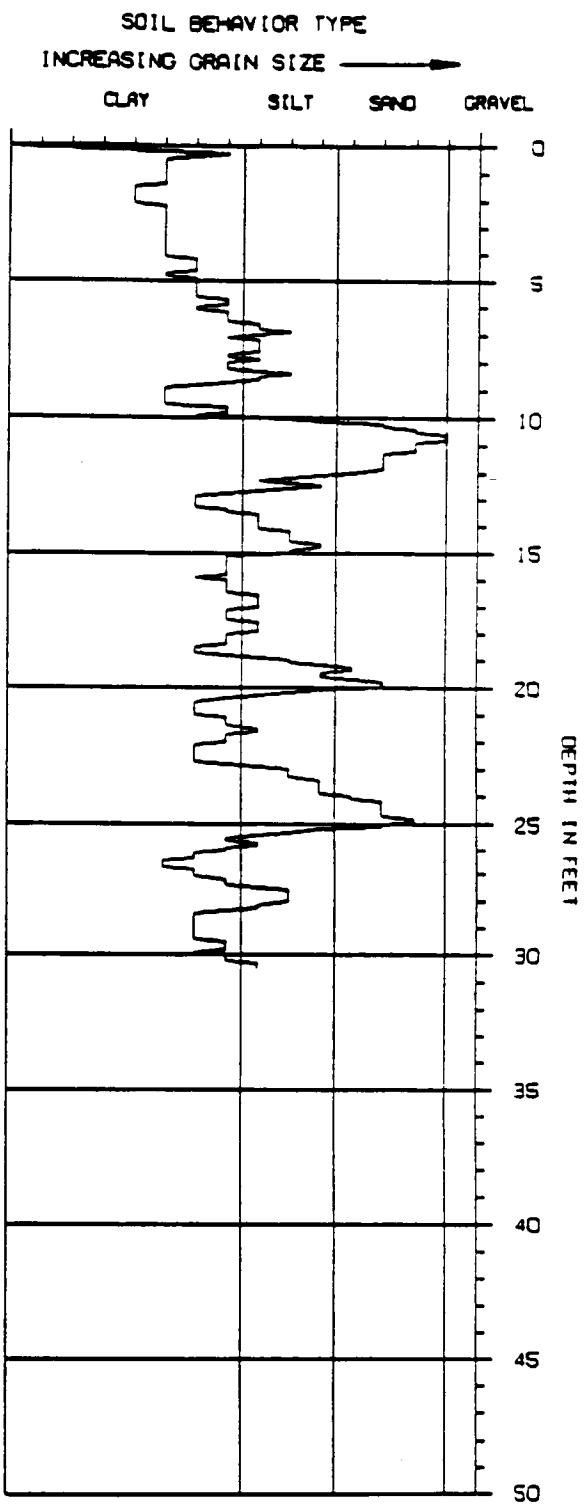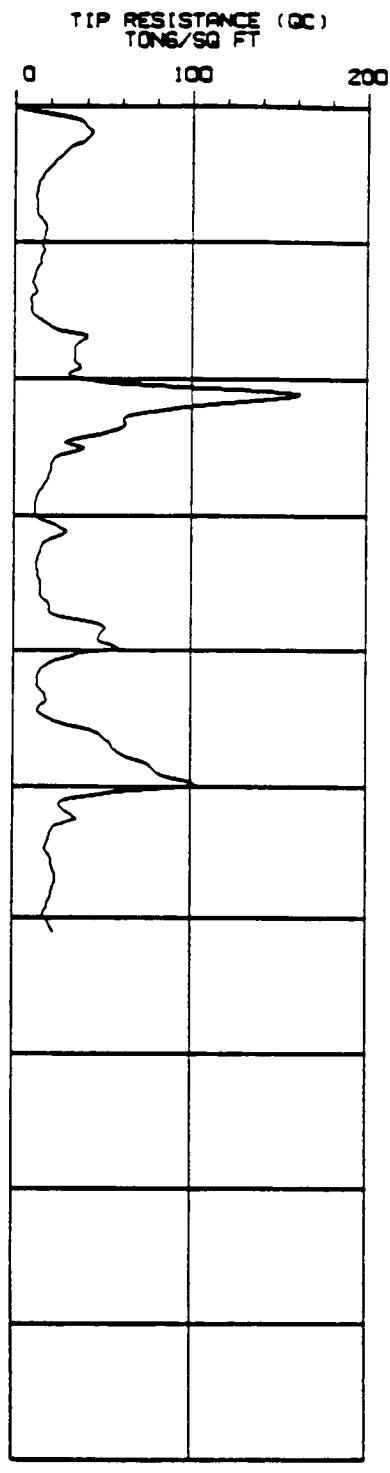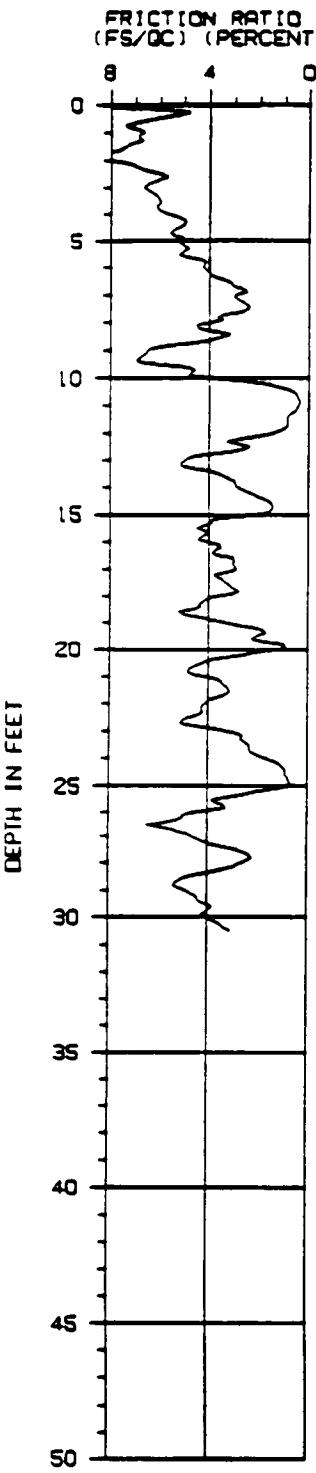

ASSUMED TOTAL UNIT WT = 110 PCF

ASSUMED DEPTH OF WATER TABLE = 6.0 FT




CONE PENETRATION TEST

PROJECT NAME : JMM/MOFFETT NAS
PROJECT NUMBER : 9110-07002

LOCATION : SUNNYVALE
DATE : 05-06-199

SOUNDING NUMBER: CPT-20

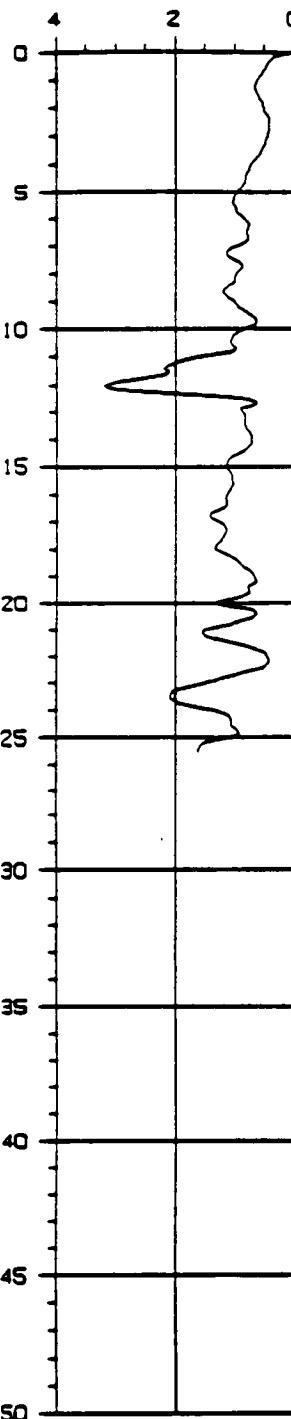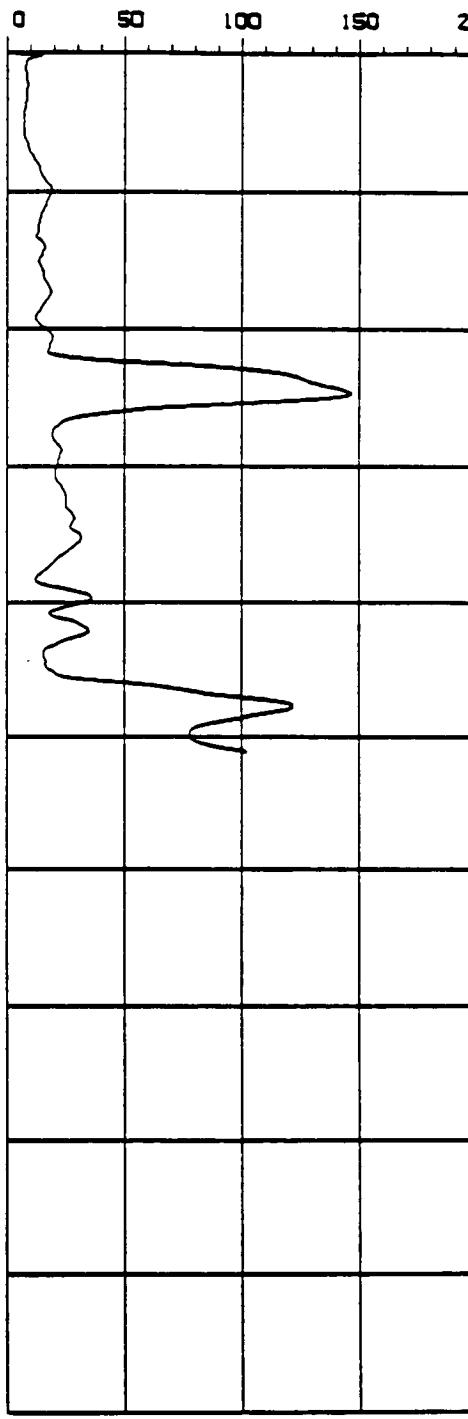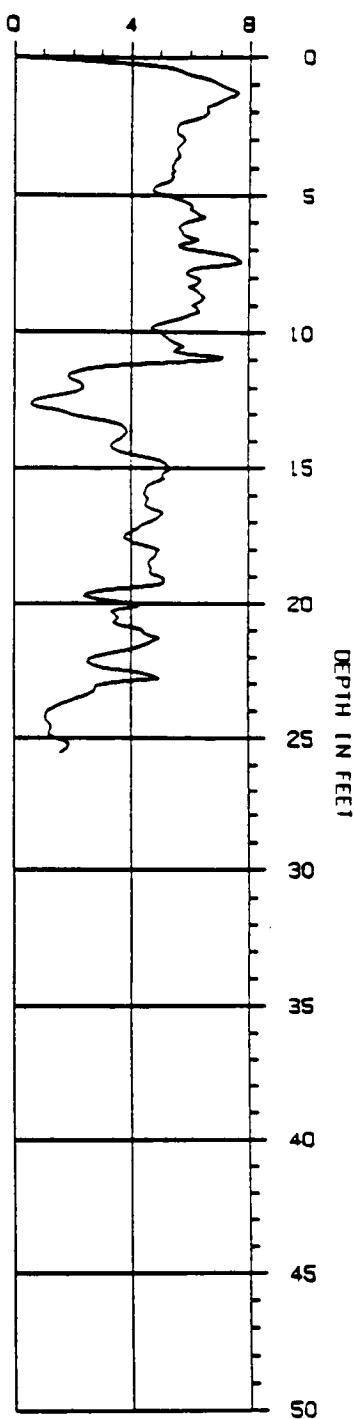

SLEEVE FRICTION (FS)
TONS/SQ FTTIP RESISTANCE (QT)
TONS/SQ FTFRICTION RATIO (FS/QT)
PERCENT

DEPTH IN FEET

DEPTH IN FEET

TIP RESISTANCE CORRECTED FOR END AREA EFFECT

CONE PENETRATION TEST

SOUNDING NUMBER: CPT-39




PROJECT NAME : JMM/MOFFETT NAS

LOCATION : SUNNYVALE

PROJECT NUMBER : 9110-07002

DATE : 05-04-1991

**THE EARTH TECHNOLOGY
CORPORATION**

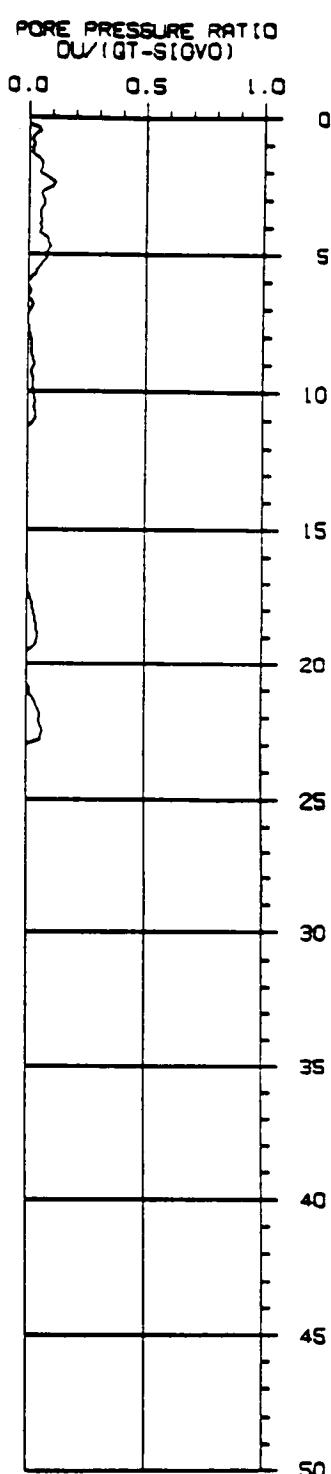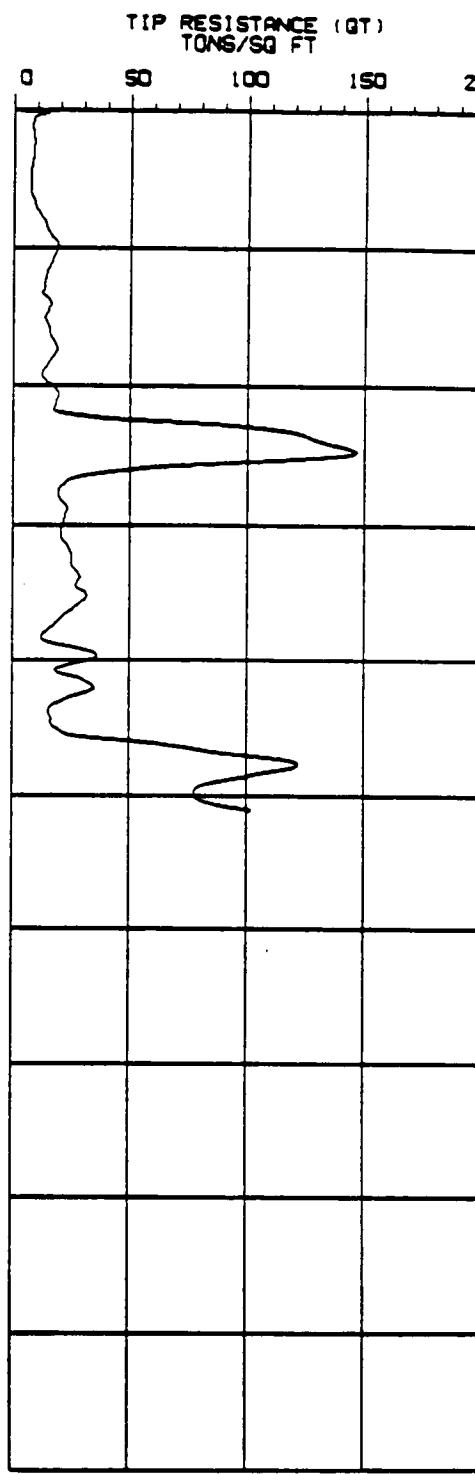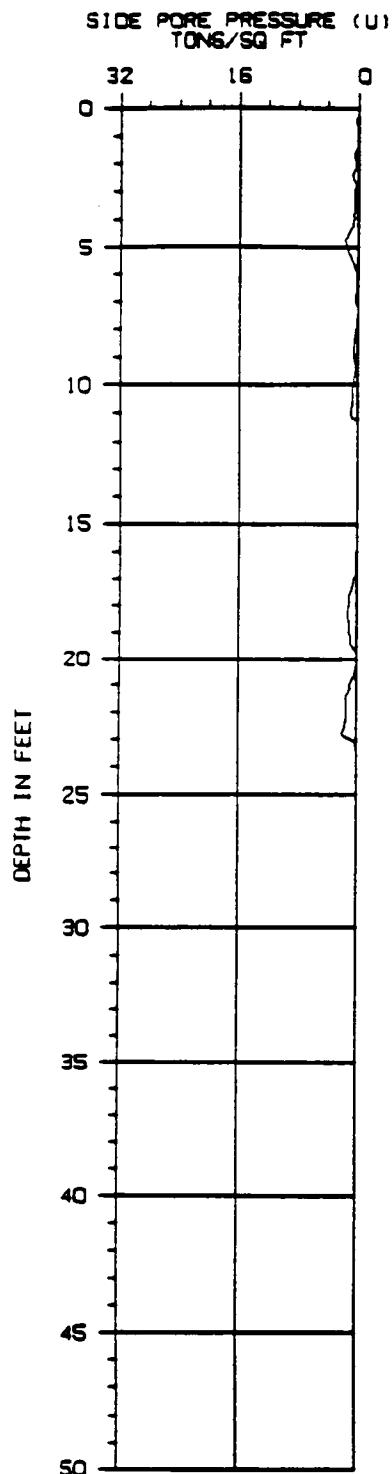

TIP RESISTANCE CORRECTED FOR END AREA EFFECT

ASSUMED TOTAL UNIT WT = 110 PCF

$DU = U - \text{HYDROSTATIC PWP}$

ASSUMED DEPTH OF WATER TABLE = 6.0 FT

SICVO = TOTAL VERTICAL STRESS


CONE PENETRATION TEST

SOUNDING NUMBER: CPT-39

PROJECT NAME : JMM/MOFFETT NAS
PROJECT NUMBER : 9110-07002

LOCATION : SUNNYVALE
DATE : 05-04-1991

 THE EARTH TECHNOLOGY
CORPORATION

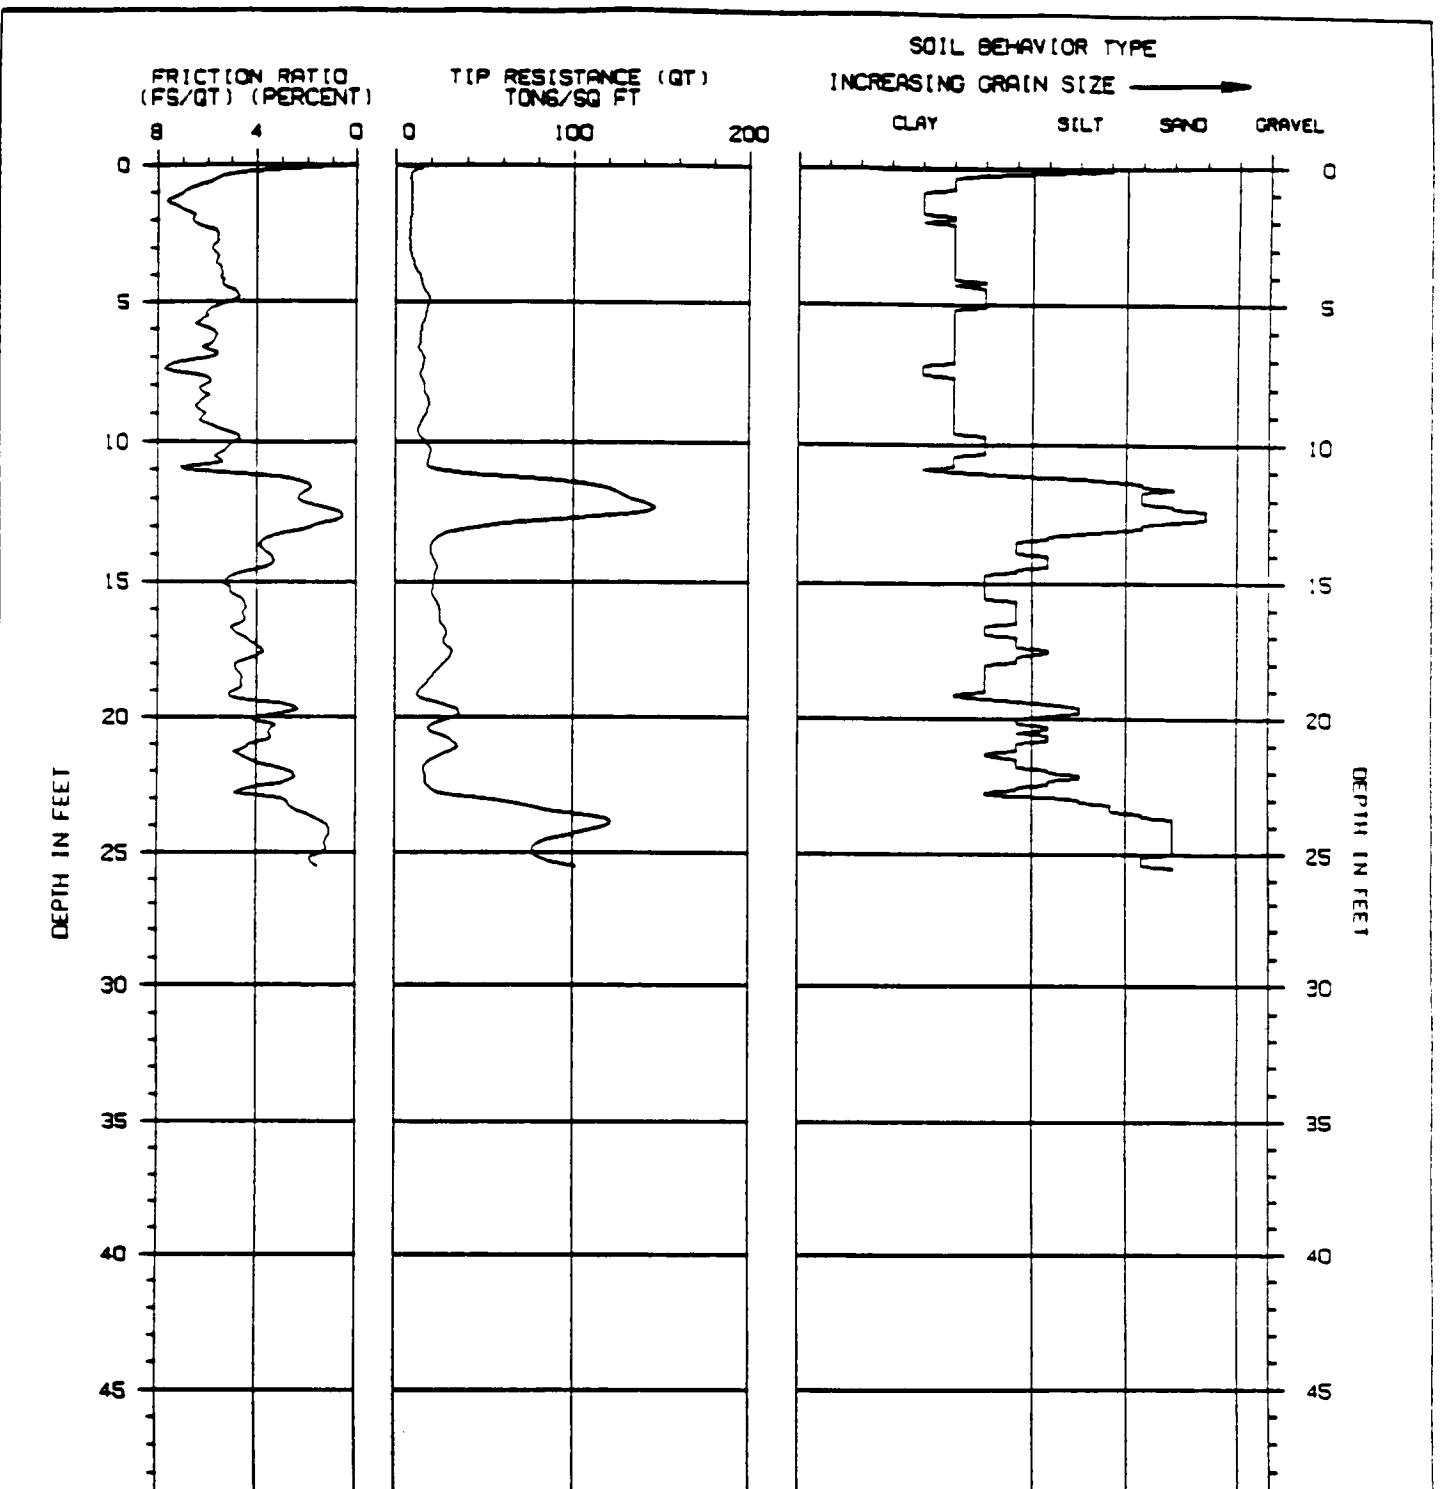

TIP RESISTANCE CORRECTED FOR END AREA EFFECT

ASSUMED TOTAL UNIT WT = 110 PCF

ASSUMED DEPTH OF WATER TABLE = 6.0 FT

CONE PENETRATION TEST


SOUNDING NUMBER: CPT-39

PROJECT NAME : JMM/MOFFETT NAS
PROJECT NUMBER : 9110-07002


LOCATION : SUNNYVALE
DATE : 05-04-1991

 THE EARTH TECHNOLOGY CORPORATION


SLEEVE FRICTION (FS)
TONS/SQ FT

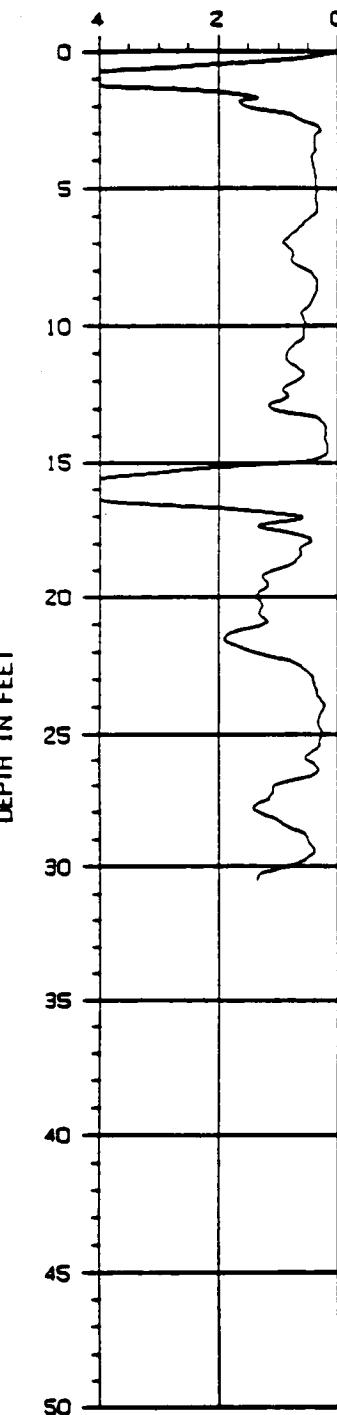

TIP RESISTANCE (QT)
TONS/SQ FT

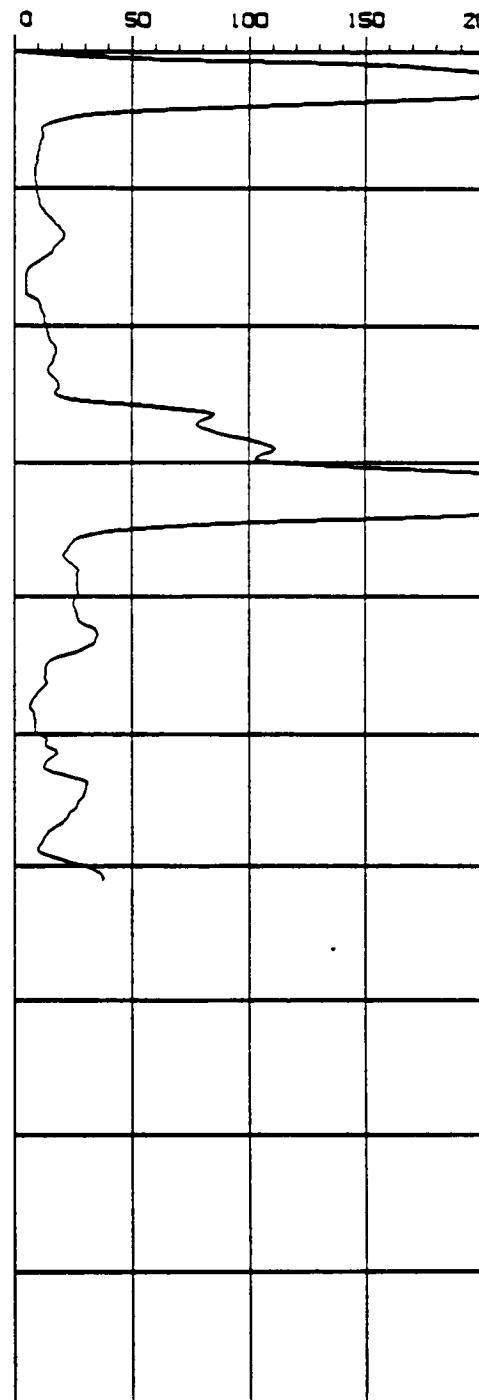

FRICTION RATIO (FS/QT)
PERCENT

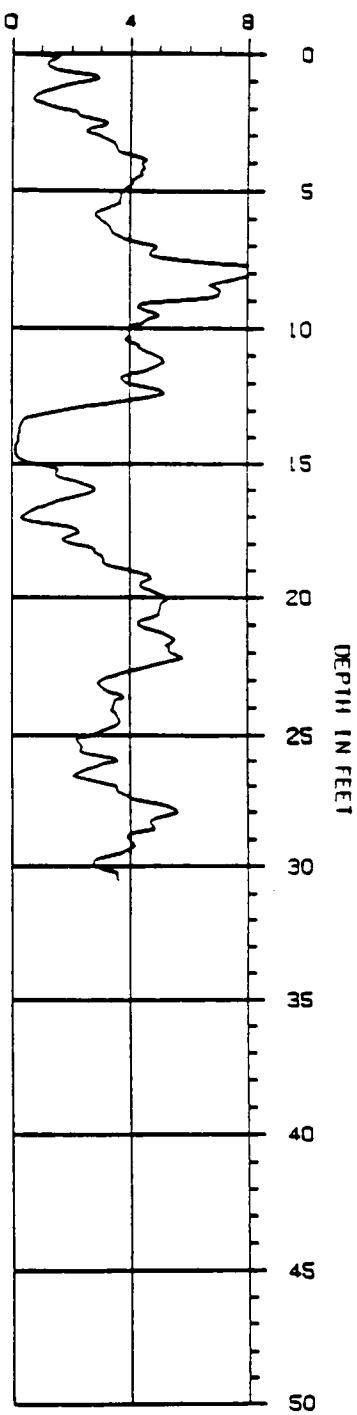

TIP RESISTANCE CORRECTED FOR END AREA EFFECT

CONE PENETRATION TEST


SOUNDING NUMBER: CPT-46

PROJECT NAME : JMM/MOFFETT NAS
PROJECT NUMBER : 9110-07002


LOCATION : SUNNYVALE
DATE : 05-04-1991

THE EARTH TECHNOLOGY
CORPORATION


SIDE PORE PRESSURE (U)
TONS/SQ FT

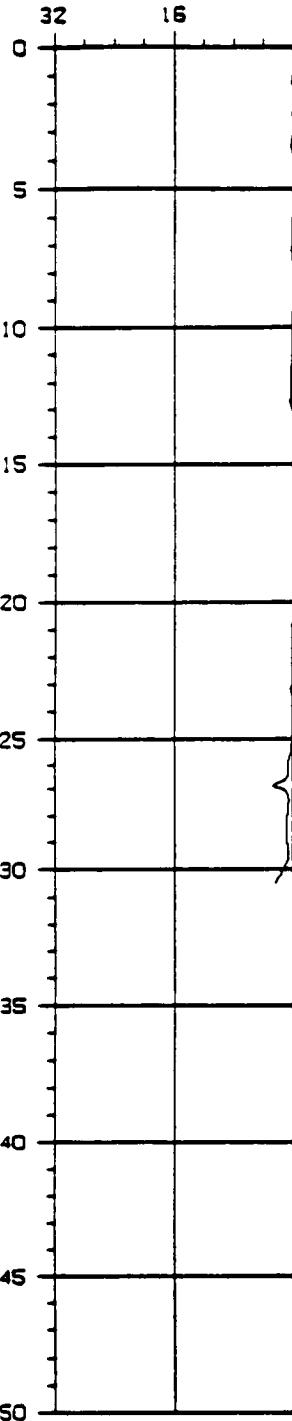

TIP RESISTANCE (QT)
TONS/SQ FT

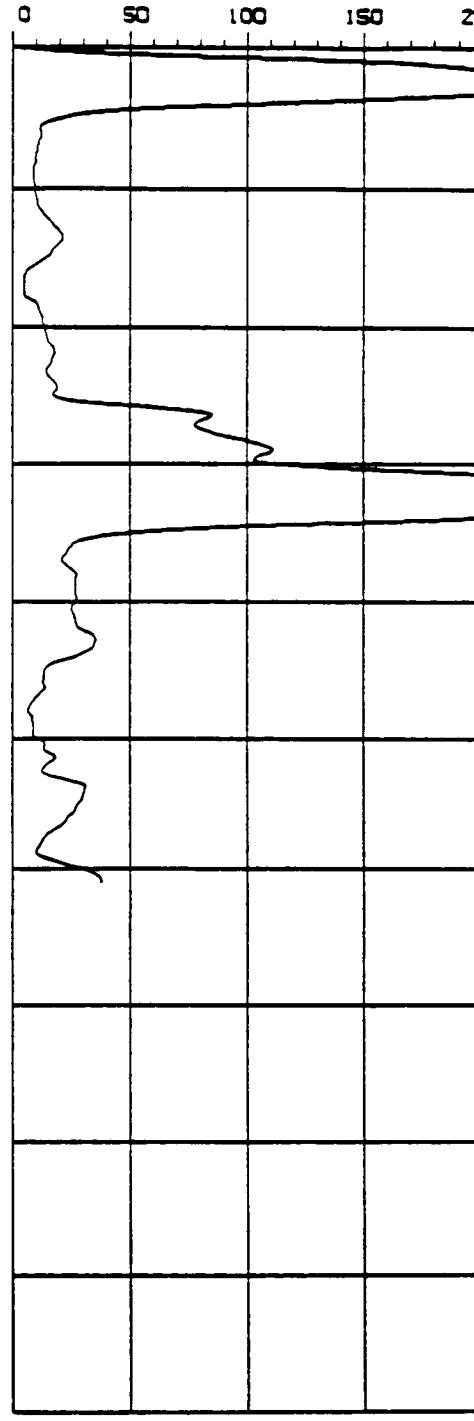

PORE PRESSURE RATIO
QU/QT-SIGVO

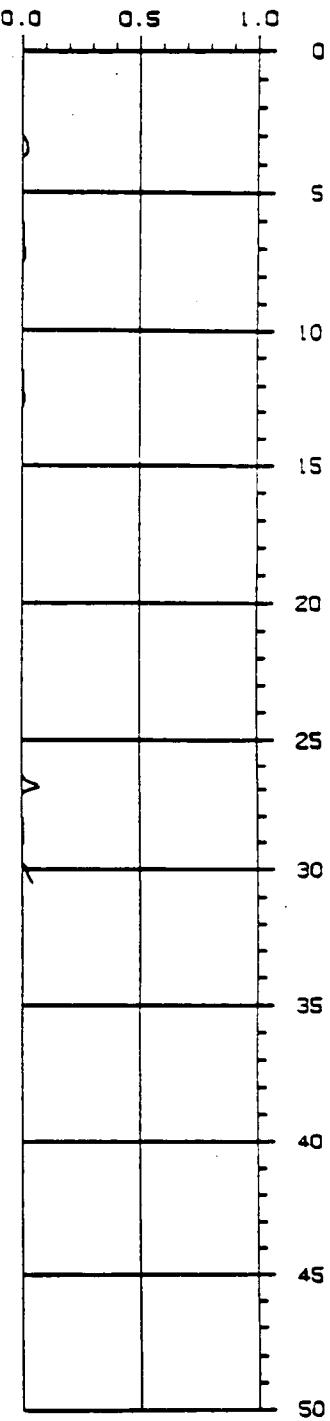

DEPTH IN FEET

DEPTH IN FEET

TIP RESISTANCE CORRECTED FOR END AREA EFFECT

ASSUMED TOTAL UNIT WT = 110 PCF

QU = U - HYDROSTATIC PWP

ASSUMED DEPTH OF WATER TABLE = 6.0 FT

SIGVO = TOTAL VERTICAL STRESS

CONE PENETRATION TEST


SOUNDING NUMBER: CPT-46

PROJECT NAME : JMM/MOFFETT NAS
PROJECT NUMBER : 9110-07002


LOCATION : SUNNYVALE
DATE : 05-04-1991

 THE EARTH TECHNOLOGY
CORPORATION


FRICITION RATIO
(FS/GT) (PERCENT)

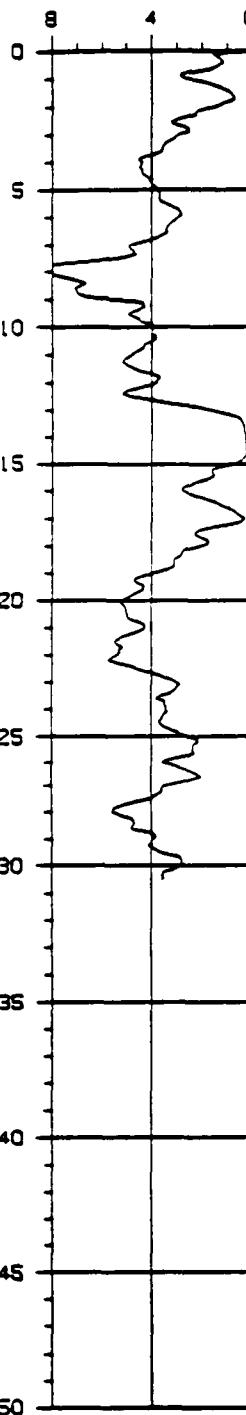

TIP RESISTANCE (QT)
TONS/SQ FT

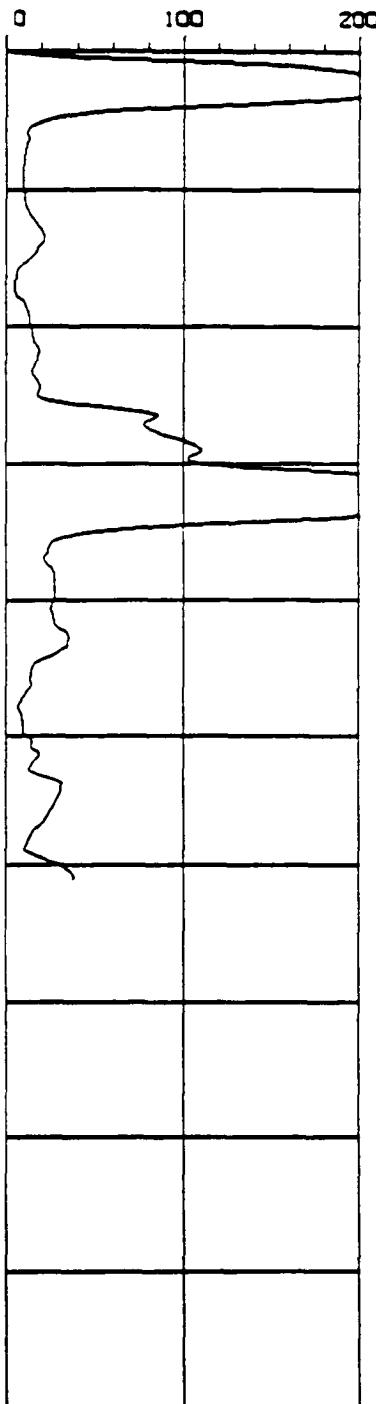

SOIL BEHAVIOR TYPE
INCREASING GRAIN SIZE →

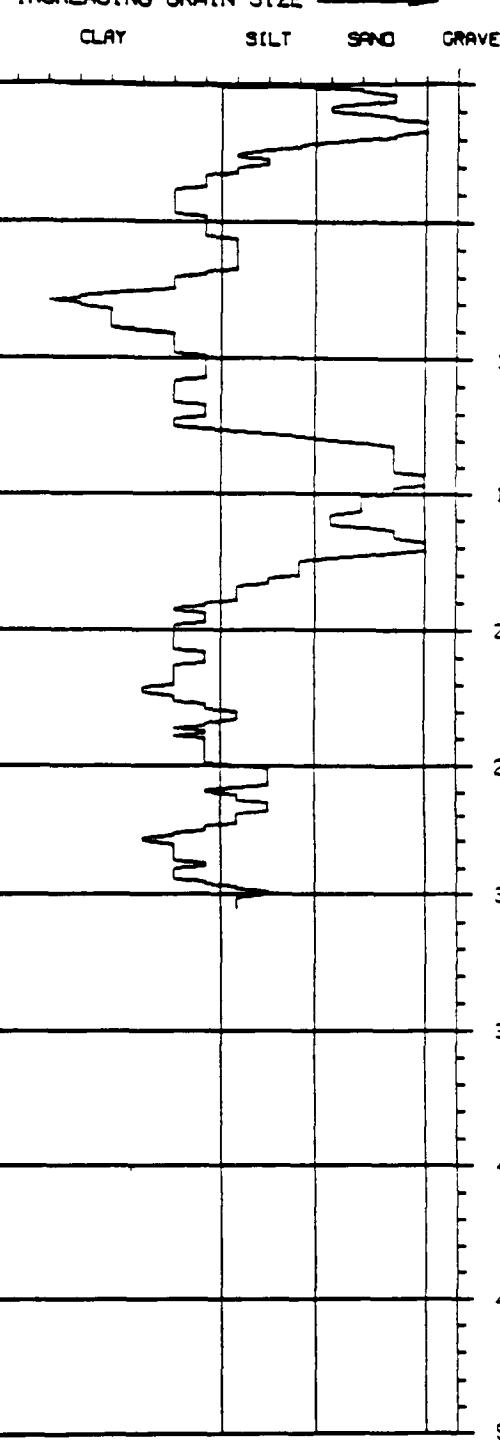

DEPTH IN FEET

DEPTH IN FEET

TIP RESISTANCE CORRECTED FOR END AREA EFFECT

ASSUMED TOTAL UNIT WT = 110 PCF

ASSUMED DEPTH OF WATER TABLE = 6.0 FT




CONE PENETRATION TEST

SOUNDING NUMBER: CPT-46

PROJECT NAME : JMM/MOFFETT NAS
PROJECT NUMBER : 9110-07002

LOCATION : SUNNYVALE
DATE : 05-04-1991

 THE EARTH TECHNOLOGY
CORPORATION

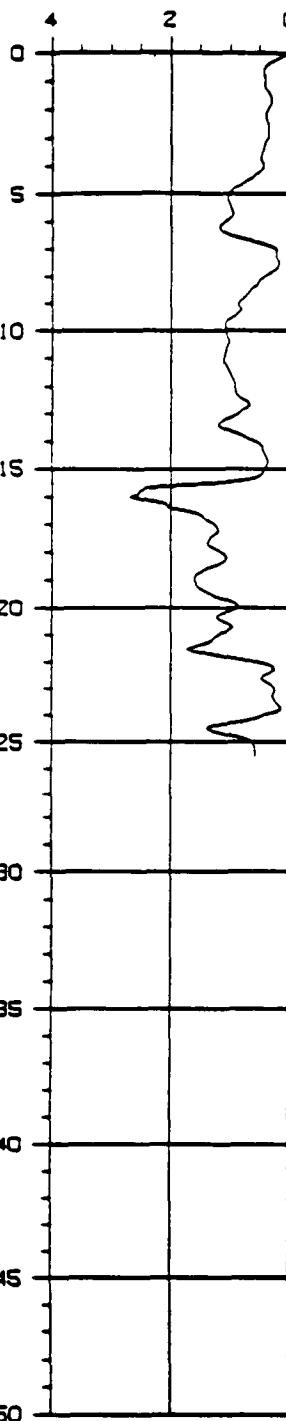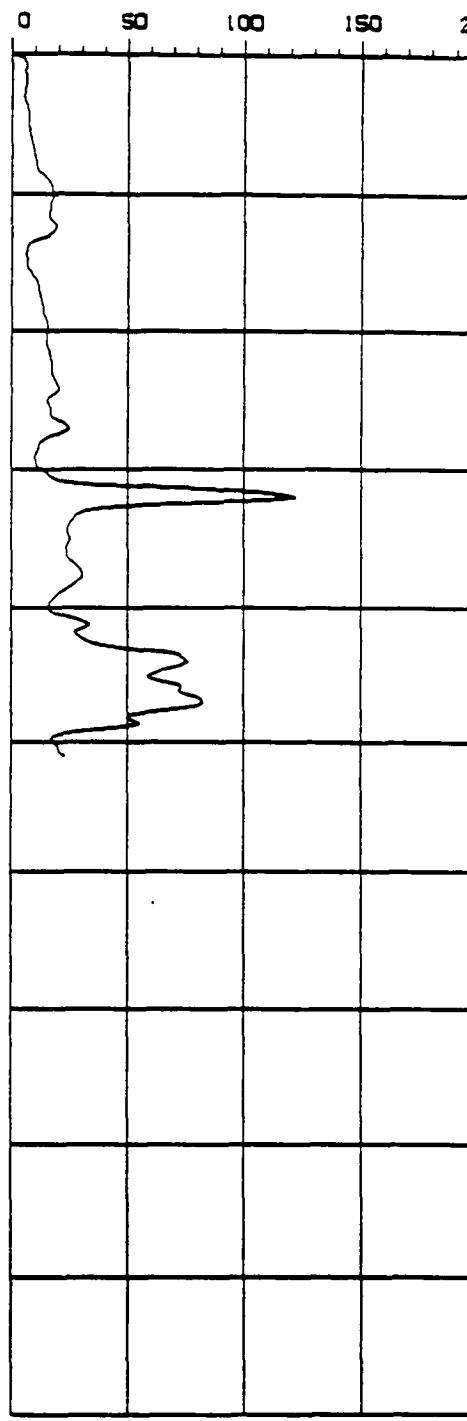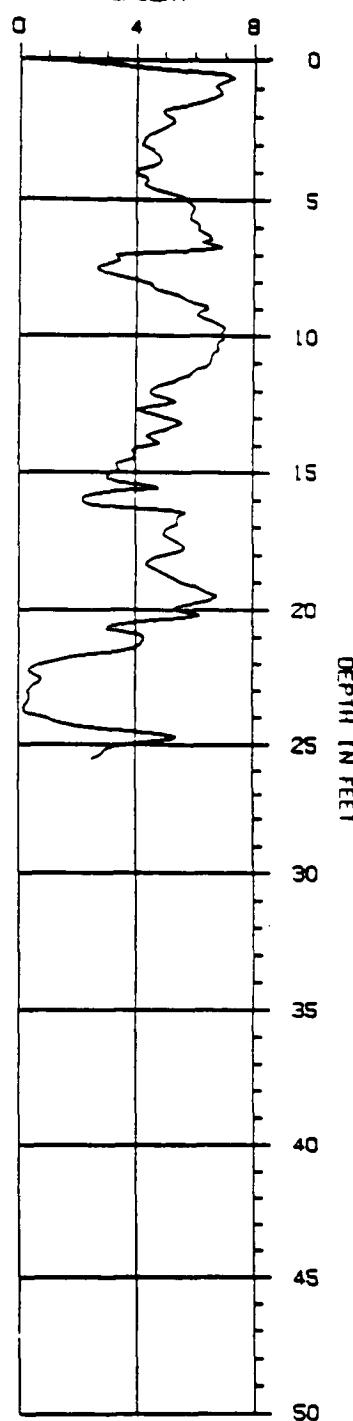
SLEEVE FRICTION (FS)
TONS/SQ FTTIP RESISTANCE (QC)
TONS/SQ FTFRICTION RATIO (FS/QC)
PERCENT

CONE PENETRATION TEST


SOUNDING NUMBER: CPT-60

PROJECT NAME : JMM/MOFFETT NAS
PROJECT NUMBER : 9110-07002LOCATION : SUNNYVALE
DATE : 05-08-1991 THE EARTH TECHNOLOGY
CORPORATION


CONE PORE PRESSURE (U)
TONS/SQ FT

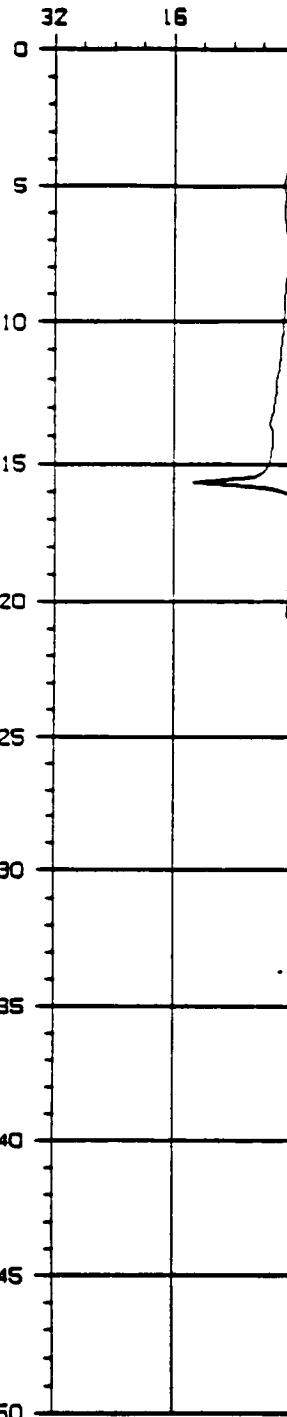

TIP RESISTANCE (qc)
TONS/SQ FT

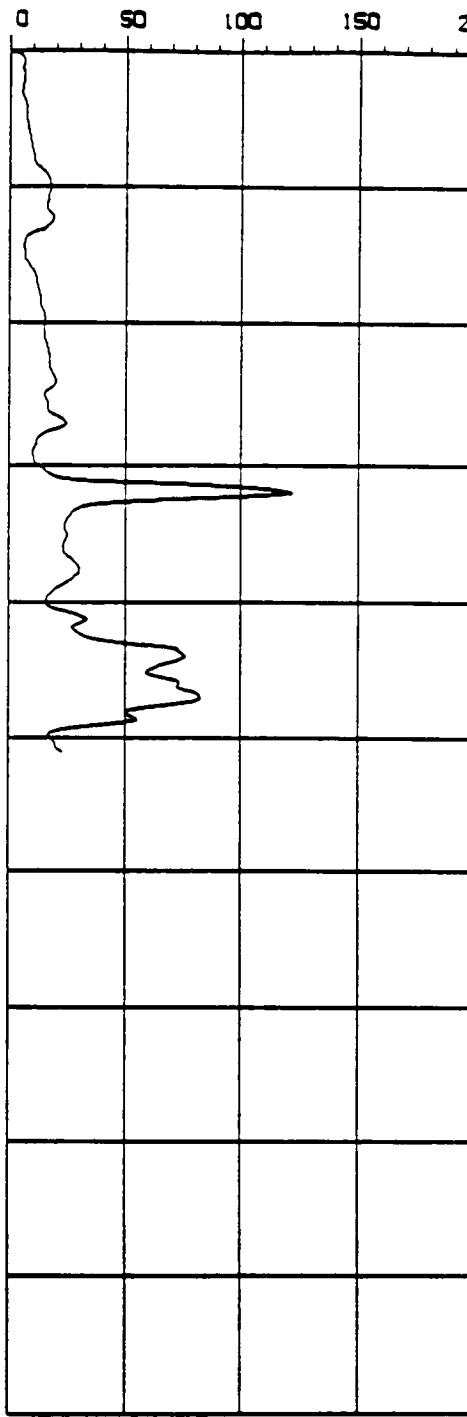

PORE PRESSURE RATIO
 U/qc

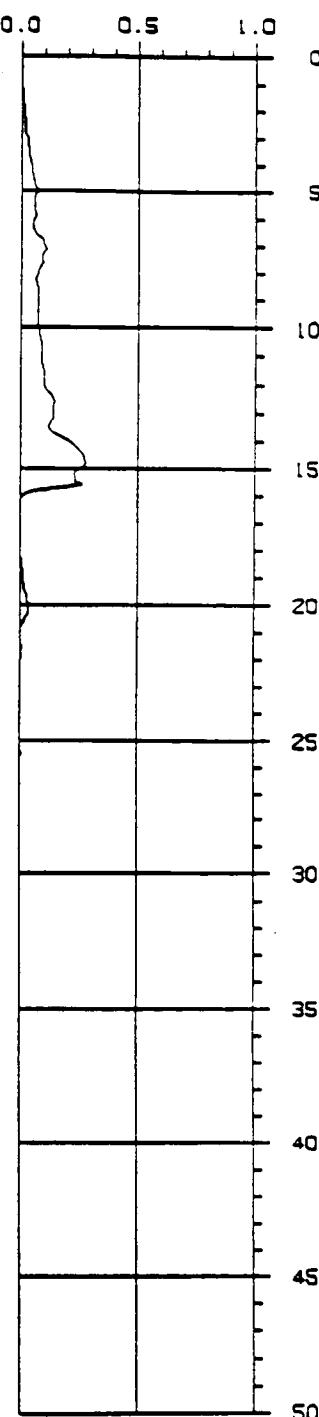


CONE PENETRATION TEST

SOUNDING NUMBER: CPT-60

PROJECT NAME : JMM/MOFFETT NAS
PROJECT NUMBER : 9110-07002

LOCATION : SUNNYVALE
DATE : 05-08-1991

 THE EARTH TECHNOLOGY
CORPORATION

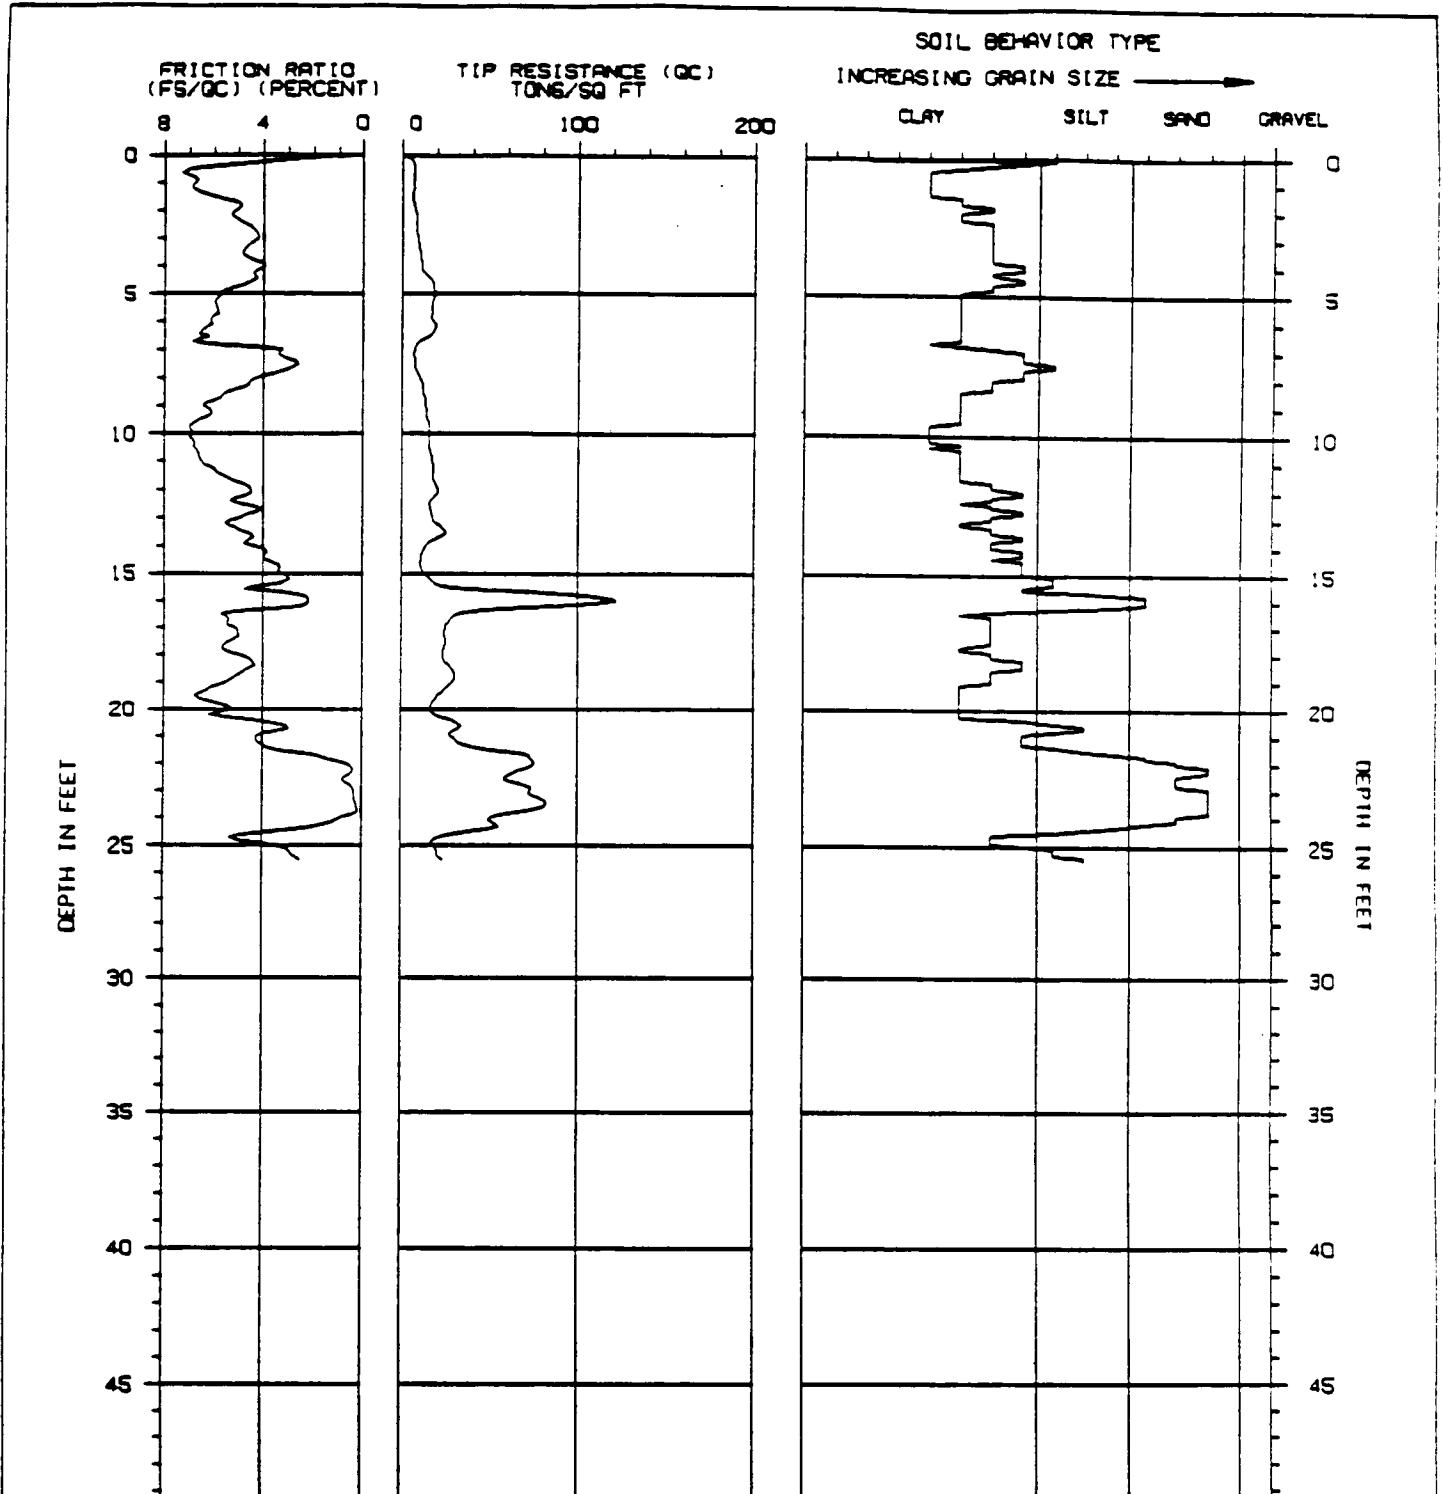

ASSUMED TOTAL UNIT WT = 110 PCF

ASSUMED DEPTH OF WATER TABLE = 6.0 FT

CONE PENETRATION TEST

SOUNDING NUMBER: CPT-60

PROJECT NAME : JMM/MOFFETT NAS
PROJECT NUMBER : 9110-07002

LOCATION : SUNNYVALE
DATE : 05-08-1991

 THE EARTH TECHNOLOGY
CORPORATION


N00296.001452
MOFFETT FIELD
SSIC NO. 5090.3

**APPENDIX C – BORING LOGS
GEOPHYSICAL LOGS**

SITE 9 – WELLS (IT)

**REMEDIAL INVESTIGATION REPORT
OPERABLE UNIT 4: WEST SIDE AQUIFERS**

DATED 01 AUGUST 1992

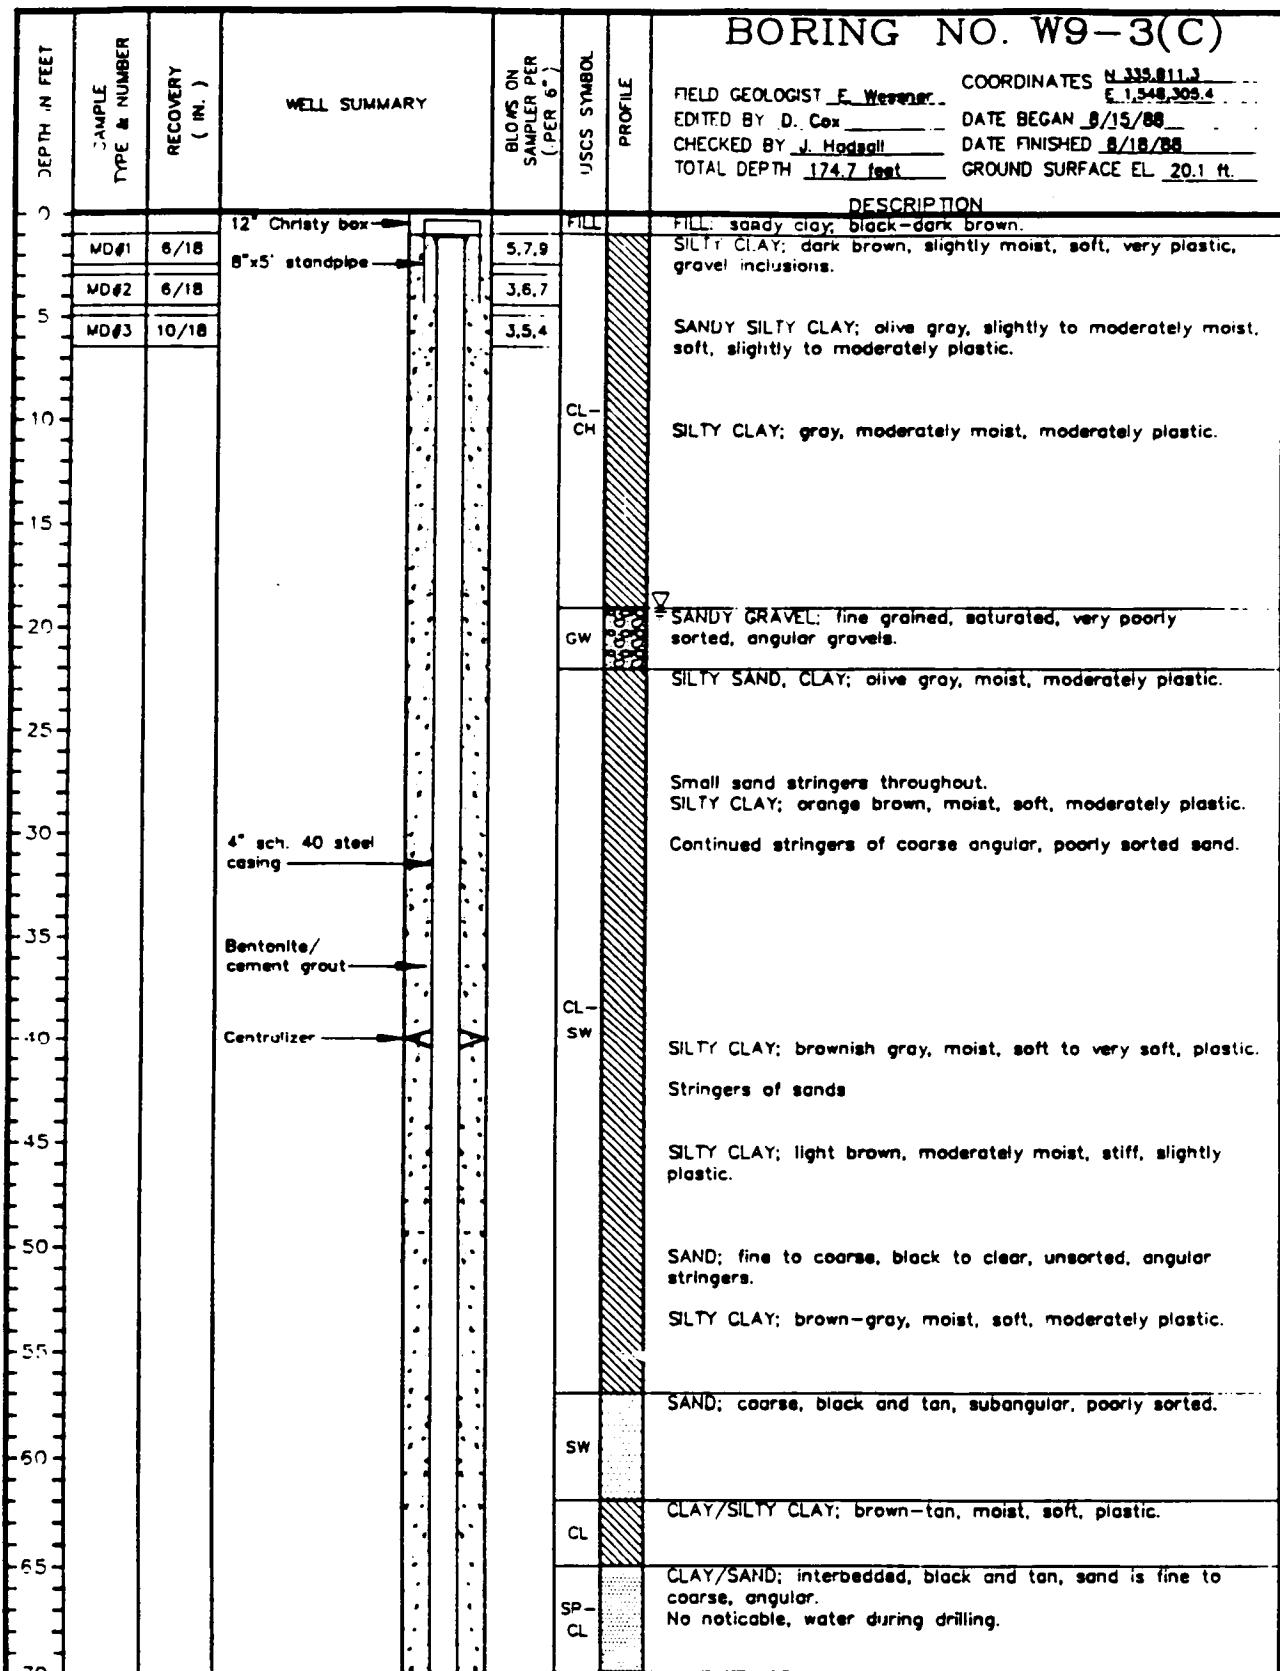

DRILLING CO.: Water Development Co.
DRILLING METHOD: Air Rotary

SAMPLING METHODS: MD=California Modified
S=Split Barrel

PROJECT NO.: 409616


CLIENT: Moffett Naval Air Station
Moffett Field, California

PAGE 1 OF 3



...Creating a Safer Tomorrow

SEE LEGEND FOR LOGS AND TEST PITS
FOR EXPLANATION OF SYMBOLS AND TERMS

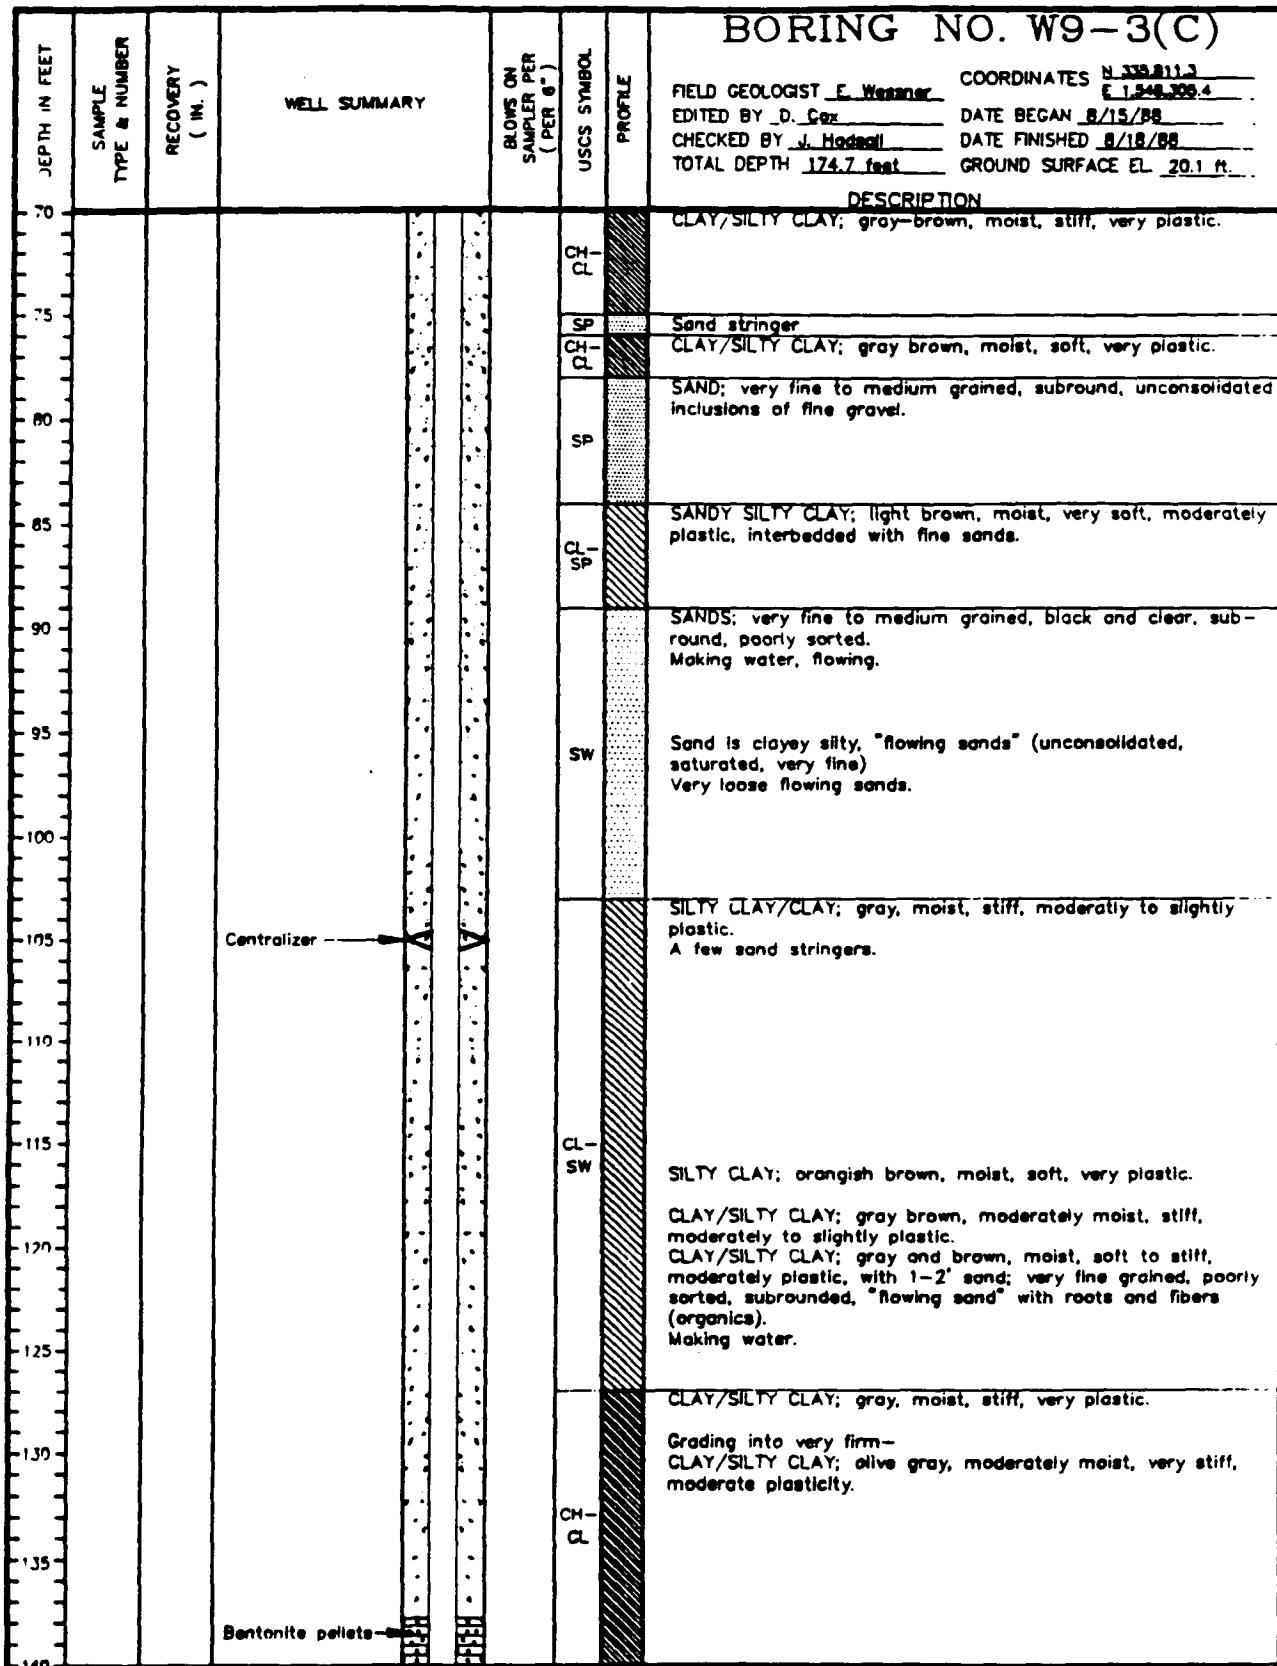

DRILLING CO.: Water Development Co.
DRILLING METHOD: Air Rotary

PAGE 2 OF 3


SAMPLING METHODS: MD=California Modified
S=Split Barrel



...Creating a Safer Tomorrow

PROJECT NO.: 409616
CLIENT: Moffett Naval Air Station
Moffett Field, California

SEE LEGEND FOR LOGS AND TEST PITS
FOR EXPLANATION OF SYMBOLS AND TERMS

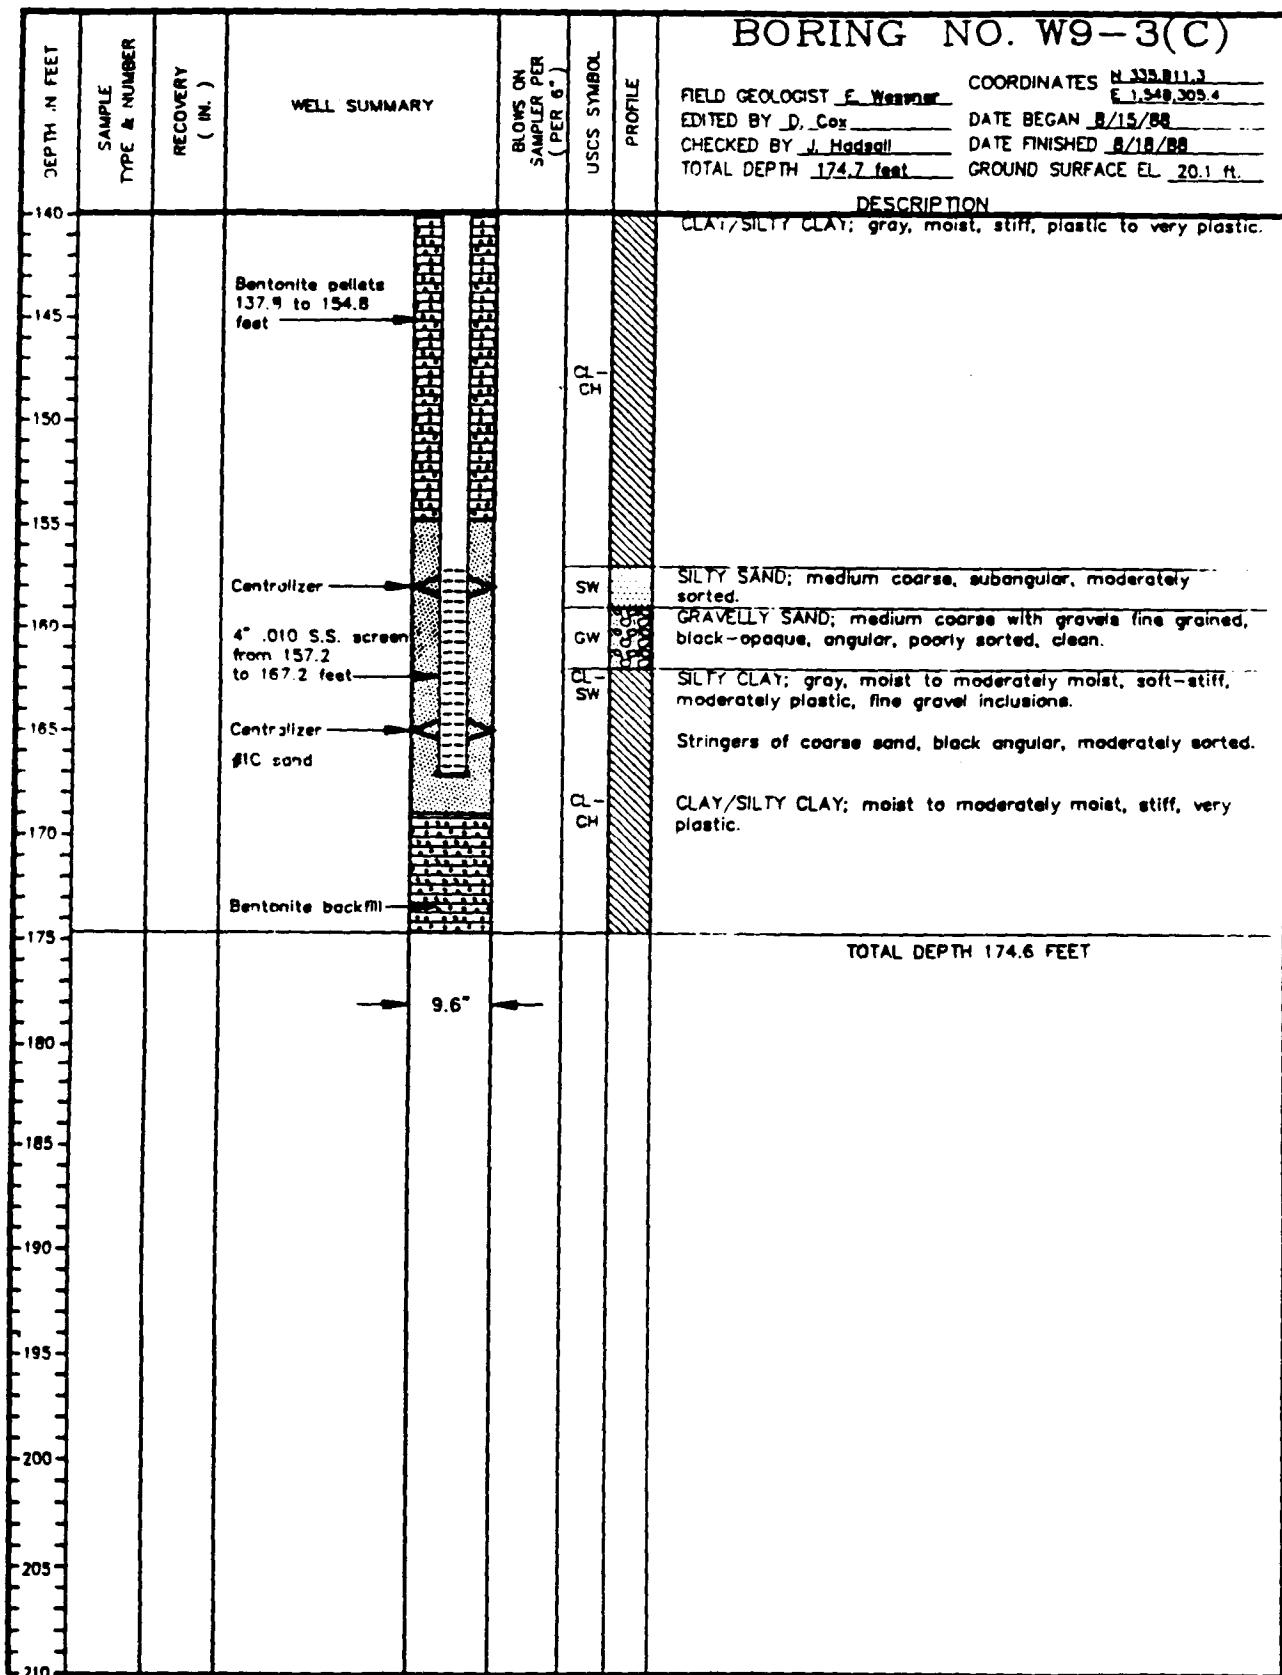

DRILLING CO.: Water Development Co.
DRILLING METHOD: Air Rotary

SAMPLING METHODS: MD=California Modified
S=Split Barrel

PROJECT NO.: 409616

CLIENT: Moffett Naval Air Station
Moffett Field, California


AutoCAD FILE: MF-W9-3C.DWG

PAGE 3 OF 3



...Creating a Safer Tomorrow

SEE LEGEND FOR LOGS AND TEST PITS
FOR EXPLANATION OF SYMBOLS AND TERMS

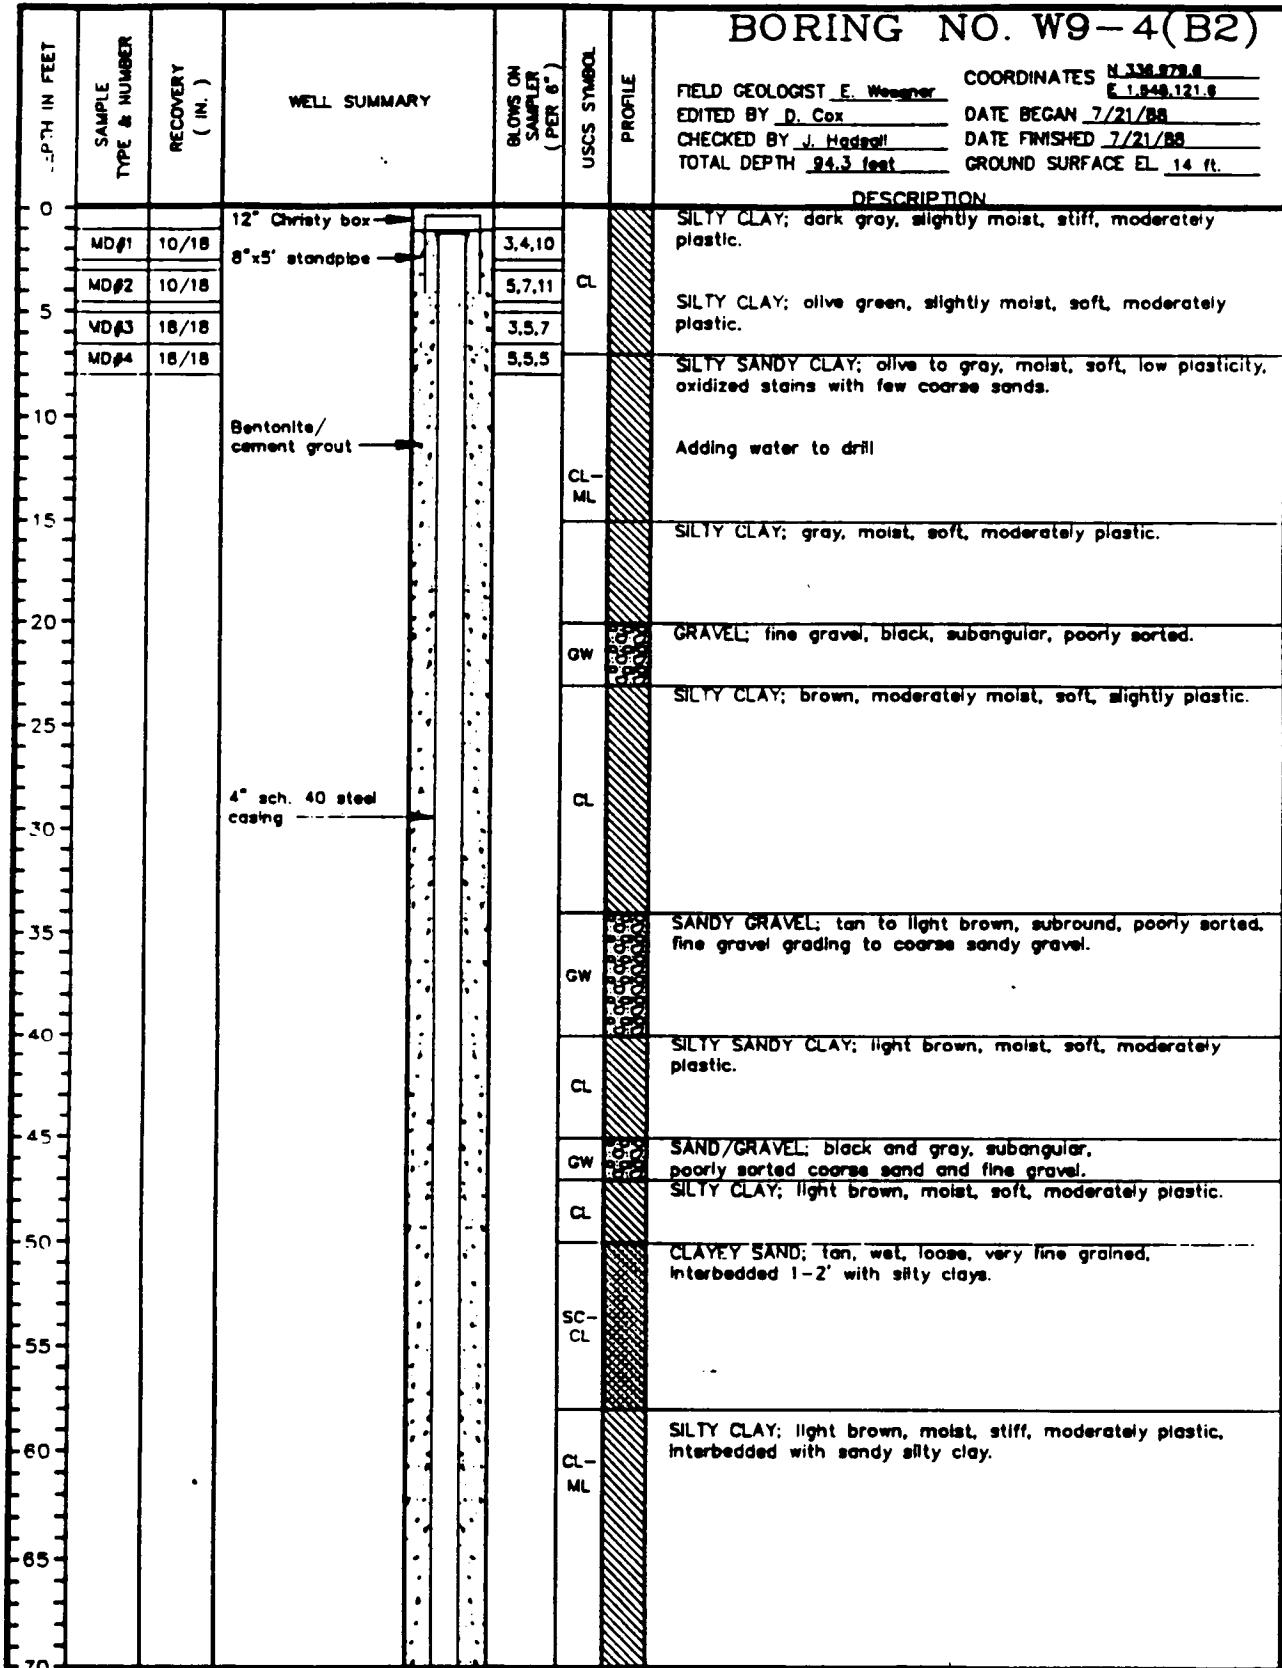

DRILLING CO.: Water Development Co.
DRILLING METHOD: Air Rotary

SAMPLING METHODS: MD=California Modified
S=Split Barrel

PROJECT NO.: 409616

CLIENT: Moffett Naval Air Station
Moffett Field, California


AutoCAD FILE: MFW9-482.DWG

PAGE 1 OF 2



...Creating a Safer Tomorrow

EE LEGEND FOR LOGS AND TEST PITS
FOR EXPLANATION OF SYMBOLS AND TERMS

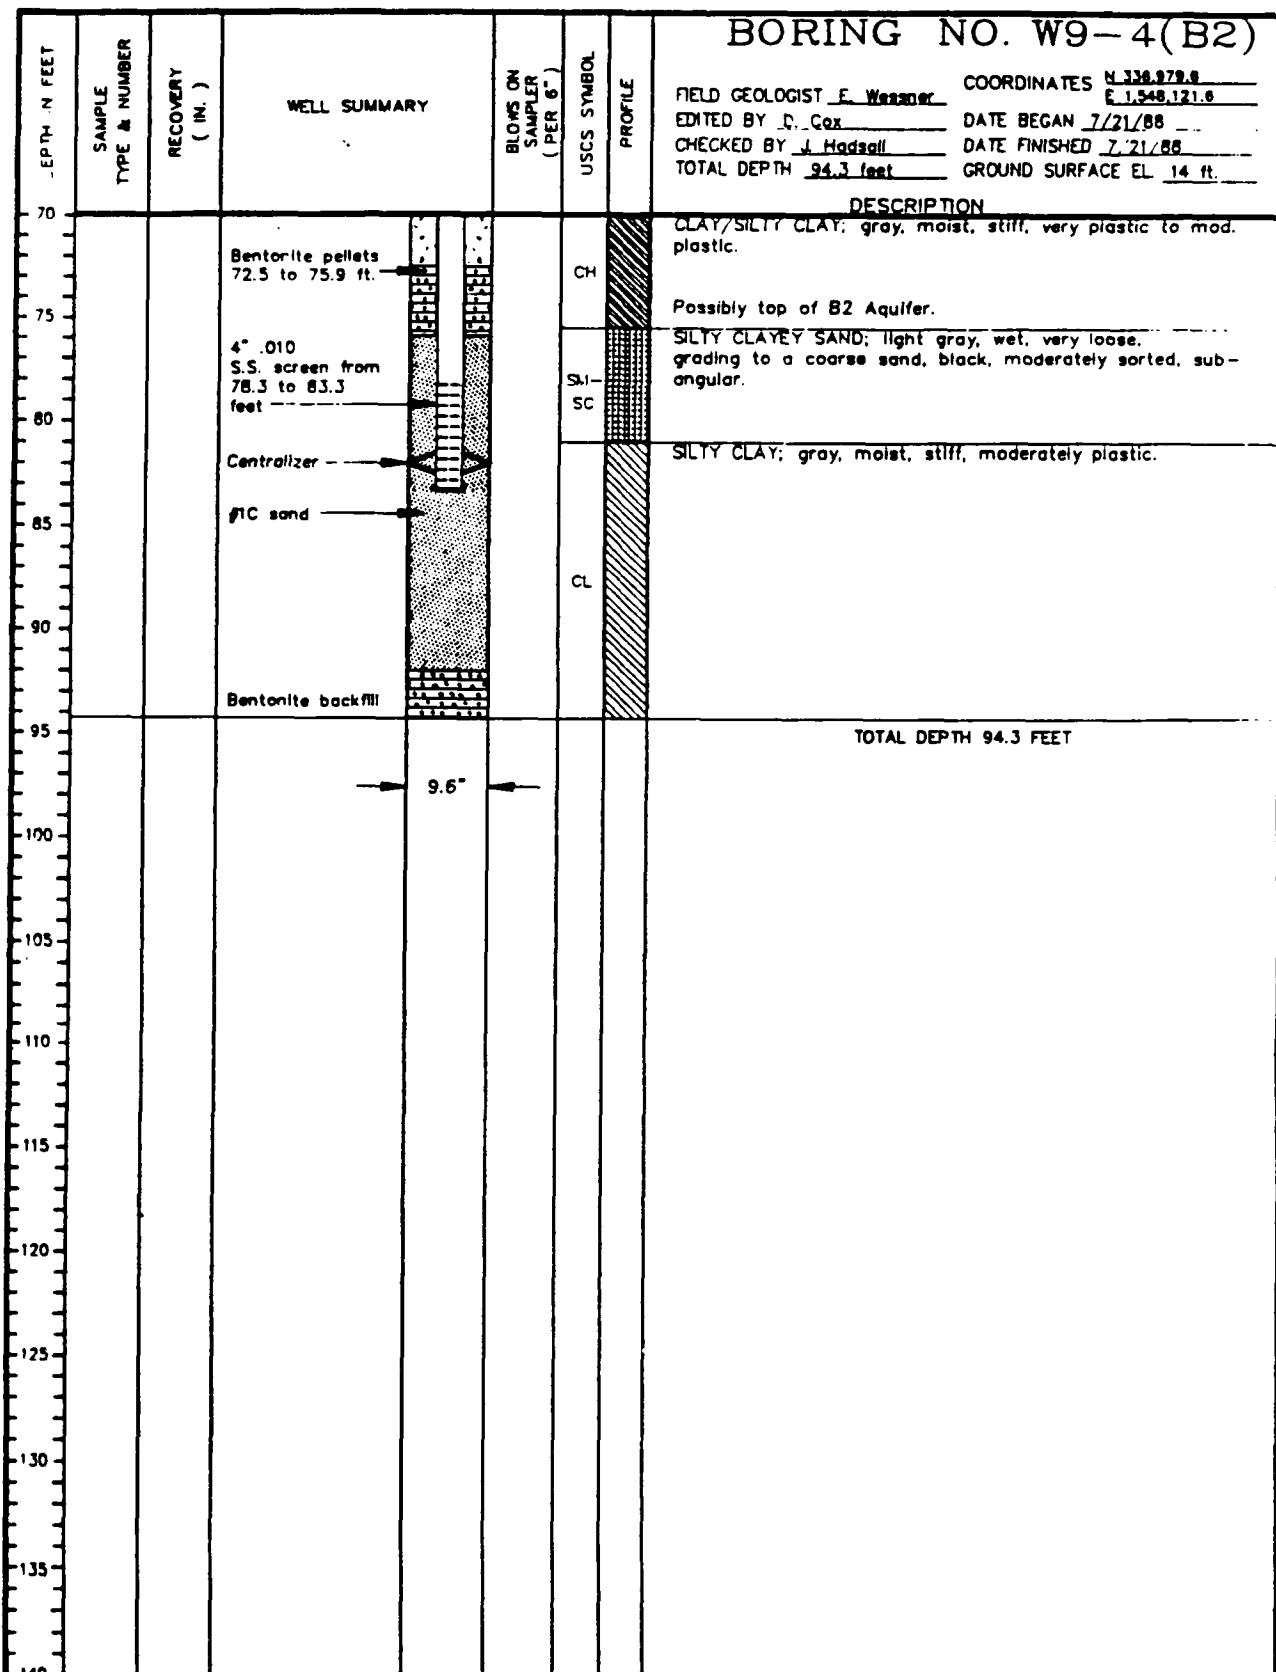

DRILLING CO.: Water Development Co.
DRILLING METHOD: Air Rotary

SAMPLING METHODS: MD=California Modified
S=Split Barrel

PROJECT NO.: 409616
CLIENT: Moffett Naval Air Station
Moffett Field, California

PAGE 2 OF 2



...Creating a Safer Tomorrow

SEE LEGEND FOR LOGS AND TEST PITS
FOR EXPLANATION OF SYMBOLS AND TERMS

DEPTH IN FEET	SAMPLE TYPE & NUMBER	RECOVERY (IN.)	WELL SUMMARY	BLOWS OF SAMPLER PER (PER 6")	USES SYMBOL	PROFILE	BORING NO. W9-5B3		COORDINATES N 33° 09.2 E 124° 11.8
							FIELD GEOLOGIST E. Wagner	EDITED BY D. Cox	DATE BEGAN 7/26/88
0							DESCRIPTION		
0	MD#1	10/18	12" Christy box 8"x5' standpipe	2.5.8	CH		CLAY-SILTY CLAY; dark gray, slightly moist, soft, very plastic.		
5	MD#2	10/18		7.14.13	CL		SILTY CLAY; light gray, slightly moist, stiff, mod. plastic.		
5	MD#3	18/18	Bentonite cement grout	4.5.7			CLAYEY SILT; olive gray, moist, very soft, mod. plastic. Moisture increase.		
5	MD#4	12/18		7.5.2	ML		SILTY CLAY; brown-gray, moderately moist, very soft, plastic, mottled light gray brown.		
10			4" sch. 40 steel casing						
15					CL-CH		Made connection at 20' and had water blow out after connection.		
20					GW-GC		SILTY GRAVELS; wet, black, fine grained, angular, moderately sorted.		
25					CL-CH		SILTY CLAY; brown-gray, moist, soft, plastic.		
30					MM		CLAYEY SILT; brown, moist, soft, plastic.		
35					GW		FINE GRAVEL; brown, subangular, moderately to poorly sorted.		
40					CH		SILTY CLAY; brown, moist, soft, plastic.		
40					GW-GC		FINE GRAVEL; brown to black, angular, poorly sorted.		
45					CH		GRAVELLY SILTY CLAY; brown, moist, soft, plastic, inclusions of gravel.		
45					GW		FINE GRAVEL; wet, angular, poorly sorted.		
50					CH		SILTY CLAY; brown, moist, soft, plastic, mottled with slightly platy structure.		
50					GW		FINE GRAVEL; poorly sorted, angular.		
55							CLAYEY SILT; interbedded, brown, moist, soft, moderately plastic, interbedded with small fine gravel.		
55							Water producing		
60					ML				
65					CL-CH		SILTY CLAY; brown, soft, moist, very plastic, interbedded with a gray silty clay.		
70									

DRILLING CO.: Water Development Co.
 DRILLING METHOD: Air Rotary

PAGE 1 OF 2


SAMPLING METHODS: MD=California Modified
 S=Split Barrel



...Creating a Safer Tomorrow

PROJECT NO.: 409616
 CLIENT: Moffett Naval Air Station
 Moffett Field, California

SEE LEGEND FOR LOGS AND TEST PITS
 FOR EXPLANATION OF SYMBOLS AND TERMS

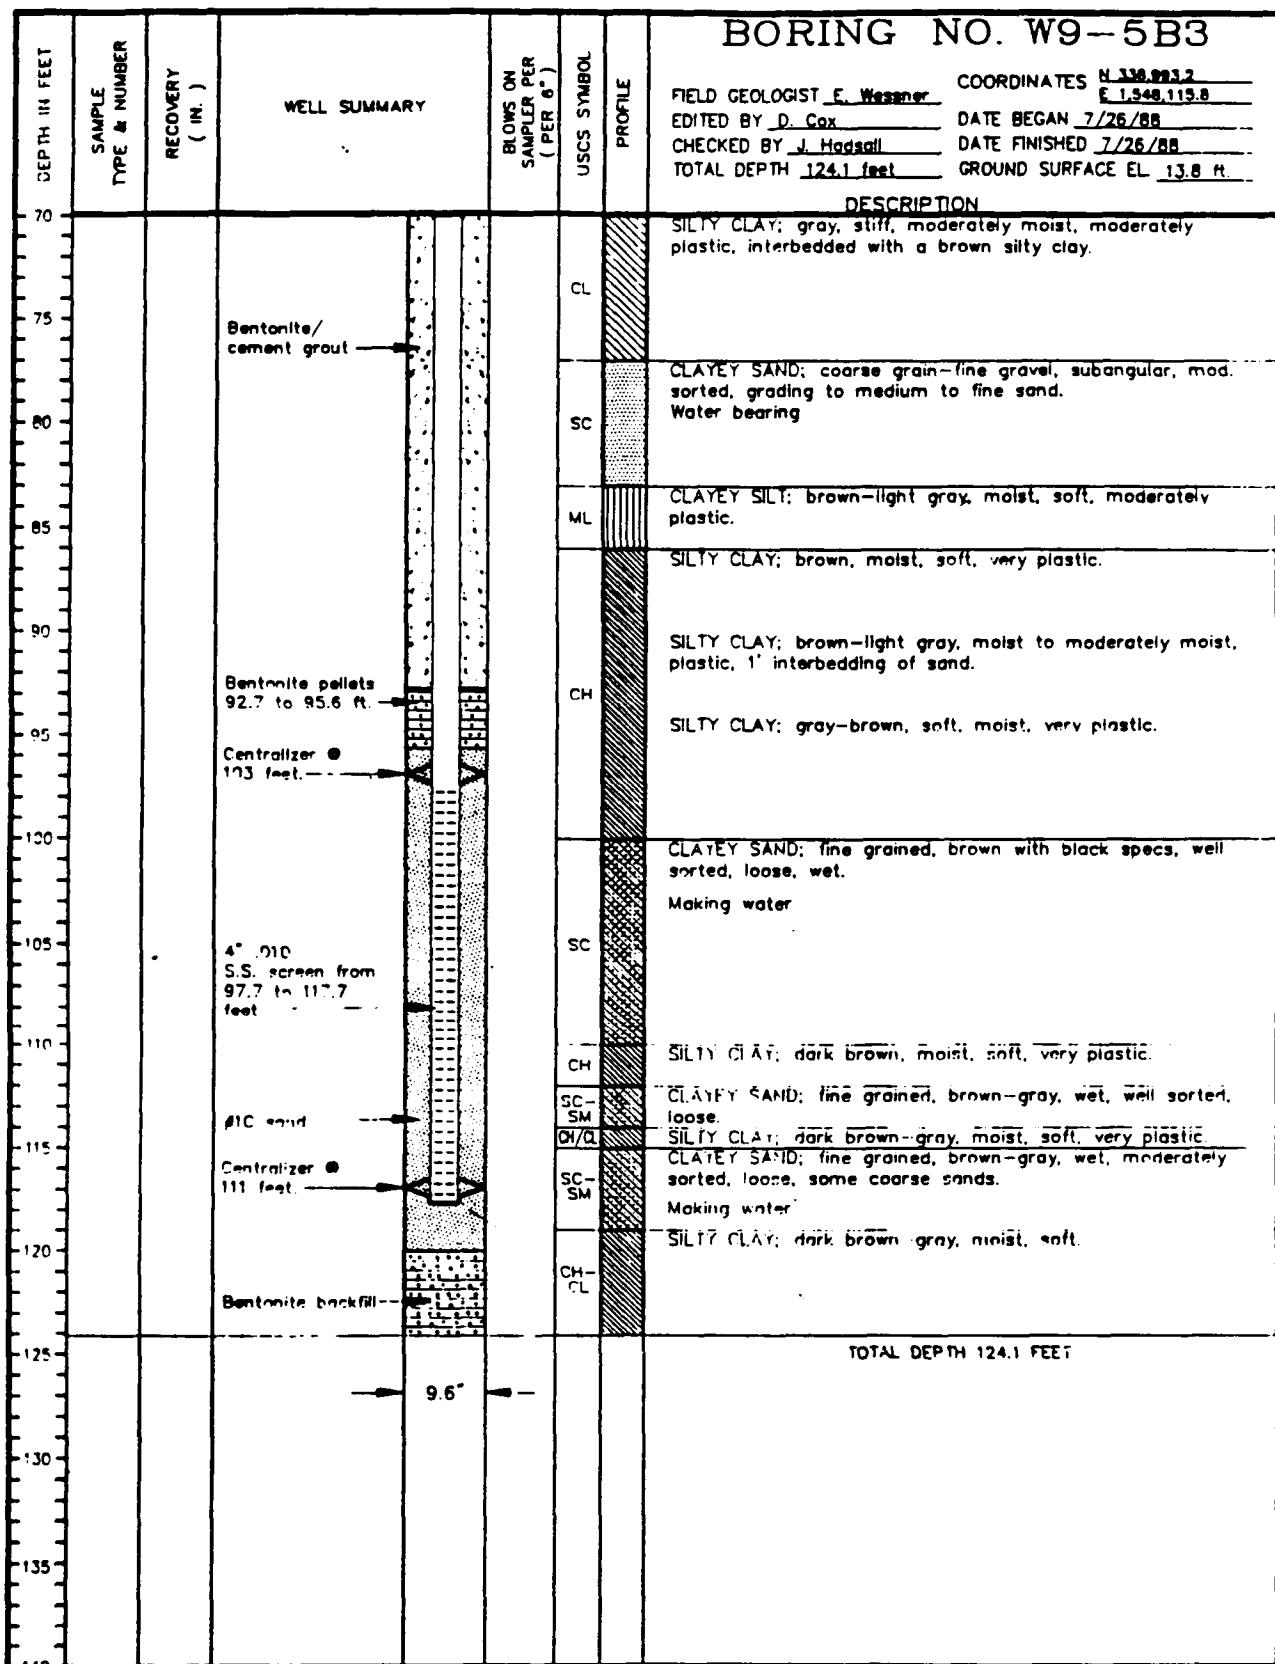

DRILLING CO.: Water Development Co.
DRILLING METHOD: Air Rotary

SAMPLING METHODS: MD=California Modified
S=Split Barrel

PROJECT NO.: 409616
CLIENT: Moffett Naval Air Station
Moffett Field, California


AutoCAD FILE: MFW9-5B3.DWG

PAGE 2 OF ?



...Creating a Safer Tomorrow

SEE LEGEND FOR LOGS AND TEST PITS
FOR EXPLANATION OF SYMBOLS AND TERMS

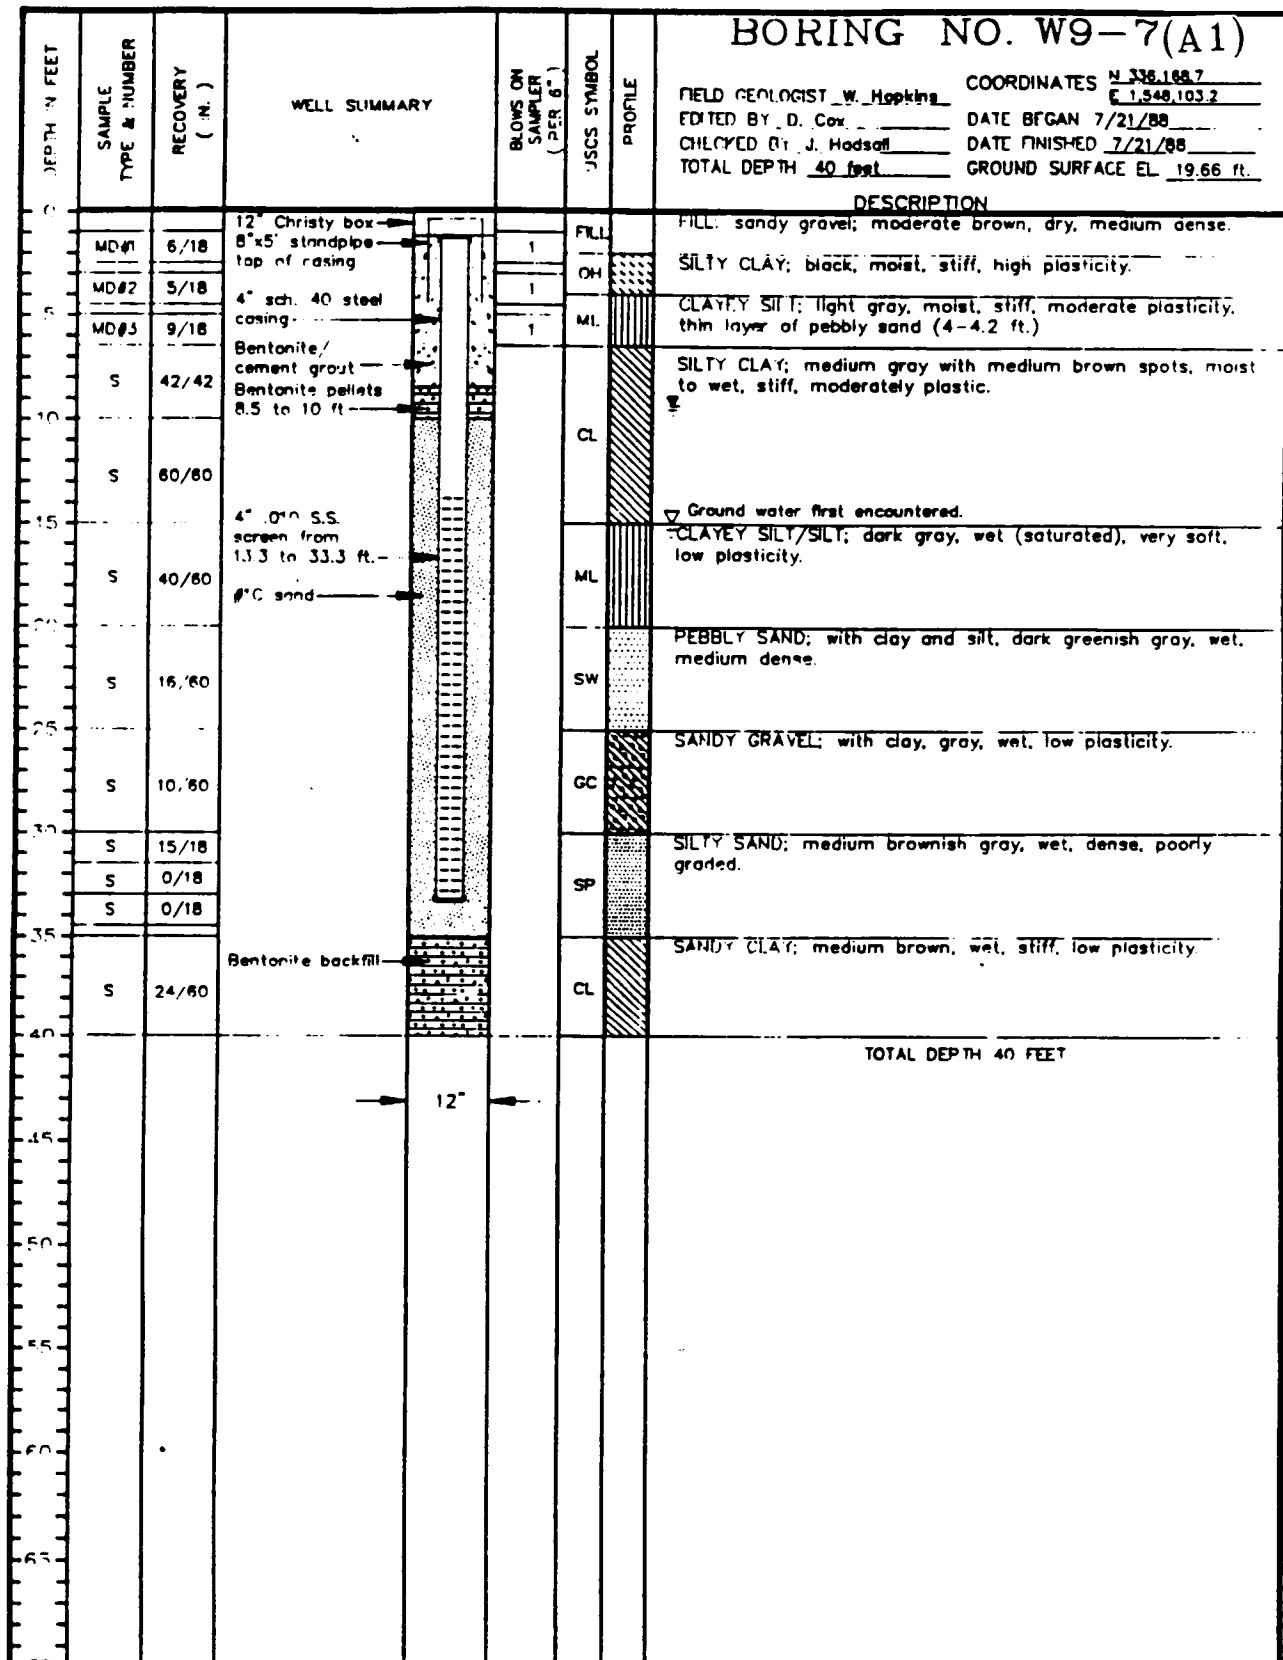

DRILLING CO.: Water Development Co.
DRILLING METHOD: CME 75 Hollow Stem Auger

SAMPLING METHODS: MD=California Modified
S=Split Barrel


PROJECT NO.: 409616

CLIENT: Moffett Naval Air Station
Moffett Field, California



...Creating a Safer Tomorrow

**EE LEGEND FOR LOGS AND TEST PITS
FOR EXPLANATION OF SYMBOLS AND TERMS**

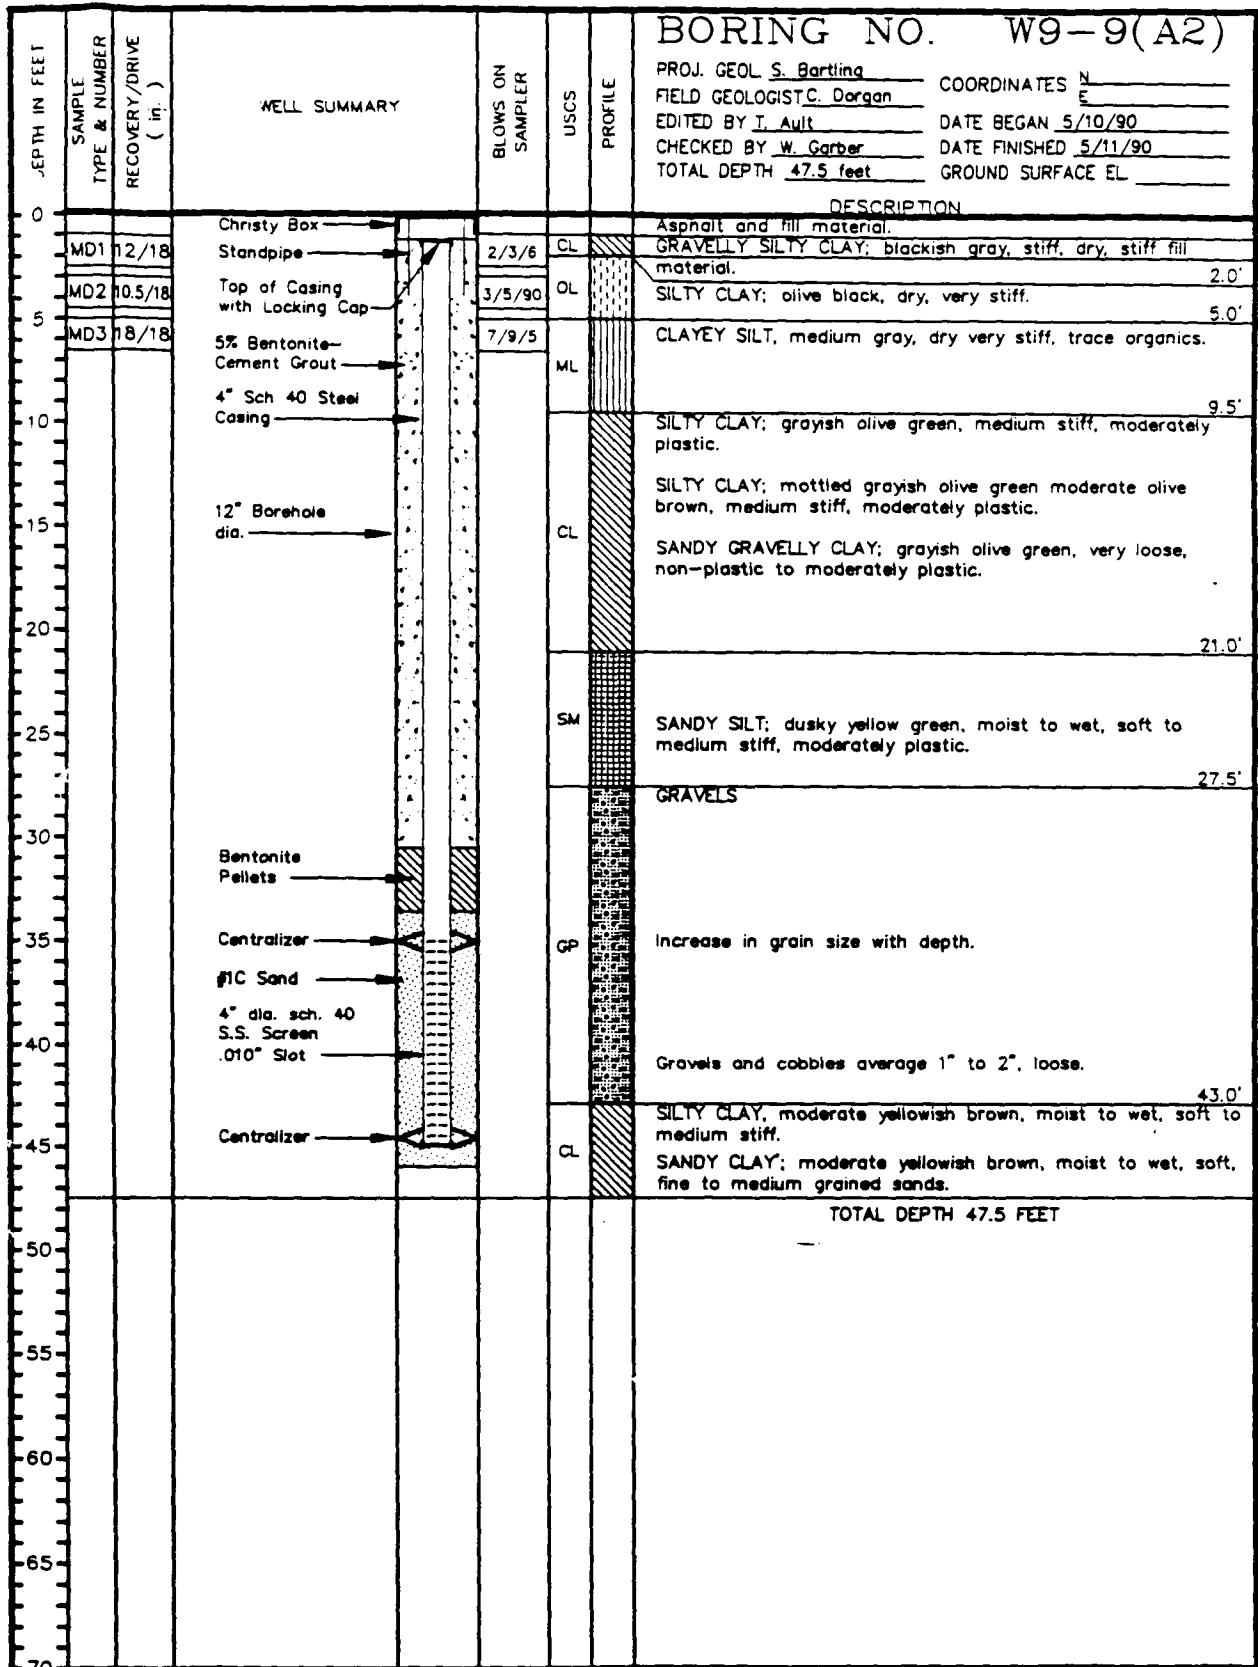


DRILLING CO.: Water Development
DRILL METHOD: Hollow Stem Auger (Rig CME-55)

PAGE 1 OF 1

PROJECT NO.: 409700
CLIENT: Moffett Naval Air Station
LOCATION: Moffett Field, California

SEE LEGEND FOR LOGS AND TEST PITS
FOR EXPLANATION OF SYMBOLS AND TERMS

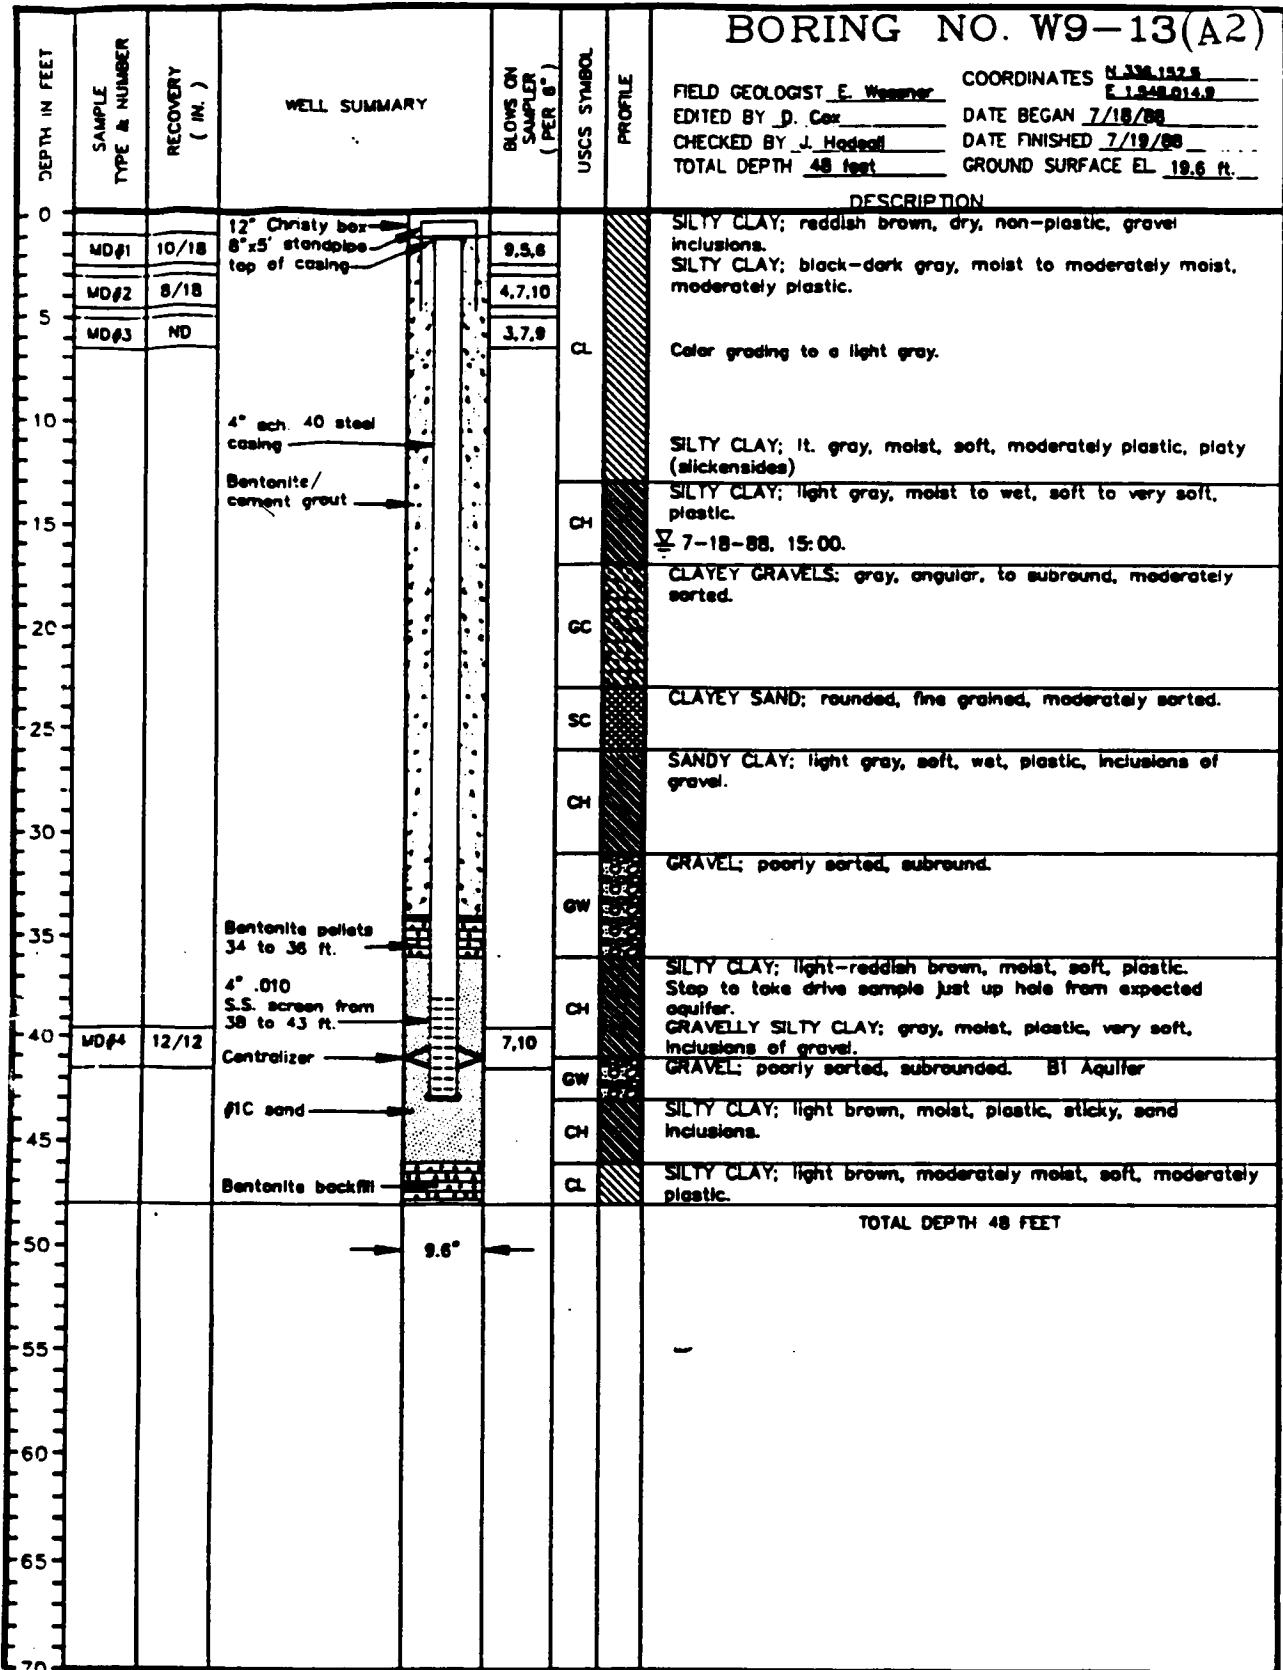

DRILLING CO.: Water Development Co.
DRILLING METHOD: Air Rotary

SAMPLING METHODS: MD=California Modified
S=Split Barrel

PROJECT NO.: 409616
CLIENT: Moffett Naval Air Station
Moffett Field, California

FIELD GEOLOGIST E. Wagner
EDITED BY J. Cox
CHECKED BY J. Hodges
TOTAL DEPTH 48 feet
GROUND SURFACE EL 19.6 ft.

DATE BEGAN 7/18/88
DATE FINISHED 7/19/88



...Creating a Safer Tomorrow

SEE LEGEND FOR LOGS AND TEST PITS
FOR EXPLANATION OF SYMBOLS AND TERMS

DEPTH IN FEET	SAMPLE TYPE & NUMBER	RECOVERY (IN.)	WELL SUMMARY	GLOWS IN SAMPLER (PER 6")	USCS SYMBOL	PROFILE	BORING NO. W9-14(A2)	
							FIELD GEOLOGIST E. Weisser	COORDINATES N 335,498.3 E 1,548,847.7
0			12" Christy box 8"x5' standpipe top of casing	3.5,7	CL		FINTED BY D. Cox	DATE BEGAN 3/3/88
5	MD/1	12/18		3.3,9			CHECKED BY J. Hodges	DATE FINISHED 3/8/88
5	MD/2	12/18		3.6,11			TOTAL DEPTH 54.7 feet	GROUND SURFACE EL 20.9 ft.
5	MD/3	12/18	4" sch. 40 steel casing		SP			
10			Bentonite/ cement grout		CL			
15					CH			
20					GP			
25					CL			
30					SP - GP			
35			Bentonite pellets 34.9 to 36.8 ft.		CL			
40			4" .010 sch. 40 S.S. screen from 39 to 49 ft.		CH			
45			Centralizer		SW	Making water		
50			Centralizer		CL	SAND: clear-tan, fine-coarse, poorly sorted, sub-rounded, some gravel, no fines.		
55			PC sand		GW	SILTY CLAY: gray, moist, soft, moderately plastic. SANDY GRAVEL: very poorly sorted, sub-angular, fine grained sand to coarse gravel. Grading into coarse gravel.		
60			Bentonite backfill		CL	Making water		
65					SW	SILTY CLAY: orangish brown, moist, soft, medium plastic.		
70						CLAYEY SILTY GRAVELLY SAND: black and brown, medium grained sand, fine gravels with fines interbedded.		
				9.6"				TOTAL DEPTH 54.7 FEET

DRILLING CO.: Water Development Co.
DRILLING METHOD: Air Rotary

SAMPLING METHODS: MD=California Modified
S=Split Barrel

PROJECT NO.: 409616

CLIENT: Moffett Naval Air Station
Moffett Field, California

PAGE 1 OF 1



...Creating a Safer Tomorrow

SEE LEGEND FOR LOGS AND TEST PITS
FOR EXPLANATION OF SYMBOLS AND TERMS

DEPTH IN FEET	SAMPLE TYPE & NUMBER	RECOVERY (in.)	WELL SUMMARY	BLOWS ON SAMPLER (PER 6")	USCS SYMBOL	PROFILE	BORING NO. W9-15(B2)	
							FIELD GEOLOGIST E. Wagner	COORDINATES N 335,828.0 E 1,348,605.0
0			12" Christy box	3.5.5	CL		SILTY CLAY; light brown-gray, slightly moist, soft, mod. plastic, inclusions of gravel.	
	MD#1	6/10	8"x5' standpipe	3.7.18	SP		SILTY CLAY; yellow brown, slight moist, soft, slightly plastic.	
	MD#2	18/18		12.24.25	CL		GRAVELLY SAND; yellow tan, slightly moist, medium grained, moderately sorted.	
	MD#3	18/18			CH		SILTY CLAY; brown-light gray, moist, very soft, moderate to slightly plastic.	
10			Bentonite/cement grout		MT		Moisture is picking up @ 10', water table must be close but have not seen water.	
15					SM		SILTY CLAY; light gray, moist, very soft, plastic.	
20					CH		SILTY CLAY/CLAYEY SILT; gray, moist, very soft, plastic, inclusions of gravel.	
25					MT		20' connection had water in hole. Ground water first encountered.	
30					SM		SILTY SAND; gray, very fine to fine grained, wet, loose, moderately sorted with some coarse sand. Mostly opaque with black minerals.	
35			4" sch 40 S.S. casing		CH		Adding water to drill. Making water.	
40					SC-GC		SILTY CLAY; gray, moist, soft, plastic.	
45					SM		SILTY SANDY CLAY; gray and orange, soft, moist, moderately plastic, gravel inclusions.	
50					GW		CLAYEY SAND & GRAVEL; brown-tan, moderately sorted sand and gravel, fine to very fine sand and gravels.	
55					CL		SILTY SAND; brown, moist, very soft, very fine grained sand, loose.	
60					GW		SANDY GRAVELS; fine gravels, coarse sands, poorly sorted, angular to sub-angular, light gray-black, clear quartz, stringers of silty clay; gray, soft, moderately plastic.	
65					SM		Making lots of water	
70					CL		SILTY CLAY; reddish brown, moist, soft, moderately plastic.	
75					GW		SILTY SAND/SANDY CLAY; light brown, wet, loose, fine to medium grained.	
					CL		GRAVEL; with coarse sand, black and opaque, fine gravels, angular poorly sorted.	
					SM		SILTY SANDY CLAY; brown, moist, soft, moderately plastic.	
					SP		Making water	
					SM-SP		SILTY SAND; light brown, wet, very fine grained, moderately sorted, loose, with some medium grained sands, black minerals.	

DRILLING CO.: Water Development Co.
DRILLING METHOD: Air Rotary

SAMPLING METHODS: MD=California Modified
S=Split Barrel

PROJECT NO.: 409616


CLIENT: Moffett Naval Air Station
Moffett Field, California

PAGE 1 OF 2



...Creating a Safer Tomorrow

SEE LEGEND FOR LOGS AND TEST PITS
FOR EXPLANATION OF SYMBOLS AND TERMS

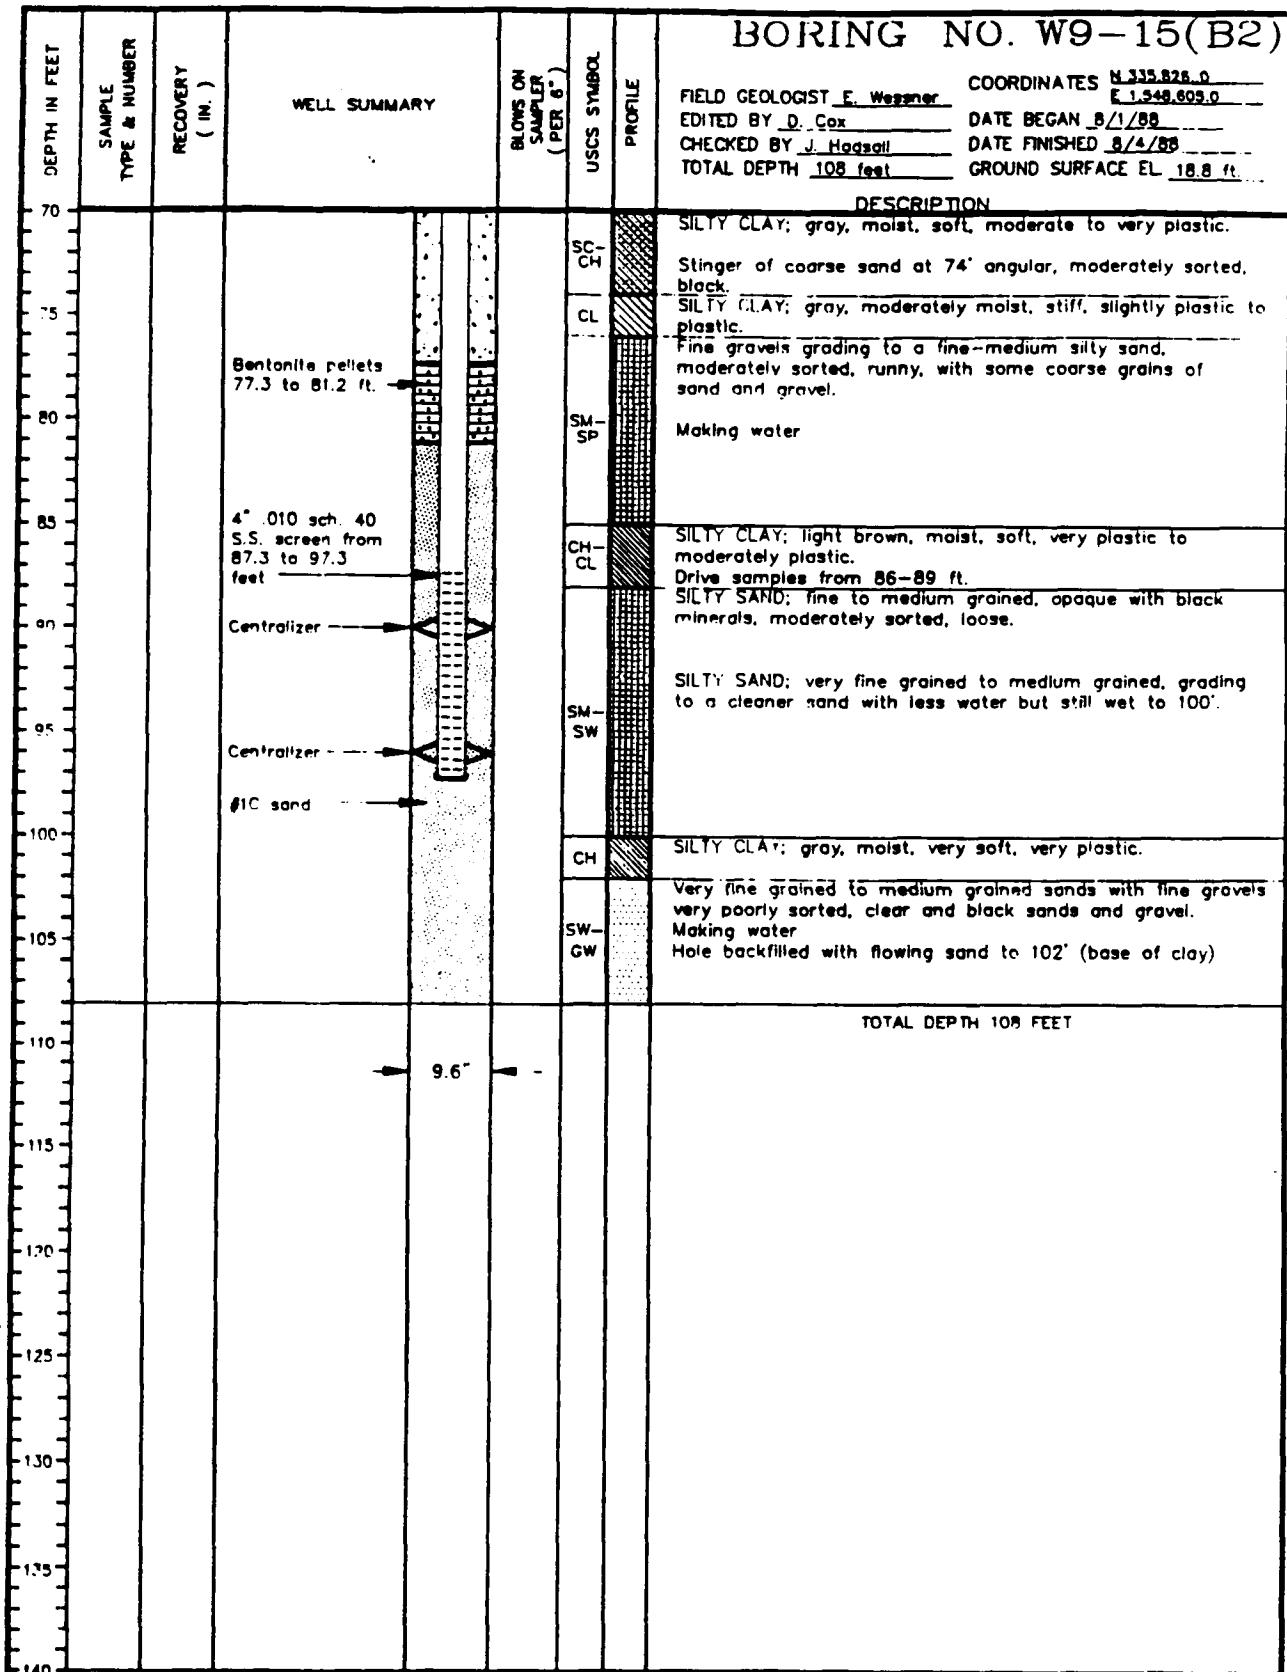

DRILLING CO.: Water Development Co.
DRILLING METHOD: Air Rotary

SAMPLING METHODS: MD=California Modified
S=Split Barrel

PROJECT NO.: 409616
CLIENT: Moffett Naval Air Station
Moffett Field, California

AutoCAD FILE: W9-15B2.DWG



...Creating a Safer Tomorrow

SEE LEGEND FOR LOGS AND TEST PITS
FOR EXPLANATION OF SYMBOLS AND TERMS

PAGE 2 OF 2

DEPTH IN FEET	SAMPLE	TYPE & NUMBER	RECOVERY/DRIVE (in)	WELL SUMMARY			BLOWS ON SAMPLER	USCS	PROFILE	BORING NO. W9-20(A2)		
										PROJ. GEOL. S. Bartling	COORDINATES N _____ E _____	
0										FIELD GEOLOGIST T. Ault		
3										EDITED BY T. Ault	DATE BEGAN 3-29-90	
5	MD1	16/18		Top of Casing			5/7/12	CL		CHECKED BY W. Garber	DATE FINISHED 3-30-90	
5	MD2	16/18					5/7/11	SC		TOTAL DEPTH 48 ft.	GROUND SURFACE E. _____	
5	MD3	16/18					7/10/10	SW				
10			0/60					SC		DESCRIPTION		
10			60/60	4" Sch. 40 Steel Casing						TOP SOIL: light brown gray, sandy gravelly clay, dry		
15			0/60							SILTY CLAY: dusky yellow, low plasticity, soft to very soft, slightly moist.		
20			30/60	5% Bentonite Cement Grout						CLAYEY SILTY SAND: dusky yellow, gravel at base, dry to slight- ly moist, loose.	5.0'	
25			40/60	Grout Protection Seal: Bentonite Pellets						SAND: medium gray, medium to coarse, very moist to wet, loose.	6.5'	
30			0/60							CLAYEY SAND: light gray, very moist, very soft, medium plasticity, subangular to subrounded inclusions.		
35			36/60	#1C Sand						CLAYEY SILTY SAND: red brown, slightly to moderately moist, soft, moderately dense.	13.0'	
40			0/36	4" dia. sch. 40 S.S. Screen .010" Slot						CLAYEY SAND: light gray, wet, soft.	13.0'	
45			50/60	Native Soil						CLAYEY SANDS: light gray, very moist, (Very fine to fine grain).	15.0'	
50										SAND: gray, minor clay, very wet, (Very fine to fine grain).		
55										CLAYEY SAND: light gray, very moist, very soft, low plasticity, grades to dark yellowish orange color.	22.0'	
60										SILTY CLAY: dusky yellow, moderately moist, soft, moderately plastic.	26.0'	
65										CLAYEY SAND: very fine grain, moderately moist. SAND: flowing.	29.0'	
70										CLAYEY SILT: dark yellowish brown, gray mottling, moderately moist, soft, moderately plastic.	30.0'	
										CLAYEY SILTY SAND: light brown, wet, loose, (medium to fine grain).	37.0'	
										SILTY SAND: dark yellowish to orange, wet, very low plasticity, very fine grain.	39.0'	
										CLAYEY SILT to SILTY CLAY: moderate yellowish orange, moderately moist, medium plasticity, abundant subrounded fine gravel.	43.0'	
										TOTAL FEET IS 48 FEET	44.0'	

DRILLING CO.: Water Development
DRILL METHOD: Hollow Stem Auger (Rig CME-75)

PAGE 1 OF 1

PROJECT NO.: 409700
CLIENT: Moffett Naval Air Station
LOCATION: Moffett Field, California

SEE LEGEND FOR LOGS AND TEST PITS
FOR EXPLANATION OF SYMBOLS AND TERMS

MF-W9-20(MF13)



**INTERNATIONAL
TECHNOLOGY
CORPORATION**


DEPTH IN FEET	SAMPLE TYPE & NUMBER (in.)	WELL SUMMARY			PROJ. GEOL S. Bartling FIELD GEOLOGIST T. Ault EDITED BY T. Ault CHECKED BY W. Garber TOTAL DEPTH 51.5 ft.	COORDINATES N E DATE BEGAN 4-19-90 DATE FINISHED 4-23-90 GROUND SURFACE EL.
		RECOVERY/DRIVE	USCS	PROFILE		
0						
MD1	11/18	Christy Box	GM		GRAVEL mixed with red brown soil, dry, unconsolidated.	1.5'
MD2	12/18	Standpipe	6/10/12	ML	CLAYEY SILT; light olive gray, moist, firm, slightly plastic.	3.0'
5	MD3	Top of Casing with Locking Cap	5/6/8	CL	SILTY CLAY; pale yellowish brown, slightly moist, slight plasticity (low).	5.0'
5	MD3		5/6/6	CL	SANDY CLAY; dark yellowish brown, slightly moist, soft, moderately plastic.	6.5'
10				SC	CLAYEY SAND; fine grained, moderate yellowish brown, moist to very moist, very loose.	7.5'
10		5% Bentonite-Cement Grout		CL	SANDY CLAY; moderate yellowish brown, moist, very soft, medium plasticity, fine sand. Dark gray, soft, plastic. Mottled pale yellowish brown, moist, firm, plastic clay at 9.5'.	10.0'
10		4" dia. sch. 40 Steel Casing		CL	CLAY; dark gray, wet, firm to soft, plastic.	12.0'
15				SC	CLAYEY SAND; very fine grained, dark gray, very wet, loose to very loose. (gradational contact with unit above).	14.5'
15				SP	SAND; coarse grained, light olive brown, wet, loose, some fine gravel. Flowing sand, medium to coarse grained, clean.	
20					SAND; dark gray, very wet, no cohesion (very loose), (fine sand, rounded to sub-angular).	20.0'
20		Continuous Core		SP	SILT (gravelly); light olive brown, medium dense, non-plastic, (medium gravel, sub-rounded to sub-angular).	24.5'
25				GM	SAND.	25.0'
30				SP		
35					CLAYEY SILT; dusky yellow, moist, firm, low plasticity, (some reddish mottling).	36.0'
35		Bentonite Pellets		ML	SILTY CLAY, dusky yellow, moist, soft, medium plasticity.	37.0'
40		#1C Sand		CL	SANDY CLAY; dusky yellow, moist, very soft, medium plasticity, (sand<5%).	38.5'
40				CL	SAND.	40.0'
45				SP	CLAY; grayish orange, slightly moist, firm to hard, plastic (when worked), minor silt, some fine gravel at ~ 47'.	45.0'
45		4" dia. sch. 40 S.S. Screen .010" Slot		CL	SANDY CLAY; moderate yellowish brown, soft to very soft, plastic to medium plastic, (coarse sand), zoned sand layers.	49.5'
50				CL		
50		Backfill: Native Soil			TOTAL DEPTH 51.5 FEET	
55						
60						
65						
70						

DRILLING CO.: Water Developement
DRILL METHOD: Hollow Stem Auger (Rig CME-75)

PAGE 1 OF 1

PROJECT NO.: 409700
CLIENT: Maffett Naval Air Station
LOCATION: Moffett Field, California

SEE LEGEND FOR LOGS AND TEST PITS
FOR EXPLANATION OF SYMBOLS AND TERMS

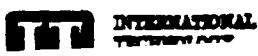


DRILLING CO.: Water Development
DRILL METHOD: Hollow Stem Auger (Rig CME-55)

PAGE 1 OF 1

PROJECT NO.: 409700
CLIENT: Moffett Naval Air Station
LOCATION: Moffett Field, California

SEE LEGEND FOR LOGS AND TEST PITS
FOR EXPLANATION OF SYMBOLS AND TERMS

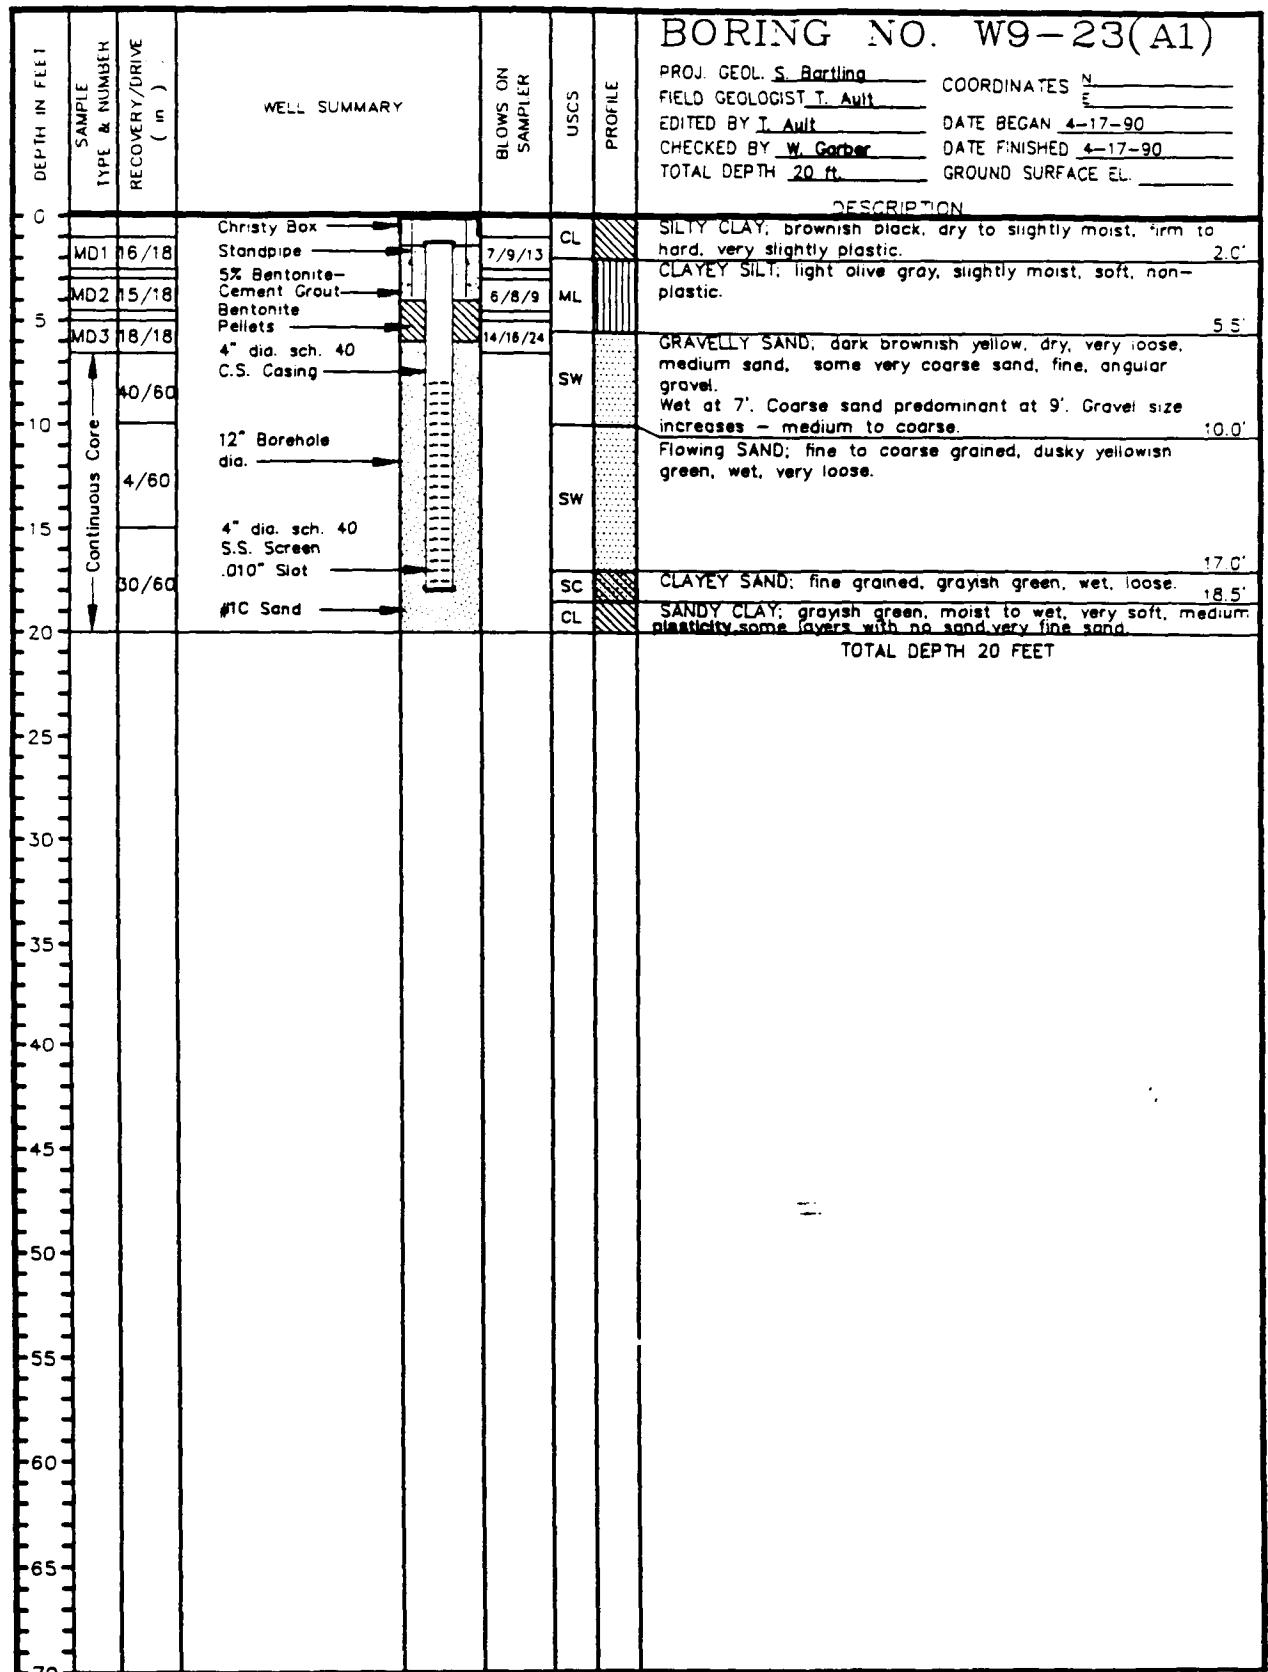

DRILLING CO.: Water Developement
 DRILL METHOD: Hollow Stem Auger (Rig CME-75)


PAGE 1 OF 1

PROJECT NO.: 409700
 CLIENT: Moffett Naval Air Station
 LOCATION: Moffett Field, California

SEE LEGEND FOR LOGS AND TEST PITS
 FOR EXPLANATION OF SYMBOLS AND TERMS

MF-W9-23(*MF16)



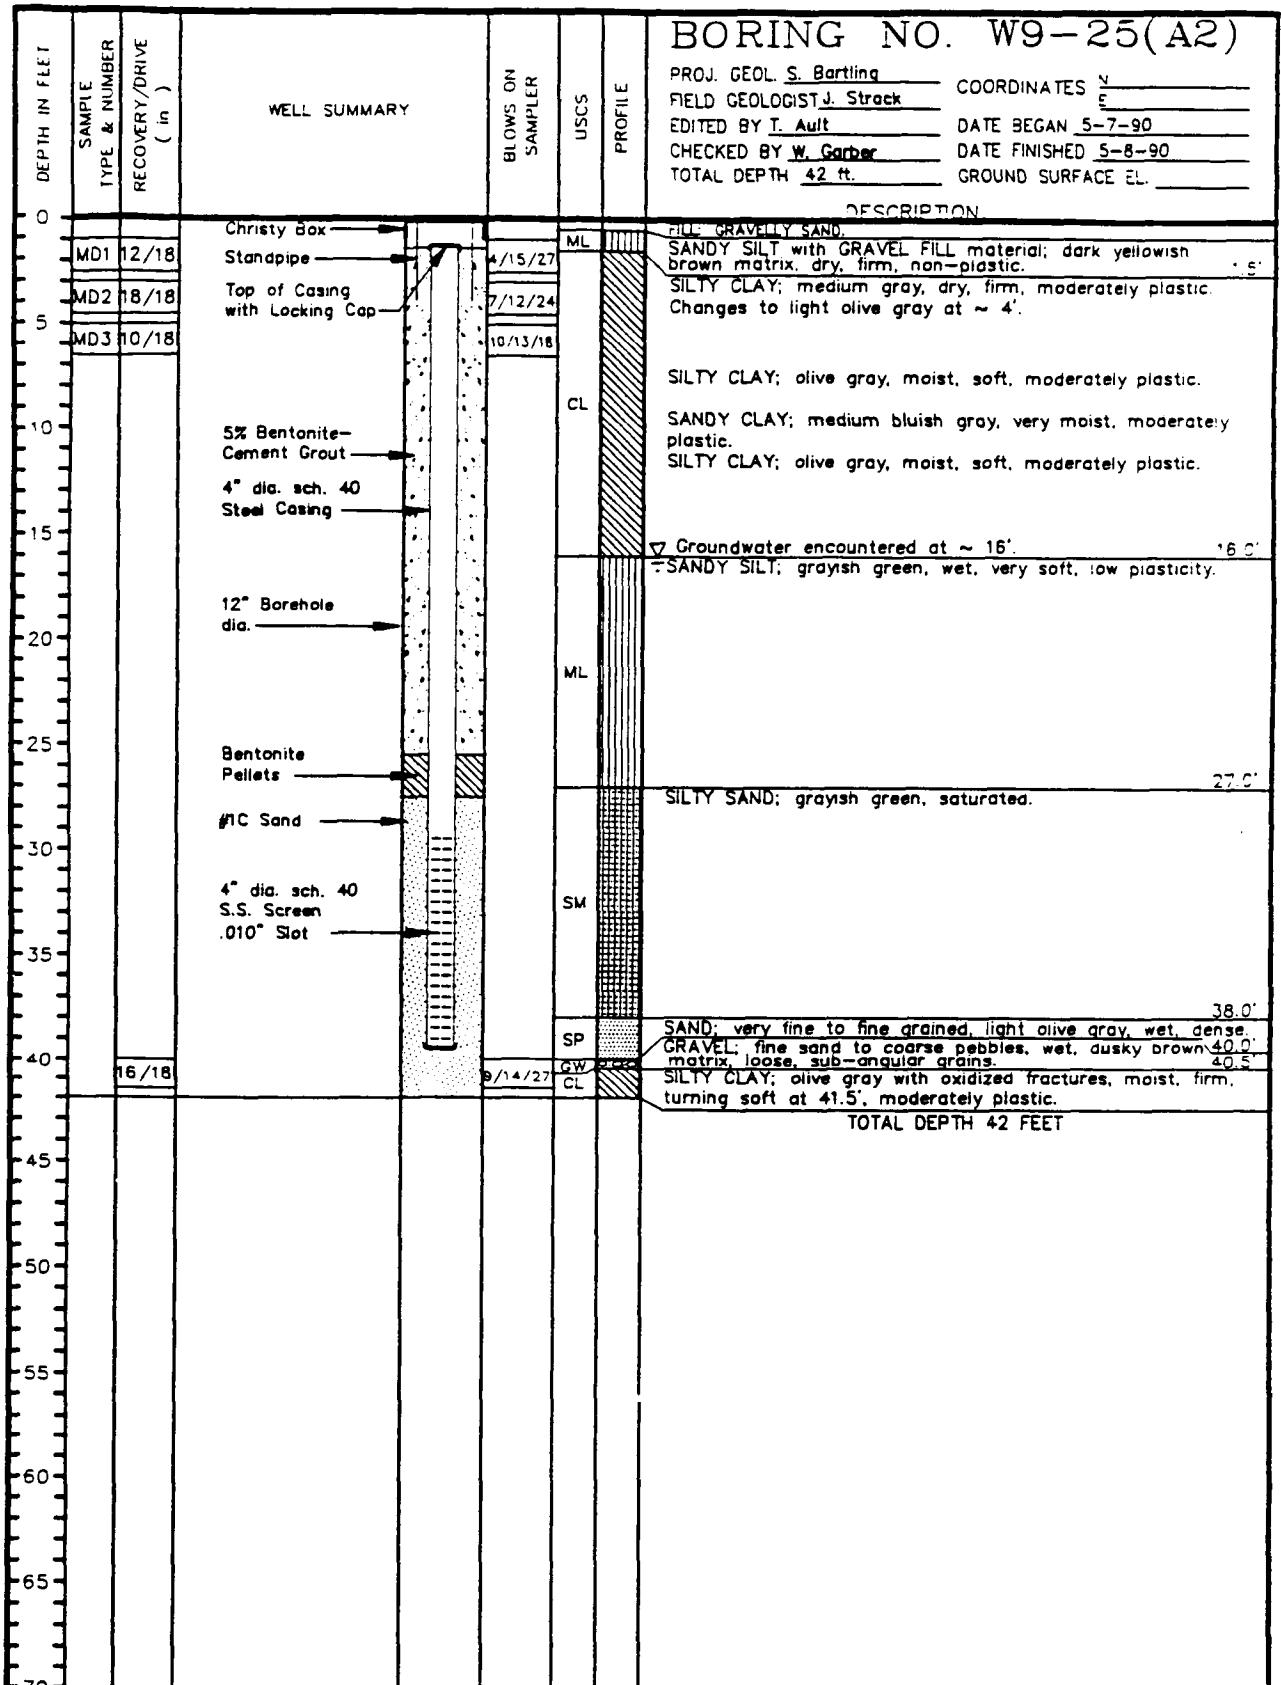

DRILLING CO.: Water Developement
DRILL METHOD: Hollow Stem Auger (Rig CME-75)

PAGE 1 OF 1


PROJECT NO.: 409700
CLIENT: Moffett Naval Air Station
LOCATION: Moffett Field, California

SEE LEGEND FOR LOGS AND TEST PITS
FOR EXPLANATION OF SYMBOLS AND TERMS

MF-W9-25(MF16)



INTERNATIONAL
TECHNOLOGY
CORPORATION

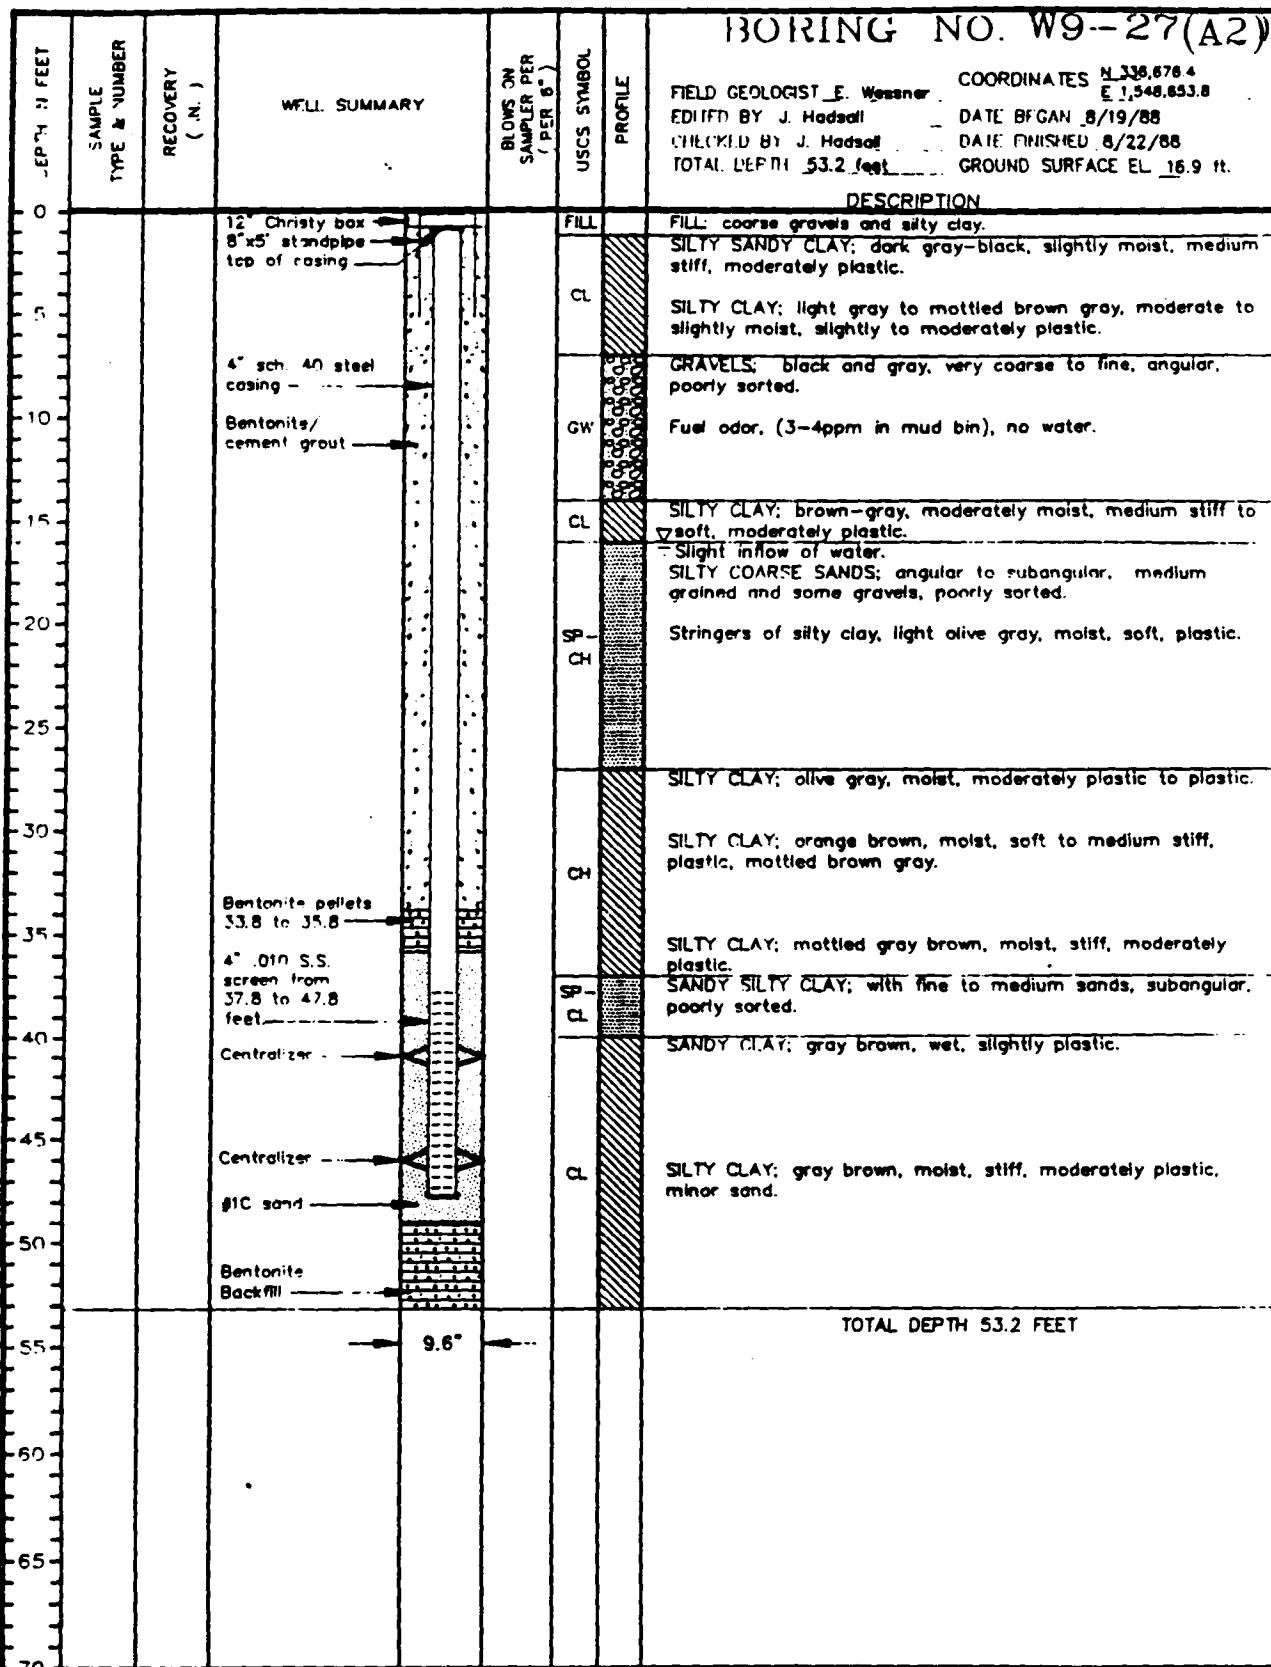

DRILLING CO.: Water Development Co.
DRILLING METHOD: Air Rotary

NOTE: Redrill of W9-27(B1), (7-19-88)
No samples taken while drilling this well. Samples taken
during the drilling of the original W9-27(B1-abandoned)
will be used as sample data.

PROJECT NO.: 409616
CLIENT: Moffett Naval Air Station
Moffett Field, California

AutoCAD FILE: MWB-27B1.DWG

PAGE 1 OF 1



...Creating a Safer Tomorrow

SEE LEGEND FOR LOGS AND TEST PITS
FOR EXPLANATION OF SYMBOLS AND TERMS

DEPTH IN FEET	SAMPLE TYPE & NUMBER	RECOVERY/DRIVE (in)	WELL SUMMARY	BLOWS ON SAMPLER	USCS	PROFILE	BORING NO. W9-33(A2)	
							PROJ. GEOL. S. Bartling	COORDINATES N _____ E _____
0			Christy Box					
	MD1	16/18	Standpipe	7/18/21		CL		
5	MD2	11/18	Top of Casing with Locking Cap	8/12/16				
5	MD3	12/18		5/6/9		CL		
10		5/60						
15		5/60	5% Bentonite— Cement Grout			SW		
15		4/60	4" dia. sch. 40 Steel Casing			SP		
20		30/60	12" Borehole dia.			SC		
25		50/60	Bentonite Pellets			CL		
30		50/60	Centralizer			ML		
35		45/60	#1C Sand			SP		
40		4/60	4" dia. sch. 40 S.S. Screen .010" Slot			GW		
45		24/60	Centralizer			NA	ML	
50	NA	18/18						
								TOTAL DEPTH AT 51.5 FT.
55								
60								
65								
70								

DRILLING CO.: Water Developement
DRILL METHOD: Hollow Stem Auger (Rig CME-55)


PROJECT NO.: 409700
CLIENT: Moffett Naval Air Station
LOCATION: Moffett Field, California

MF-W9-33(MF19)

SEE LEGEND FOR LOGS AND TEST PITS
FOR EXPLANATION OF SYMBOLS AND TERMS



INTERNATIONAL
TECHNOLOGY
CORPORATION

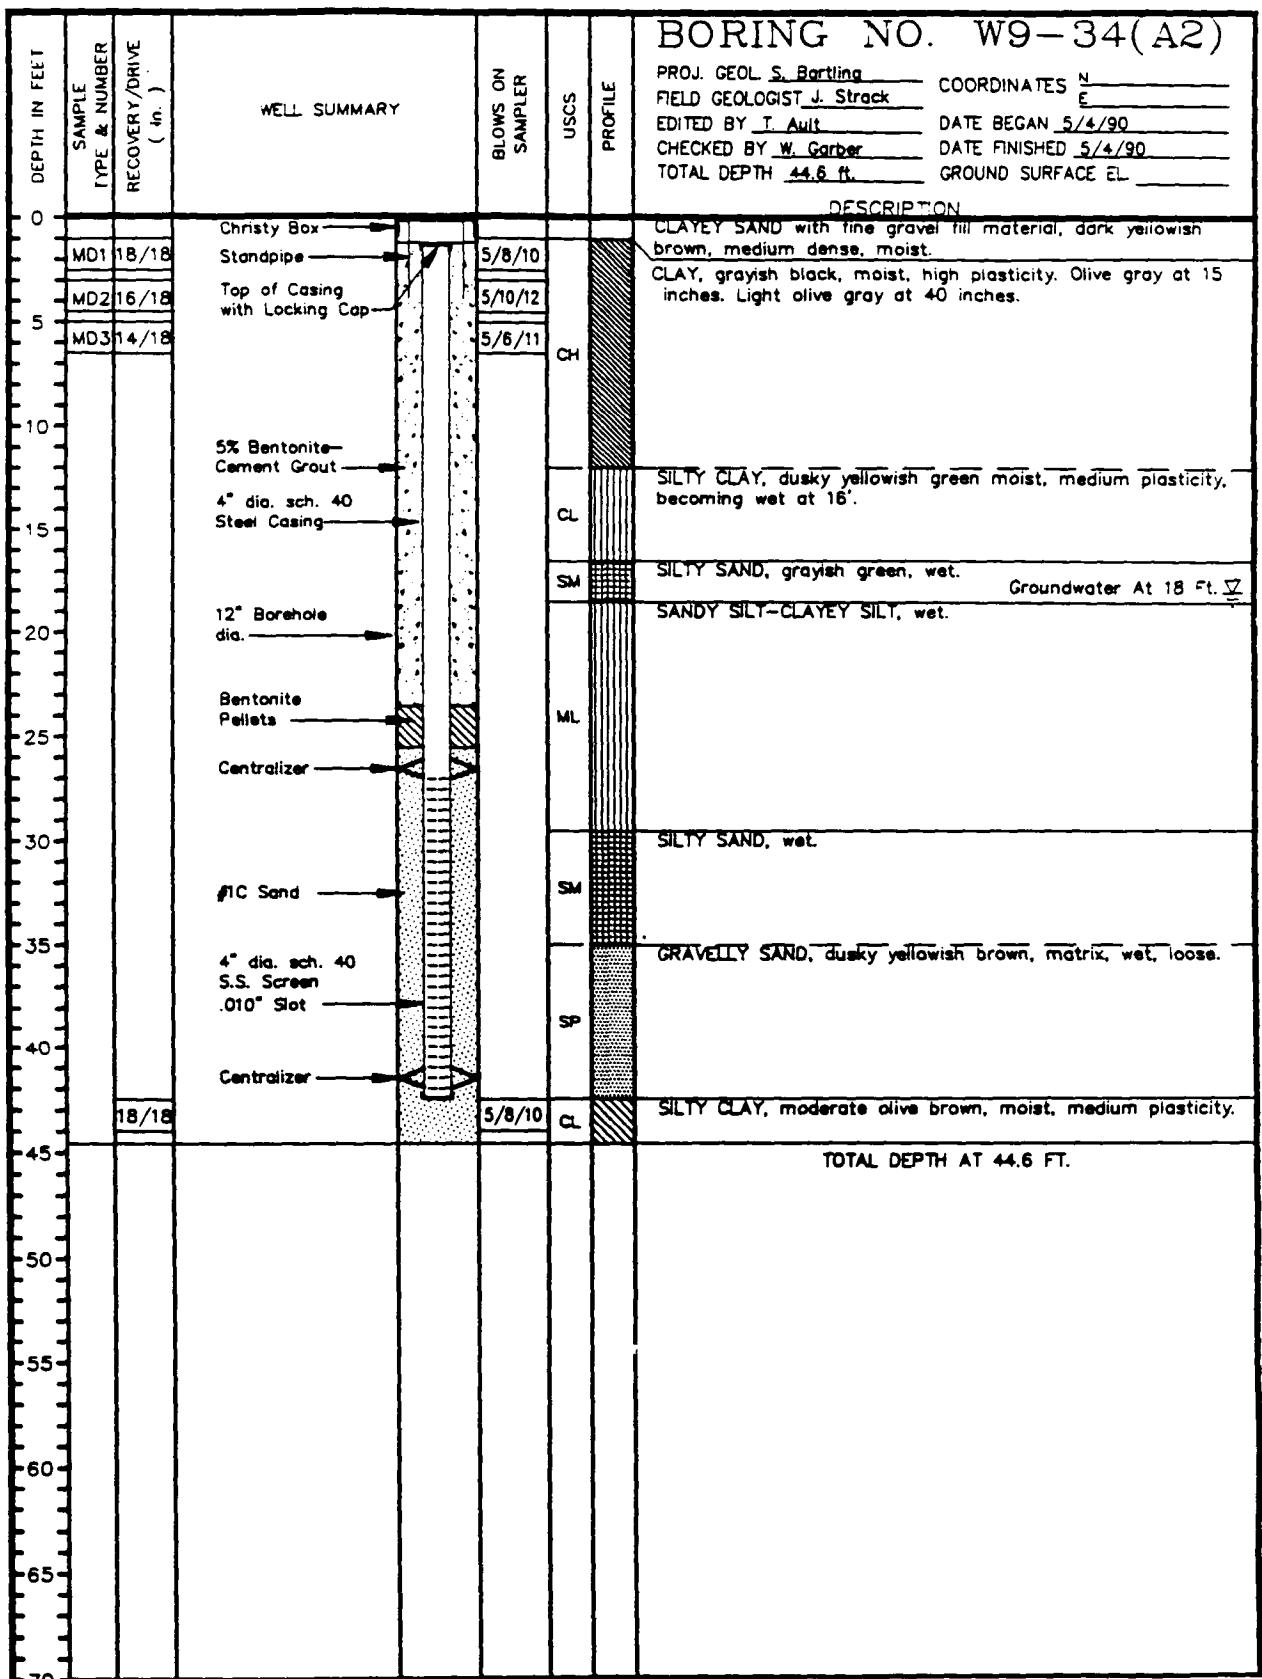


DRILLING CO.: Water Developement
 DRILL METHOD: Hollow Stem Auger (Rig CME-55)

PAGE 1 OF 1

PROJECT NO.: 409700
 CLIENT: Moffett Naval Air Station
 LOCATION: Moffett Field, California

SEE LEGEND FOR LOGS AND TEST PITS
 FOR EXPLANATION OF SYMBOLS AND TERMS

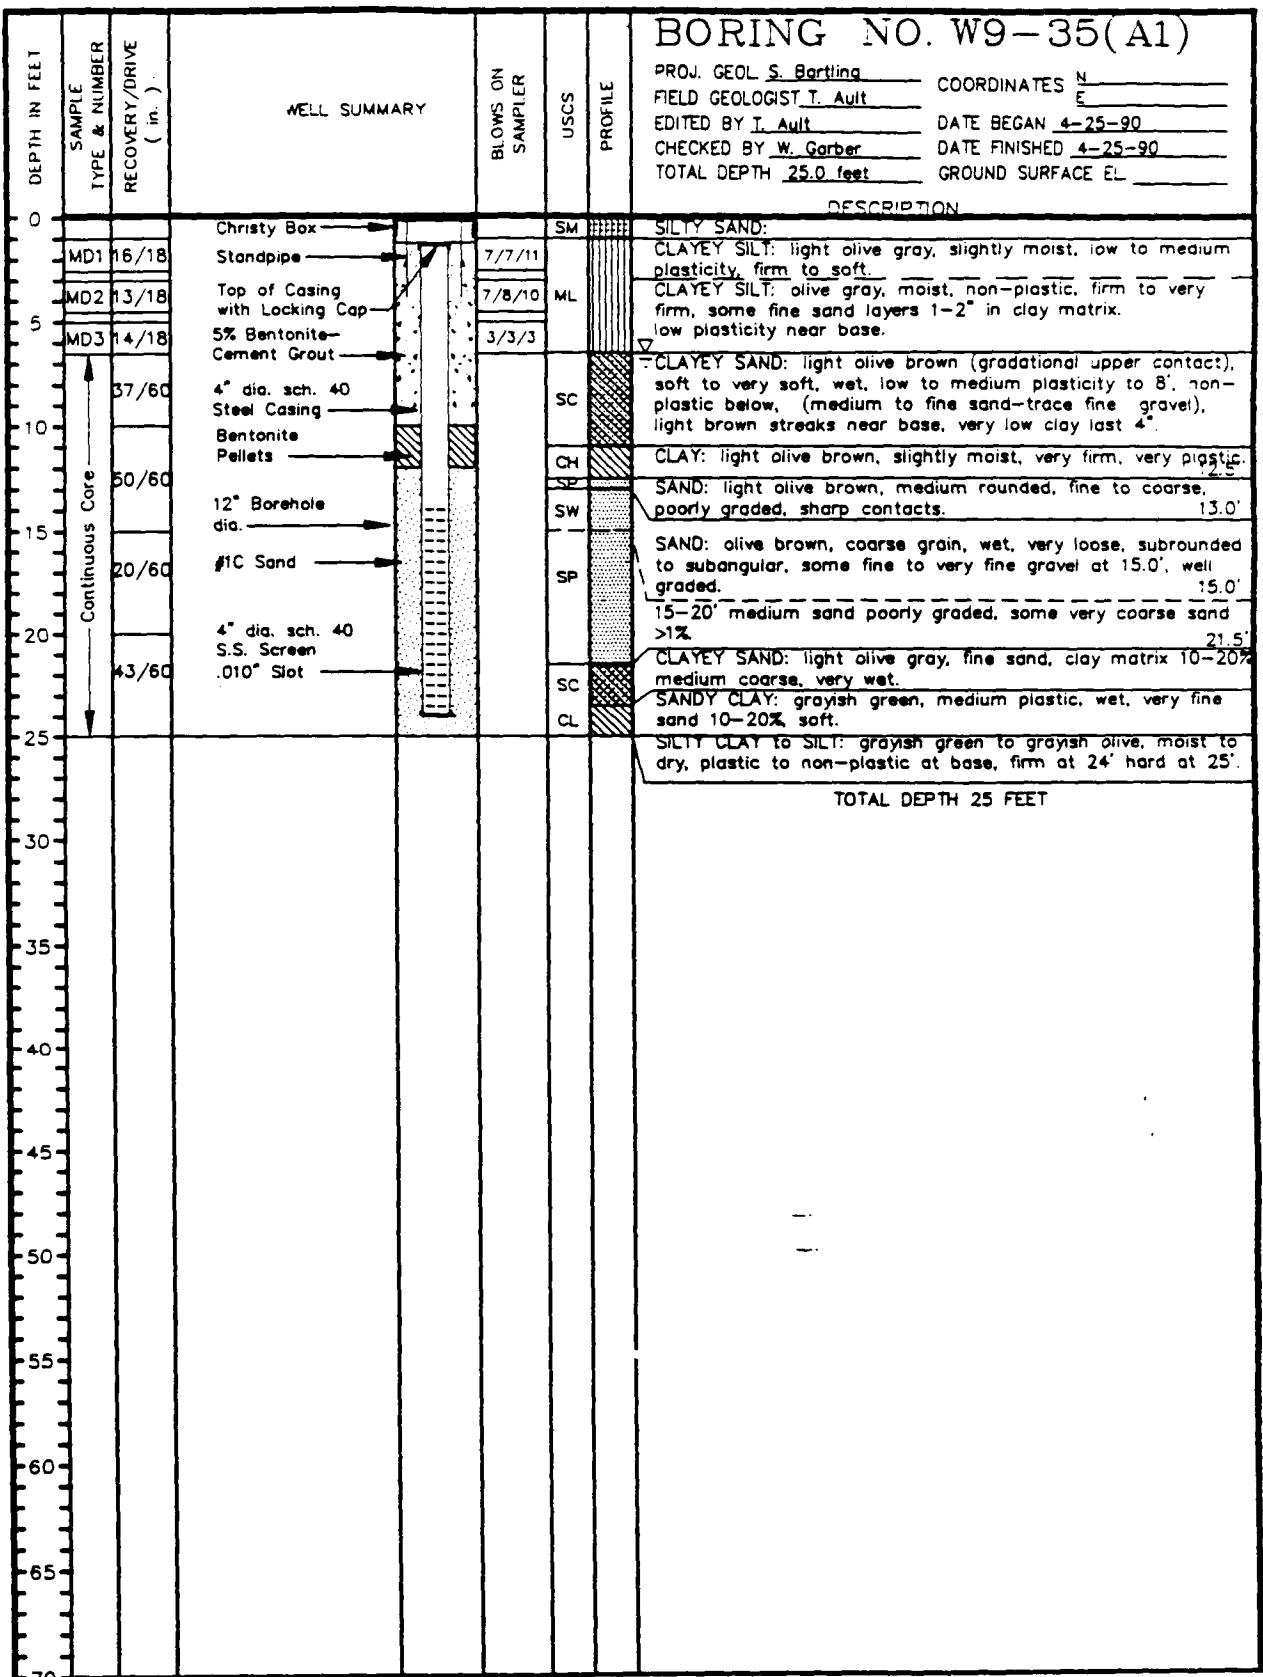


DRILLING CO.: Water Developement
 DRILL METHOD: Hollow Stem Auger (Rig CME-75)

PAGE 1 OF 1

PROJECT NO.: 409700
 CLIENT: Moffett Naval Air Station
 LOCATION: Moffett Field, California

SEE LEGEND FOR LOGS AND TEST PITS
 FOR EXPLANATION OF SYMBOLS AND TERMS

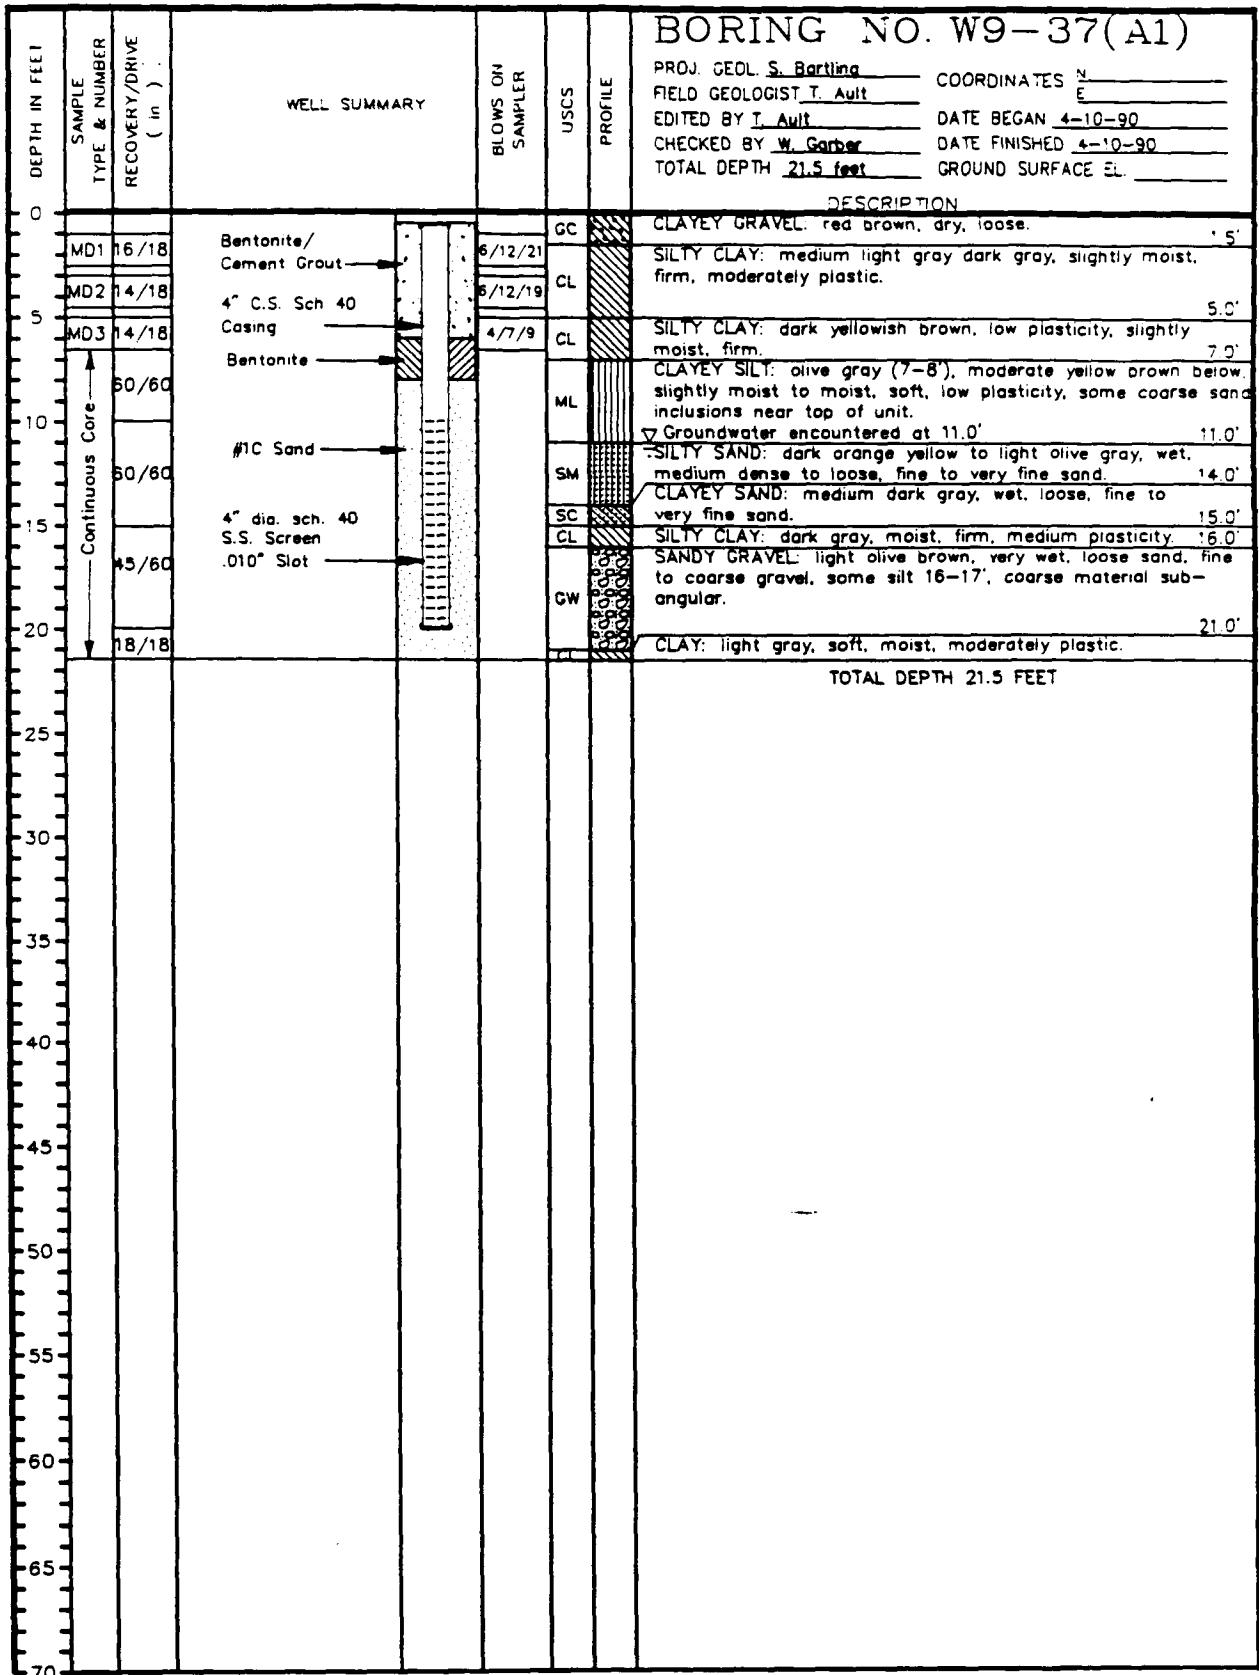

DRILLING CO.: Water Developement
 DRILL METHOD: Hollow Stem Auger (Rig CME-75)

PAGE 1 OF 1

PROJECT NO.: 409700
 CLIENT: Moffett Naval Air Station
 LOCATION: Moffett Field, California

SEE LEGEND FOR LOGS AND TEST PITS
 FOR EXPLANATION OF SYMBOLS AND TERMS


DRILLING CO.: Water Development
DRILL METHOD: Hollow Stem Auger (Rig CME-75)


PAGE 1 OF 1

PROJECT NO.: 409700

CLIENT: Moffett Naval Air Station
LOCATION: Moffett Field, California

SEE LEGEND FOR LOGS AND TEST PITS
FOR EXPLANATION OF SYMBOLS AND TERMS

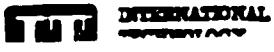

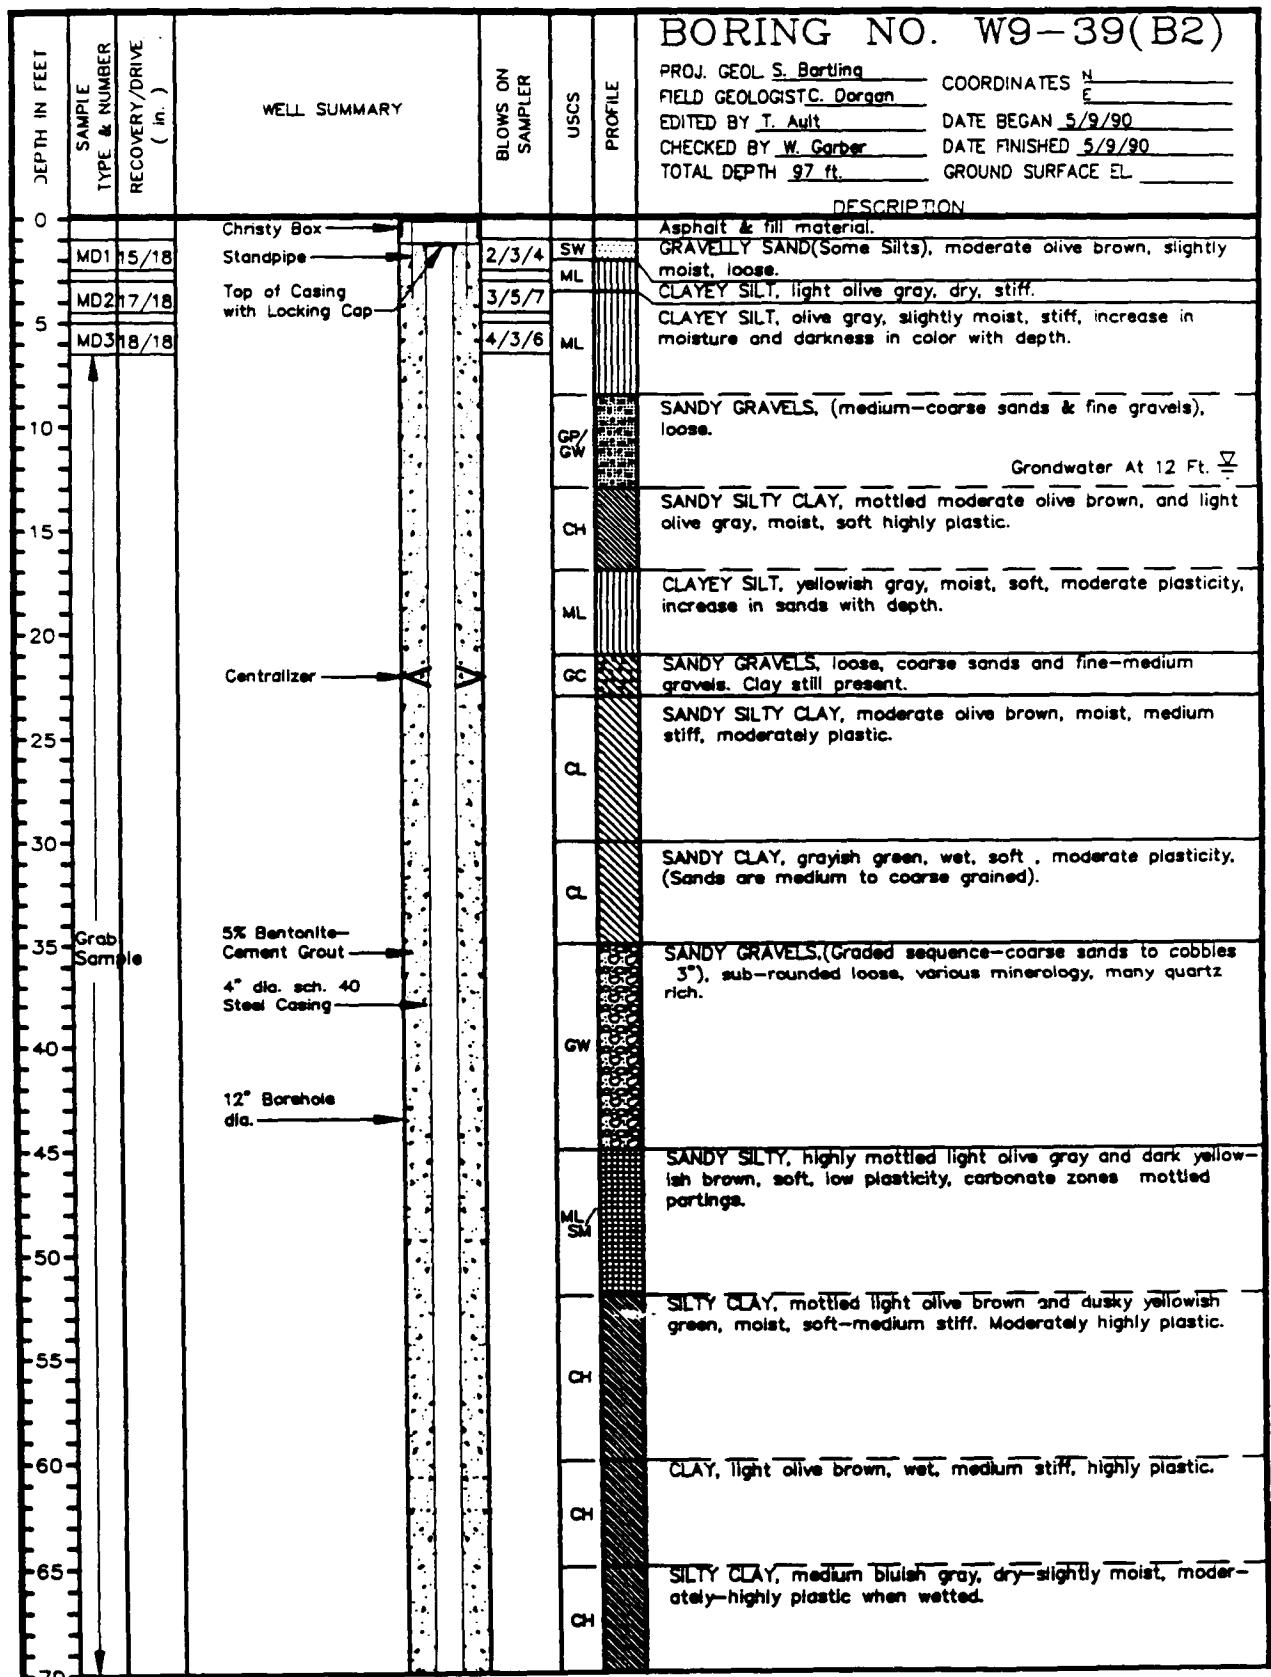


DRILLING CO.: Water Developement
DRILL METHOD: Air Rotory with Drive Casing

PROJECT NO.: 409700
CLIENT: Moffett Naval Air Station
LOCATION: Moffett Field, California

SEE LEGEND FOR LOGS AND TEST PITS
FOR EXPLANATION OF SYMBOLS AND TERMS



INTERNATIONAL
TECHNOLOGY

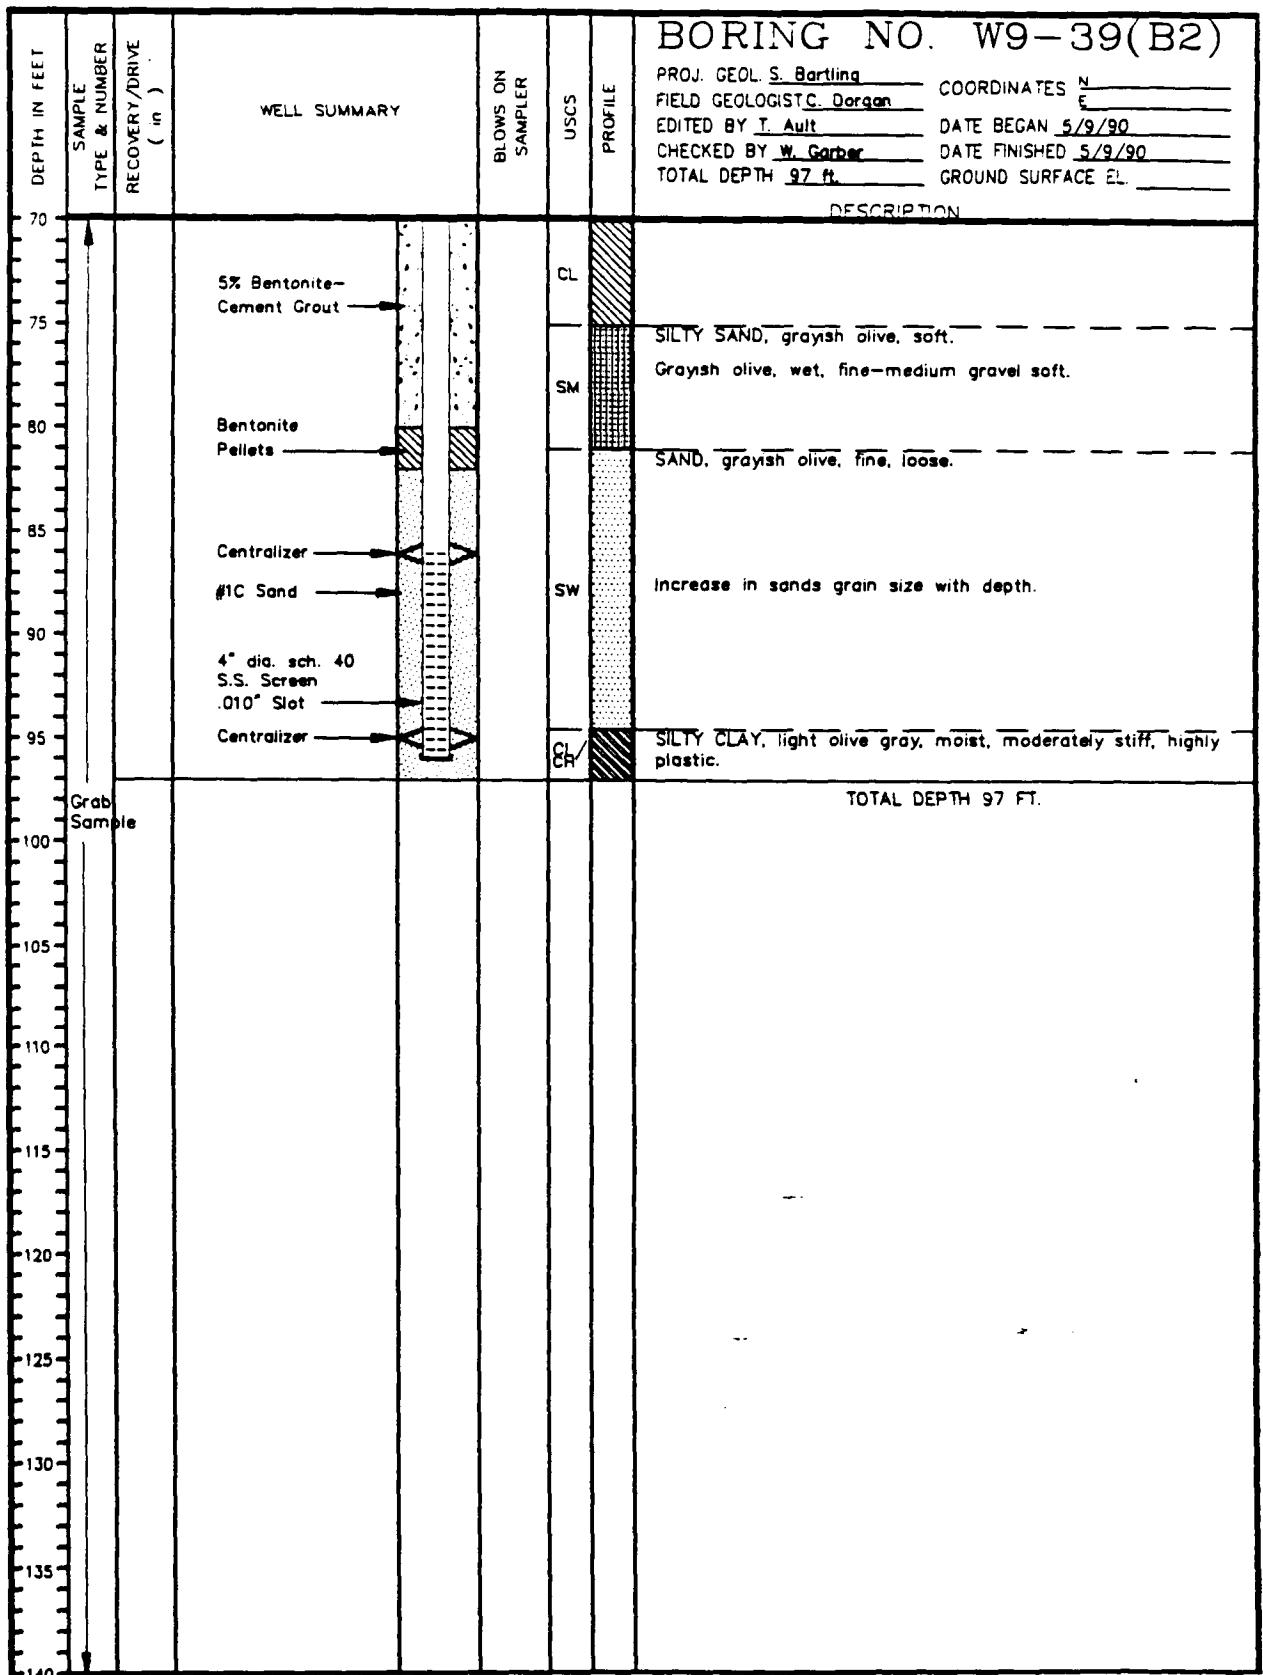

DRILLING CO.: Water Development
 DRILL METHOD: Air Rotary with Drive Casing

PAGE 2 OF 2

PROJECT NO.: 409700
 CLIENT: Moffett Naval Air Station
 LOCATION: Moffett Field, California

SEE LEGEND FOR LOGS AND TEST PITS
 FOR EXPLANATION OF SYMBOLS AND TERMS

MF-W9-39(MF-19)



DRILLING CO.: Water Development
DRILL METHOD: Hollow Stem Auger (Rig CME-55)

PAGE 1 OF 1

PROJECT NO.: 409700
CLIENT: Moffett Naval Air Station
LOCATION: Moffett Field, California

SEE LEGEND FOR LOGS AND TEST PITS
FOR EXPLANATION OF SYMBOLS AND TERMS



**INTERNATIONAL
TECHNOLOGY
CORPORATION**


DEPTH IN FEET	SAMPLE TYPE & NUMBER RECOVERY/DRIVE (in)	WELL SUMMARY	BLOWS ON SAMPLER	USCS	PROFILE	BORING NO. W9-42(A2)	
						PROJ. GEOL. S. Bartling	COORDINATES N E
0						FIELD GEOLOGIST T. Ault	DATE BEGAN 4-25-90
	MD1 18/18	Christy Box	6/8/10	ML		EDITED BY T. Ault	DATE FINISHED 4-25-90
5	MD2 12/18	Top of Casing	6/7/8	ML		CHECKED BY W. Garber	TOTAL DEPTH 41.5 feet GROUND SURFACE EL.
5	MD3 15/18		2/3/5	CL			
10	30/60	4" dia. sch. 40 Steel Casing		ML		CLAYEY SILT: light olive brown, slightly moist, firm to hard.	
10	30/60	12" Borehole dia.		SC		CLAYEY SILT: olive gray, slightly moist, slightly firm, non-plastic.	5.0'
15	39/60	5% Bentonite-Cement Grout		ML		SANDY CLAY: medium bluish gray, very moist, soft, plastic, very fine sand.	6.5'
20	5/80			GW		SILT: moderate yellow brown, fine to very fine sand to 7.5', moist, firm, moderate to non-plastic, brown and gray mottling at intervals, gray at base, firm.	10.0'
25	30/60	Bentonite Pellets		CL		CLAYEY SAND: medium bluish gray, moist to very moist, medium dense, some plasticity near base, very fine sand.	14.0'
30	0/60	#1C Sand		MH		- abundant clay matrix, mottled gray to moderate yellow brown at base.	15.0'
30	0/60	Centralizer		SP		SILT: moderate yellow brown, moist, medium to moderately firm, non-plastic.	15.5'
35	12/60	4" dia. sch. 40 S.S. Screen .010" Slot		SP		SAND: moderate yellow brown, medium grain, very wet, round	
45							
50							
55							
60							
65							
70							
TOTAL DEPTH 41.5 FEET							

DRILLING CO.: Water Developement
DRILL METHOD: Hollow Stem Auger (Rig CME-75)

PAGE 1 OF 1

PROJECT NO.: 409700
CLIENT: Moffett Naval Air Station
LOCATION: Moffett Field, California

SEE LEGEND FOR LOGS AND TEST PITS
FOR EXPLANATION OF SYMBOLS AND TERMS

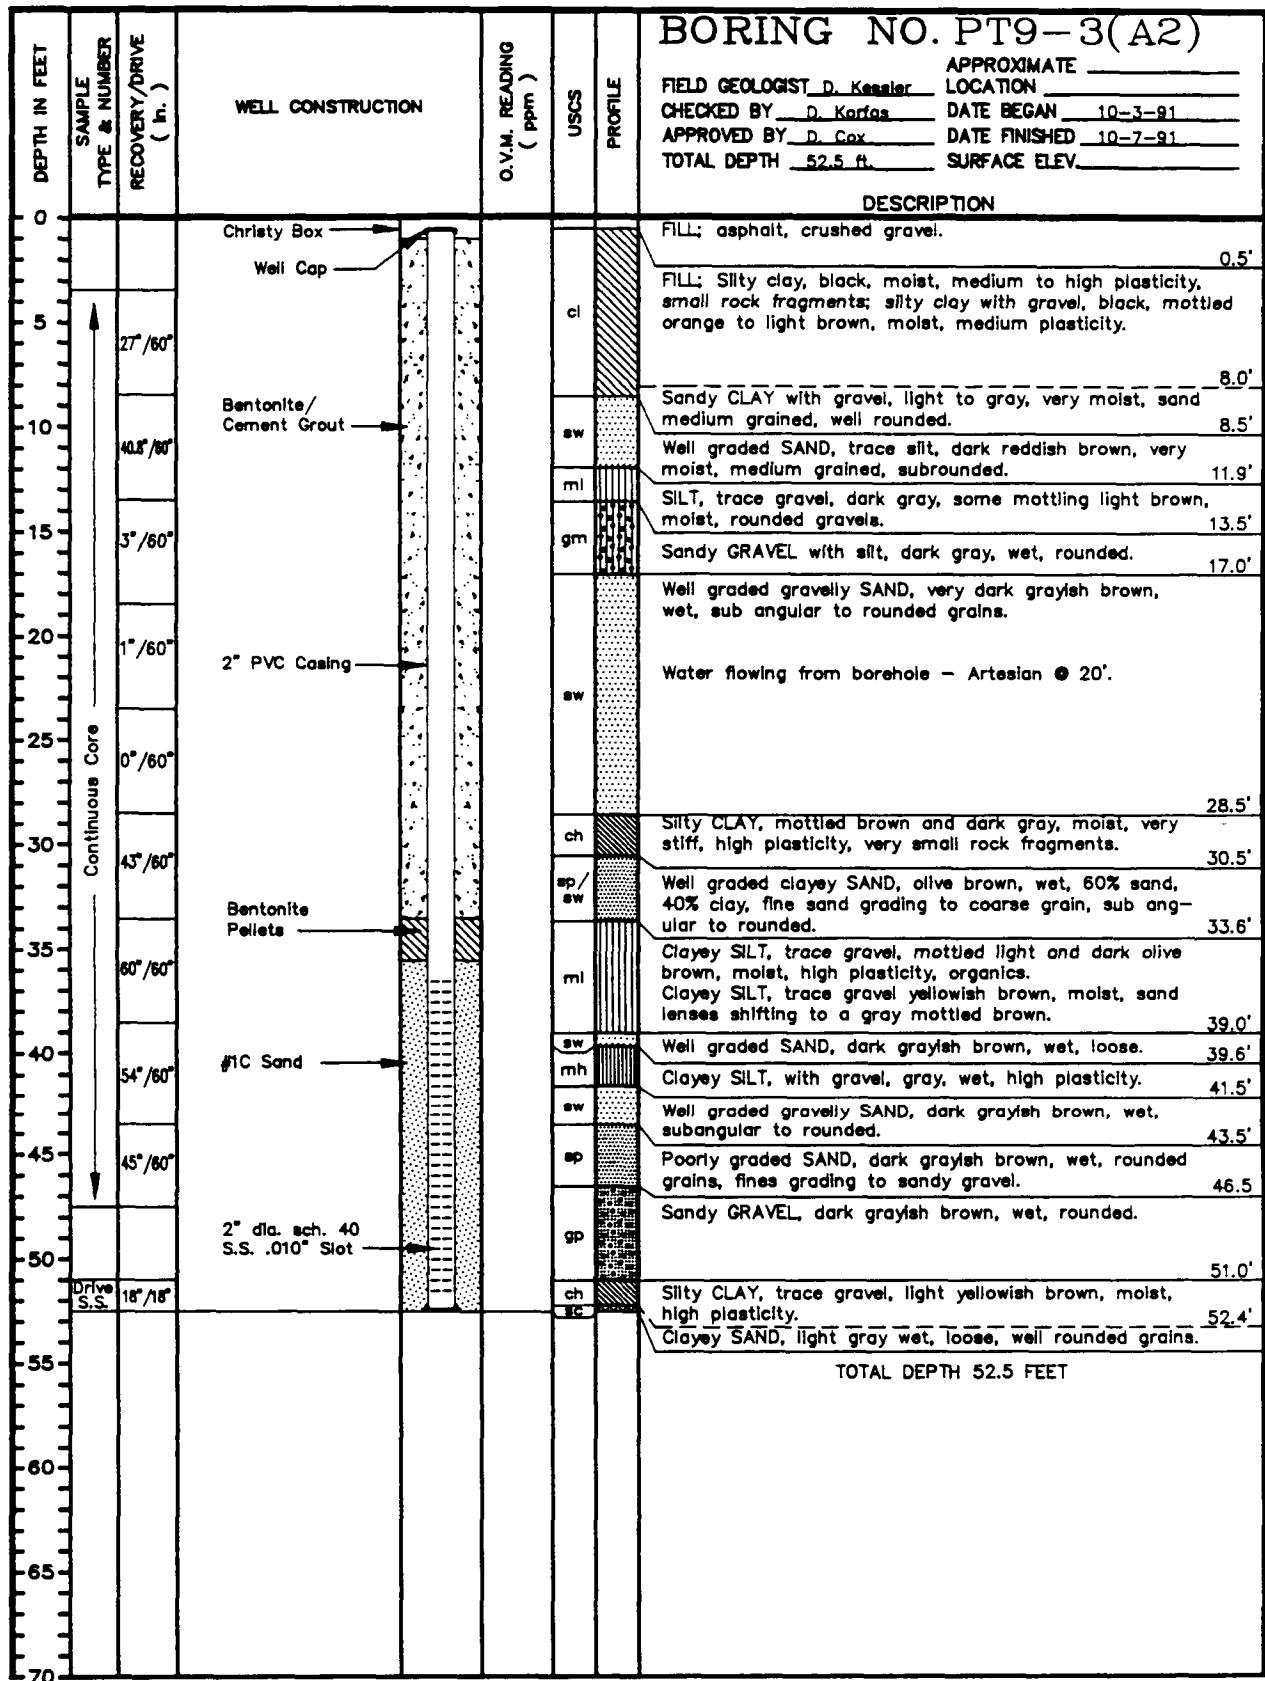

DRILLING CO.: Water Development Corporation

PAGE 1 OF 1

DRILLER: R. Williamson

DRILLING METHOD: Hollow Stem Auger - 8" O.D.

SAMPLING METHOD: See Log

CLIENT: Moffett Naval Air Station

LOCATION: Moffett Field, California

PROJECT NO.: 409729

PT9-3(MF42)

SEE LEGEND FOR LOGS AND
TEST PITS FOR EXPLANATION
OF SYMBOLS AND TERMS



INTERNATIONAL
TECHNOLOGY
CORPORATION

N00296.001452
MOFFETT FIELD
SSIC NO. 5090.3

APPENDIX C – BORING LOGS GEOPHYSICAL LOGS

SITE 9 – WELLS (CLEAN)

REMEDIAL INVESTIGATION REPORT
OPERABLE UNIT 4: WEST SIDE AQUIFERS

DATED 01 AUGUST 1992

WELL COMPLETION
DETAIL

BORING LOG DETAIL

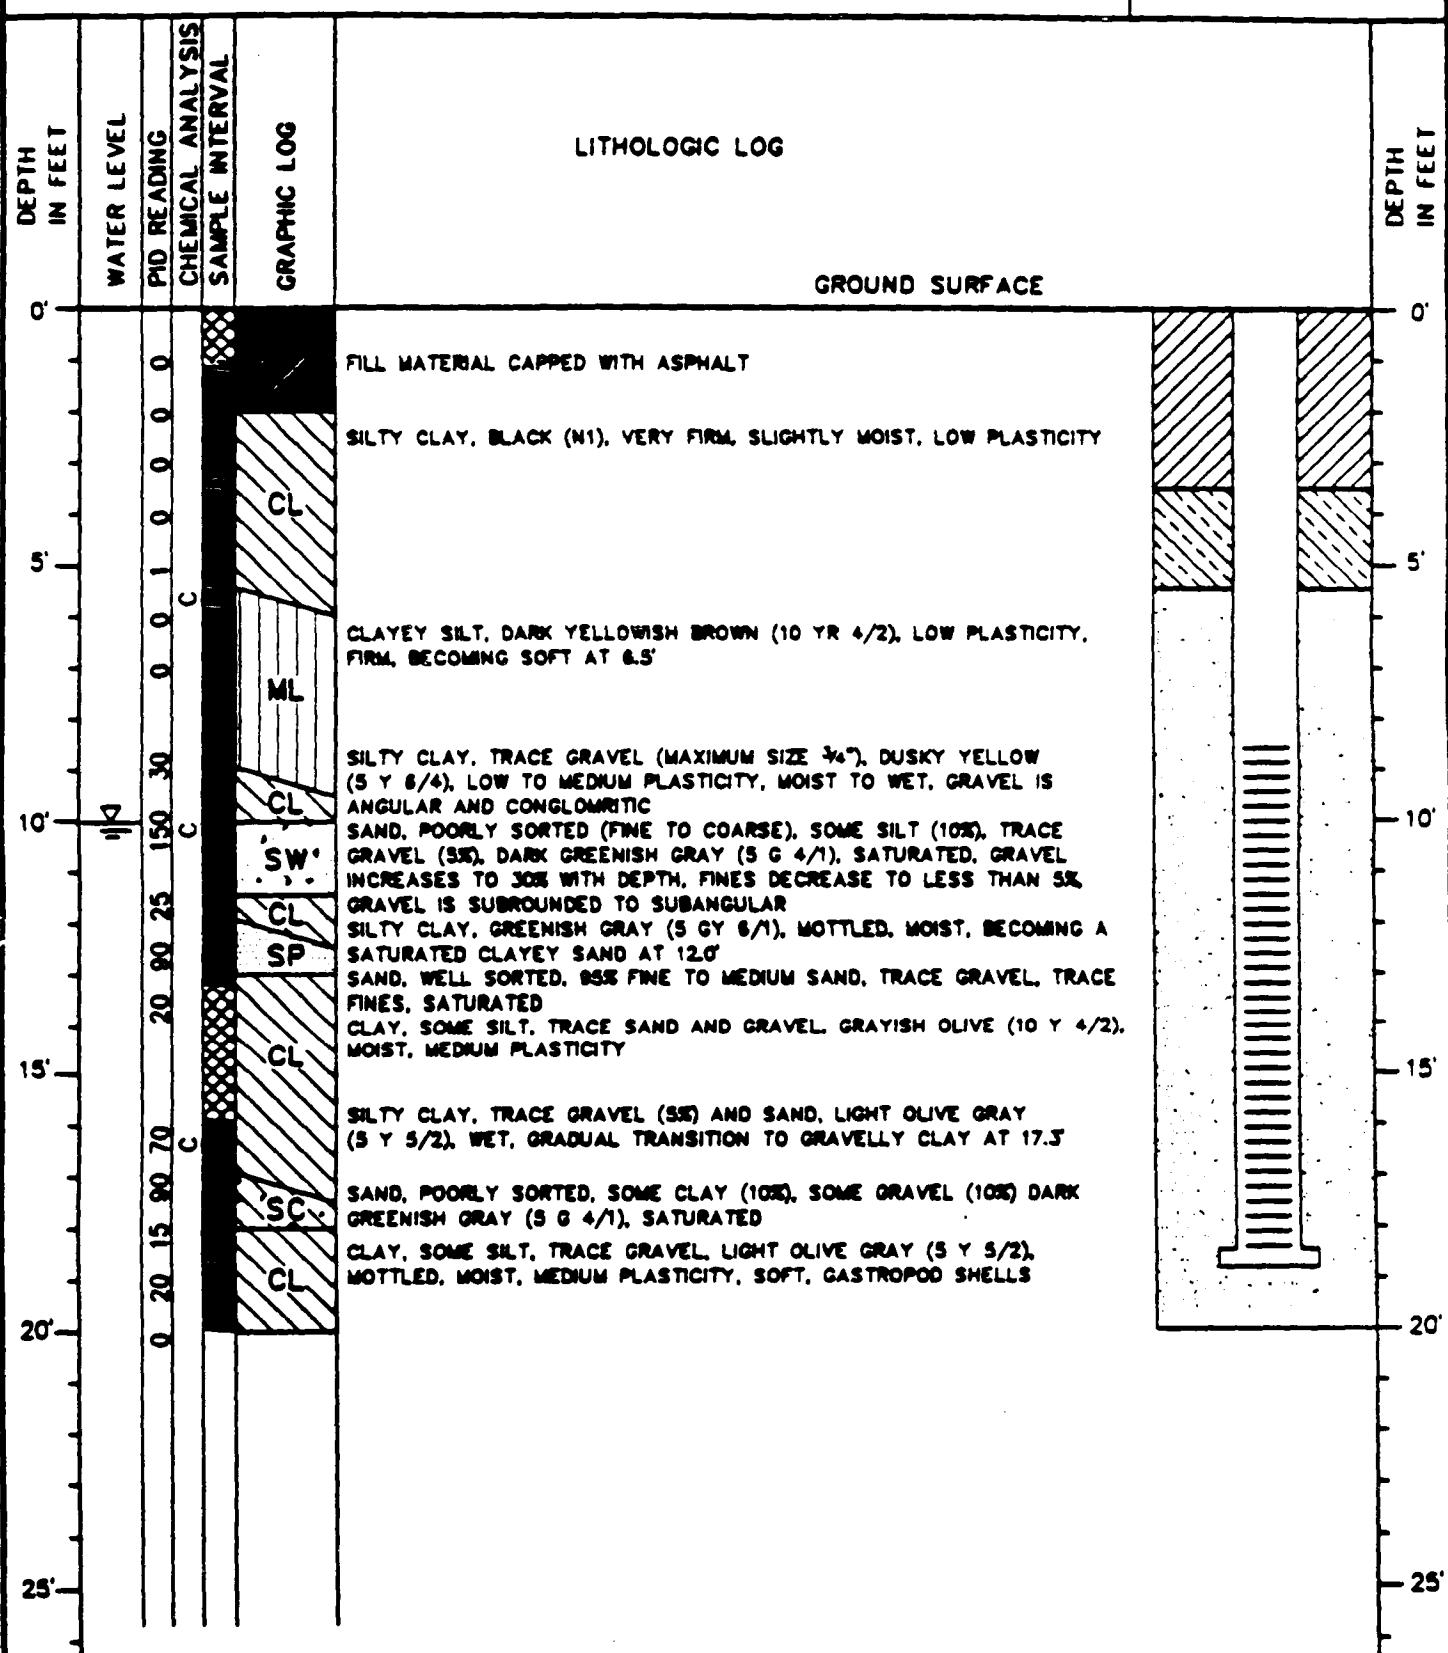


FIGURE D-1
NAS MOFFETT FIELD BUILDING 29 AREA
W29-1(A)

SCALE: AS SHOWN

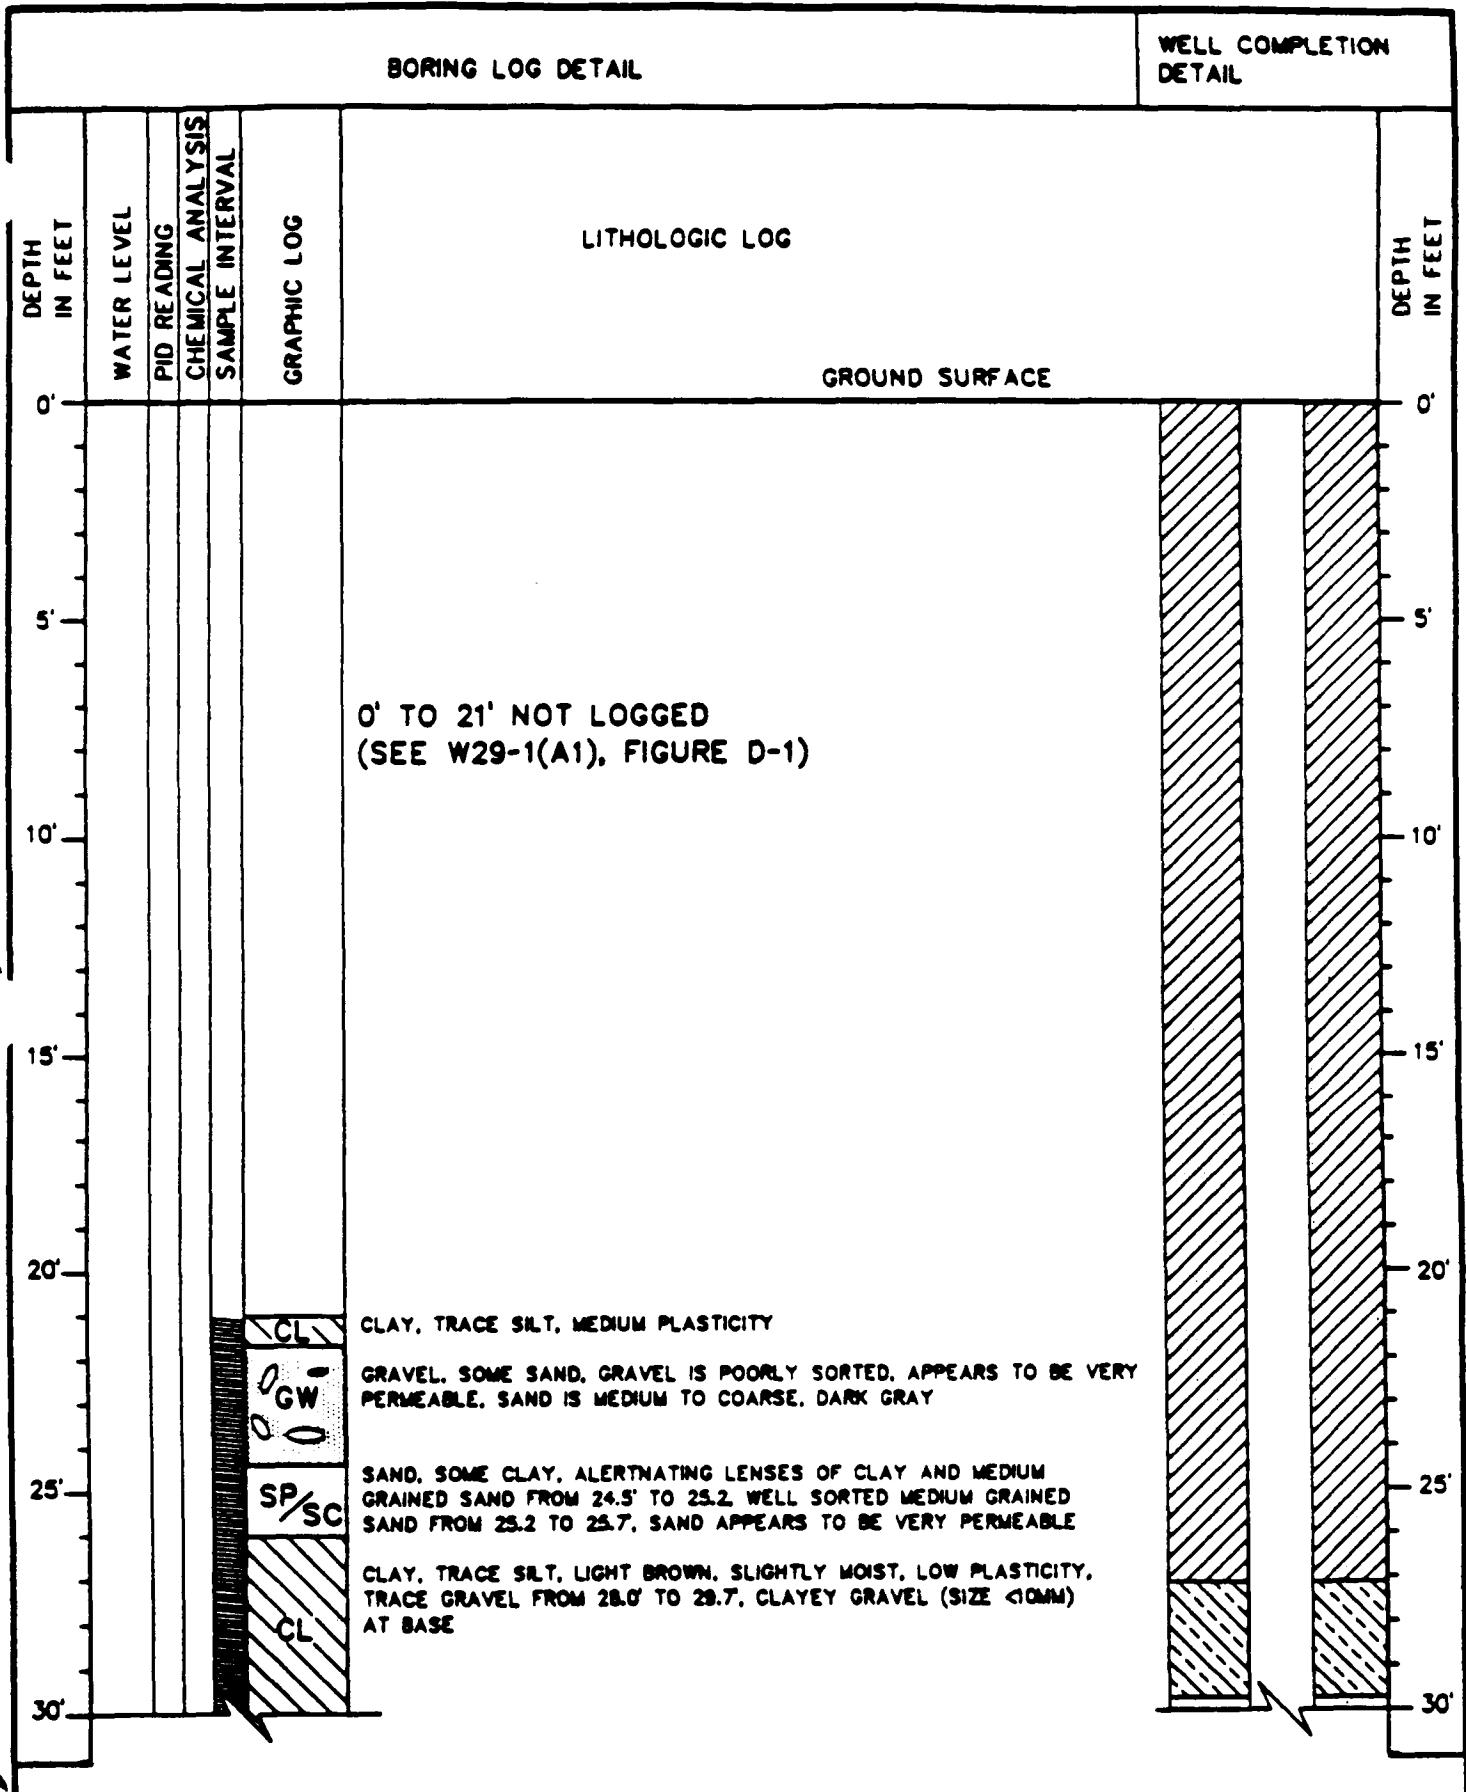


FIGURE D-7
NAS MOFFETT FIELD BUILDING 29 AREA
W29-7(A2)

SCALE: AS SHOWN

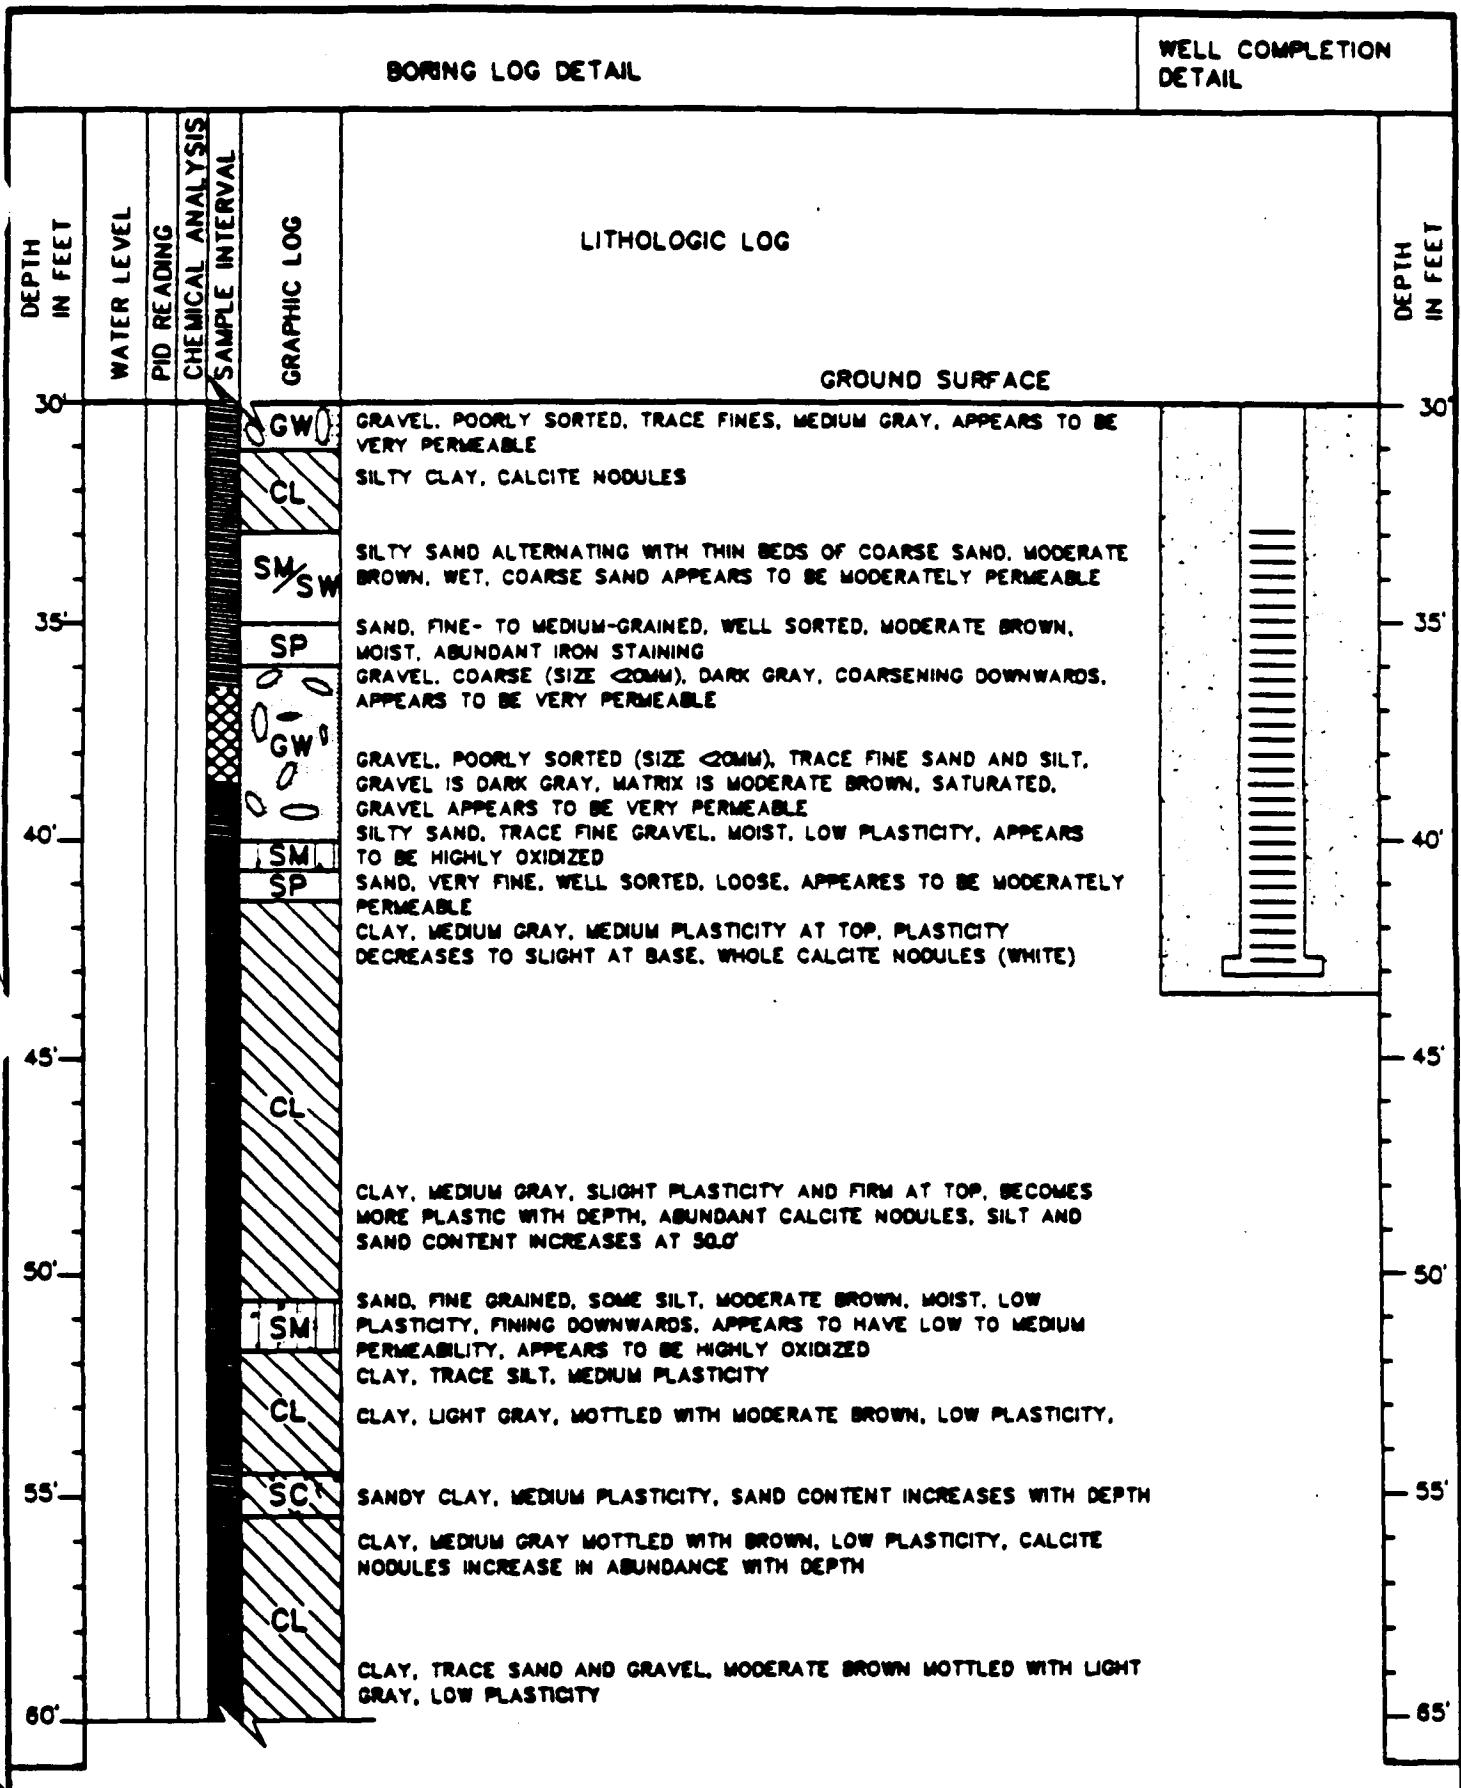


FIGURE D-7 (CONT.)
NAS MOFFETT FIELD BUILDING 29 AREA
W29-7(A2)

SCALE: AS SHOWN

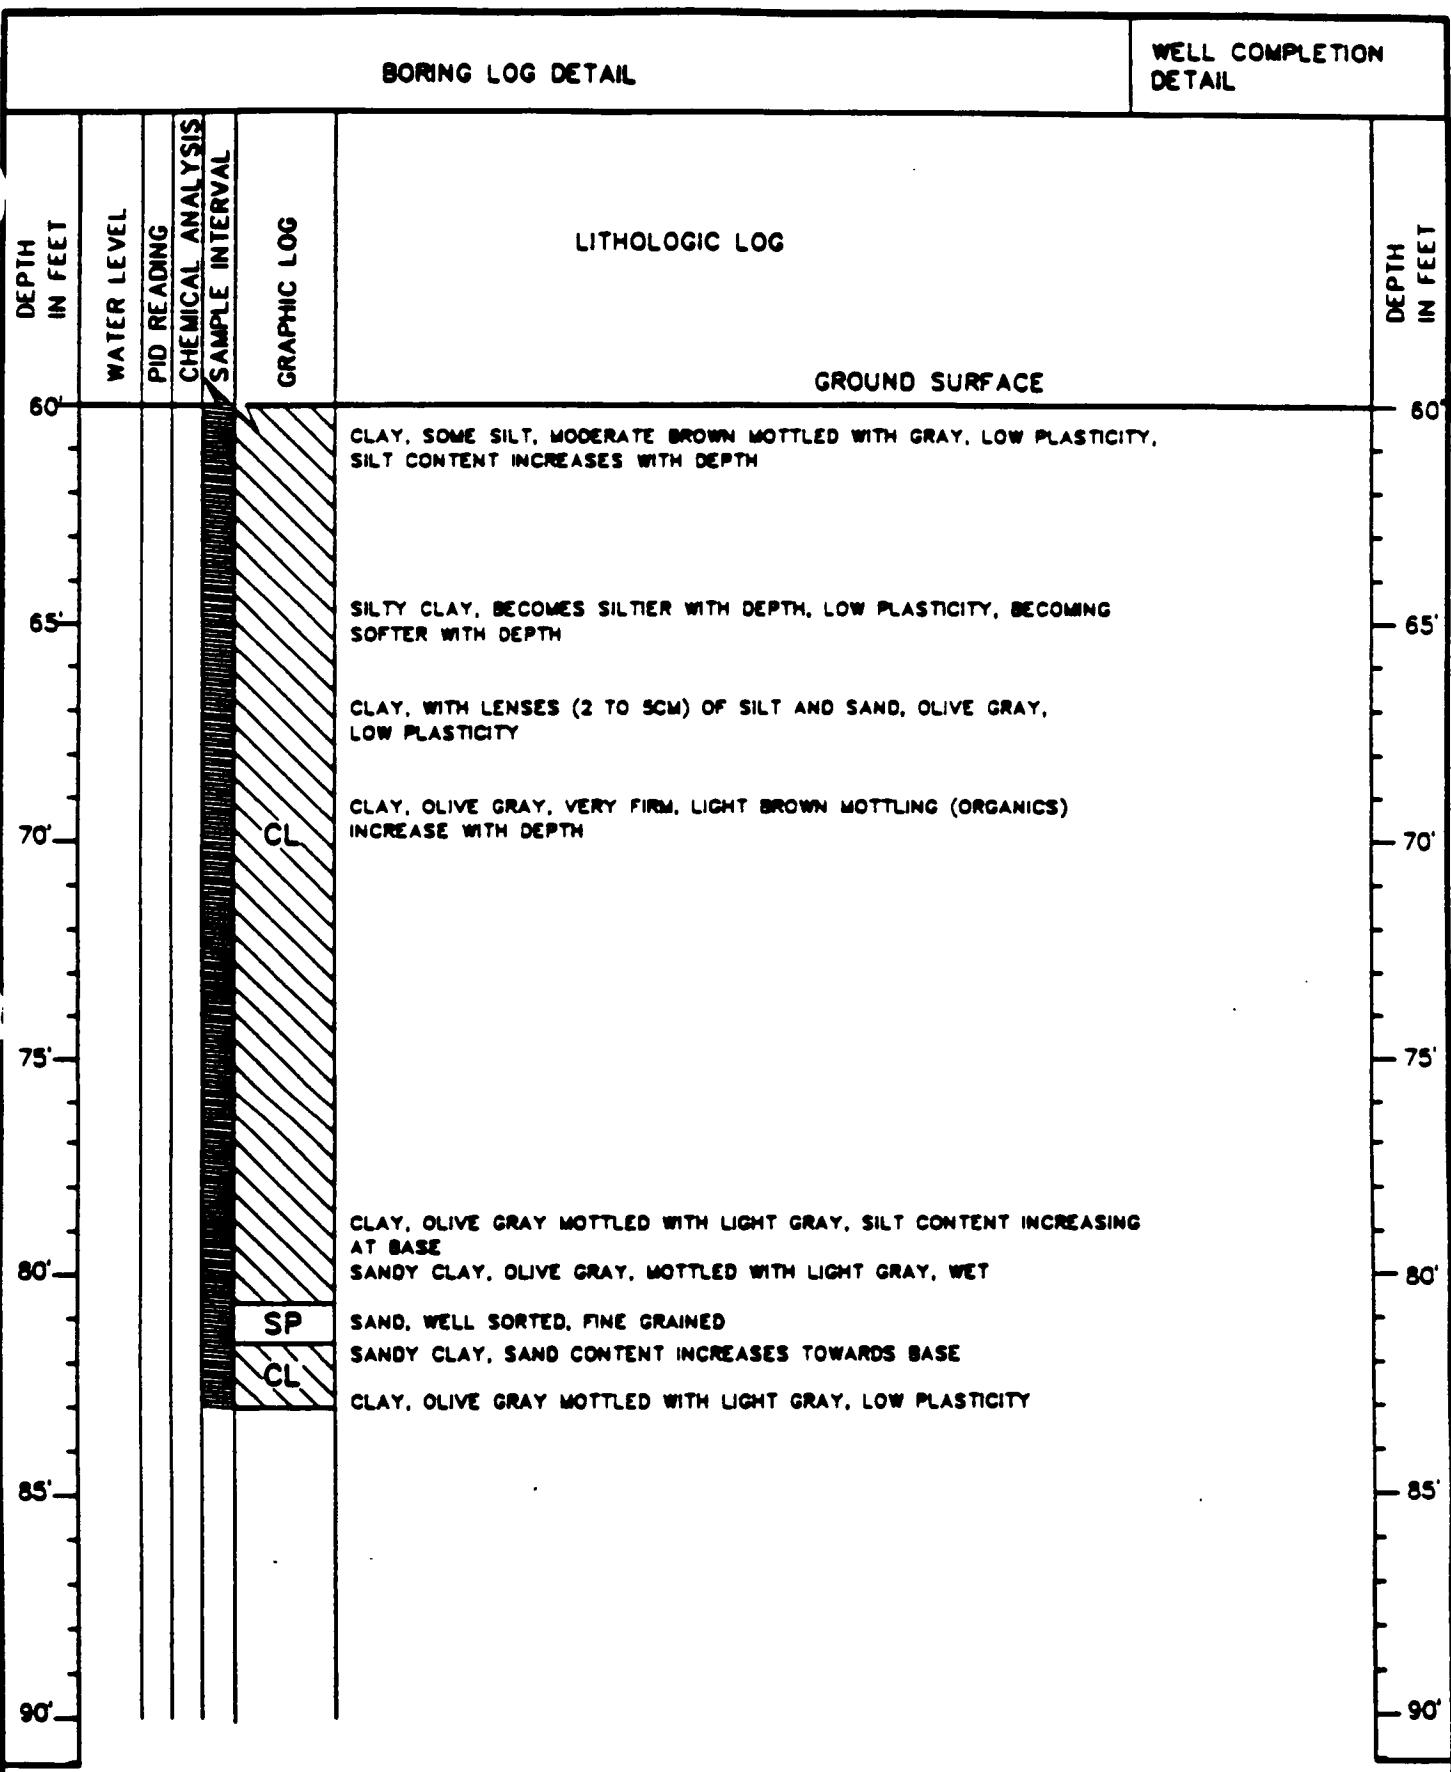


FIGURE D-7 (CONT.)
NAS MOFFETT FIELD BUILDING 29 AREA
W29-7(A2)

SCALE: AS SHOWN

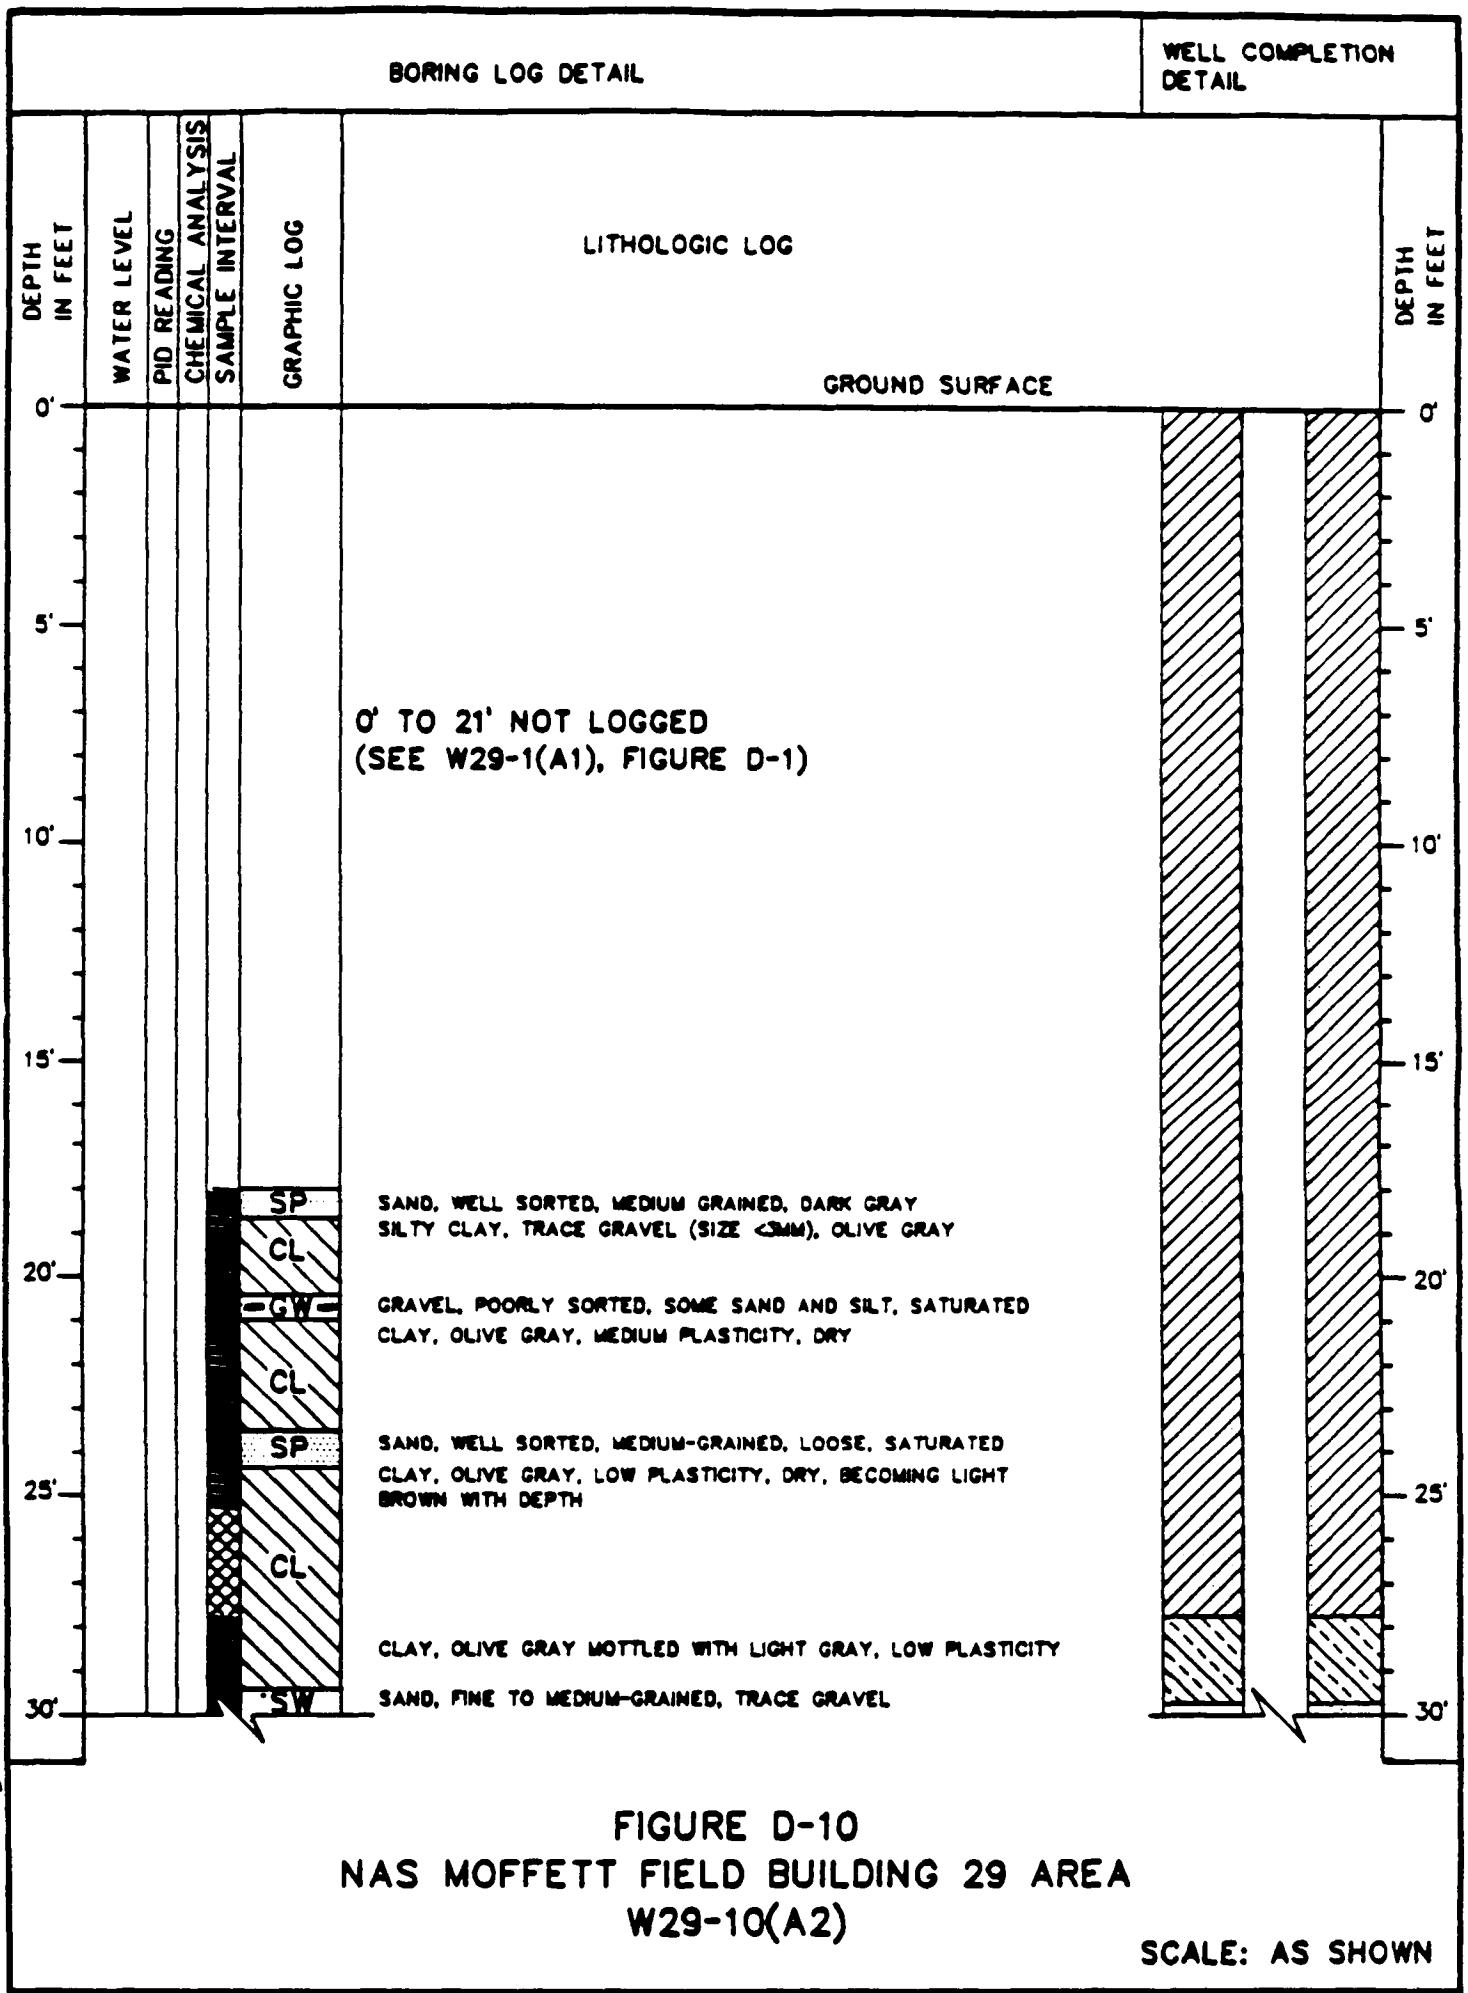


FIGURE D-10
NAS MOFFETT FIELD BUILDING 29 AREA
W29-10(A2)

BORING LOG DETAIL

WELL COMPLETION DETAIL

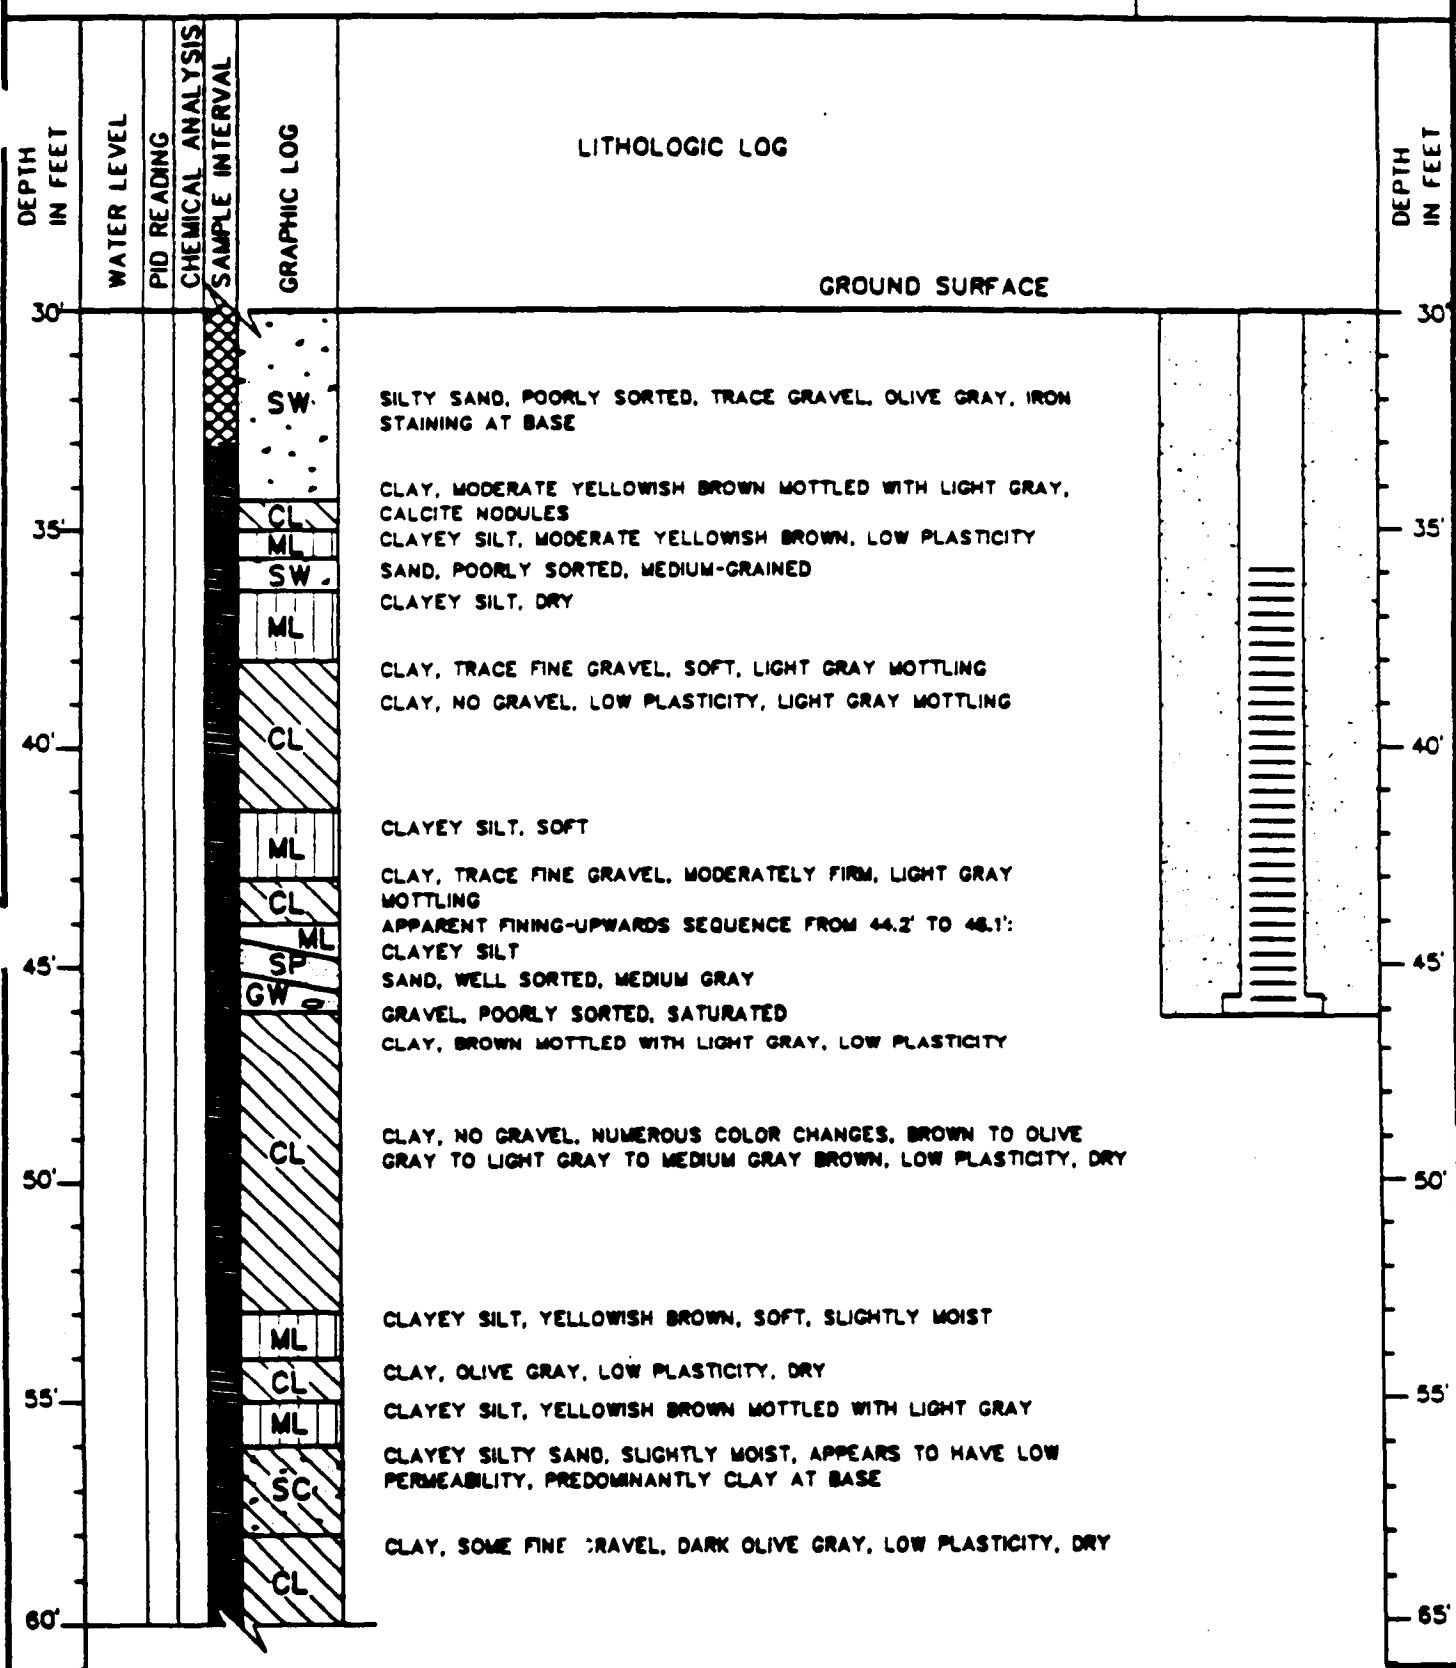


FIGURE D-10 (CONT.)
NAS MOFFETT FIELD BUILDING 29 AREA
W29-10(A2)

SCALE: AS SHOWN

BORING LOG DETAIL

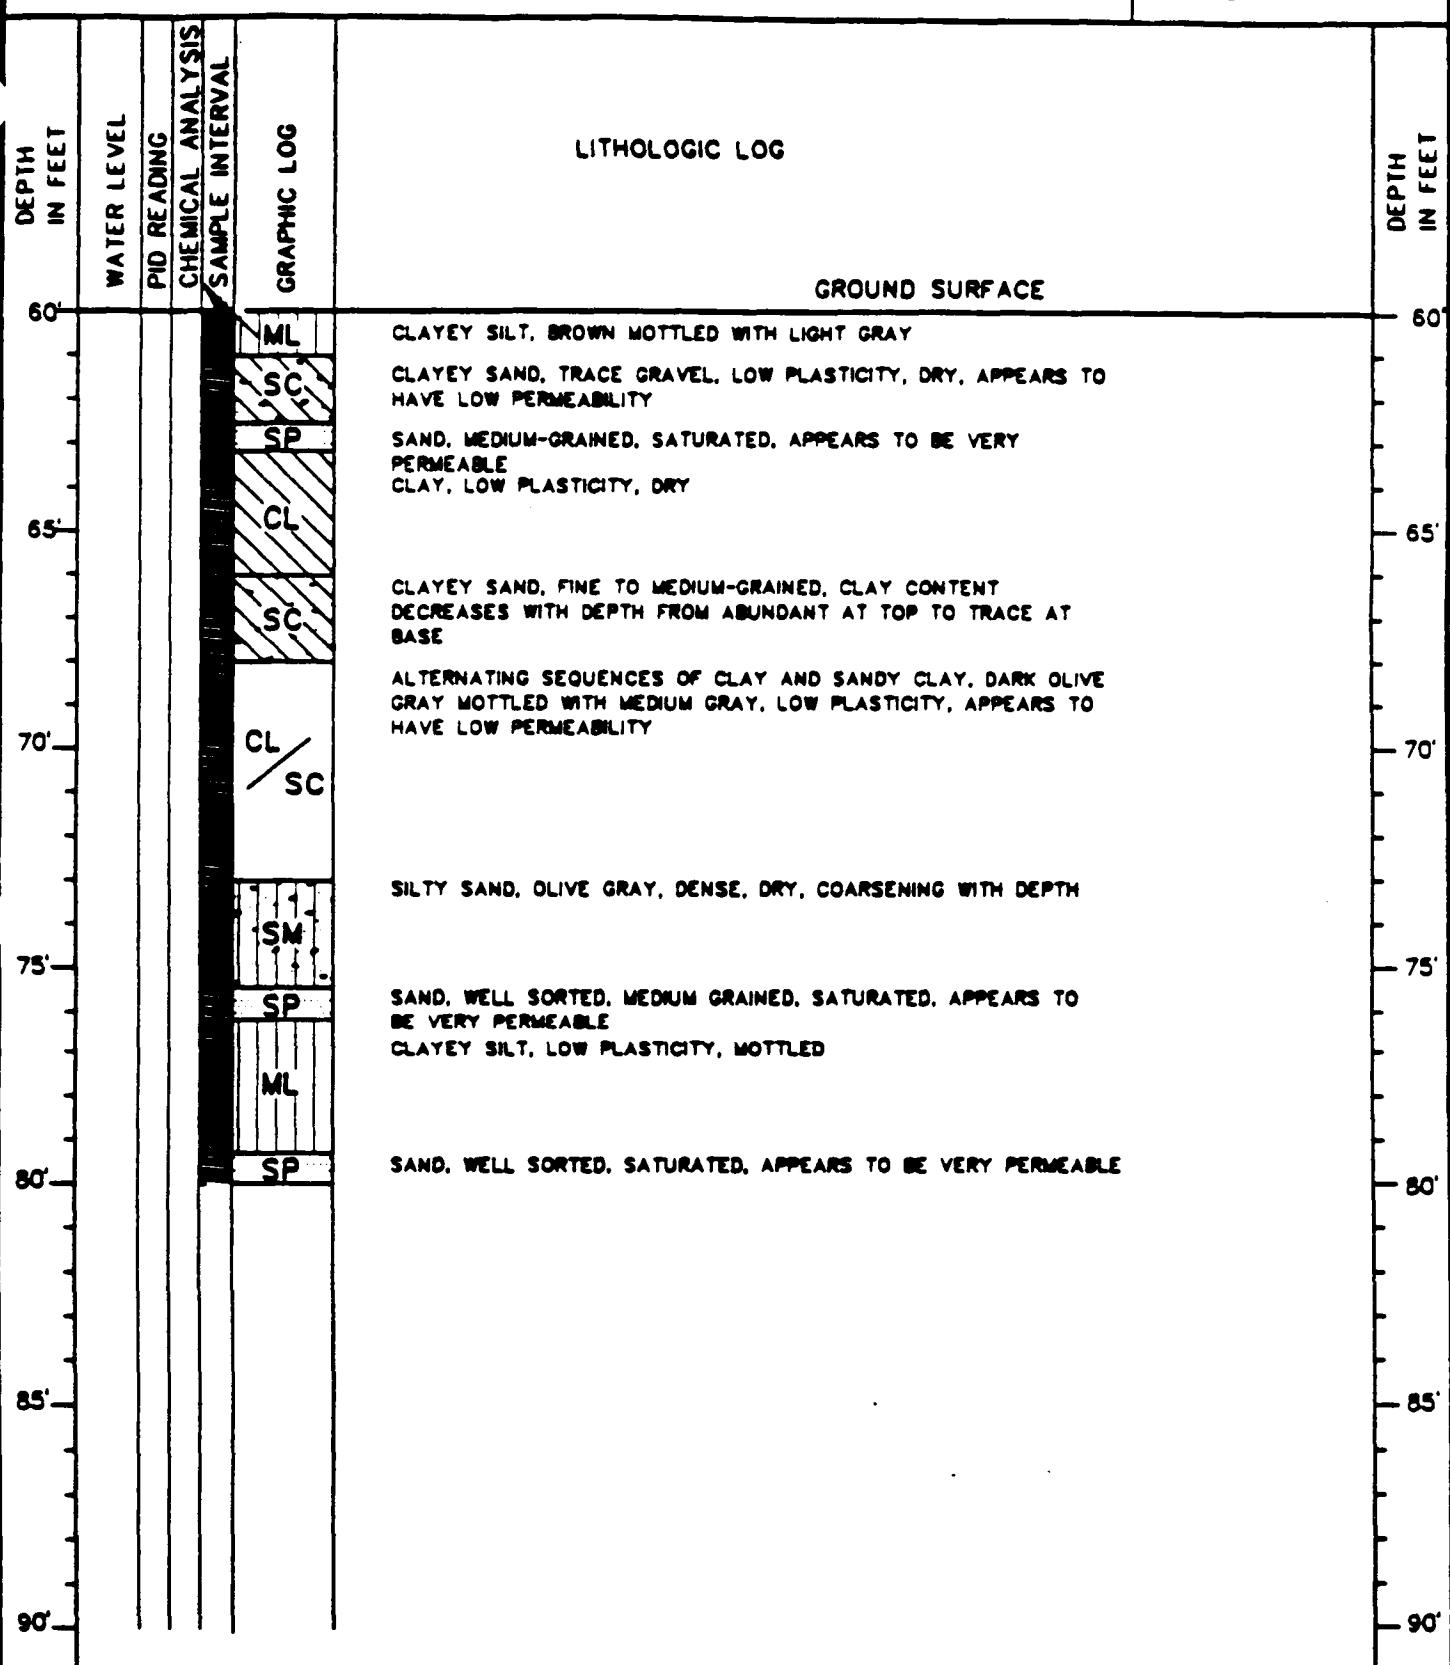
WELL COMPLETION
DETAIL

FIGURE D-10 (CONT.)
NAS MOFFETT FIELD BUILDING 29 AREA
W29-10(A2)

SCALE: AS SHOWN


JAMES M. MONTGOMERY
CONSULTING ENGINEERS, INC.

365 LENNON LANE, WALNUT CREEK, CALIFORNIA, 94598 / (415) 975-3400

PAGE 1 OF 2

BORING/WELL NUMBER WB9-1 (A)
DATE STARTED 11/07/90 COMPLETED 11/09/90
ELEVATION 37.32 FEET, Top of Box

CLIENT US NAVY
PROJECT NAS MOFFETT FIELD IS 8 and 9
GEOLOGIST CHRIS PETERSEN

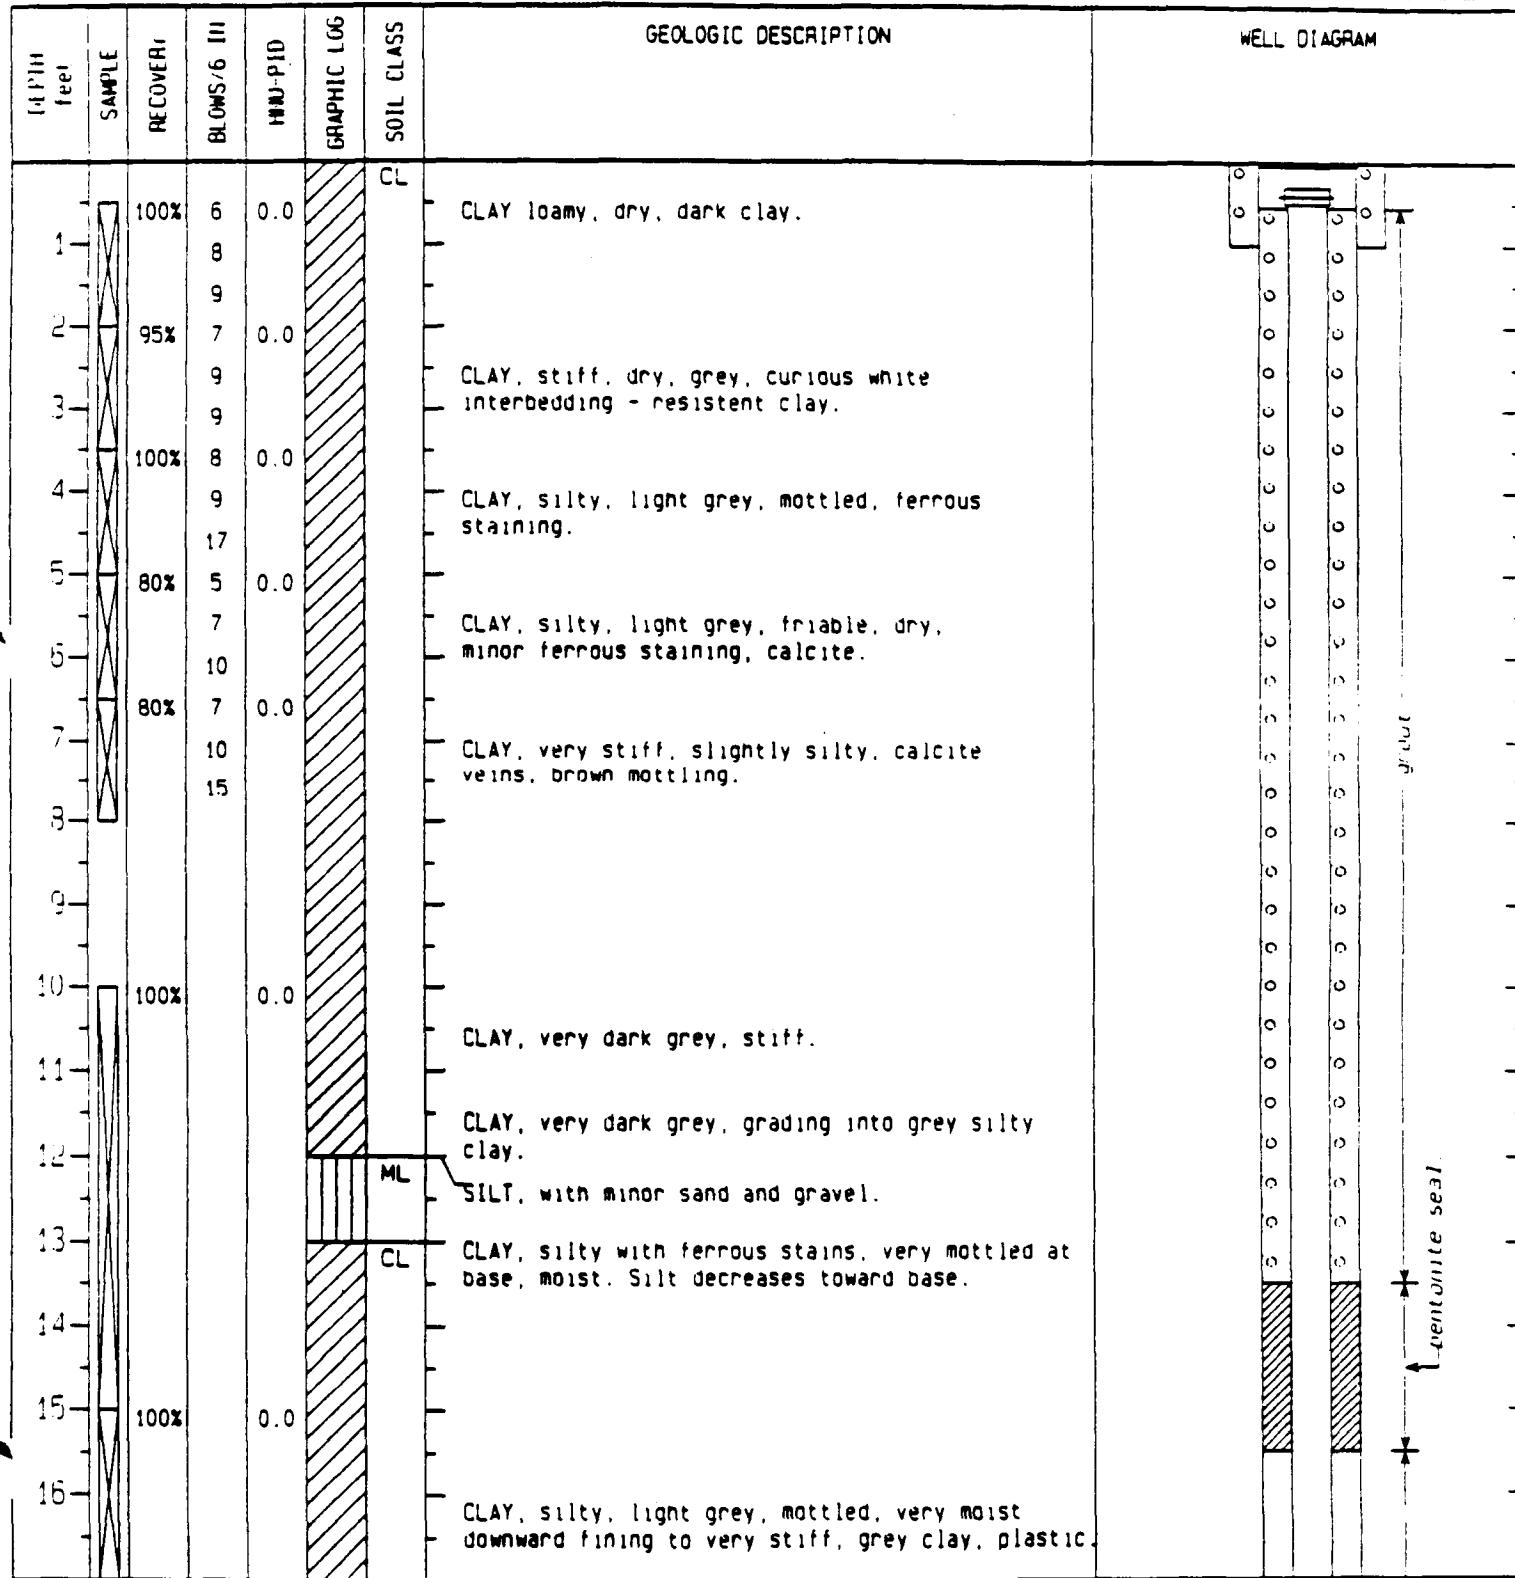

METHOD OF DRILLING HOLLOW STEM AUGER
HOLE DIAMETER 12 INCHES
TOTAL DEPTH 30 FEET

WELL COMPLETION DEPTH 29.8 FEET
WELL DIAMETER 4 INCHES
WELL MATERIAL LOW CARBON STEEL/STAINLESS STEEL

JAMES M. MONTGOMERY
CONSULTING ENGINEERS, INC.

365 LENNON LANE, WALNUT CREEK, CALIFORNIA, 94598 / (415) 975-3400

PAGE 2 OF 1

BORING/WELL NUMBER W89-1 (A)
DATE STARTED 11/07/90 COMPLETED 11/09/90
ELEVATION 37.32 FEET, Top of Box

CLIENT US NAVY
PROJECT NAS MOFFETT FIELD IS A and B
GEOLOGIST CHRIS PETERSEN

DEPTH feet	SAMPLE	HEAVY WEIGHT BLWS/6 IN	HARD-PID	GRAPHIC LOG	SOIL CLASS	GEOLOGIC DESCRIPTION		WELL DIAGRAM
18					CL	CLAY, grey, stiff, coarsening downward to light brown silt.		
19					ML	SILT, sandy, dark brown, moist - not saturated, friable.		
20	100%		0.0			SILT, sandy, dark brown, very moist, friable.		
21						Abrupt change from sandy SILT to silty CLAY, fining downward to very dark grey clay with minor gravel.		
22					CL			
23					GC			
24								
25	20%		0.0			Sample is a slurry of sandy gravel fining upward to a silty clay. The bottom 4 feet of sand and gravel (?) washed out.		
26								
27								
28								
29								
30								
31								
32								
33								

JAMES M. MONTGOMERY
CONSULTING ENGINEERS, INC.

365 LENNON LANE, WALNUT CREEK, CALIFORNIA, 94598 / (415) 975-3400

PAGE 1 OF 2

BORING/WELL NUMBER WB9-2 (A)


CLIENT US NAVY

DATE STARTED 11/08/90 COMPLETED 11/08/90

PROJECT NAS MOFFETT FIELD IS 3 and 9

ELEVATION 34.96 FEET, Top of Box

GEOLOGIST CHRIS PETERSEN

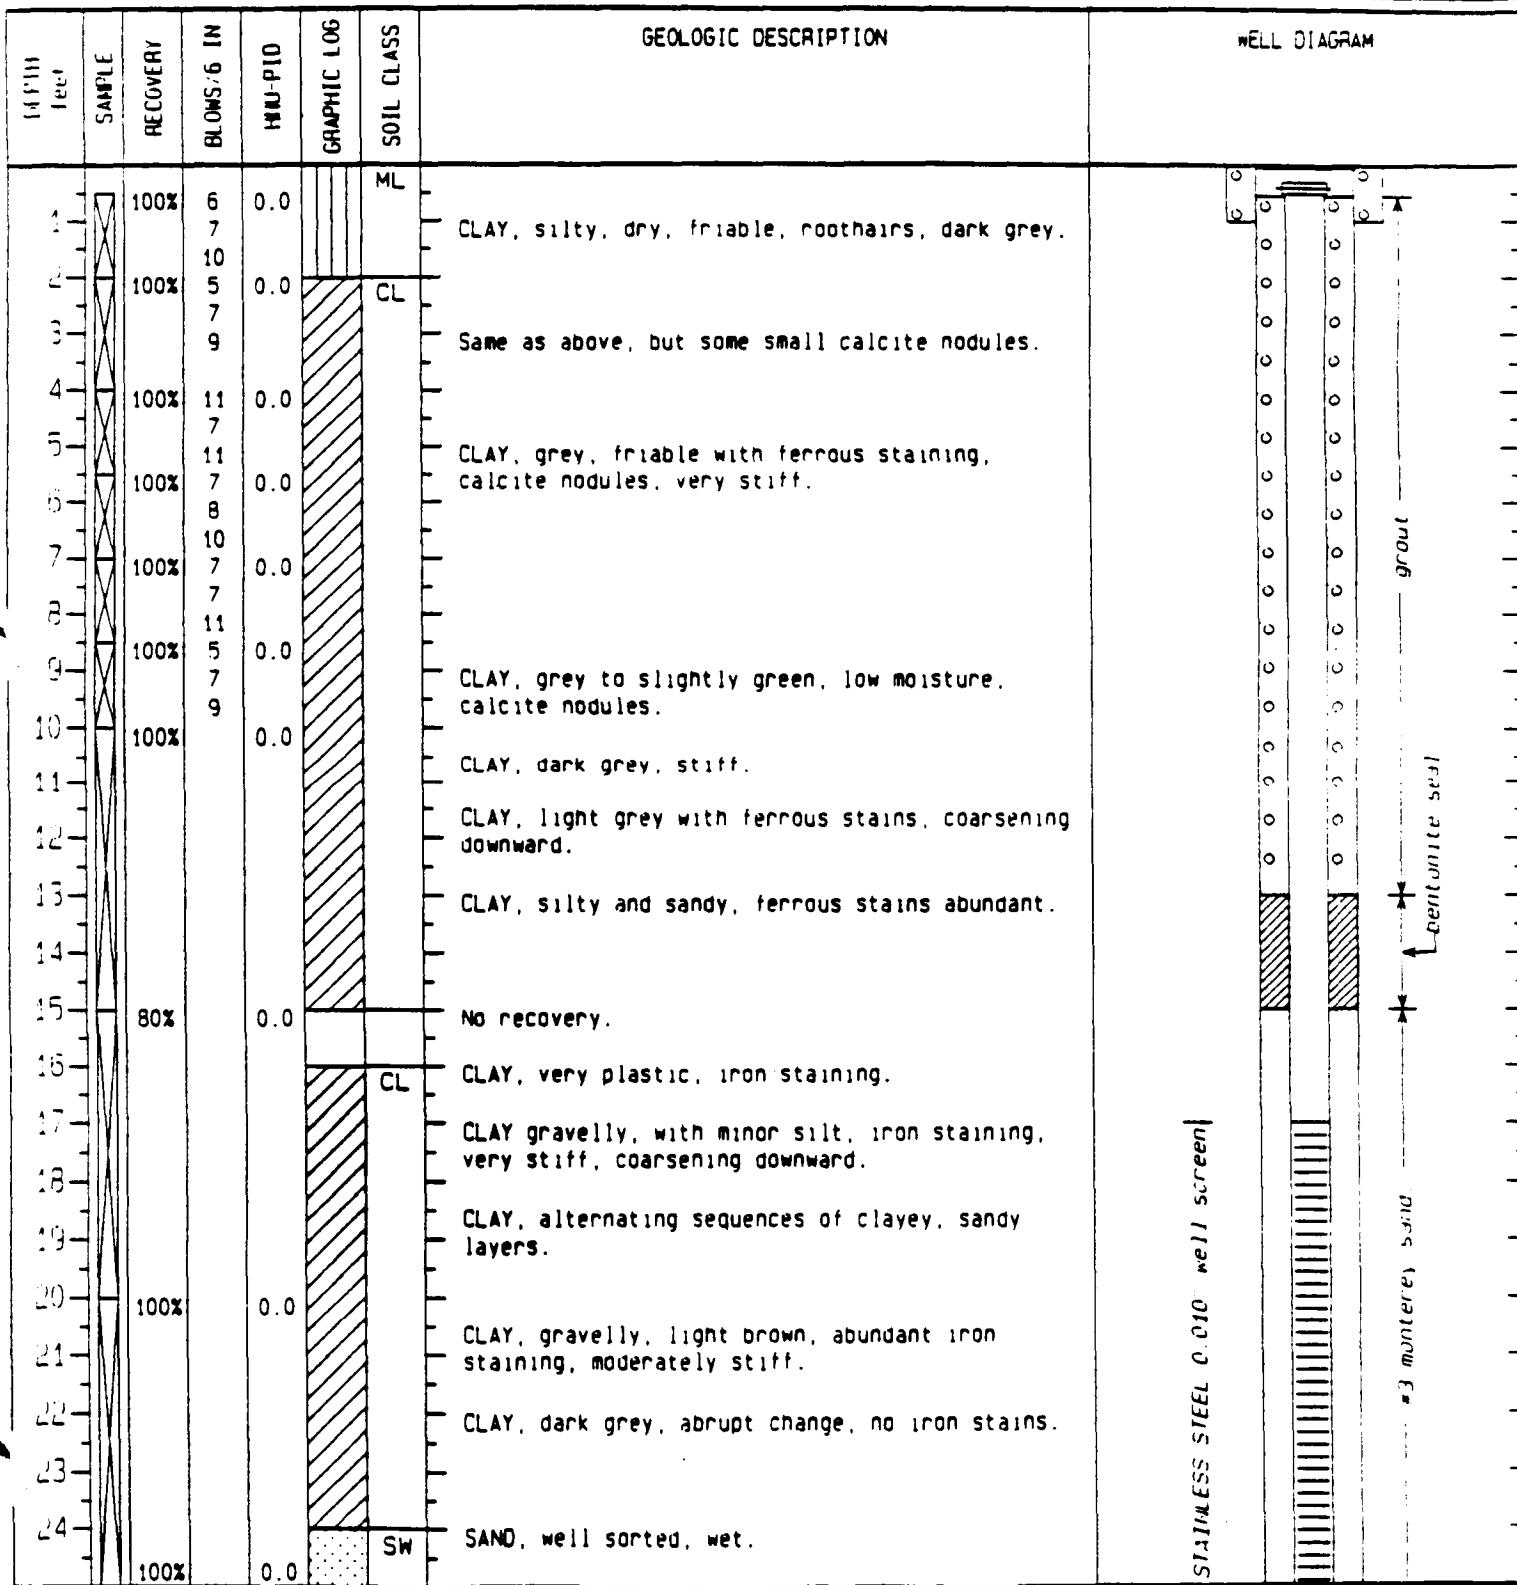

METHOD OF DRILLING HOLLOW STEM AUGER

WELL COMPLETION DEPTH 30 FEET

HOLE DIAMETER 12 INCHES

WELL DIAMETER 4 INCHES

TOTAL DEPTH 30 FEET

WELL MATERIAL LOW CARBON STEEL/STAINLESS STEEL

JAMES M. MONTGOMERY
CONSULTING ENGINEERS, INC.

365 LENNON LANE, WALNUT CREEK, CALIFORNIA, 94598 / (415) 975-3400

PAGE 2 OF

BORING/WELL NUMBER W89-2 (A)
DATE STARTED 11/08/90 COMPLETED 11/08/90
ELEVATION 34' 96 FEET, Top of Box

CLIENT US NAVY
PROJECT NAS MOFFETT FIELD IS 3 and 3
GEOLOGIST CHRIS PETERSEN

DEPTH feet	SAMPLE	ACQWT Ht	BLDG#6 III	MIN-PID	GRAPHIC LOG	SOIL CLASS	GEOLOGIC DESCRIPTION		WELL DIAGRAM
							SW	CL	
29	60%			0.0			CLAY, grey, well graded sequence from grey clay to silts, gravelly, clay mix, dark greyish green.		
30						GP	GRAVEL, sandy, poorly sorted, very wet, brown gravels up to quarter inch in size.		
31							No sample recovery.		
32									
33									
JAMES M. MONTGOMERY
CONSULTING ENGINEERS, INC.

365 LENNON LANE, WALNUT CREEK, CALIFORNIA, 94598 / (415) 975-3400

PAGE 1 OF 1

BORING/WELL NUMBER TH89-1/W89-11(B1)
DATE STARTED 11/14/90 COMPLETED 12/7/90
ELEVATION 37 44 FEET, Top of Box

CLIENT US NAVY
PROJECT NAS MOFFETT FIELD IS B and 9
GEOLOGIST CRAIG STEVENS

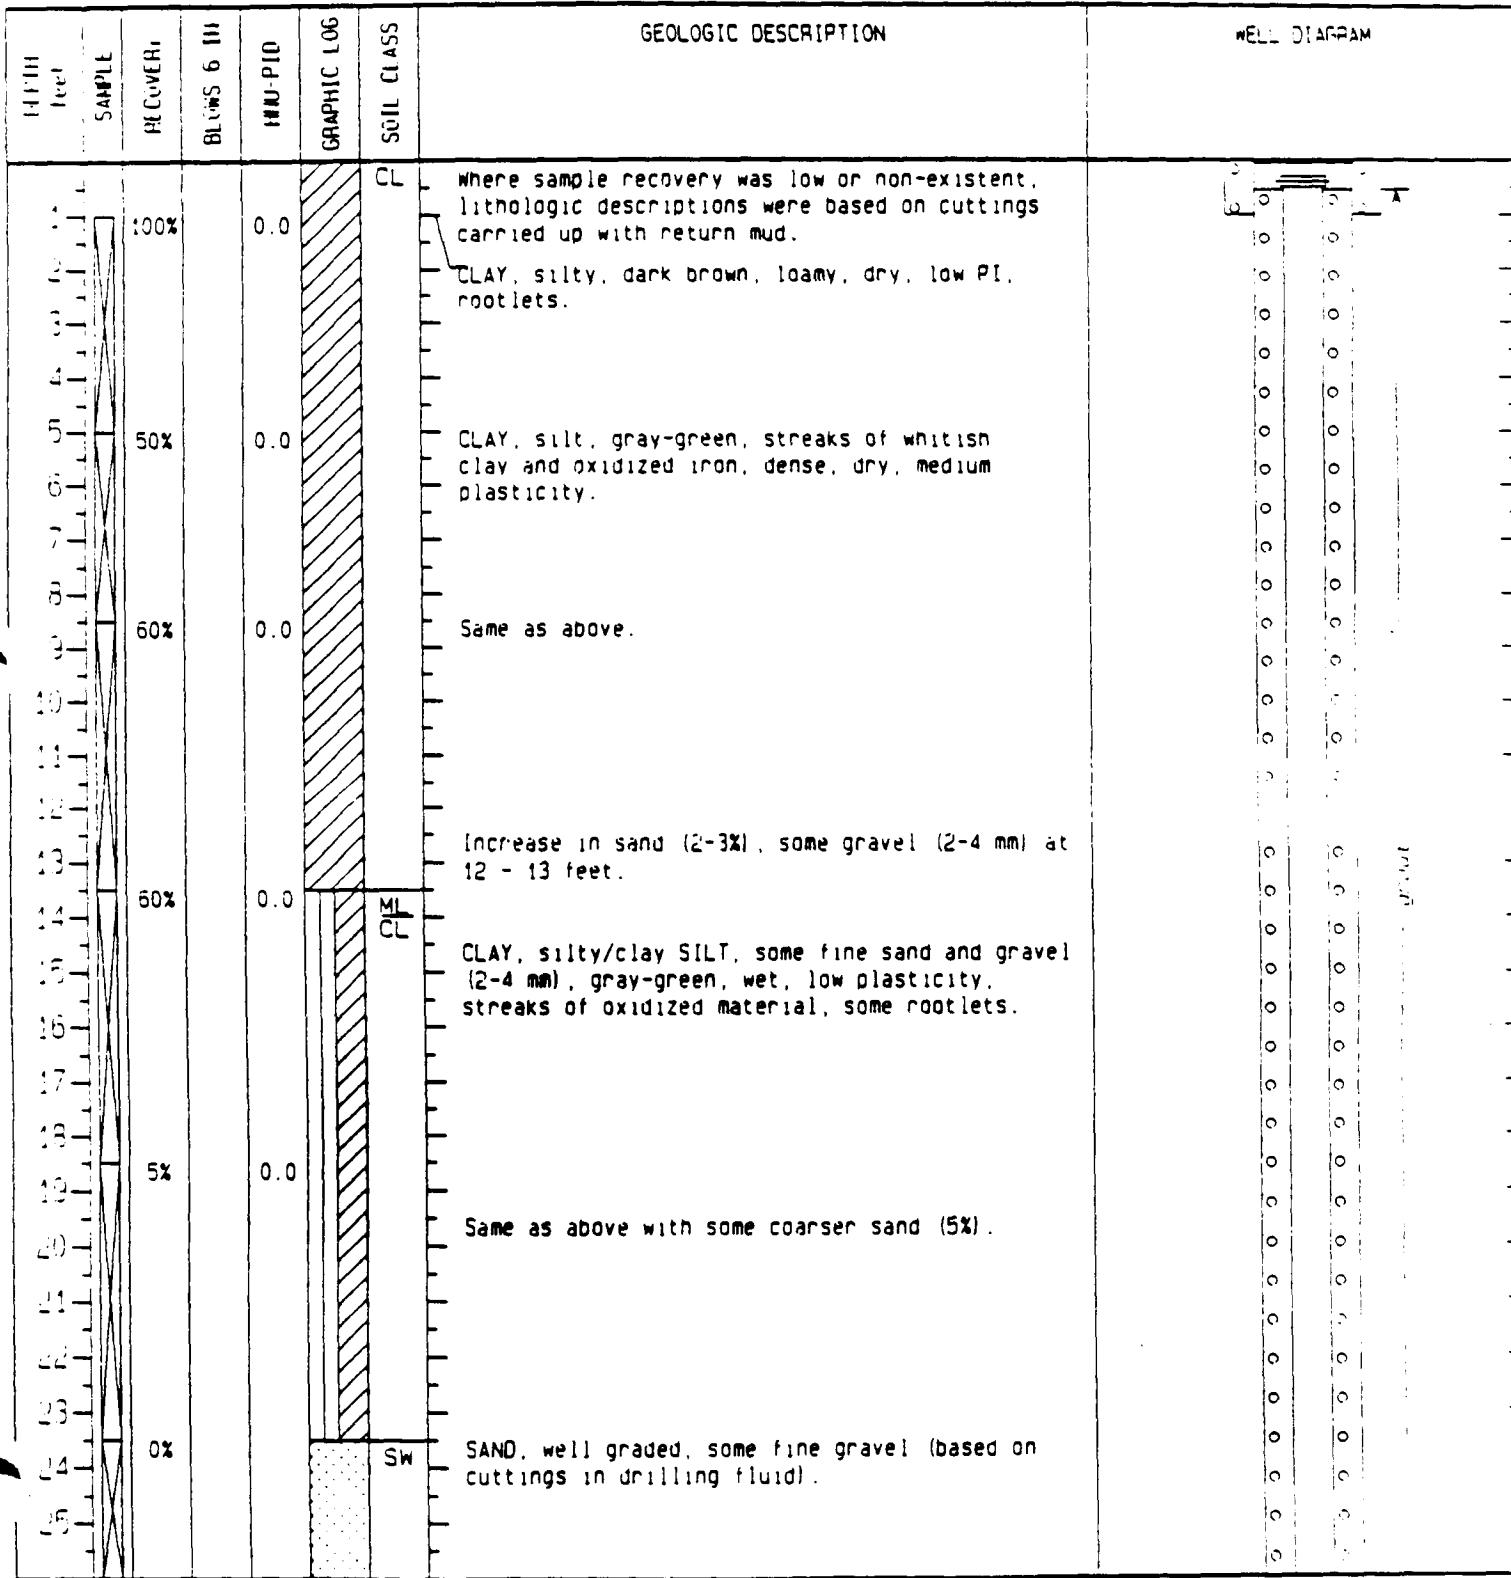

METHOD OF DRILLING MUD ROTARY
HOLE DIAMETER 10 INCHES
TOTAL DEPTH 103 FEET

WELL COMPLETION DEPTH 62 FEET
WELL DIAMETER 4 INCHES
WELL MATERIAL LOW CARBON STEEL/STAINLESS STEEL


JAMES M. MONTGOMERY
CONSULTING ENGINEERS, INC.

365 LENNON LANE, WALNUT CREEK, CALIFORNIA 94598 / (415) 975-3400

PAGE 1 OF 1

BORING/WELL NUMBER TH89-1/W89-11(B1)
DATE STARTED 11/14/90 COMPLETED 12/7/90
ELEVATION 37 44 FEET, Top of Box

CLIENT US NAVY
PROJECT NAS MOFFETT FIELD IS B and E
GEOLOGIST CRAIG STEVENS

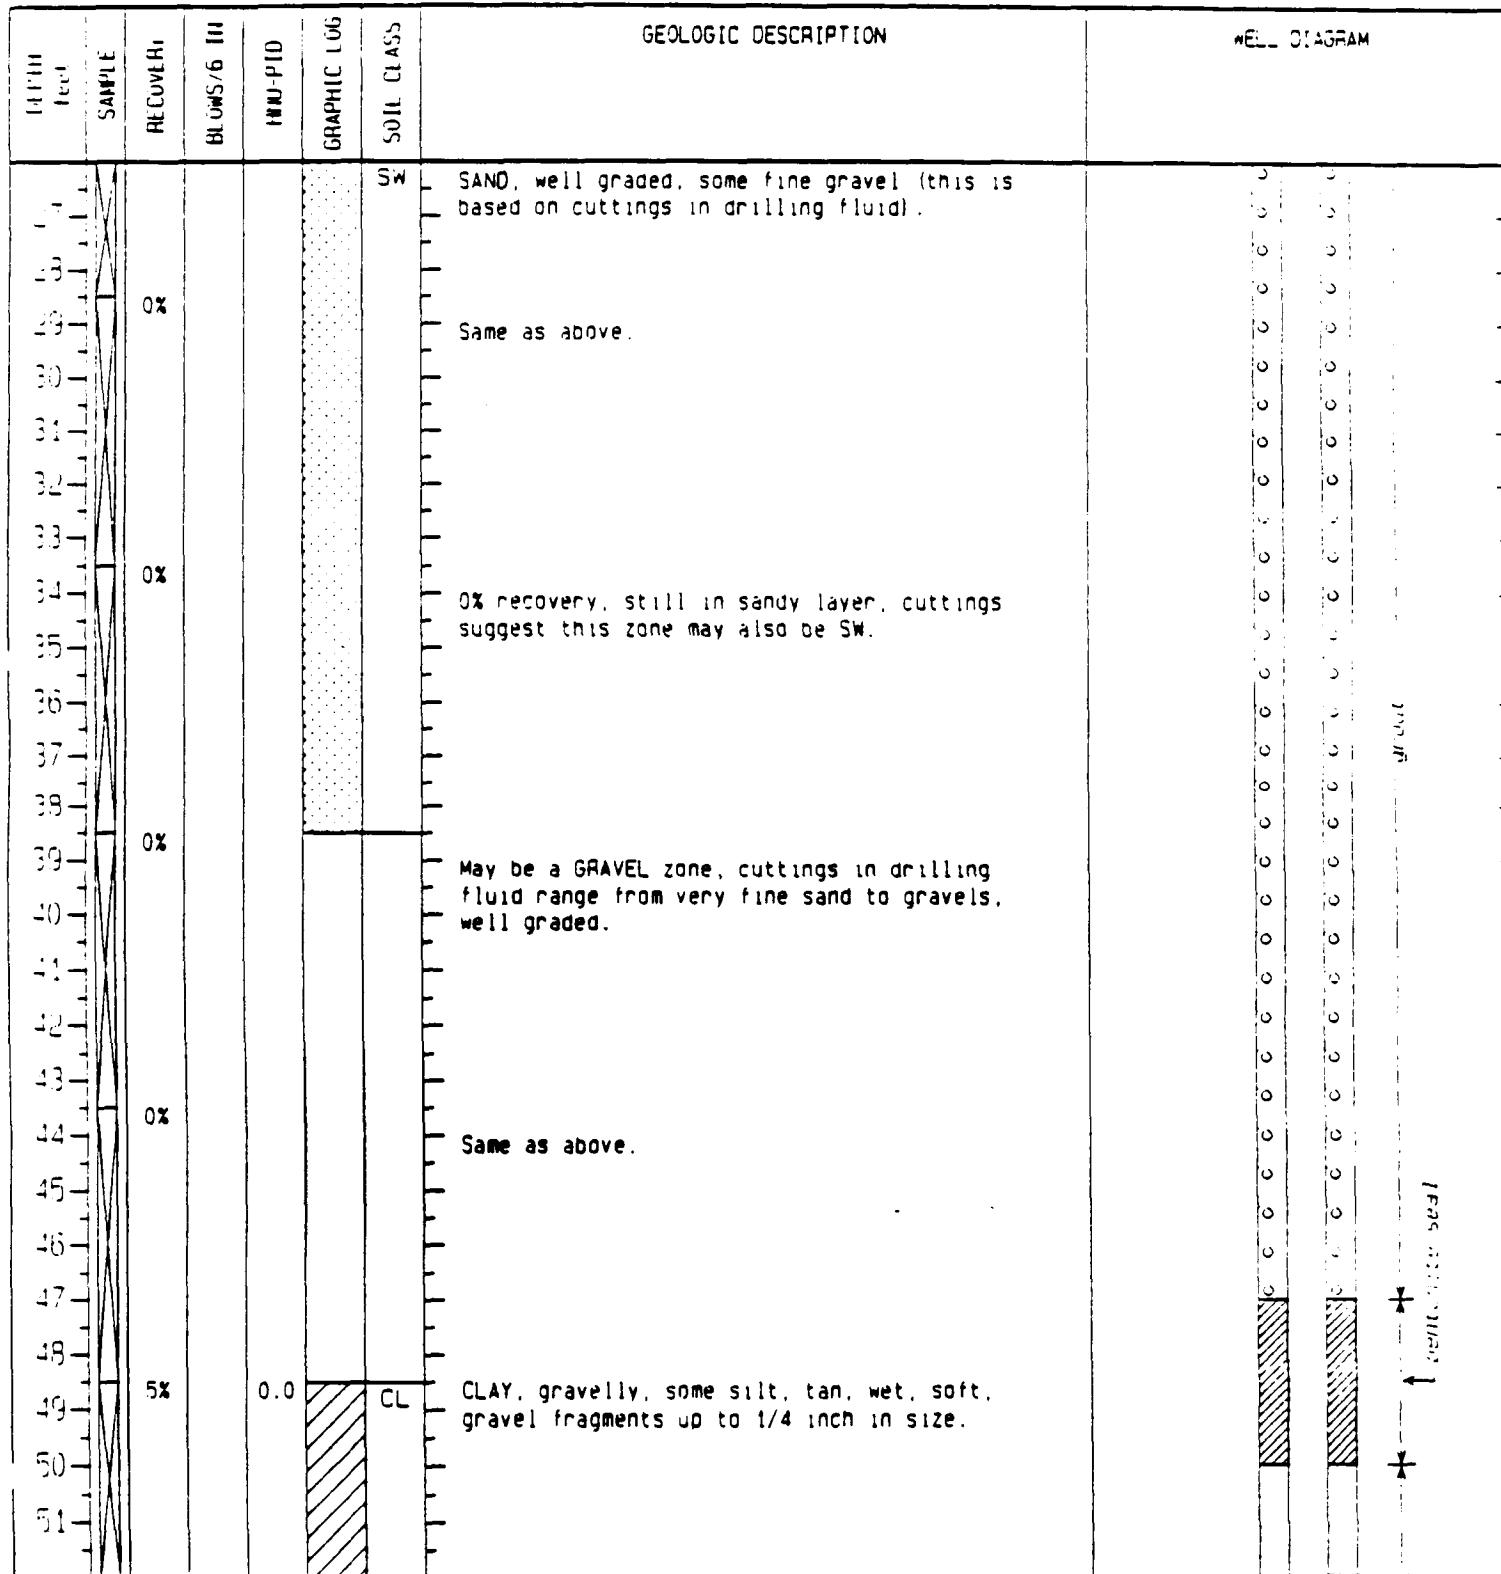


JAMES M. MONTGOMERY
CONSULTING ENGINEERS, INC.

365 LENNON LANE, WALNUT CREEK, CALIFORNIA, 94598 / (415) 975-3400

PAGE 3 OF 1

BORING/WELL NUMBER TH89-1/W89-11(B1)
DATE STARTED 11/14/90 COMPLETED 12/7/90
ELEVATION 37.44 FEET, Top of Box

CLIENT US NAVY
PROJECT NAS MOFFETT FIELD IS 8 and 9
GEOLOGIST CRAIG STEVENS

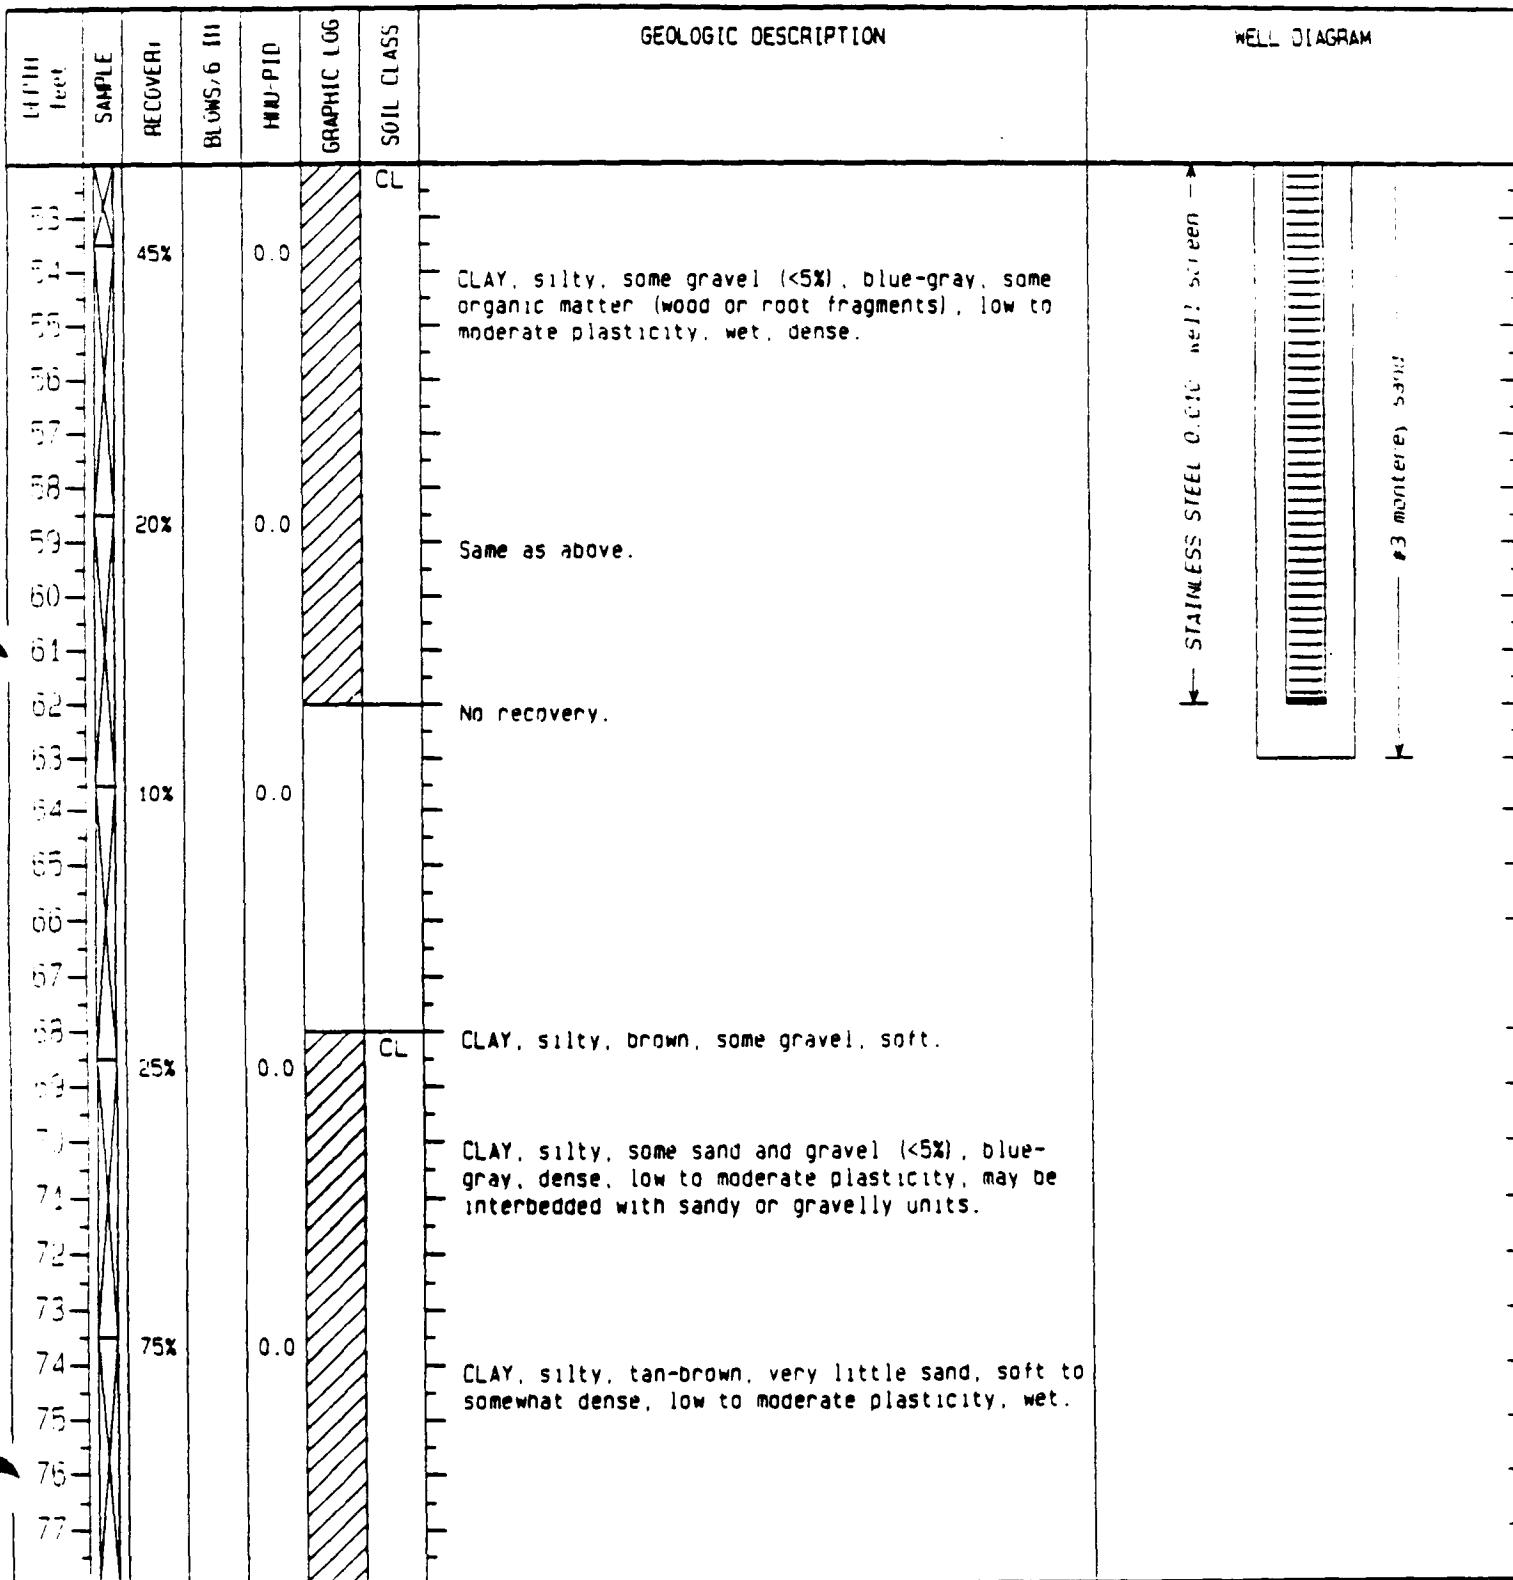

JAMES M. MONTGOMERY
CONSULTING ENGINEERS, INC.

365 LENNON LANE, WALNUT CREEK, CALIFORNIA, 94598 / (415) 975-3400

PAGE 4 OF

BORING/WELL NUMBER TH89-1/W89-11(B1)
DATE STARTED 11/14/90 COMPLETED 12/7/90
ELEVATION 37 14 FEET, Top of Box

CLIENT US NAVY
PROJECT VAS MOFFETT FIELD IS 3 and 4
GEOLOGIST CRAIG STEVENS

DEPTH feet	SAMPLE	HOLLOWAR	BLUNTS/III	WATER LEVEL	GRAPHIC LOG	SOIL CLASS	GEOLOGIC DESCRIPTION		WELL DIAGRAM
							CL	CL	
37	X	40%		0.0		CL	Same as above but color changes from tan-brown near the top of the sample to more of a blue-gray near the bottom (83.5).		
38									
39									
40									
41									
42									
43									
44		5%		0.0		CL	Same as above, blue-gray.		
45									
46									
47									
48									
49		0%					No recovery.		
50									
51									
52									
53									
54		0%							
55									
56									
57									
58									
59		75%		0.0		CL	CLAY, silty, gray-green, dense, moderate plasticity, zones of oxidation iron staining.		
60									
61									
JAMES M. MONTGOMERY
CONSULTING ENGINEERS, INC.

365 LENNON LANE, WALNUT CREEK, CALIFORNIA, 94598 / (415) 975-3400

PAGE 1 OF 4

BORING/WELL NUMBER TH89-2/WB9-12(B1)
DATE STARTED 11/16/90 COMPLETED 12/04/90
ELEVATION 35.28 FEET, TOP of Box

CLIENT US NAVY
PROJECT NAS MOFFETT FIELD IS 9 and 9
GEOLOGIST CRAIG STEVENS/CHRIS PETERSEN

DEPTH feet	SAMPLE	RECOVERY	BLUNS 6 IN	HNU-PID	GRAPHIC LOG	SOIL CLASS	GEOLOGIC DESCRIPTION		WELL DIAGRAM
0						CL			
1									
2									
3									
4									
5									
6									
7									
8									
9									
10									
11									
12									
13									
14									
15									
16									
17									
18									
19									
20									
21									
22									
23									
24						SW			
25	X	60%	0.0			CL	CLAY, silty, dark gray, stiff, moderately plastic.		

METHOD OF DRILLING MUD ROTARY

WELL COMPLETION DEPTH 65 FEET

HOLE DIAMETER 10 INCHES

WELL DIAMETER 4 INCHES

TOTAL DEPTH 104 FEET

WELL MATERIAL LOW CARBON STEEL/STAINLESS STEEL


JAMES M. MONTGOMERY
CONSULTING ENGINEERS, INC.

365 LENNON LANE, WALNUT CREEK, CALIFORNIA, 94598 / (415) 975-3400

PAGE 2 OF 4

BORING/WELL NUMBER TH89-2/W89-12(B1)
DATE STARTED 11/16/90 COMPLETED 12/04/90
ELEVATION 35.28 FEET, Top of Box

CLIENT US NAVY
PROJECT NAS MOFFETT FIELD IS 3 AND 3
GEOLOGIST CRAIG STEVENS/CHRIS PETERSEN

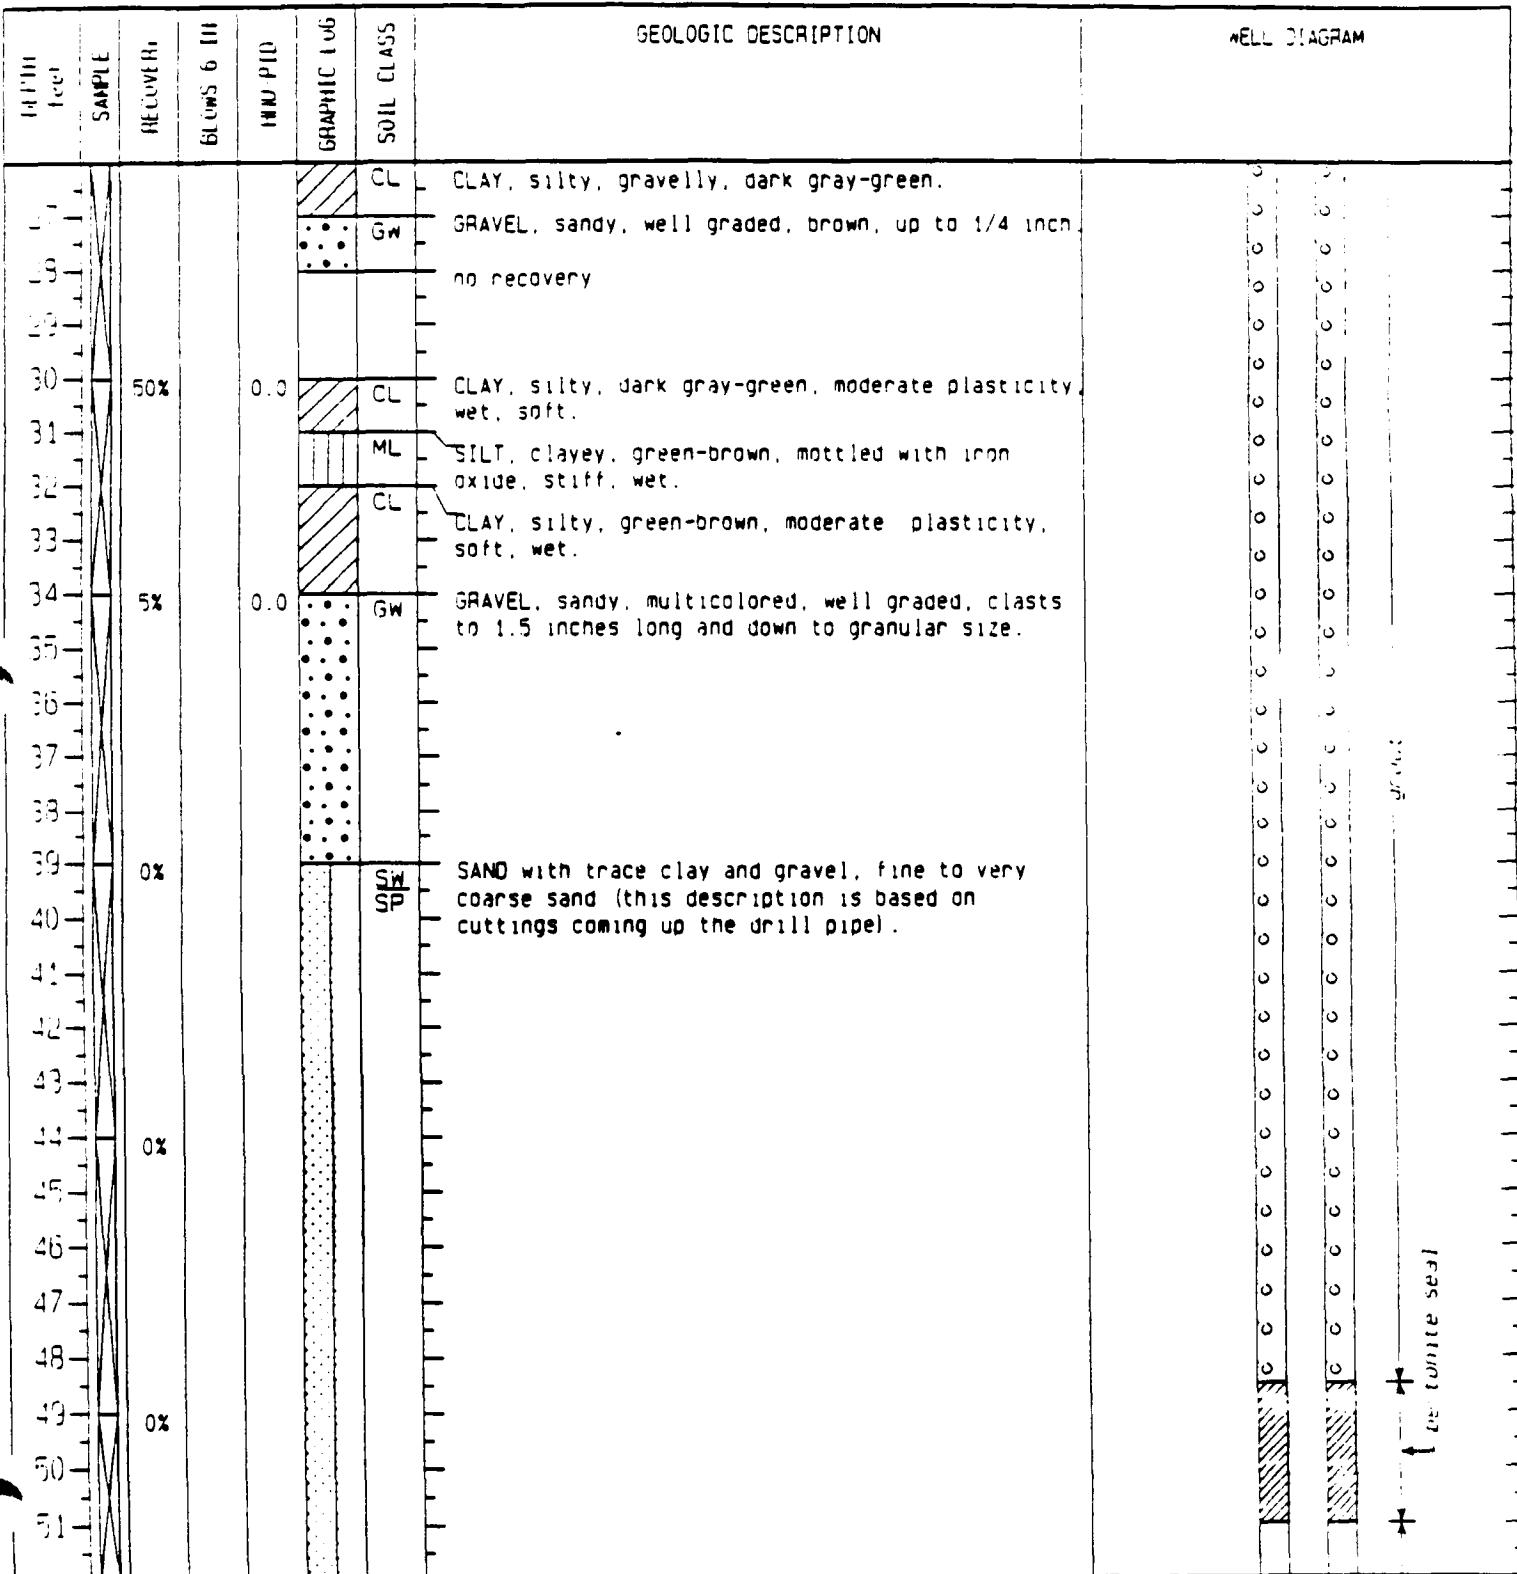

JAMES M. MONTGOMERY
CONSULTING ENGINEERS, INC.

365 LENNON LANE, WALNUT CREEK, CALIFORNIA, 94598 / (415) 975-3400

PAGE 3 OF 4

BORING/WELL NUMBER TH89-2/W89-12(B1)
DATE STARTED 11/16/90 COMPLETED 12/04/90
ELEVATION 35.28 FEET, Top of Box

CLIENT US NAVY
PROJECT NAS MOFFETT FIELD IS 3 and 9
GEOLOGIST CRAIG STEVENS/CHRIS PETERSEN

LTD. feet	SAMPLE	RECOVERED	BLWS: 6 III	HNU-PID	GRAPHIC LOG	SOIL CLASS	GEOLOGIC DESCRIPTION		WELL DIAGRAM
							SW	SP	
53		0%					SAND, well graded to poorly graded, fine, coarse and very coarse sands, trace gravel, trace clay. particles are multicolored (description from cuttings).		

→ STAINLESS STEEL 6' Ø 12" well screen →

→ 3' center, 5' side

JAMES M. MONTGOMERY
CONSULTING ENGINEERS, INC.

365 LENNON LANE, WALNUT CREEK, CALIFORNIA, 94598 / (415) 975-3400

PAGE 4 OF

BORING/WELL NUMBER TH89-2/W89-12(B1)
DATE STARTED 11/16/90 COMPLETED 12/04/90
ELEVATION 35 28 FEET, Top of Box

CLIENT US NAVY
PROJECT NAS MOFFETT FIELD IS 3 AND 4
GEOLOGIST CRAIG STEVENS/CHRIS PETERSEN

DEPTH feet	SAMPLE	Ht Cont Hr	BLW/S6	HWL/PID	GRAPHIC LOG	SOIL CLASS	GEOLOGIC DESCRIPTION		WELL DIAGRAM
							SW	SP	
79		0%							
80							Very fine to moderate SAND (description from cuttings).		
81									
82									
83									
84		0%							
85							same as above.		
86									
87									
88									
89		0%							
90							same as above.		
91									
92									
93									
94		0%							
95							same as above.		
96									
97									
98									
99									
100		20%		0.0					
101							same as above.		
102									
103						CL	CLAY, silty, gray-green, stiff, low plasticity, trace gravel and sand.		

N00296.001452
MOFFETT FIELD
SSIC NO. 5090.3

**APPENDIX C – BORING LOGS
GEOPHYSICAL LOGS**

SITE 9 – WELLS (MEW)

**REMEDIAL INVESTIGATION REPORT
OPERABLE UNIT 4: WEST SIDE AQUIFERS**

DATED 01 AUGUST 1992

Canonie

Boring Log

PRELIMINARY

PROJECT No. CE 82-023

BORING No. 2C

PAGE 1 OF 6

PROJECT NAME FAIRCHILD CAMERA AND INSTRUMENT CORPORATION, MOUNTAIN VIEW, CALIFORNIA

BORING LOCATION N 33° 69' E 1,548,307 SURFACE ELEV. 28.6
DRILLER ALL TERRAIN DRILLING DATE: START 7-30-85 FINISH 8-05-85

DEPTH	SAMPLE		BLOW COUNT			RECOVERY IN INCHES	U.S.C.S. SOIL TYPE	PERCENT MOISTURE	QU TSF	CONTACT DEPTH	SOIL DESCRIPTION AND REMARKS	PIEZO
	No.	Type	Interval	0	6	12						
	From	To		6	12	18						
0											(FILL MATERIAL).	
5	1	PB*	4.5	7.0			30	CL	3.0	4.0	VERY STIFF BROWN SILTY CLAY, SOME FINE TO COARSE GRAVEL.	
10	2	PB	7.0	9.5			30	CL SM&GM	2.0	8.0	GRAY SILTY FINE TO COARSE SAND AND FINE TO COARSE GRAVEL.	
15	3	PB	9.5	12.0			30	CL	2.0	10.0	VERY STIFF BROWN MOTTLED GRAY SILTY CLAY.	
20	4	PB	12.0	14.5			30	CL	2.0	14.5	GRAY FINE TO COARSE SAND AND FINE TO COARSE GRAVEL (WET).	
25	5	PB	14.5	17.0			30	SW&GW			(BROWN SANDY SILTY CLAY).	
30	6	PB	17.0	19.5			30	SW&GW			GRAY FINE TO COARSE SAND AND FINE TO COARSE GRAVEL (WET).	
35	7	PB	19.5	22.0			30	SW&GW			MEDIUM STIFF TO VERY STIFF GRAY SILTY CLAY.	
40	8	PB	22.0	24.5			6	CL	0.5			
	9	PB	24.5	27.0			6	CL	1.0			
	10	PB	27.0	29.5			6	CL	1.5			
	11	PB	29.5	32.0			6	CL	2.5			
	12	PB	32.0	34.5			18					
	13	PB	34.5	37.0			30					
	14	PB	37.0	39.5			30					
	15	PB	39.5	42.0			30					

*PB-PITCHER BARREL

Canonie

Boring Log

PROJECT No. CE 82-023

BORING No. 2C

PAGE 2 OF 6

PROJECT NAME FAIRCHILD CAMERA AND INSTRUMENT CORPORATION, MOUNTAIN VIEW, CALIFORNIA

BORING LOCATION SURFACE ELEV.

DRILLER ALL TERRAIN DRILLING DATE: START 7-30-85 FINISH 8-05-85

DEPTH	SAMPLE		BLOW COUNT			RECOVERY IN INCHES	U.S.C.S. SOIL TYPE	PERCENT MOISTURE	qu TSF	CONTACT DEPTH	SOIL DESCRIPTION AND REMARKS	PIEZO
	No.	Type	Interval From	To	0	6	12	18				
40												
	16	PB	42.0	44.5			30		CL	2.5		
										3.0		
	17	PB	44.5	47.0			30		CL	1.5	MEDIUM STIFF TO VERY STIFF GRAY SILTY CLAY.	
	18	PB	47.0	49.5			30		CL	2.0		
									CL	2.0		
	19	PB	49.5	52.0			30		SM			
									SM			
	20	PB	52.0	54.5			30		CL	2.5	50.5	
											53.0	
	21	PB	54.5	57.0			30		CL	1.25		
	22	PB	57.0	59.5			30		CL	3.25	STIFF TO VERY STIFF GRAY AND BROWN SILTY CLAY, SOME FINE GRAVEL.	
									CL	3.0		
	23	PB	59.5	62.0			30		CL	2.0		
									SW	64.5	BROWN FINE TO COARSE SAND (WET).	
	24	PB	62.0	64.5			30		CL	2.0		
									CL	2.0	65.5	
	25	PB	64.5	67.0			30		CL	2.5		
									CL	2.0		
	26	PB	67.0	69.5			30		CL	2.5	VERY STIFF BROWN FINE SANDY SILTY CLAY.	
									CL	2.0		
	27	PB	69.5	72.0			30		CL	2.5		
									SW	74.5		
	28	PB	72.0	74.5			30		CL	2.5		
									SW			
	29	PB	74.5	77.0			30		SW			
									SW			
	30	PB	77.0	79.5			30		SW		BROWN FINE TO COARSE SAND, SOME FINE GRAVEL (WET).	
									SW			
	31	PB	79.5	82.0			30		SW			

Canonie

Boring Log

PROJECT No. CE 82-023
 BORING No. 2C
 PAGE 3 OF 6

PROJECT NAME FAIRCHILD CAMERA AND INSTRUMENT CORPORATION, MOUNTAIN VIEW, CALIFORNIA

BORING LOCATION SURFACE ELEV.
 DRILLER ALL TERRAIN DRILLING DATE: START 7-30-85 FINISH 8-05-85

DEPTH	SAMPLE		BLOW COUNT			RECOVERY IN INCHES	U.S.C.S. SOIL TYPE	PERCENT MOISTURE	q _u TSF	CONTACT DEPTH	SOIL DESCRIPTION AND REMARKS	PIEZOM.
	No.	Type	Interval FROM	To	0	6	12	18				
80												
82	32	PB	82.0	84.5			30	CL	2.0	82.5		
85	33	PB	84.5	87.0			30	CL	2.5			
87	34	PB	87.0	89.5			30	CL	3.0			
90	35	PB	89.5	92.0			30	CL	4.5			
92	36	PB	92.0	94.5			30	CL	4.5			
95	37	PB	94.5	97.0			30	CL	2.5		STIFF TO HARD GRAY MOTTLED BROWN SILTY CLAY.	
97	38	PB	97.0	99.5			30	CL	2.0			
100	39	PB	100.0	102.0			0	CL	2.0			
102	40	PB	102.0	104.0			24	CL	1.5			
105	41	PB	104.5	106.5			30	CL	2.0	105.5	BROWN SILTY FINE SAND.	
107	42	PB	106.5	109.0			30	SM CL	3.0	107.0	VERY STIFF GRAY SILTY CLAY.	
109	43	PB	109.0	111.5			30	SW		109.0	BROWN FINE TO COARSE SAND (WET).	
111	44	PB	111.5	114.0			30	CL	3.0	111.0		
113	45	PB	114.0	116.5			30	CL SW	2.5	113.5	VERY STIFF BROWN SILTY CLAY.	
115	46	PB	116.5	119.0			30	CL	3.5	115.5	BROWN SILTY FINE SAND.	
117	47	PB	119.0	121.5			30	CL	3.0	117.5	VERY STIFF BROWN MOTTLED GRAY SILTY CLAY.	

Canonie

Boring Log

PROJECT No. CE 82-023

BORING No. 2C

PAGE 4 OF 6

PROJECT NAME FAIRCHILD CAMERA AND INSTRUMENT CORPORATION, MOUNTAIN VIEW, CALIFORNIA

BORING LOCATION _____ SURFACE ELEV. _____

DRILLER ALL TERRAIN DRILLING DATE: START 7-30-85 FINISH 8-05-85

DEPTH	SAMPLE			BLOW COUNT			RECOVERY IN INCHES	U.S.C.S. SOIL TYPE	PERCENT MOISTURE	QU TSF	CONTACT DEPTH	SOIL DESCRIPTION AND REMARKS	PIEZ
	No.	Type	Interval	0	6	12							
			FROM	TO	6	12	18						
120													
	48	PB	121.5	124.0				30	CL		3.0	123.0	
125									SM				
	49	PB	124.0	126.5				24	SM				
130									SM				
	50	PB	126.5	129.0				30					GRAY SILTY FINE SAND.
135													
	51	PB	129.0	133.0				0					
140													
	52	PB	133.0	135.5				12	CL		2.5		
145													
	53	PB	135.5	138.0				18	CL		3.5		
150													
	54	PB	138.0	142.0				48	CL		3.5		
155													
	55	PB	142.0	146.0				48	CL		3.5		VERY STIFF GRAY SILTY CLAY.
160													
	56	PB	146.0	150.0				48	CL		3.0		
	57	PB	150.0	154.0				48	CL		2.5		
	58	PB	154.0	158.0				48	CL		3.0		
	59	PB	158.0	162.0				48	CL		3.0		

Canonie

Boring Log

PROJECT No. CE 82-023

BORING No. 2C

PAGE 5 OF 6

PROJECT NAME FAIRCHILD CAMERA AND INSTRUMENT CORPORATION, MOUNTAIN VIEW, CALIFORNIA

BORING LOCATION SURFACE ELEV.

DRILLER ALL TERRAIN DRILLING DATE: START 7-30-85 FINISH 8-05-85

DEPTH	SAMPLE		BLOW COUNT			RECOVERY IN INCHES	U.S.C.S. SOIL TYPE	PERCENT MOISTURE	qu TSF	CONTACT DEPTH	SOIL DESCRIPTION AND REMARKS	PIEZO
	No.	TYPE	INTERVAL		0							
			FROM	TO	6	12						
160										162.0		
165	60	PB	162.0	166.0			48	CL	2.8			
170	61	PB	166.0	170.0			48	CL	3.0		VERY STIFF BROWN SILTY CLAY.	
175	62	PB	170.0	174.0			48	CL	3.0	171.5	BROWN FINE TO COARSE SAND.	
180	63	PB	174.0	178.0			48	CL	3.5	173.0		
185	64	PB	178.0	182.0			48	CL	3.5		VERY STIFF GRAY SILTY CLAY.	
190	65	PB	182.0	186.0			48	CL	3.0	183.0		
195	66	PB	186.0	190.0			48	SP			BROWN FINE SAND (WET).	
200	67	PB	190.0	194.0			36	SP				
	68	PB	194.0	198.0			48	CL	2.0	187.5		
	69	PB	198.0	202.0			48	SW&GW	2.25	196.5	VERY STIFF GRAY SILTY CLAY.	
											BROWN FINE TO COARSE SAND AND FINE TO COARSE GRAVEL.	
										200.5		

Canonie

Boring Log

PROJECT No. CE 82-023

BORING No. 2C

PAGE 6 OF 6

PROJECT NAME FAIRCHILD CAMERA AND INSTRUMENT CORPORATION, MOUNTAIN VIEW, CALIFORNIA

BORING LOCATION _____ SURFACE ELEV. _____

DRILLER ALL TERRAIN DRILLING DATE: START 7-30-85 FINISH 8-05-85

LOG OF EXPLORATORY BORING

Sheet 1 Of 2

PROJECT NUMBER 505-6.2
BY MCW DATE 4/12/82

BORING NO. 3B (10L)

SURFACE ELEV. *
(PROJECT DATUM)

CLASSIFICATION DATA			FIELD DATA			Depth In Ft.	Ground Water Levels	Samples	*AERO-GEODETIC: USGS ELEV. 35.4	DESCRIPTION
% Fines (No.200)	Liquid Limit	Plasti-city Index		Compressive Strength (TSF)	Penetration (Blows/Ft.)					
						5				Asphalt (CL) Dark gray-brown CLAY (brown,silty) (minor sand and fine gravel)
						10				(GW) Coarse sandy fine GRAVEL
						15				(fine to medium)
						20				(medium)
						25				(CL) Blue-gray silty to fine sandy CLAY
						30				(fine to coarse sand)
						35				
						40				

REMARKS:

Well construction details attached.



LOG OF EXPLORATORY BORING

Sheet 2 of 2

PROJECT NUMBER 505-6.2
BY HCW **DATE** 4/12/82

BORING NO. 3B (10L)
SURFACE ELEV.

CLASSIFICATION DATA			FIELD DATA			Depth in Ft.	Ground Water Levels	Samples	DESCRIPTION
% Fines (-No.200)	Liquid Limit	Plasti-city Index		Compressive Strength (TSF)	Penetration (Blows/Ft.)				
						45			(sandy to fine gravelly)
						50			(light brown)
						55			
						60			
						65			(SP-GP) Green-brown coarse SAND and GRAVEL
						70			(CL-SC) Brown fine sandy CLAY to clayey fine SAND
						75			(CL) Brown silty to fine sandy CLAY
						80			BOTTOM OF BORING

REMARKS:



Canonie

Boring Log

PRELIMINARY

PROJECT No. CE 82-023
 BORING No. 3C
 PAGE 1 OF 5

PROJECT NAME FAIRCHILD CAMERA AND INSTRUMENT CORPORATION, MOUNTAIN VIEW, CALIFORNIA

BORING LOCATION ALL TERRAIN DRILLING SURFACE ELEV.
 DRILLER ALL TERRAIN DRILLING DATE: START 8-7-85 FINISH 8-12-85

DEPTH	SAMPLE		BLOW COUNT			RECOVERY INCHES	U.S.C.S. SOIL TYPE	PERCENT MOISTURE	QU TSF	CONTACT DEPTH	SOIL DESCRIPTION AND REMARKS	PIEZO
	No.	Type	Interval From	To	0	6	12	18				
0											(FILL MATERIAL)	
5	1	PB*	2.0	4.5				30	CL	3.0		
10	2	PB	5.0	7.5				30	CL	1.0	STIFF TO VERY STIFF BROWN SILTY CLAY.	
15	3	PB	7.5	10.0				30	CL	1.5		
20	4	PB	10.0	12.5				30	CL	1.0		
25	5	PB	12.5	15.0				30	SM	11.5	BROWN SILTY FINE SAND.	
30	6	PB	15.0	17.5				30	SM	14.0	GRAY FINE SANDY SILTY CLAY.	
35	7	PB	17.5	20.0				30	CL	17.5	GRAY CLAYEY FINE SAND.	
40	8	PB	20.0	22.5				30	SC			
	9	PB	22.5	25.0				30	SC	25.0	STIFF GRAY SILTY CLAY.	
	10	PB	25.0	27.5				30	CL	1.0		
	11	PB	27.5	30.0				30	CL	27.5		
	12	PB	30.0	32.5				30	CL	2.0	STIFF BROWN SILTY CLAY, SOME FINE TO COARSE SAND.	
	13	PB	32.5	35.0				30	CL	1.0		
	14	PB	35.0	37.5				30	CL	37.5		
	15	PB	37.5	40.0				30	SC		BROWN CLAYEY FINE TO COARSE SAND, WET.	

Canonie

Boring Log

PROJECT No. CE 82-023

BORING No. 3C

PAGE 2 OF 5

PROJECT NAME FAIRCHILD CAMERA AND INSTRUMENT CORPORATION, MOUNTAIN VIEW, CALIFORNIA

BORING LOCATION SURFACE ELEV.

DRILLER ALL TERRAIN DRILLING DATE: START 8-7-85 FINISH 8-12-85

DEPTH	SAMPLE		BLOW COUNT			RECOVERY IN INCHES	U.S.C.S. SOIL TYPE	PERCENT MOISTURE	qu TSF	CONTACT DEPTH	SOIL DESCRIPTION AND REMARKS	PIEZO
	No.	Type	Interval	0	6	12						
40	16	PB	40.0	42.5			18	SC				
45	17	PB	42.5	46.0			12	SC&GC				
	18	PB	46.0	50.0			36	SC				
50	19	PB	50.0	54.0			48	CL	1.0	50.0		
55	20	PB	54.0	58.0			24	CL	2.0			
60	21	PB	58.0	62.0			48	CL	2.5		MEDIUM STIFF TO VERY STIFF BROWN SILTY CLAY.	
65	22	PB	62.0	66.0			48	CL	1.0			
	23	PB	66.0	70.0			48	CL	0.7	68.0		
70	24	PB	70.0	74.0			48	SC		70.0	BROWN CLAYEY FINE TO COARSE SAND.	
75	25	PB	74.0	78.0			48	CL	2.5	72.5	VERY STIFF BROWN SILTY CLAY.	
	26	PB	78.0	82.0			48	SC	2.5	74.0	BROWN CLAYEY FINE SAND.	
80								CL	1.0		STIFF TO VERY STIFF BROWN SILTY CLAY.	
								CL	3.5			

Canonie

Boring Log

PROJECT No. CE 82-023

BORING No. 3C

PAGE 3 OF 5

PROJECT NAME FAIRCHILD CAMERA AND INSTRUMENT CORPORATION, MOUNTAIN VIEW, CALIFORNIA

BORING LOCATION SURFACE ELEV.

DRILLER ALL TERRAIN DRILLING DATE: START 8-7-85 FINISH 8-12-85

DEPTH	SAMPLE		BLOW COUNT			RECOVERY IN INCHES	U.S.C.S. SOIL TYPE	PERCENT MOISTURE	QU TSF	CONTACT DEPTH	SOIL DESCRIPTION AND REMARKS	PIEZO
	No.	Type	Interval From	To	0	6	12	6	12	18		
80												
82	27	PB	82.0	86.0								
85	28	PB	86.0	90.0								
90	29	PB	90.0	94.0								
95	30	PB	94.0	98.0								
100	31	PB	98.0	102.0								
105	32	PB	102.0	106.0								
110	33	PB	106.0	110.0								
115	34	PB	110.0	114.0								
120	35	PB	114.0	118.0								
	36	PB	118.0	122.0								

Canonie

Boring Log

PROJECT No. CE 82-023
 BORING No. 3C
 PAGE 4 OF 5

PROJECT NAME FAIRCHILD CAMERA AND INSTRUMENT CORPORATION, MOUNTAIN VIEW, CALIFORNIA

BORING LOCATION ALL TERRAIN DRILLING SURFACE ELEV.
 DRILLER DATE: START 8-7-85 FINISH 8-12-85

DEPTH	SAMPLE		BLOW COUNT			RECOVERY IN INCHES	U.S.C.S. SOIL TYPE	PERCENT MOISTURE	q _u TSF	CONTACT DEPTH	SOIL DESCRIPTION AND REMARKS	PIEZ.
	No.	Type	INTERVAL	0	6	12						
			FROM	TO	6	12	18					
120												
	37	PB	122.0	126.0				48	CL	122.0		
125								SP		123.0	STIFF BROWN SILTY CLAY.	
	38	PB	126.0	130.0				48	CL	126.0	GRAY FINE SAND, WET.	
130												
	39	PB	130.0	134.0				48	CL	130.0	VERY STIFF GRAY SILTY CLAY.	
	40	PB	134.0	138.0				48	CL	131.0	BROWN SILTY CLAY.	
135											4 INCH GRAY SAND LAYER AT 131.0 FT.	
140								48	CL	2.5		
	41	PB	138.0	142.0				48	CL	2.5		
145								48	CL	2.0		
	42	PB	142.0	146.0				48	CL	2.0		
	43	PB	146.0	150.0				48	CL	3.0	VERY STIFF GRAY SILTY CLAY.	
150												
	44	PB	150.0	154.0				48	CL	3.0		
155								48	CL	2.0		
	45	PB	154.0	158.0				48	CL	3.0		
160								48	CL	3.0		

Canonie

Boring Log

PROJECT No. CES 82-023
BORING No. 3C
PAGE 5 OF 5

LOG OF EXPLORATORY BORING

SHEET 1 of 2

PROJECT NUMBER 505-0.2
BY HCW DATE 6/15/82

BORING NO. 4B
SURFACE ELEV. *
(PROJECT DATUM)

CLASSIFICATION DATA			FIELD DATA			Depth in Ft.	Ground Water Levels	Samples	*AERO-GEODETIC: USGS ELEV. 27.4	DESCRIPTION
% Fines (-No.200)	Liquid Limit	Plasti-city Index		Compressive Strength (TSF)	Penetration (Blows/Ft.)					
						25				(CL) Dark Brown CLAY with trace of fine sand - damp (gray-brown) (minor silt to fine sand and trace of fine gravel)
						30				(SM) Green-gray silty fine SAND with minor fine gravel - moist to wet
						35				(SW) Brown fine gravelly medium to coarse SAND with 1" to 2" thick silt and fine gravel inter-layers
						40				(gray, silty, fine-grained, no gravel)
										(CL) Gray silty CLAY with trace fine gravel - damp to moist
										(GC) Brown fine sandy clayey fine GRAVEL - wet
										(CL) Brown sandy and fine gravelly CLAY - damp
										(green-gray, silty with minor sand)
										(reddish brown, silty, with minor coarse sand and fine gravel)
										(decrease in sand and gravel content)

REMARKS:



LOG OF EXPLORATORY BORING

SHEET 2 of 2

PROJECT NUMBER 505-0.2
BY HCW DATE 6/15/82

BORING NO. 4B
SURFACE ELEV.*

CLASSIFICATION DATA			FIELD DATA			Depth in Ft.	Ground Water Levels	Samples	DESCRIPTION
% Fines (No.200)	Liquid Limit	Plasti- city Index		Compre- ssive Strength (TSF)	Penetra- tion (Blows/ Ft.)				
					20	45			(brown, trace fine sand and fine gravel)
						50			(gray, minor rootlets)
						55			(gray-green)
					44				(decrease in silt content)
						60			(brown, increase in fine to medium sand content)
						65			(GC) Brown very clayey coarse sandy fine GRAVEL - wet
						70			(GP/SW) Brown-green fine GRAVEL and clayey fine gravelly medium to coarse SAND - wet
									(CL) Brown silty CLAY - damp
									BOTTOM OF BORING

REMARKS: Boring was converted to a ground-water monitoring well by the installation of 64' of 4" steel casing, the lower 10' of which is a stain-less steel well screen. The annular space was backfilled with #2 aquarium sand to a depth of 50'. A bentonite-concrete seal was placed in the annular space from 50' to the surface.



Canonie

Boring Log

PRELIMINARY

PROJECT No. CES 82-023

BORING No. RW-9

PAGE 1 OF 3

PROJECT NAME FAIRCHILD CAMERA AND INSTRUMENT CORPORATION, MOUNTAIN VIEW, CALIFORNIA

BORING LOCATION SURFACE ELEV.

DRILLER ALL TERRAIN DRILLING DATE: START 7-08-85 FINISH 7-09-85

DEPTH	SAMPLE			BLOW COUNT			RECOVERY IN INCHES	U.S.C.S. SOIL TYPE	PERCENT MOISTURE	QU TSF	CONTACT DEPTH	SOIL DESCRIPTION AND REMARKS	PIEZO
	No.	Type	Interval	0	6	12							
			From	To	6	12	18						
5	1	MS*	3.5	5.0	6	13	19	18	OL	4.0	0.5	ASPHALT	
10	2	PB°	7.0	11.0				36	OL SW&GW	2.5	9.0		
15	3	PB	11.0	15.0				0	SW&GW			GRAY MOTTLED BROWN FINE TO COARSE SAND AND FINE TO COARSE GRAVEL.	
20	4	MS	15.0	16.5	7	17	17	9	SW&GW				
25	5	MS	17.5	19.0	7	18	22	8	SW&GW				
30	6	MS	20.0	21.5	8	19	11	10	SW&GW		21.5		
35	7	MS	22.5	24.0	2	3	5	18	CL	1.5			
40	8	PB	24.0	28.0				48	CL	1.75			
	9	PB	28.0	32.0				6	CL	4.0		MEDIUM STIFF TO VERY STIFF GRAY SILTY CLAY, SOME FINE TO COARSE SAND.	
	10	MS	32.0	33.5	8	9	15	18	CL	1.0			
	11	MS	34.5	36.0	3	5	7	18	CL	1.5			
	12	MS	37.0	38.5	4	6	8	18	CL	1.5			
	13	MS	39.5	41.0	4	17	12	18	CL	1.75			

Canonie

Boring Log

PROJECT No. CES 82-023
 BORING No. RW-9
 PAGE 2 OF 3

PROJECT NAME FAIRCHILD CAMERA AND INSTRUMENT CORPORATION, MOUNTAIN VIEW, CALIFORNIA

BORING LOCATION SURFACE ELEV.

DRILLER ALL TERRAIN DRILLING DATE: START 7-08-85 FINISH 7-09-85

DEPTH	SAMPLE			BLOW COUNT			RECOVERY IN INCHES	U.S.C.S. SOIL TYPE	PERCENT MOISTURE	qu TSF	CONTACT DEPTH	SOIL DESCRIPTION AND REMARKS	PIEZO
	No.	TYPE	INTERVAL	0	6	12							
			FROM	TO	6	12	18						
40													
	14	MS	42.0	43.5	2	3	5	18	CL	2.0			
45													
	15	MS	44.5	46.0	8	9	12	18	CL	0.75			
	16	MS	47.0	48.5	4	6	8	18	CL	1.5			
50													
	17	MS	49.5	51.0	4	6	8	18	CL	1.0			
	18	PB	52.0	56.0				16	CL	1.0			
55													
	19	PB	56.0	60.0				48	CL	4.0	56.0	VERY STIFF GRAY SILTY CLAY.	
60													
	20	PB	60.0	64.0				48	CL	1.5	60.0		
65													
	21	PB	64.0	68.0				48	SW		64.0	GRAY FINE TO COARSE SAND.	
									CL	2.5	67.0	VERY STIFF BROWN SILTY CLAY, SOME FINE TO COARSE SAND.	
70									CL	2.5	70.5		
	22	PB	68.0	72.0				48	SC		74.0	BROWN FINE TO COARSE SAND, SOME CLAY.	
								SC	1.5	76.0	STIFF BROWN SILTY CLAY.		
75									CL		78.0	BROWN SILTY SAND.	
	23	PB	72.0	76.0				48	SM		80.5	STIFF GRAY SILTY CLAY.	
									CL	1.5		CONTINUED.	
80													

Canonie

Boring Log

PROJECT No. CES 82-023

BORING No. RW-9

PAGE 3 OF 3

PROJECT NAME FAIRCHILD CAMERA AND INSTRUMENT CORPORATION, MOUNTAIN VIEW, CALIFORNIA

BORING LOCATION SURFACE ELEV.

DRILLER ALL TERRAIN DRILLING DATE: START 7-08-85 FINISH 7-09-85

DEPTH	SAMPLE		BLOW COUNT			RECOVERY IN INCHES	U.S.C.S. SOIL TYPE	PERCENT MOISTURE	QU TSF	CONTACT DEPTH	SOIL DESCRIPTION AND REMARKS	PIEZO
	No.	Type	Interval	0	6	12						
			From	To	6	12	18					
80											GRAY FINE SAND.	
	25	PB	80.0	84.0			48	CL	1.5	80.5		
										81.5		
85								CL	3.0			
	26	PB	84.0	88.0			48	SP	2.5	85.5	VERY STIFF GRAY SILTY CLAY, SOME FINE SAND.	
								CL	2.75	86.5	GRAY FINE SAND.	
90												
	27	PB	88.0	92.0			48	CL	4.5		STIFF TO HARD BROWN SILTY CLAY, SOME FINE SAND.	
95												
	28	PB	92.0	96.0			48	CL	1.5	100.0		
100											BOTTOM OF BORING AT 100.0 FEET.	
	29	PB	96.0	100.0			48	CL				
											NOTES:	
											1. BORING DRILLED USING MUD ROTARY METHOD.	
											2. UPON COMPLETION BORING WAS REAMED USING BUCKET RIG AND RECOVERY WELLS RW-9A, RW-9B(1), RW-9B(2) WERE INSTALLED. SEE RECOVERY WELL DETAILS.	

Canonie

Boring Log

PRELIMINARY

PROJECT No. CES 82-023
 BORING No. 10B
 PAGE 1 OF 3

PROJECT NAME FAIRCHILD CAMERA AND INSTRUMENT CORPORATION, MOUNTAIN VIEW, CALIFORNIA

BORING LOCATION N 332.145 F 1,547.882 SURFACE ELEV. 44.0

DRILLER ALL TERRAIN DRILLING DATE: START 3/15/85 FINISH 3/19/85

DEPTH	SAMPLE		BLOW COUNT			RECOVERY IN INCHES	U.S.C.S. SOIL TYPE	PERCENT MOISTURE	q TSF	CONTACT DEPTH	SOIL DESCRIPTION AND REMARKS	PIEZO	
	No.	Type	Interval	0	6	12							
			From	To	6	12	18						
0										0.5	(ASPHALT)		
										3.0	(SAND AND GRAVEL)		
5	1	MS*	3.5	5.0	9	15	19	18	CL	2.8	VERY STIFF BROWN SILTY CLAY.		
										7.0			
10	2	MS	8.5	10.0	6	10	16	18	CL	2.6	VERY STIFF GRAY SILTY CLAY, TRACE OF WOOD FRAGMENTS.		
										14.0			
15	3	MS	13.5	15.0	6	13	14	12	CL SW&GW	8.3	BROWN FINE TO COARSE SAND AND FINE TO COARSE GRAVEL, TRACE OF CLAY. (COBBLES)		
										19.5			
20	4	MS	18.5	20.0	20	28	32	18	ML	21.1	GRAY CLAYEY SANDY SILT.		
										29.5			
25	5	MS	23.5	25.0	9	14	23	18	ML	1.5	STIFF GRAY SILTY CLAY.		
										34.5	MEDIUM STIFF TAN SILTY CLAY.		
30	6	MS	28.5	30.0	6	14	28	18	CL	0.8	35.5		
										36.2			
35	7	MS	33.5	35.0	9	12	18	18	CL	23.5	3.75	VERY STIFF GRAY SILTY CLAY, TRACE OF ROOTS, 2 INCHES SAND AT 37.3 FT.	
										39.0	BROWN CLAYEY SAND AND GRAVEL.		
40	8	MS	35.0	36.5	8	12	24	18	CL	2.4			
	9	MS	36.5	38.0	9	23	30	18	CL-ML	0.8			
	10	MS	38.0	39.5	16	24	41	18	CL				
	11	MS	39.5	41.0	9	12	13	18	SC				
									CL				

*MODIFIED SPOON

Canonie

Boring Log

PROJECT No. CES 82-023

BORING No. 10B

PAGE 2 OF 3

PROJECT NAME FAIRCHILD CAMERA AND INSTRUMENT CORPORATION, MOUNTAIN VIEW, CALIFORNIA

BORING LOCATION N 332.145 E 1.547.882 SURFACE ELEV. 44.0

DRILLER ALL TERRAIN DRILLING DATE: START 3/15/85 FINISH 3/19/85

DEPTH	SAMPLE		BLOW COUNT			RECOVERY IN INCHES	U.S.C.S. SOIL TYPE	PERCENT MOISTURE	q _u TSF	CONTACT DEPTH	SOIL DESCRIPTION AND REMARKS	PIEZ
	No	Type	INTERVAL FROM	TO	0	6	12	18				
40										41.0	MEDIUM STIFF TAN SILTY CLAY.	
	12	MS	41.0	42.5	13	13	20	18	SC&GC	41.7	GRAY SAND AND GRAVEL, SOME CLAY.	
									SW&CL	20.2		
	13	MS	42.5	44.0	8	28	28	18	SC&GC	43.6	BROWN FINE TO COARSE SANDY CLAY, TRACE OF GRAVEL.	
	14	MS	44.0	45.5	15	34	42	18	SC&GC			
									SC&GC			
	15	MS	45.5	47.0	6	35	50	18	SC&GC			
	16	MS	47.0	47.9	34	59 ₅		10	SC&GC			
									SC&GC			
45									SC&GC			
	17	MS	48.5	50.0	20	41	49	12	SW&GW	9.7		
	18	MS	50.0	50.4	50 ₅			5	SC&GC	52.0		
								SC&GC				
	19	MS	51.5	53.0	10	9	11	14	CL	1.2		
	20	MS	53.0	54.5	3	12	15	18	CL	1.75	STIFF BROWN SILTY CLAY, TRACE OF FINE TO COARSE SAND.	
								CL				
	21	MS	54.5	56.0	17	27	32	18	CL	1.0		
	22	MS	56.0	57.0	12	50		12	CL	56.8		
								CL				
50								SW&GW				
	23	MS	57.5	58.3	32	50 ₄		10	SC	15.0	BROWN FINE TO COARSE SAND AND FINE TO COARSE GRAVEL, SILTY CLAY SEAMS.	
	24	MS	59.0	59.4	70 ₅			5	SW&GW	62.5		
								SC&GC				
	25	MS	60.5	61.7	12	31	50 ₃	14	SC&GC			
	26	MS	62.0	62.8	40	51 ₃		9	SC&GC	66.1		
								CL				
55								CL				
	27	MS	63.5	65.0	10	14	18	18	CL	1.0	STIFF GRAY SILTY CLAY, TRACE OF ROOTS, TRACE OF SHELLS, SANDY SEAMS.	
	28	MS	65.0	66.5	28	33	39	18	CL	1.25		
								CL				
	29	MS	66.5	68.0	8	18	27	16	CL	23.1		
	30	MS	68.0	69.5	8	12	18	18	CL	1.25		
								CL				
60								CL				
	31	MS	69.5	71.0	10	20	21	18	CL	1.25		
	32	MS	71.0	72.5	13	19	21	12	CL	1.25	STIFF GRAY SANDY CLAY, TRACE OF GRAVEL.	
								CL				
	33	MS	72.5	74.0	18	24	35	18	CL	1.5	STIFF GRAY SILTY CLAY, TRACE OF SAND, TRACE OF ROOTS.	
	34	MS	74.0	75.5	14	27	36	14	CL	1.75	STIFF GRAY SANDY CLAY, TRACE OF ROOTS, TRACE OF GRAVEL.	
								CL				
65								CL				
	35	MS	75.5	77.0	14	22	23	18	CL	1.75	GRAY SANDY CLAYEY SILT.	
	36	MS	77.0	78.5	20	30	35	15	CL	78.0		
								ML				
70								ML	79.5			
	37	MS	78.5	79.5	16	50		12	ML			
								ML				
75								ML				
								ML				
80								ML				

Canonie

Boring Log

PROJECT No. CES 82-023

BORING No. 10B

PAGE 3 OF 3

PROJECT NAME FAIRCHILD CAMERA AND INSTRUMENT CORPORATION, MOUNTAIN VIEW, CALIFORNIA

BORING LOCATION N 332.145 E 1,547.882 SURFACE ELEV. 44.0

DRILLER ALL TERRAIN DRILLING DATE: START 3/15/85 FINISH 3/19/85

DEPTH	SAMPLE			BLOW COUNT			RECOVERY IN INCHES	U.S.C.S. SOIL TYPE	PERCENT MOISTURE	q _u TSF	CONTACT DEPTH	SOIL DESCRIPTION AND REMARKS	PIEZ
	No.	Type	Interval	0	6	12							
80	38	MS	80.0 81.5	17	22	30	18	SC	.	81.0		GRAY CLAYEY FINE TO COARSE SAND.	
								ML				VERY STIFF DARK GRAY CLAYEY SILT.	
85	39	MS	81.5 83.0	12	41	45	18	ML	2.1	83.0		TRACE OF SAND.	
	40	MS	83.0 84.5	21	32	50	18	SM		84.0		DARK GRAY SILTY FINE SAND.	
90	41	MS	84.5 86.0	18	30	48	18	CL	2.25	86.0		VERY STIFF GRAY SILTY CLAY, SAND	
	42	MS	86.0 87.5	12	40	41	12	CL				SEAMS.	
95	43	MS	87.5 88.5	32	50		12	SW				GRAY FINE TO COARSE SAND, TRACE OF	
	44	MS	90.0 91.4	28	42	50/5	16	SC	16.3			SILT, 3-INCHES CLAY AT 88 FT.	
100	45	MS	91.5 93.0	16	28	35	18	SW	2.0				
	46	MS	93.0 94.5	15	25	31	16	CL	2.5			STIFF TO VERY STIFF GRAY SILTY	
	47	MS	94.5 96.0	16	21	25	18	CL	2.0			CLAY, TRACE OF SAND, 4-INCH SAND	
	48	MS	96.0 97.5	26	37	37	18	CL	1.6			AT 91.5 FT.	
	49	MS	97.5 99.0	23	35	39	18	CL	18.3	2.75			
								CL	2.0	99.0		BOTTOM OF BORING AT 99.0 FT.	
												NOTES:	
												1. BORING DRILLED USING 8-INCH	
												HOLLOW STEM AUGERS.	
												2. UPON COMPLETION, BORING WAS	
												CONVERTED TO A 2-INCH PVC	
												OBSERVATION WELL WITH 5 FT.	
												OF SCREEN FROM 85.0 TO 90.0 FT.	
												SEE 10B(2) OBSERVATION WELL	
												DETAILS.	

Canonie

PRELIMINARY

Boring Log

PROJECT No. CES 82-023

BORING No. 128

PAGE 1 OF 3

PROJECT NAME FAIRCHILD CAMERA AND INSTRUMENT CORPORATION, MOUNTAIN VIEW, CALIFORNIA

BORING LOCATION N 333,426 E 1,547,826 SURFACE ELEV. 37.2

DRILLER ALL TERRAIN DRILLING DATE: START 6-10-85 FINISH 6-10-85

DEPTH	SAMPLE		BLOW COUNT			RECOVERY IN INCHES	U.S.C.S. SOIL TYPE	PERCENT MOISTURE	QU TSF	CONTACT DEPTH	SOIL DESCRIPTION AND REMARKS	PIEZO
	No.	Type	Interval	0	6	12						
			FROM	TO	6	12	18					
0										0.5	ASPHALT.	
5											(CLAY)	
10												
15												
20												
25												
30										30.0		
	1	MS*	30.0	31.5	3	4	5	18				
	2	MS	32.5	34.0	4	6	10	18				
	3	MS	35.0	36.5	6	6	9	18				
	4	MS	37.5	39.0	7	9	12	18				
35												
40										39.0	GRAY CLAYEY SILT, SOME FINE SAND.	
										40.0	(BROWN FINE TO COARSE SAND, AND FINE GRAVEL).	

Canonie

Boring Log

PROJECT No. CES 82-023

BORING No. 12B

PAGE 2 OF 3

PROJECT NAME FAIRCHILD CAMERA AND INSTRUMENT CORPORATION, MOUNTAIN VIEW, CALIFORNIA

BORING LOCATION SURFACE ELEV.

DRILLER ALL TERRAIN DRILLING DATE: START 6-10-85 FINISH 6-10-85

DEPTH	SAMPLE		BLOW COUNT			RECOVERY IN INCHES	U.S.C.S. SOIL TYPE	PERCENT MOISTURE qu TSF	CONTACT DEPTH	SOIL DESCRIPTION AND REMARKS	PIEZO
	No.	TYPE	INTERVAL		0						
			FROM	TO	6	12	18				
40	5	MS	40.0	41.5	9	8	6	18	ML	GRAY CLAYEY SILT, SOME FINE SAND.	
45	6	MS	42.5	44.0	7	9	9	18	CL	BROWN SILTY CLAY, SOME FINE TO COARSE SAND.	
50	7	MS	45.0	46.5	5	7	8	18	CL	GRAY SILTY CLAY, SOME FINE SAND.	
55	8	MS	47.5	49.0	4	7	9	18	CL	BROWN SILTY CLAY, SOME FINE SAND.	
60	9	MS	50.0	51.5	5	6	8	18	CL	BROWN SILTY CLAY, SOME FINE SAND.	
65	10	MS	52.5	54.0	7	10	17	18	CL	BROWN FINE TO COARSE SAND AND FINE GRAVEL.	
70	11	MS	55.0	56.5	17	22	25	14	SW&GP	BROWN/GRAY CLAYEY SILT, SOME FINE SAND, 3-IN. FINE SAND LAYER AT 58.0 FEET.	
75	12	MS	57.5	59.0	7	9	13	18	ML	BROWN SILTY CLAY, SOME FINE TO COARSE SAND.	
80	13	MS	60.0	61.5	6	9	11	18	CL	BROWN SILTY CLAY, SOME FINE TO COARSE SAND.	
	14	MS	62.5	64.0	5	7	7	5	CL	65.0	
	15	MS	65.0	66.5	11	22	33	14	SW&GP	BROWN FINE TO COARSE SAND AND FINE GRAVEL.	
	16	MS	67.5	68.5	36	74	-	12	SW&GP	69.5	
	17	MS	70.0	71.5	6	9	17	18	CL	BROWN SILTY CLAY, SOME FINE TO COARSE SAND.	
	18	MS	72.5	74.0	8	8	12	18	CL	74.5	
	19	MS	75.0	76.5	5	7	9	18	CL	BROWN/GRAY SILTY CLAY.	
										76.5	BOTTOM OF BORING AT 76.5 FEET.
											(CONTINUED)

Canonie

Boring Log

PROJECT No. CES 82-023

BORING No. 128

PAGE 3 OF 3

PROJECT NAME FAIRCHILD CAMERA AND INSTRUMENT CORPORATION, MOUNTAIN VIEW, CALIFORNIA

BORING LOCATION N 333.426 E 1,547.826 SURFACE ELEV. 37.2

DRILLER ALL TERRAIN DRILLING **DATE: START** 6-10-85 **FINISH** 6-10-85

LOG OF EXPLORATORY BORING

PROJECT NUMBER 505-9.1

BY SMM DATE 2/26/82

BORING NO. 45A (18BP)

SURFACE ELEV. 78.0*
(PROJECT DATUM)

CLASSIFICATION DATA			FIELD DATA			Depth in Ft.	Ground Water Level	Samples	*AERO-GEODETIC: USGS ELEV. 43.7 DESCRIPTION
% Fines (<No.200)	Liquid Limit	Plasti-city Index	Compressive Strength (TSF)	Penetration (Blows/Ft.)					
									Asphalt
						5			(CL) Brown CLAY - damp, stiff to very stiff
					27	10			(SW) Brown to tan gravelly medium to coarse SAND - moist to wet, medium dense, slightly clayey
						15			(GW) Brown sandy coarse GRAVEL - wet, dense, some cobbles up to 4"
					10	20			(CL) Interlayered tan silty CLAY and fine sandy CLAY - wet, stiff
					36	25			(SC) Blue gray clayey fine SAND - wet, dense
					9				(CL) Blue CLAY - moist, stiff BOTTOM OF BORING

REMARKS: Boring was converted to a monitoring well by the installation of 25' of 2" PVC casing. The lower 12' of casing was slotted and the annular space backfilled with pea-gravel. A bentonite-concrete seal was placed in the annular space from 13' to the surface.




LOG OF EXPLORATORY BORING

PROJECT NUMBER 505-6.2

BY DM DATE 4/16/82

BORING NO. 46A (15L)

SURFACE ELEV. *
(PROJECT DATUM)

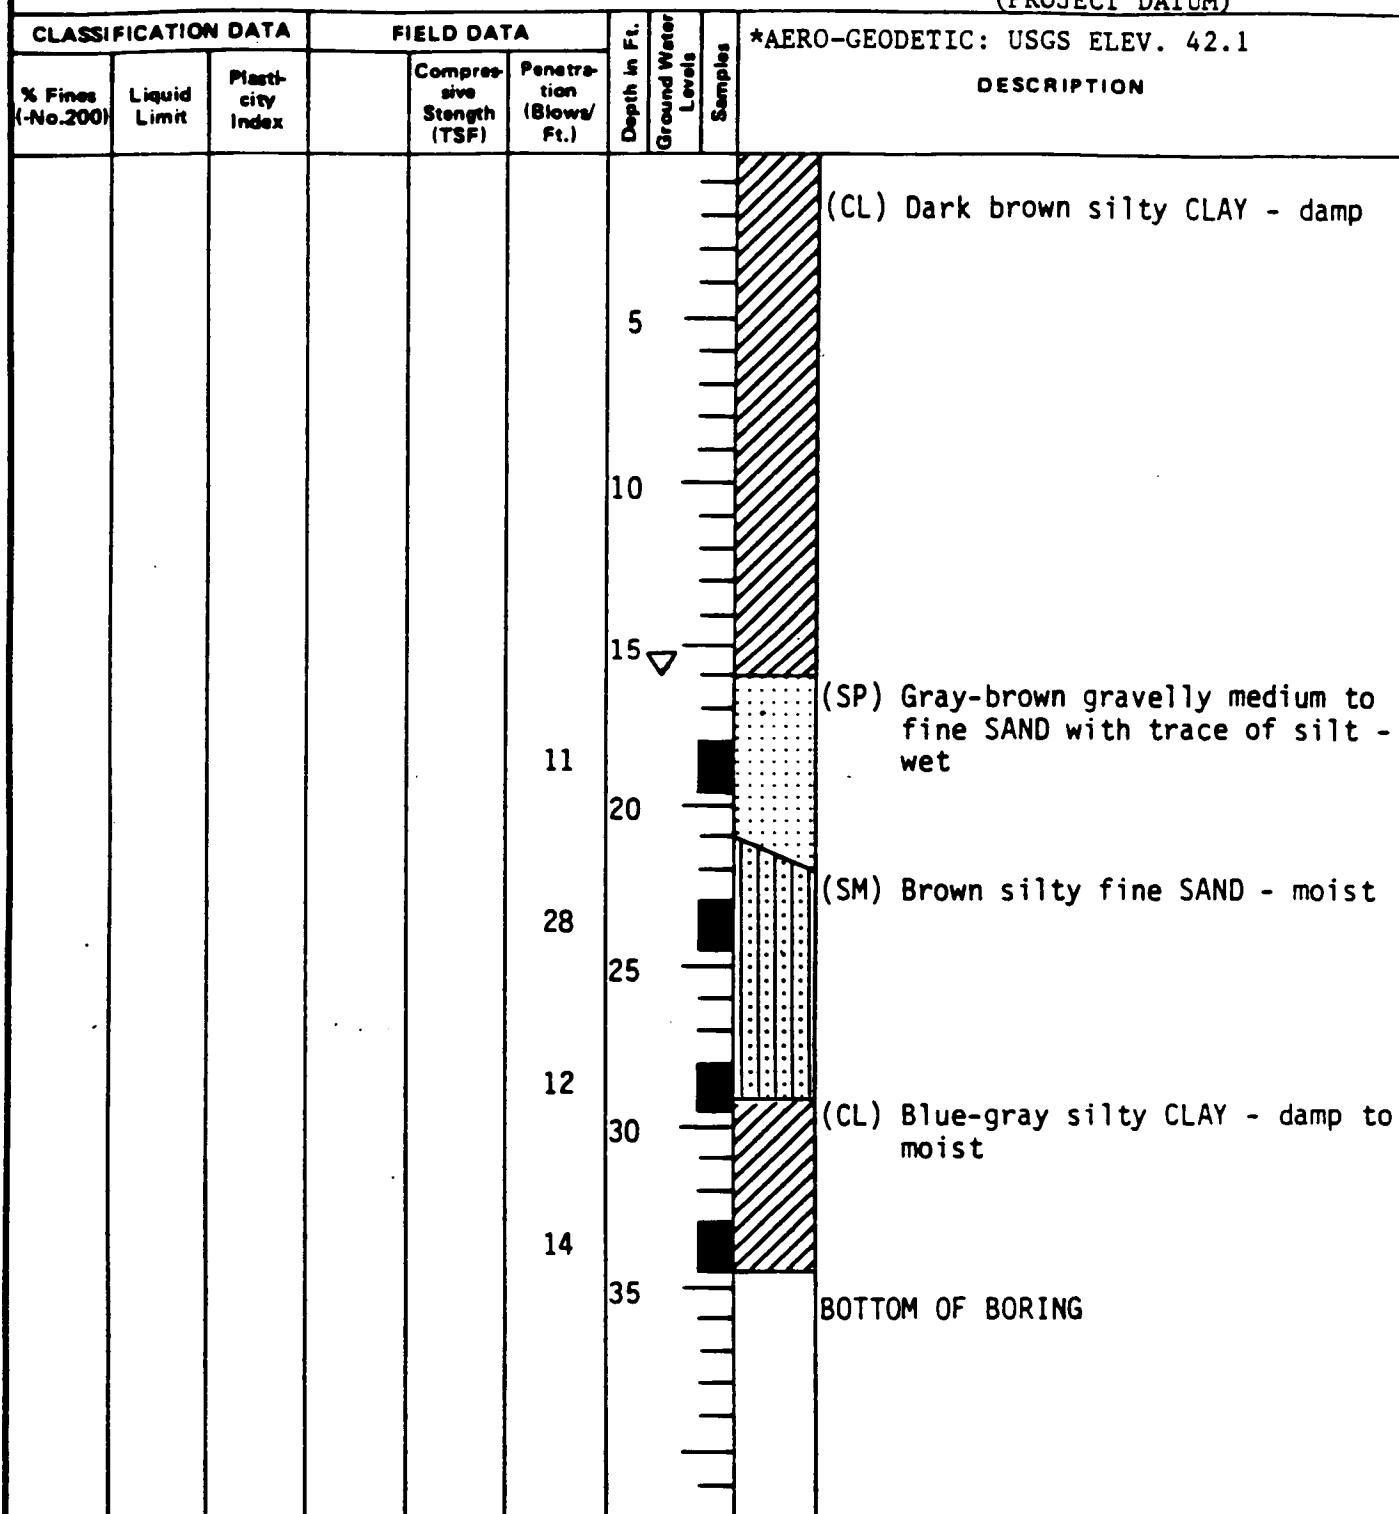

REMARKS: Boring converted to a monitoring well by the installation of 34' of 2" PVC casing, the lower 20' of which was slotted. The annular space was backfilled with gravel to within 14' of the ground surface at which point a concrete surface seal was installed.



EMCON
ASSOCIATES

LOG OF EXPLORATORY BORING

PROJECT NUMBER 505-6.1

BY SMM DATE 2/17/82

BORING NO. 49A (8L)

SURFACE ELEV. 75.7*

CLASSIFICATION DATA			FIELD DATA			Depth in Ft.	Ground Water Levels	Samples	*AERO-GEODETIC: USGS ELEV. 41.5	DESCRIPTION
% Fines (<No.200)	Liquid Limit	Plasti-city Index	Compressive Strength (TSF)	Penetration (Blows/Ft.)						
				41		5				Asphalt
				27		10				(CL) Brown CLAY - damp, hard, some orange silty zones (moist, very stiff)
				37		15				(GM) Brown coarse sandy GRAVEL - wet, dense, some silt
						20				
						25				(ML) Blue gray clayey SILT - moist to wet, very stiff to hard
						30				(GM) Brown sandy GRAVEL - wet, dense (CL) Blue CLAY - wet, very stiff
										BOTTOM OF BORING

REMARKS: Boring was converted to a monitoring well by the installation of 30' of 2" PVC casing. The lower 15' of casing was slotted and the annular space backfilled with pea-gravel to a depth of 10'. A bentonite and concrete seal was placed in the annular space from 10' to the surface.



LOG OF EXPLORATORY BORING

PROJECT NUMBER 505-5.1
BY HCW **DATE** 2/22/82

BORING NO. 54A (1M)

SURFACE ELEV. 74.1*
(Project data)

REMARKS: Boring converted to a monitoring well by the installation of 40' of 2" PVC casing. The lower 26' of casing was slotted and the annular space filled with pea-gravel. A bentonite and concrete seal was placed in the annular space from 14' to the surface.



EMCON
ASSOCIATES


LOG OF EXPLORATORY BORING

PROJECT NUMBER 505-6.1

BY SMM DATE 2/16/82

BORING NO. 57A (3L)

SURFACE ELEV. 73.6*
(PROJECT DATUM)

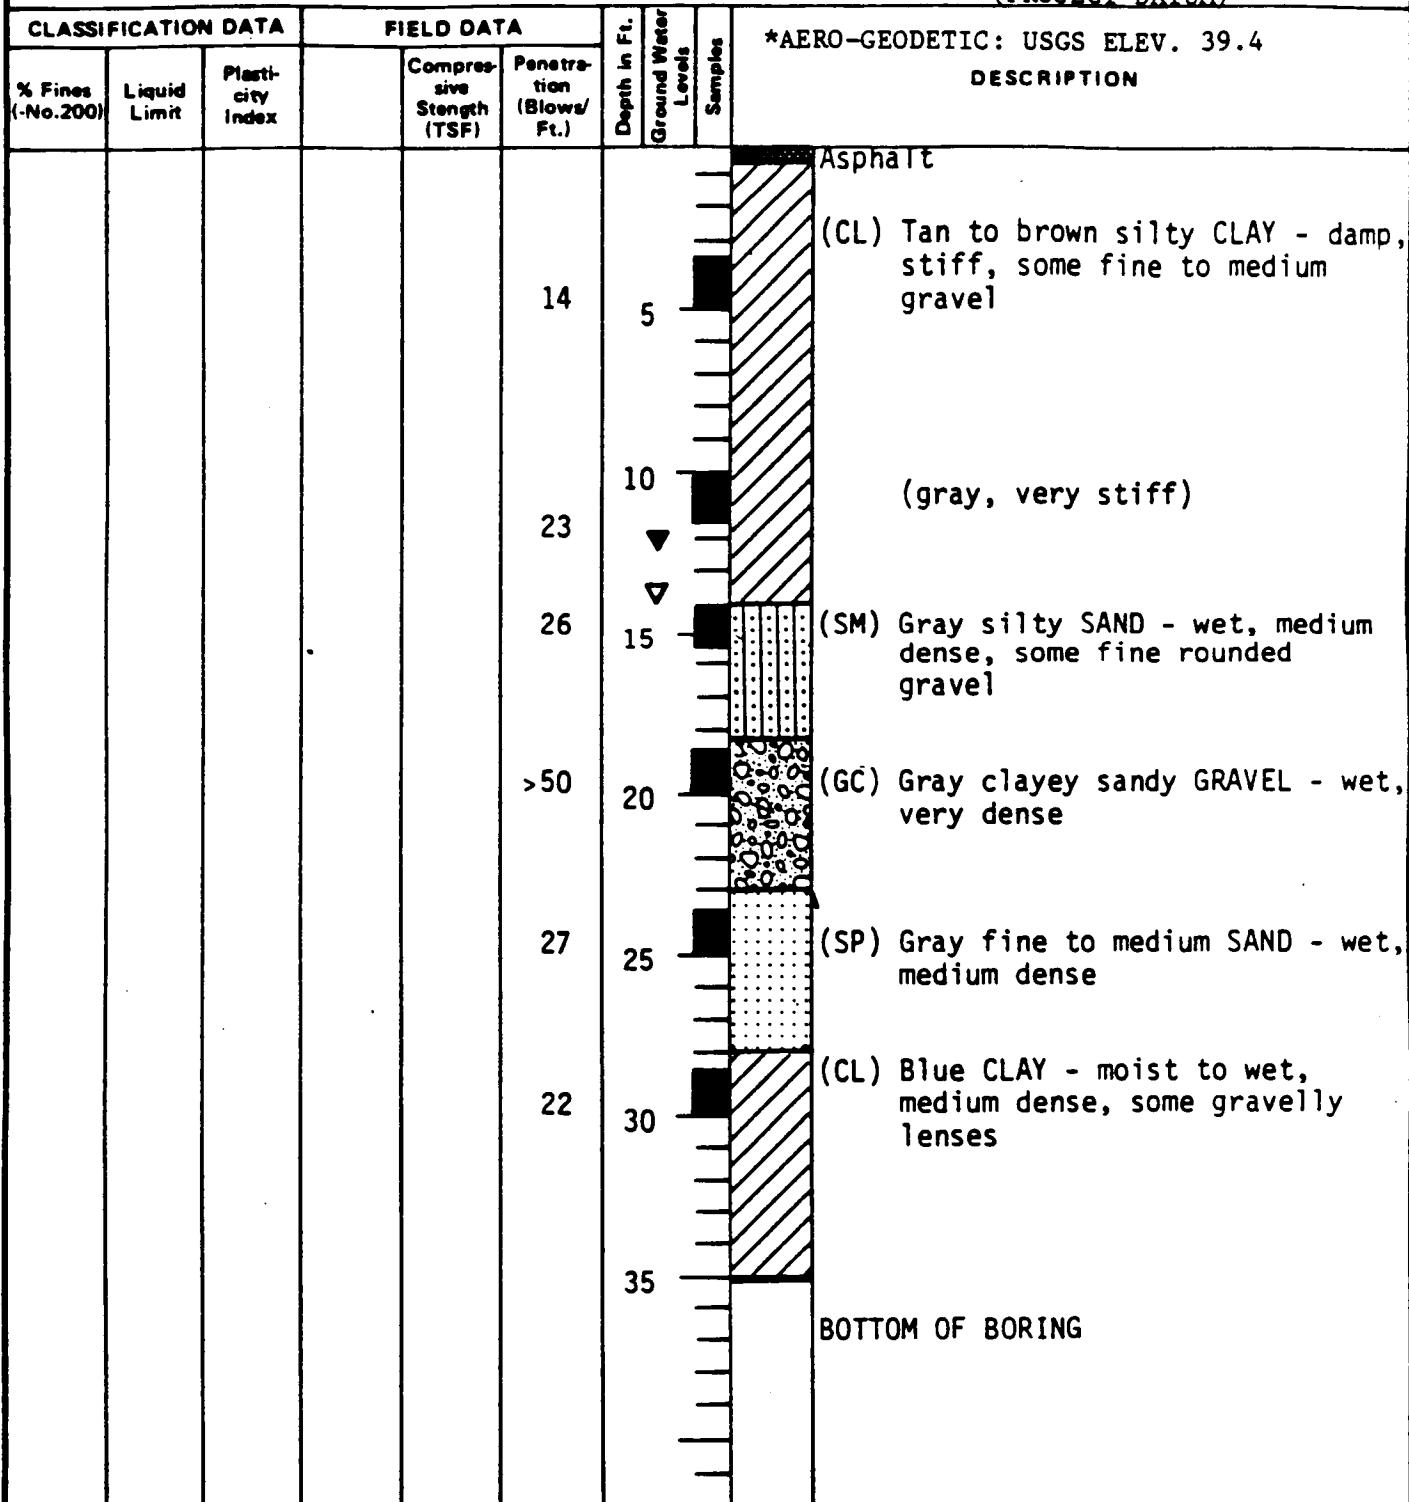

REMARKS:

Boring was converted to a monitoring well by the installation of 35' of 2" PVC casing. The lower 20' of casing was slotted and the annular space filled with pea-gravel to a depth of 12'. A bentonite and concrete seal was placed in the annular space from 12' to the surface.



LOG OF EXPLORATORY BORING

PROJECT NUMBER 505-6.2

BY LP DATE 4/6/82

BORING NO. 61A (14L)

SURFACE ELEV. *
(PROJECT DATUM)

CLASSIFICATION DATA			FIELD DATA			Depth In Ft. Ground Water Levels	Samples	*AERO-GEODETIC: USGS ELEV. 37.7	
% Fines (No. 200)	Liquid Limit	Plasti- city Index		Compre- hesive Strength (TSF)	Penetra- tion (Blows/ Ft.)			DESCRIPTION	
								XXXX	Asphalt and Base Rock
									(CL) Dark brown silty CLAY - moist (mottled, brown)
					7	5			(sandy)
						11	10		(very moist)
							14	15	▽
									(CL/SM) Interlayered gray very sandy CLAY and silty SAND - wet
						17	20		(SM/SP) Interlayered brown silty SAND and gravelly coarse SAND - wet
							25		
							30		(CL) Light blue-green silty CLAY with trace of very sandy clay, root holes - moist
					6				BOTTOM OF BORING
						35			

REMARKS: Boring converted to a monitoring well by the installation of 31' of 2" PVC casing, the lower 15' of which was slotted. The annular space was backfilled with gravel to within 10' of the ground surface at which point a concrete surface seal was installed.



Canonie

Boring Log

PRELIMINARY

PROJECT No. CES 82-023

BORING No. 64B

PAGE 1 OF 3

PROJECT NAME FAIRCHILD CAMERA AND INSTRUMENT CORPORATION, MOUNTAIN VIEW, CA

BORING LOCATION N 332,697 F 1,549,518 SURFACE ELEV.

DRILLER ALL TERRAIN DRILLING DATE: START 7-17-85 FINISH 7-18-85

DEPTH	SAMPLE			RECOVERY IN INCHES	U.S.C.S. SOIL TYPE	PERCENT MOISTURE	QU TSF	CONTACT DEPTH	SOIL DESCRIPTION AND REMARKS	PIEZO
	No.	TYPE	INTERVAL							
			FROM	TO	6	12	18			
5										
10										
15										
20										
25										
30										
35										
40										

FOR SOIL DESCRIPTIONS FROM 30.0
FT. TO 70.0 FT., SEE BORING
LOG 14B.

Canonie

Boring Log

PROJECT No. CES 82-023

BORING No. 648

PAGE 2 OF 3

PROJECT NAME FAIRCHILD CAMERA AND INSTRUMENT CORPORATION, MOUNTAIN VIEW, CA

BORING LOCATION N 332.697 E 1,549.518 SURFACE ELEV.

DRILLER ALL TERRAIN DRILLING DATE: START 7-17-85 FINISH 7-18-85

DEPTH	SAMPLE			BLOW COUNT			RECOVERY IN INCHES	U.S.C.S. SOIL TYPE	PERCENT MOISTURE	qu TSF	CONTACT DEPTH	SOIL DESCRIPTION AND REMARKS	PIEZO
	No.	TYPE	INTERVAL	0	6	12							
			FROM	TO									
45													
50													
55													
60													
65													
70	1	MS	70.0	71.5	10	9	14	18	CL	1.5	70.0	(CLAY)	
75	2	MS	72.5	74.0	16	18	21	18	CL	1.0	75.0	STIFF BROWN SILTY CLAY, TRACE OF FINE TO COARSE SAND.	
	3	MS	75.0	76.5	12	13	16	18	CL	1.0	77.0	STIFF GRAY MOTTLED BROWN SANDY SILTY CLAY.	
80	4	MS	77.5	79.0	18	35	36	18	CL/SP	1.0	78.3	STIFF GRAY SILTY CLAY.	
	5	MS	80.0	81.5	19	20	21	18	SP/CL		80.3	BROWN FINE TO MEDIUM SAND.	

Canonie

Boring Log

PROJECT No. CES 82-023

BORING No. 64B

PAGE 3 OF 3

PROJECT NAME FAIRCHILD CAMERA AND INSTRUMENT CORPORATION, MOUNTAIN VIEW, CA

BORING LOCATION N 332.697 E 1,549.518 SURFACE ELEV.

DRILLER ALL TERRAIN DRILLING DATE: START 7-17-85 FINISH 7-18-85

DEPTH	SAMPLE			BLOW COUNT			RECOVERY IN INCHES	U.S.C.S. SOIL TYPE	PERCENT MOISTURE	QU TSF	CONTACT DEPTH	SOIL DESCRIPTION AND REMARKS	PIEZO
	NO.	TYPE	INTERVAL		0	6							
			FROM	TO	6	12							
85	6	MS	82.5	84.0	16	28	34	18	SP	2.0	80.3	VERY STIFF BROWN SILTY CLAY, SOME FINE SAND.	
											81.0		
	7	MS	85.0	86.5	16	21	25	18	CL	2.5	83.9	BROWN FINE TO MEDIUM SAND.	
90	8	MS	87.5	89.0	13	19	24	16	CL	2.5		VERY STIFF GRAY SILTY CLAY, TRACE OF FINE TO MEDIUM SAND.	
	9	MS	90.0	91.5	12	17	21	11	CL	3.25	92.0		
95	10	MS	92.5	94.0	12	25	35	16	CL	2.0	94.5	STIFF BROWN MOTTLED GRAY SILTY CLAY, SOME FINE TO COARSE SAND. TRACE OF ROOTS.	
	11	MS	95.0	96.5	9	12	25	18	CL	0.5		MEDIUM STIFF TO VERY STIFF BROWN MOTTLED GRAY SILTY CLAY.	
100	12	MS	97.5	99.0	13	19	26	18	CL	2.5	99.0	SOFT BROWN SANDY SILTY CLAY.	
	13	MS	100.0	101.5	13	19	27	18	CL	0.5	101.5	BOTTOM OF BORING AT 101.5 FT.	
105												NOTES:	
												1. BORING DRILLED USING MUD ROTARY METHOD.	
												2. UPON COMPLETION, BORING WAS CONVERTED TO 4-INCH DIAMETER PVC OBSERVATION WELL. SEE 64B(3) OBSERVATION WELL DETAILS.	

LOG OF EXPLORATORY BORING

PROJECT NUMBER 505-0.2
BY HCW DATE 6/14/82

BORING NO. 65A
SURFACE ELEV. *
(PROJECT DATUM)

CLASSIFICATION DATA			FIELD DATA			Depth in Ft.	Ground Water Levels	Samples	*AERO-GEODETIC: USGS ELEV. 27.4	DESCRIPTION
% Fines (<No.200)	Liquid Limit	Plasti-city Index		Compressive Strength (TSF)	Penetra-tion (Blows/Ft.)					
					12	5				(CL) Dark brown CLAY with trace of fine sand - damp (gray-brown) (minor silt to fine sand and trace fine gravel)
					15	10	▽	■		(SM) Green-gray silty fine SAND with minor fine gravel - moist to wet
					27	15	■	■		(SW) Brown fine gravelly medium to coarse SAND with 1" to 2" thick silt and fine gravel inter-layers - wet
					17	20	■	■		(gray, silty, fine-grained, no gravel)
					55	25	■	■		(CL) Gray silty CLAY with trace fine gravel - damp to moist
					20	30	■	■		(GC) Brown fine sandy clayey fine GRAVEL - wet
					14	35	■	■		(CL) Brown sandy and fine gravelly CLAY - damp (green-gray, silty with minor sand)
						40				BOTTOM OF BORING

REMARKS: Boring was converted to a ground-water monitoring well by installation of 34' of 4" PVC casing. The lower 5' of casing is unslotted with a 10' section of slotted casing above. The annular space was backfilled with gravel to a depth of 7'. A bentonite-concrete seal was placed in the annular space from 7' to the surface.



Canonie

Boring Log

PRELIMINARY

PROJECT No. CES 82-023

BORING NO. 79A

PAGE 1 OF 2

PROJECT NAME FAIRCHILD CAMERA AND INSTRUMENT CORPORATION, MOUNTAIN VIEW, CA

BORING LOCATION N 333.420 E 1.547.825 SURFACE ELEV.

DRILLER ALL TERRAIN DRILLING DATE: START 7-29-85 FINISH 7-29-85

DEPTH	SAMPLE			BLOW COUNT			RECOVERY IN INCHES	U.S.C.S. SOIL TYPE	PERCENT MOISTURE	qu TSF	CONTACT DEPTH	SOIL DESCRIPTION AND REMARKS	PIEZO
	No.	Type	Interval	0	6	12							
	From	To		6	12	18							
											0.3	ASPHALT.	
											5.0	(FILL MATERIAL)	
5	1	MS*	5.0	6.5	10	19	20	18	CL	3.0			
											10.0	VERY STIFF BROWN SILTY CLAY.	
	2	MS	7.5	9.0	13	14	19	18	CL	-3.0			
10	3	MS	10.0	11.5	10	16	14	18	CL	3.5		VERY STIFF GRAY SILTY CLAY, SOME MEDIUM TO COARSE SAND.	
	4	MS	12.5	14.0	4	4	4	18	SM		12.5	GRAY SILTY FINE TO COARSE SAND, WET.	
	5	MS	15.0	16.5	4	6	8	18	SM/SC		15.5	GRAY MOTTLED BROWN CLAYEY FINE TO MEDIUM SAND.	
	6	MS	16.5	18.0	10	23	41	18	SC/SW		17.5		
	7	MS	18.0	19.5	21	25	19	15	SW			GRAY FINE TO COARSE SAND, TRACE OF FINE GRAVEL.	
20	8	MS	19.5	21.0	6	8	18	18	SW/ML		20.5		
	9	MS	22.0	23.5	11	10	9	18	ML	0.75	23.5	GRAY FINE SANDY SILT, WET.	
	10	PB*	23.5	27.5				48	CL	0.75		MEDIUM STIFF GRAY FINE SANDY SILTY CLAY, TRACE OF ROOTS, TRACE OF SHELLS.	
	11	PB	27.5	31.5				0			31.5		
30	12	PB	31.5	35.5				40	CL	0.75	34.5	MEDIUM STIFF GRAY MOTTLED BROWN FINE SANDY SILTY CLAY, TRACE OF ROOTS.	
	13	PB	35.5	39.5				0				GRAY FINE SANDY SILTY CLAY, TRACE OF ROOTS. (SILTY CLAY)	
40											39.5	BOTTOM OF BORING AT 39.5 FT.	

Canonie

Boring Log

PROJECT No. CES 82-023

BORING No. 79A

PAGE 2 OF 2

PROJECT NAME FAIRCHILD CAMERA AND INSTRUMENT CORPORATION, MOUNTAIN VIEW, CA

BORING LOCATION N 333.420 F 1.547.825 SURFACE ELEV.

DRILLER ALL TERRAIN DRILLING **DATE:** START 7-29-85 **FINISH** 7-29-85

Canonie

Boring Log

PRELIMINARY

PROJECT NO. CE 82-023
 BORING NO. 2C(MEW-82(A))
 PAGE 1 OF 5

PROJECT NAME FAIRCHILD CAMERA AND INSTRUMENT CORPORATION, MOUNTAIN VIEW, CALIFORNIA
 BORING LOCATION N 33° 6.95' E 1,548.307 SURFACE ELEV. 28.6
 DRILLER ALL TERRAIN DRILLING DATE: START 7-30-85 FINISH 8-05-85

DEPTH	SAMPLE		BLOW COUNT			RECOVERY IN INCHES	U.S.C.S. SOIL TYPE	PERCENT MOISTURE	QU TSF	CONTACT DEPTH	SOIL DESCRIPTION AND REMARKS	PIEZO
	NO.	TYPE	INTERVAL		0							
			FROM	TO	6	12	18					
0											(FILL MATERIAL).	
5										4.0		
	1	PB	4.5	7.0		30	CL	3.0			VERY STIFF BROWN SILTY CLAY. SOME FINE TO COARSE GRAVEL.	
	2	PB	7.0	9.5		30	CL	2.0	8.0			
10	3	PB	9.5	12.0		30	SM&GM			10.0	GRAY SILTY FINE TO COARSE SAND AND FINE TO COARSE GRAVEL.	
	4	PB	12.0	14.5		30	CL	2.0			VERY STIFF BROWN MOTTLED GRAY SILTY CLAY.	
15	5	PB	14.5	17.0		30	SW&GW			14.5		
	6	PB	17.0	19.5		30	SW&GW					
20	7	PB	19.5	22.0		30	SW&GW				GRAY FINE TO COARSE SAND AND FINE TO COARSE GRAVEL (WET).	
	8	PB	22.0	24.5		6	SW&GW					
25	9	PB	24.5	27.0		6	SW&GW					
	10	PB	27.0	29.5		6	SW&GW			27.5	(BROWN SANDY SILTY CLAY).	
30	11	PB	29.5	32.0		6	SW&GW			28.5		
	12	PB	32.0	34.5		18	CL	0.5			GRAY FINE TO COARSE SAND AND FINE TO COARSE GRAVEL (WET).	
35	13	PB	34.5	37.0		30	CL	1.0				
	14	PB	37.0	39.5		30	CL	1.5			MEDIUM STIFF TO VERY STIFF GRAY SILTY CLAY.	
40	15	PB	39.5	42.0		30	CL	2.5				

Canonie

Boring Log

PROJECT No. CE 82-023
 BORING No. 2C(MEW-82(A))
 PAGE 2 OF 5

PROJECT NAME FAIRCHILD CAMERA AND INSTRUMENT CORPORATION, MOUNTAIN VIEW, CALIFORNIA

BORING LOCATION SURFACE ELEV.

DRILLER ALL TERRAIN DRILLING DATE: START 7-30-85 FINISH 8-05-85

DEPTH	SAMPLE		BLOW COUNT			RECOVERY IN INCHES	U.S.C.S. SOIL TYPE	PERCENT MOISTURE	QU TSF	CONTACT DEPTH	SOIL DESCRIPTION AND REMARKS	PIEZO
	No.	Type	Interval	0	6	12						
			From	To	6	12	18					
40												
45	16	PB	42.0	44.5			30	CL	2.5			
	17	PB	44.5	47.0			30	CL	3.0			
	18	PB	47.0	49.5			30	CL	1.5		MEDIUM STIFF TO VERY STIFF GRAY SILTY CLAY.	
50	19	PB	49.5	52.0			30	CL	2.0			
	20	PB	52.0	54.5			30	CL	2.0			
55	21	PB	54.5	57.0			30	SM	2.5			
	22	PB	57.0	59.5			30	SM	1.25		GRAY SILTY FINE SAND.	
60	23	PB	59.5	62.0			30	CL	3.25			
	24	PB	62.0	64.5			30	CL	3.0			
65	25	PB	64.5	67.0			30	CL	2.0		64.5 BROWN FINE TO COARSE SAND (WET).	
	26	PB	67.0	69.5			30	SW	2.0		65.5	
70	27	PB	69.5	72.0			30	CL	2.5			
	28	PB	72.0	74.5			30	CL	2.0			
75	29	PB	74.5	77.0			30	CL	2.5		74.5	
	30	PB	77.0	79.5			30	SW	2.5			
80	31	PB	79.5	82.0			30	SW	2.0			

Canonie

Boring Log

PROJECT No. CE 82-023
 BORING No. 2C (MEN-92A)
 PAGE 3 OF 6

PROJECT NAME FAIRCHILD CAMERA AND INSTRUMENT CORPORATION, MOUNTAIN VIEW, CALIFORNIA

BORING LOCATION SURFACE ELEV.
 DRILLER ALL TERRAIN DRILLING DATE: START 7-30-85 FINISH 8-05-85

DEPTH	SAMPLE		BLOW COUNT			RECOVERY IN INCHES	U.S.C.S. SOIL TYPE	PERCENT MOISTURE	QU TSF	CONTACT DEPTH	SOIL DESCRIPTION AND REMARKS	PIEZO
	No.	Type	Interval From	To	6	12	18					
80												
	32	PB	82.0	84.5			30	CL	2.0	82.5		
85	33	PB	84.5	87.0			30	CL	2.5			
	34	PB	87.0	89.5			30	CL	3.0			
90	35	PB	89.5	92.0			30	CL	4.5			
	36	PB	92.0	94.5			30	CL	4.5			
95	37	PB	94.5	97.0			30	CL	2.5			
	38	PB	97.0	99.5			30	CL	2.0			
100	39	PB	100.0	102.0			0	CL	2.0			
	40	PB	102.0	104.0			24	CL	1.5			
105	41	PB	104.5	106.5			30	CL	2.0	105.5	BROWN SILTY FINE SAND.	
	42	PB	106.5	109.0			30	SM	3.0	107.0		
110	43	PB	109.0	111.5			30	CL	3.0	109.0	VERY STIFF GRAY SILTY CLAY.	
	44	PB	111.5	114.0			30	SW	3.0	111.0	BROWN FINE TO COARSE SAND (WET).	
115	45	PB	114.0	116.5			30	CL	2.5	115.5		
	46	PB	116.5	119.0			30	SW	3.5	116.5	VERY STIFF BROWN SILTY CLAY.	
120	47	PB	119.0	121.5			30	CL	3.0	119.0	BROWN SILTY FINE SAND.	
											VERY STIFF BROWN MOTTLED GRAY SILTY CLAY.	

Canonie

Boring Log

PROJECT No. CE 82-023
 BORING No. 2C(MEW-82(A))
 PAGE 4 OF 5

PROJECT NAME FAIRCHILD CAMERA AND INSTRUMENT CORPORATION, MOUNTAIN VIEW, CALIFORNIA

BORING LOCATION _____ SURFACE ELEV. _____

DRILLER ALL TERRAIN DRILLING DATE: START 7-30-85 FINISH 8-05-85

DEPTH	SAMPLE		BLOW COUNT			RECOVERY IN INCHES	U.S.C.S. SOIL TYPE	PERCENT MOISTURE	q TSF	CONTACT DEPTH	SOIL DESCRIPTION AND REMARKS	PIEZOMETER HEAD
	No.	Type	INTERVAL FROM	TO	0							
					6	12						
120												
	48	PB	121.5	124.0			30	CL	3.0	123.0		
125								SM				
	49	PB	124.0	126.5			24	SM				
	50	PB	126.5	129.0			30	SM			GRAY SILTY FINE SAND.	
130							0			133.0		
	51	PB	129.0	133.0								
135												
	52	PB	133.0	135.5			12	CL	2.5			
	53	PB	135.5	138.0			18	CL	3.5			
140											VERY STIFF GRAY SILTY CLAY.	
	54	PB	138.0	142.0			48	CL	3.5			
	55	PB	142.0	146.0			48	CL	3.5			
145												
	56	PB	146.0	150.0			48	CL	3.0			
150												
	57	PB	150.0	154.0			48	CL	2.5			
155												
	58	PB	154.0	158.0			48	CL	3.0			
160												
	59	PB	158.0	162.0			48	CL	3.0			

Canonie

Boring Log

PROJECT No. CE 82-023
BORING No. 2C (new - 8240)
PAGE 5 OF 6

PROJECT NAME FAIRCHILD CAMERA AND INSTRUMENT CORPORATION, MOUNTAIN VIEW, CALIFORNIA
BORING LOCATION SURFACE ELEV.
DRILLER ALL TERRAIN DRILLING DATE: START 7-30-85 FINISH 8-05-85

Canonie

Boring Log

PROJECT No. CE 82-023

BORING No. 2C (NEW 82(A))

PAGE 6 OF 6

PROJECT NAME FAIRCHILD CAMERA AND INSTRUMENT CORPORATION, MOUNTAIN VIEW, CALIFORNIA

BORING LOCATION _____ SURFACE ELEV.

DRILLER ALL TERRAIN DRILLING **DATE:** START 7-30-85 FINISH 8-05-85

DEPTH	SAMPLE		BLOW COUNT			RECOVERY IN INCHES	U.S.C.S. SOIL TYPE	PERCENT MOISTURE	qu TSF	CONTACT DEPTH	SOIL DESCRIPTION AND REMARKS
	No.	Type	INTERVAL	0	6	12					
		FROM	TO	6	12	18					
200										200.5	
										202.0	VERY STIFF BROWN SILTY CLAY.
										202.5	BROWN FINE TO COARSE SAND AND FINE TO COARSE GRAVEL.
205	70	PB	202.0	206.0			36	CL	2.5		
											VERY STIFF GRAY SILTY CLAY.
	71	PB	206.0	210.0			48	CL	2.5		
210										210.0	
											BOTTOM OF BORING AT 210.0 FEET.
											NOTES:
											1. BORING DRILLED USING MUD ROTARY METHOD.
											2. UPON COMPLETION BORING WAS CONVERTED TO OBSERVATION WELL 55B. SEE 55B OBSERVA- TION WELL DETAILS.

N00296.001452
MOFFETT FIELD
SSIC NO. 5090.3


**APPENDIX C – BORING LOGS
GEOPHYSICAL LOGS**

SITE 9 – CPT (IT)


**REMEDIAL INVESTIGATION REPORT
OPERABLE UNIT 4: WEST SIDE AQUIFERS**

DATED 01 AUGUST 1992

JOB # : 409700
DATE : 03/15/80/15:50
LOCATION : CPT9-5
FILE : FIL129

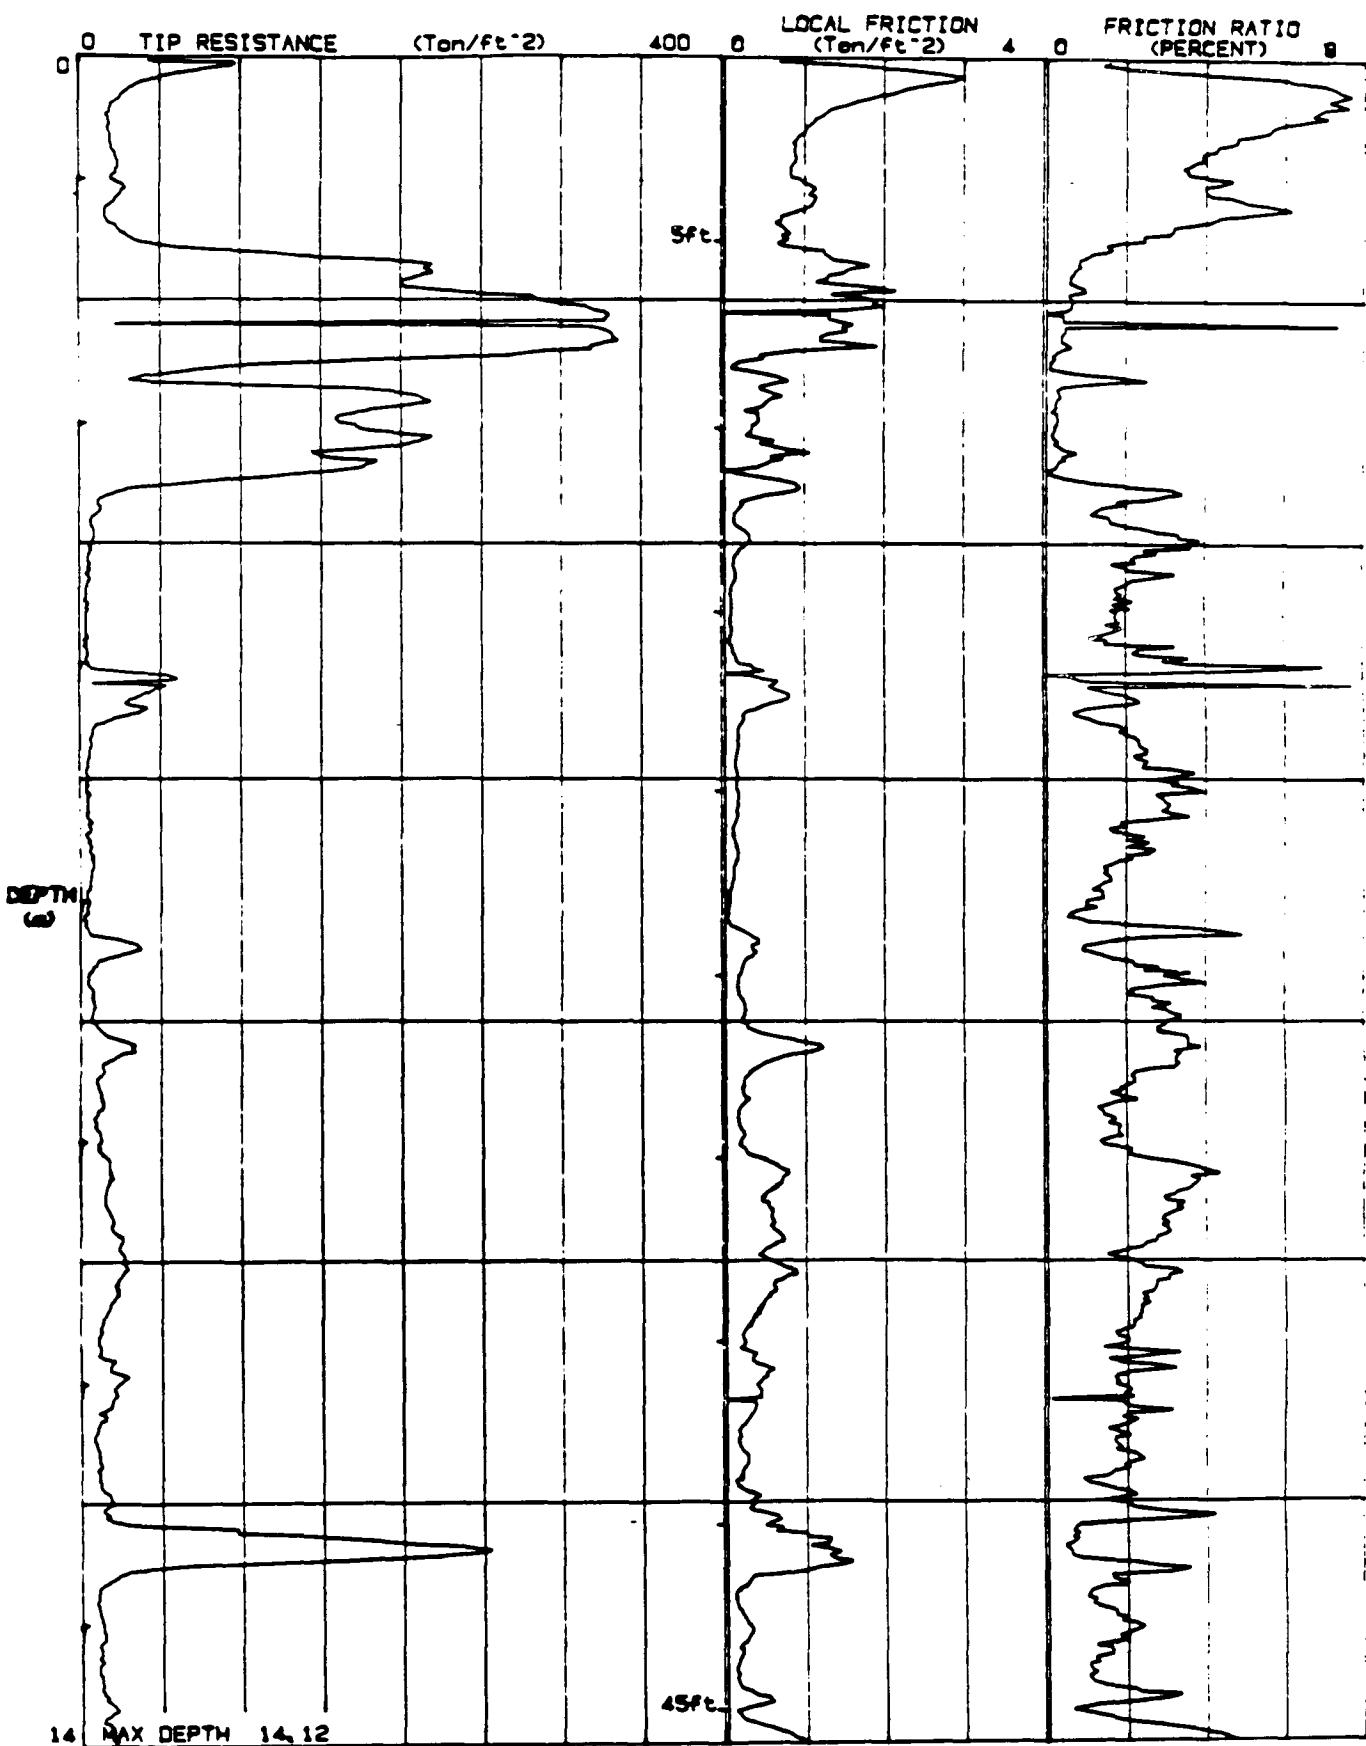


JOB # : 408700
DATE : 09/15/90/15:50
LOCATION : CPTB-3
FILE : FIL129

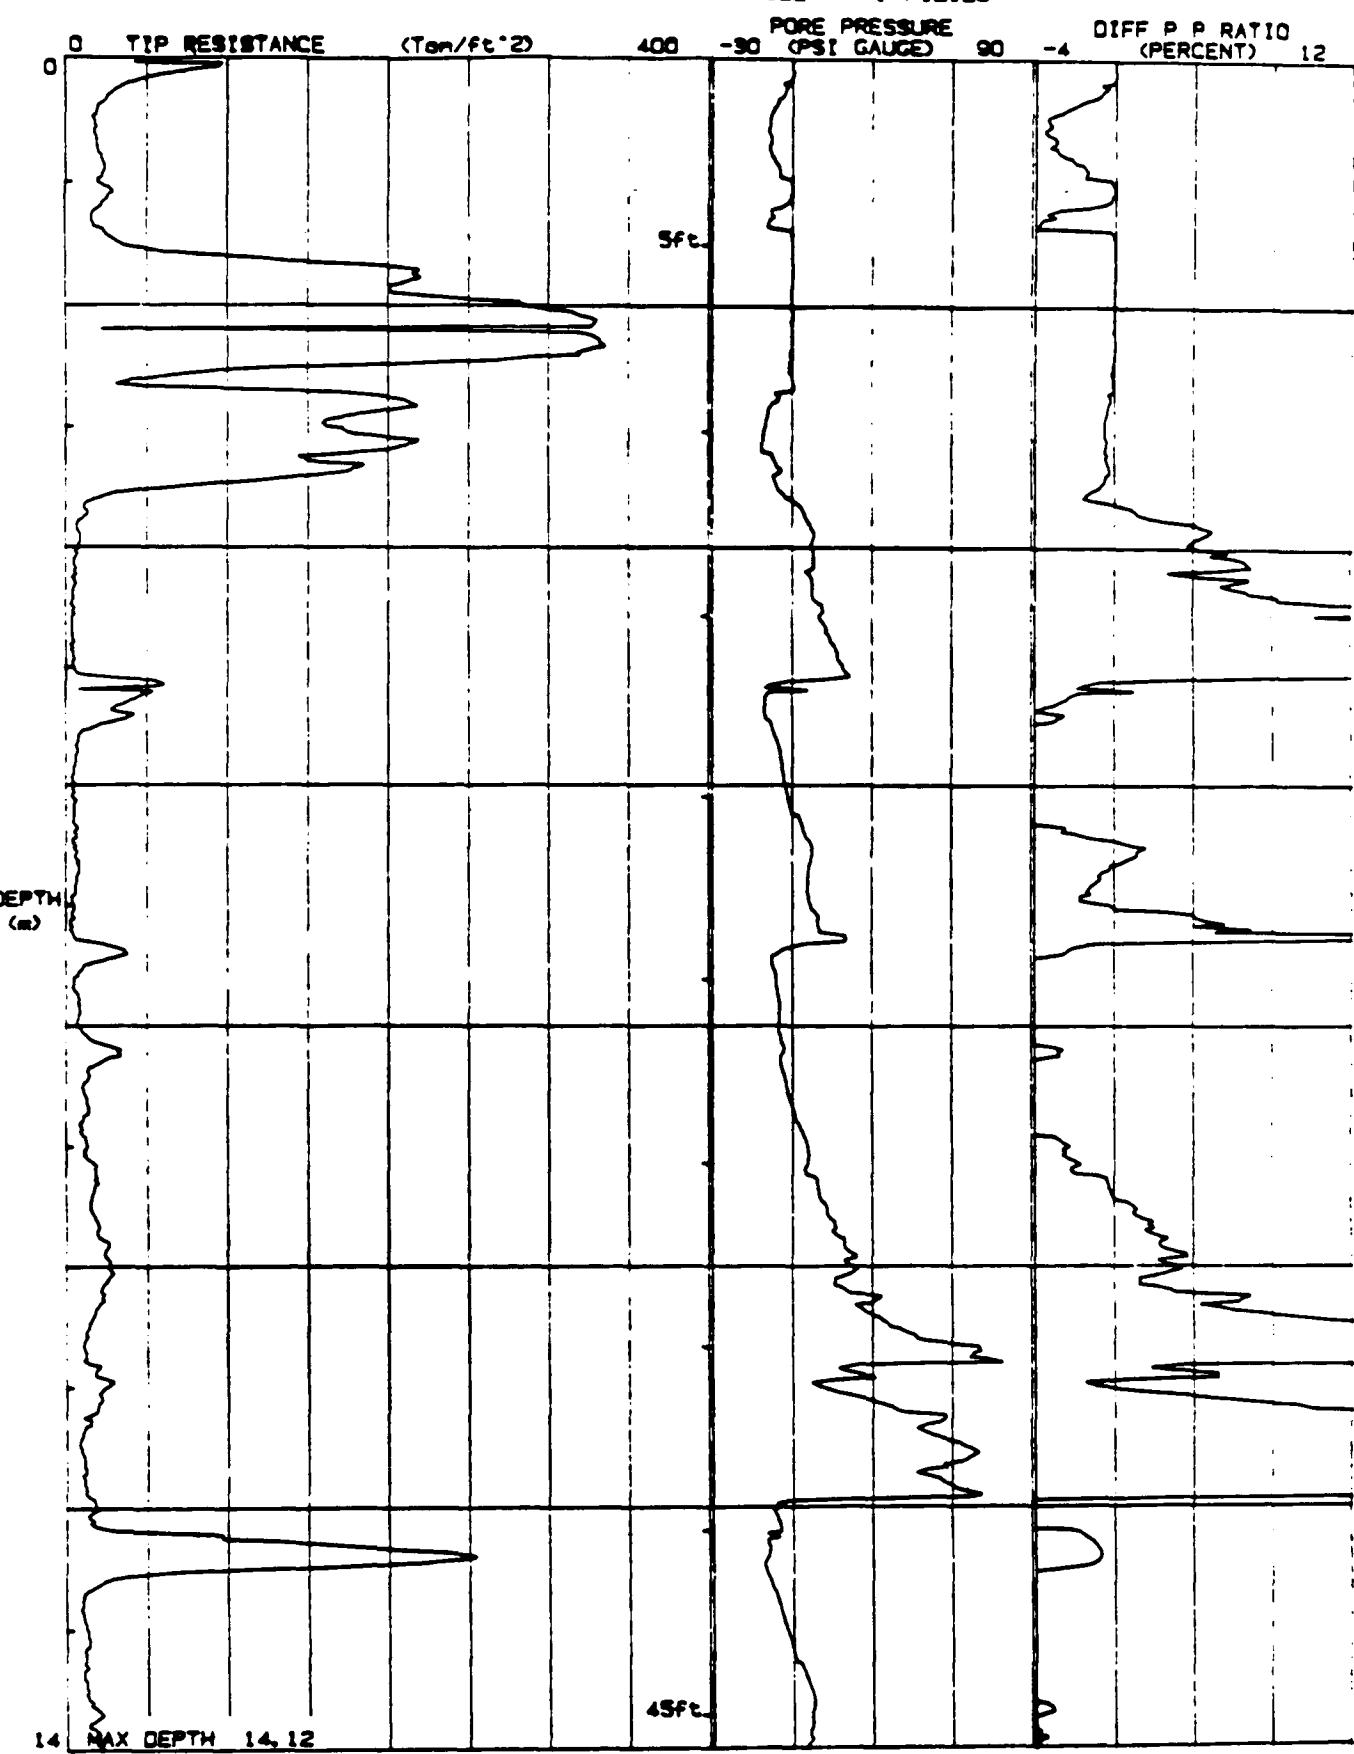


JOB # : 409700
DATE : 01/29/80
LOCATION : CPT/S-S
FILE # : 14




JOB # : 409700
DATE : 01/29/80
LOCATION : CPT/S-8
FILE # : 14

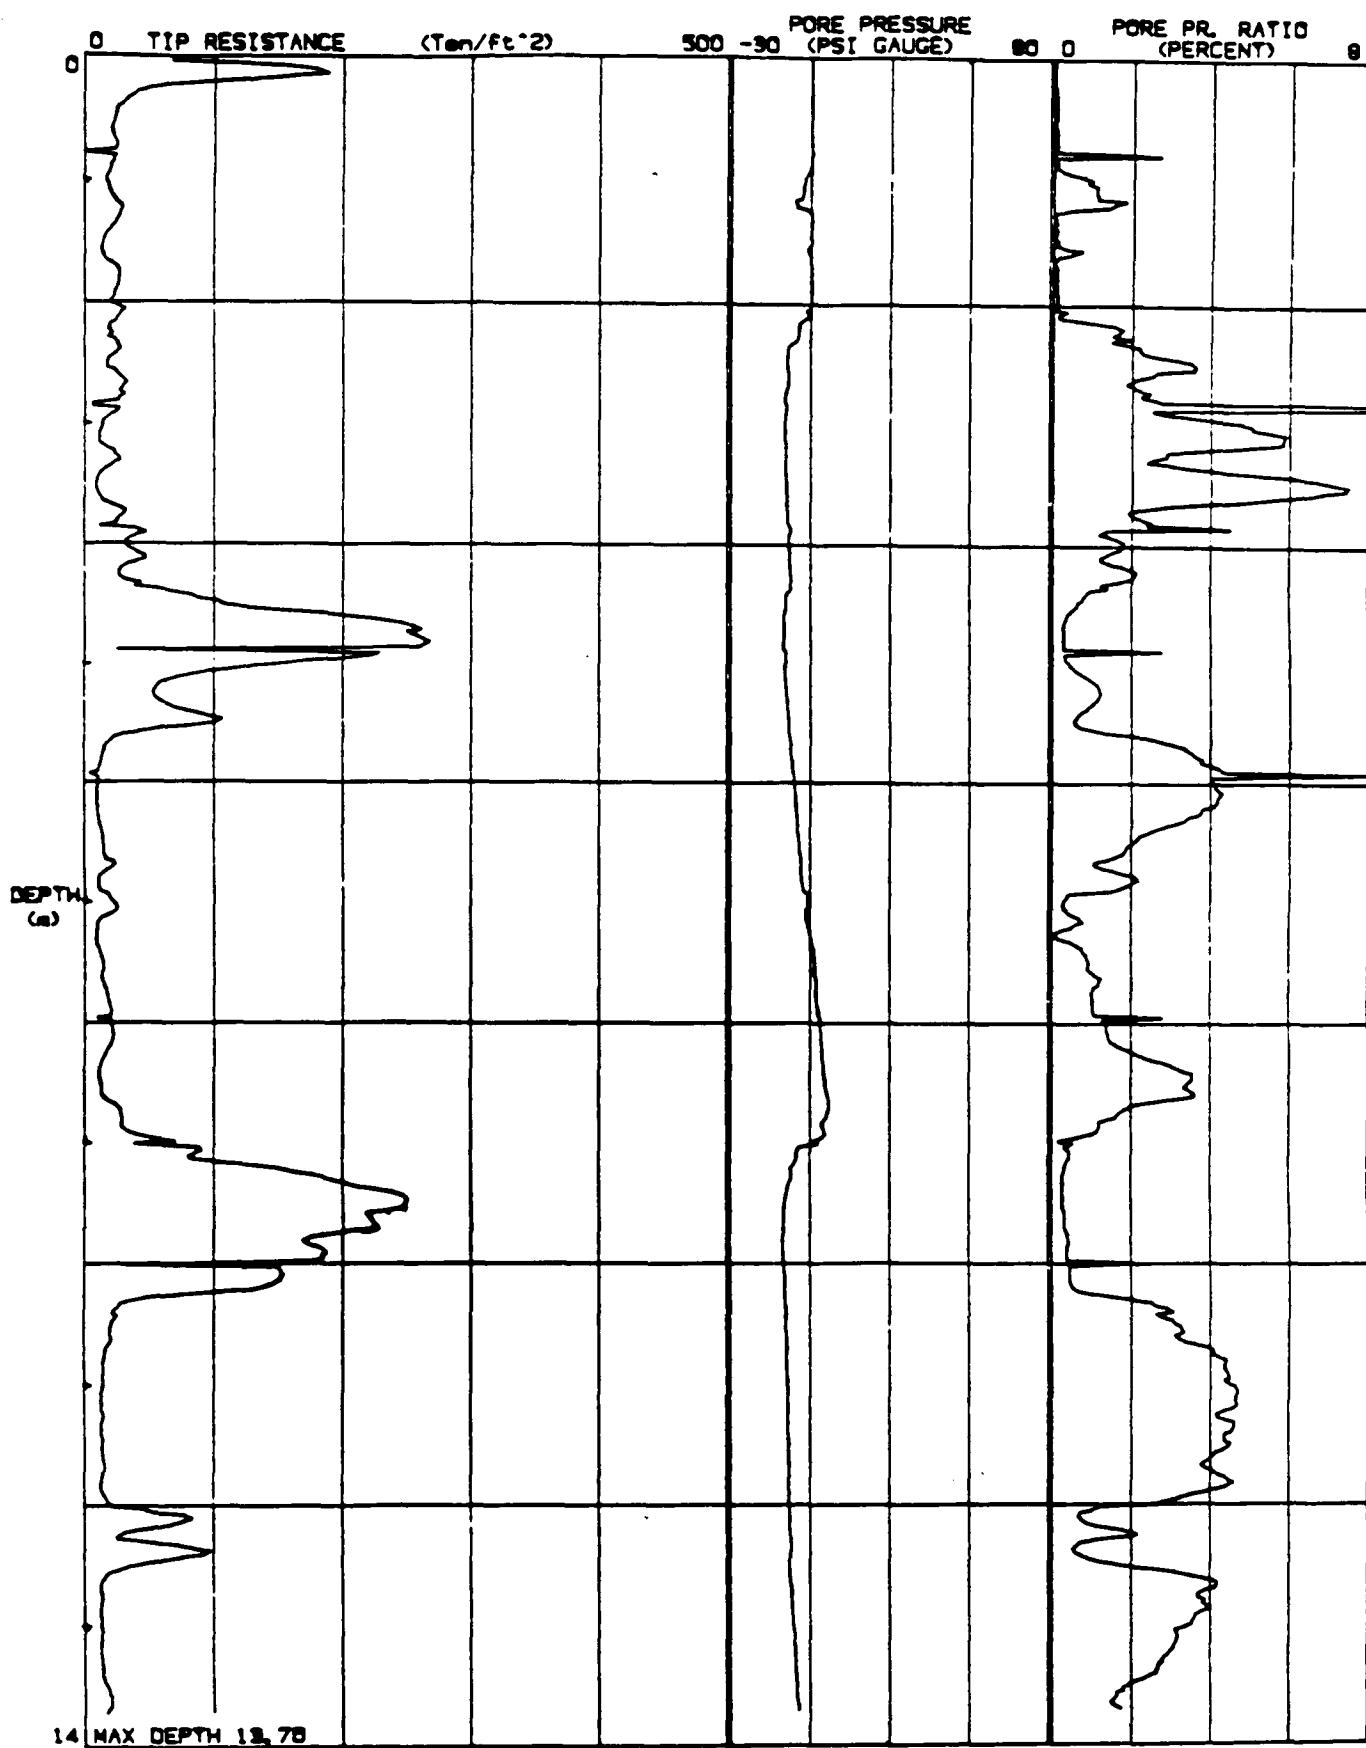


JOB # : 409700
DATE : 03/19/90/17:45
LOCATION : CPT8-8
FILE : FIL137

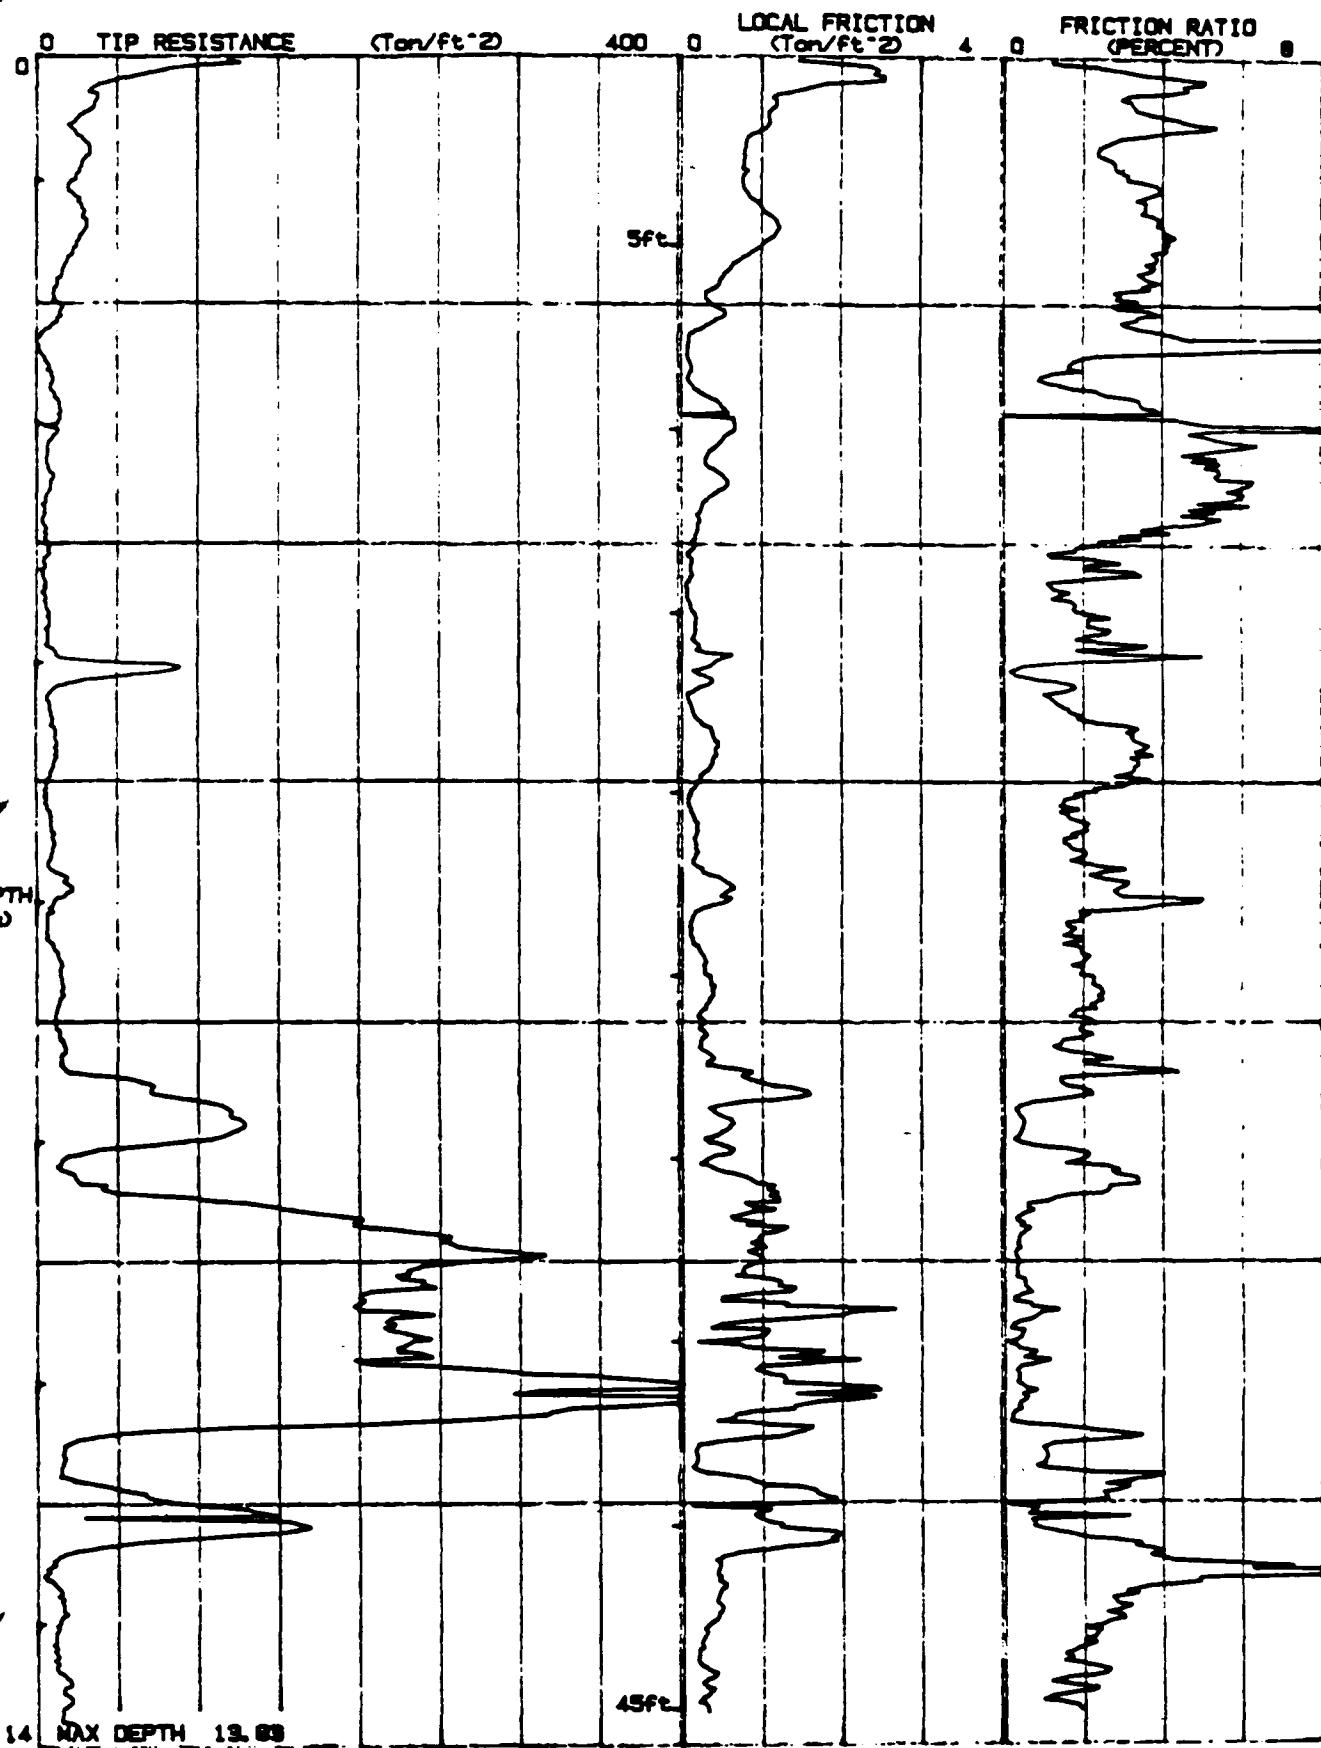


JOB # : 409700
DATE : 03/19/90/17:45
LOCATION : CPTB-9
FILE : FIL137

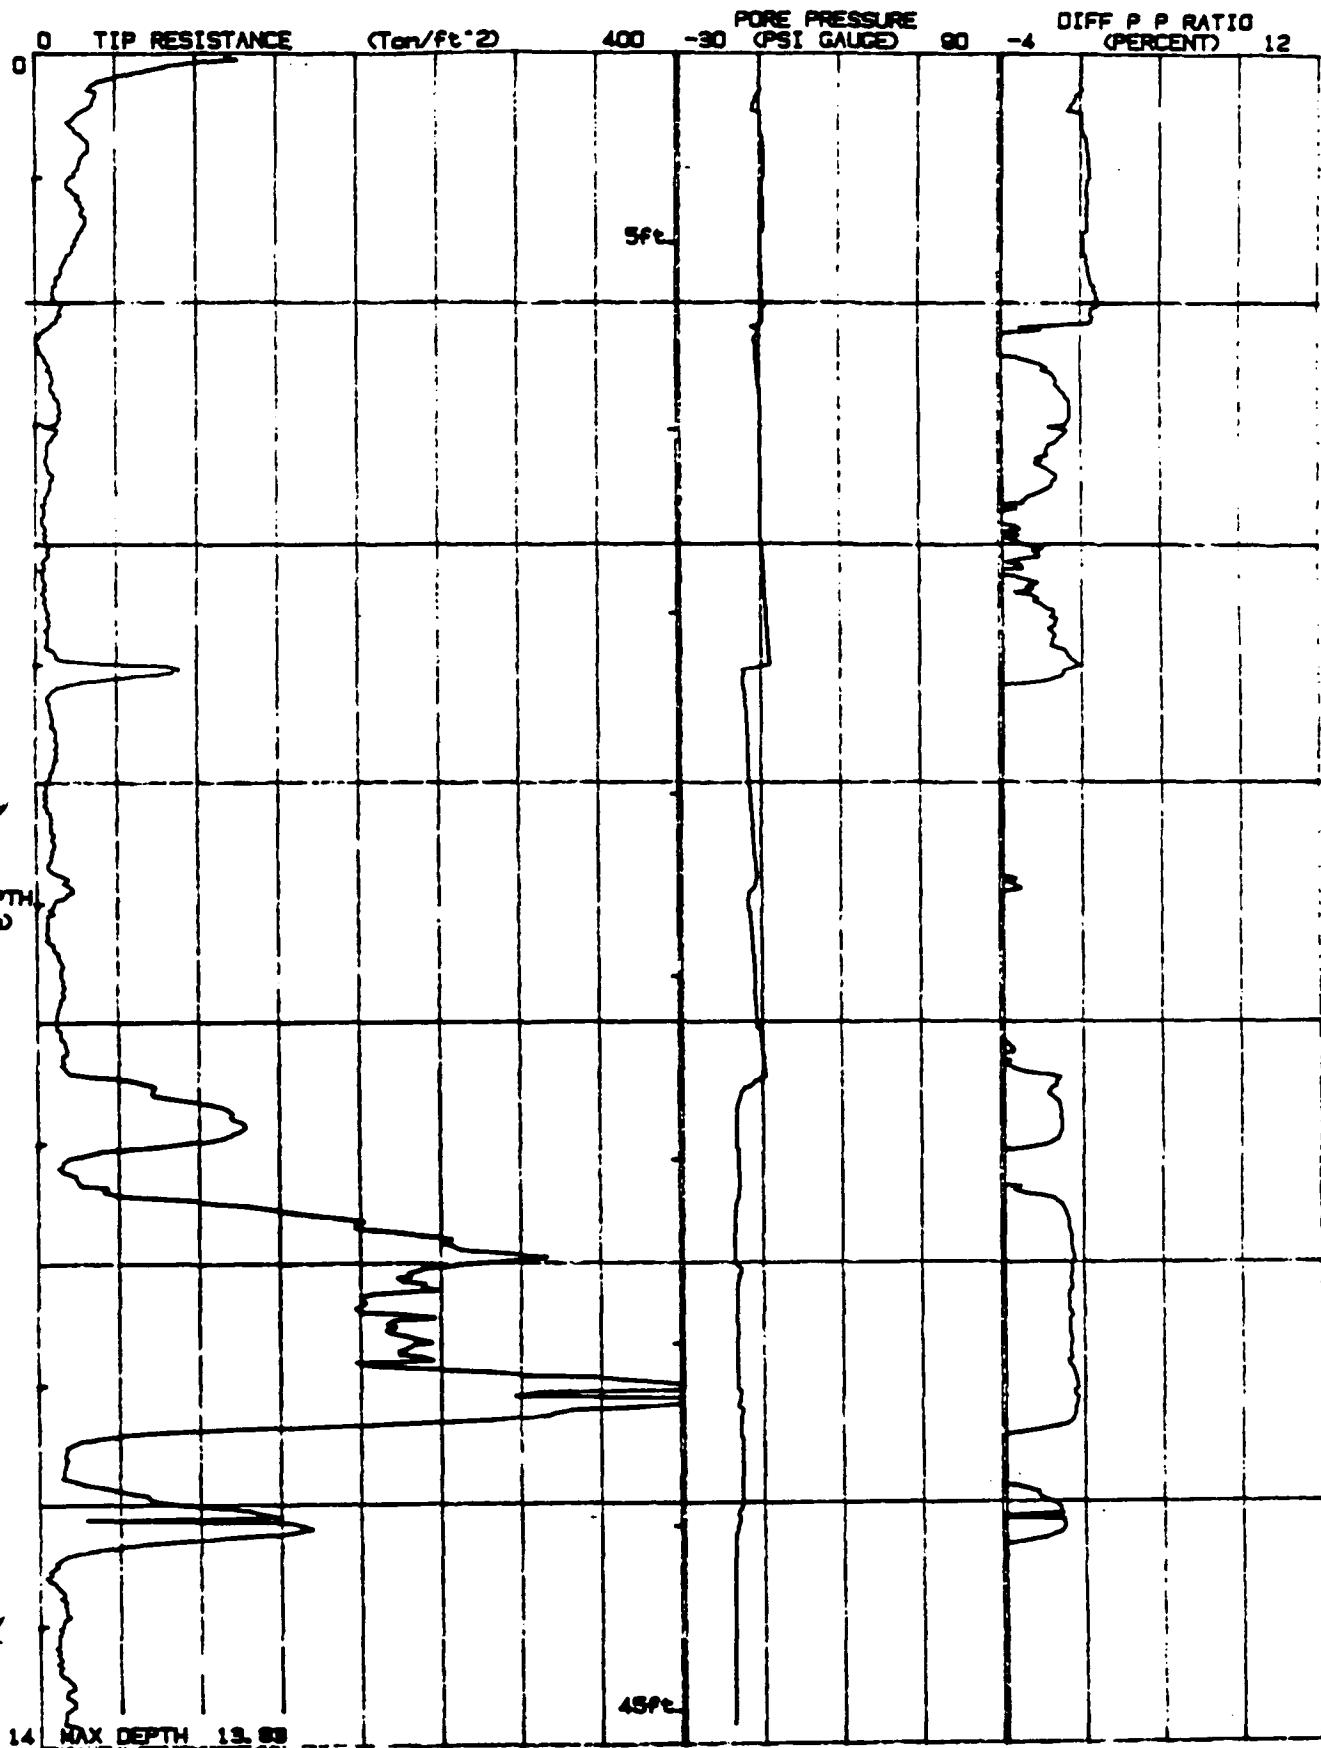


JOB # : 408700
DATE : 03/19/20/16, 18
LOCATION : CPT8-11
FILE : FIL136

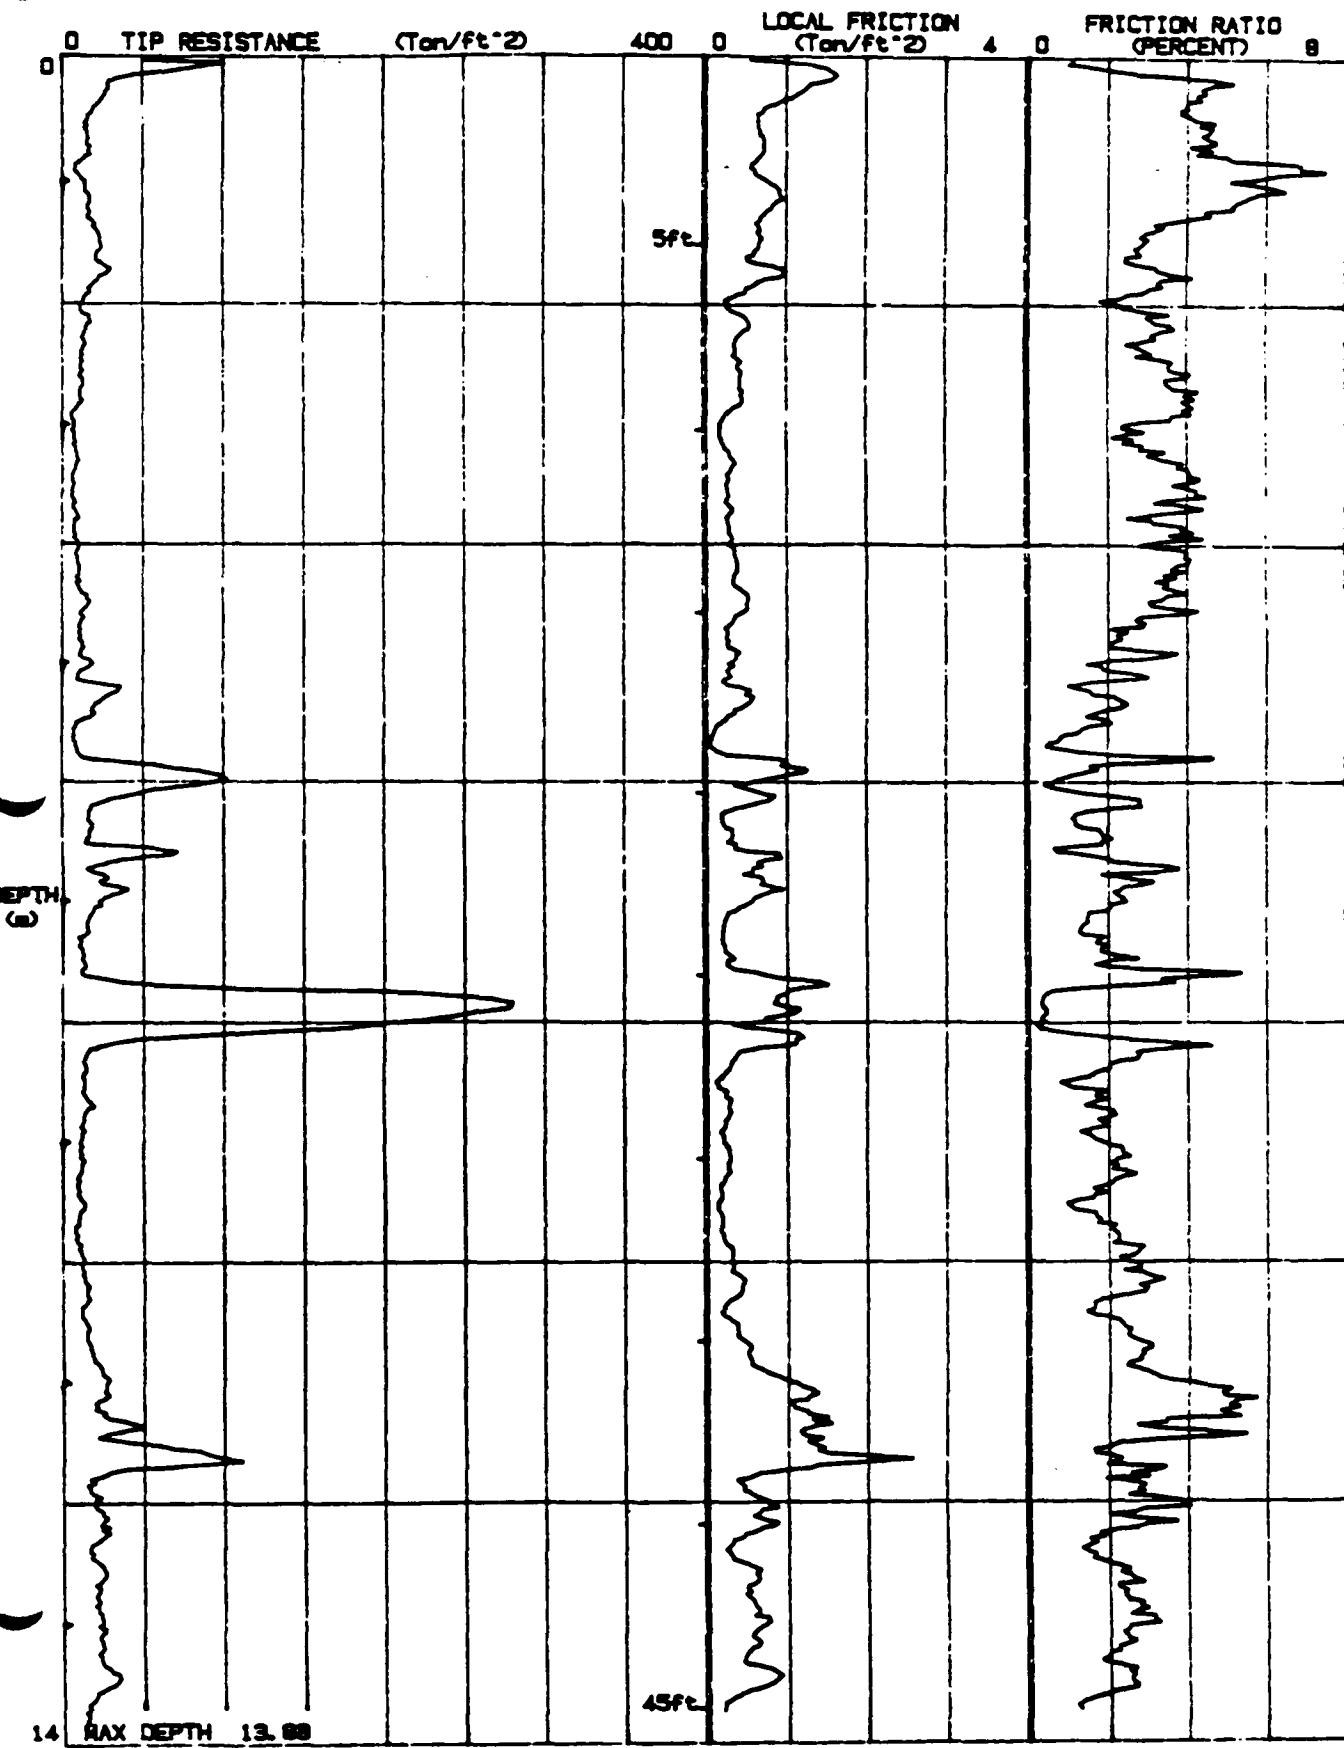


JOB # : 409700
DATE : 03/18/90/18:18
LOCATION : CPTB-11
FILE : FIL138

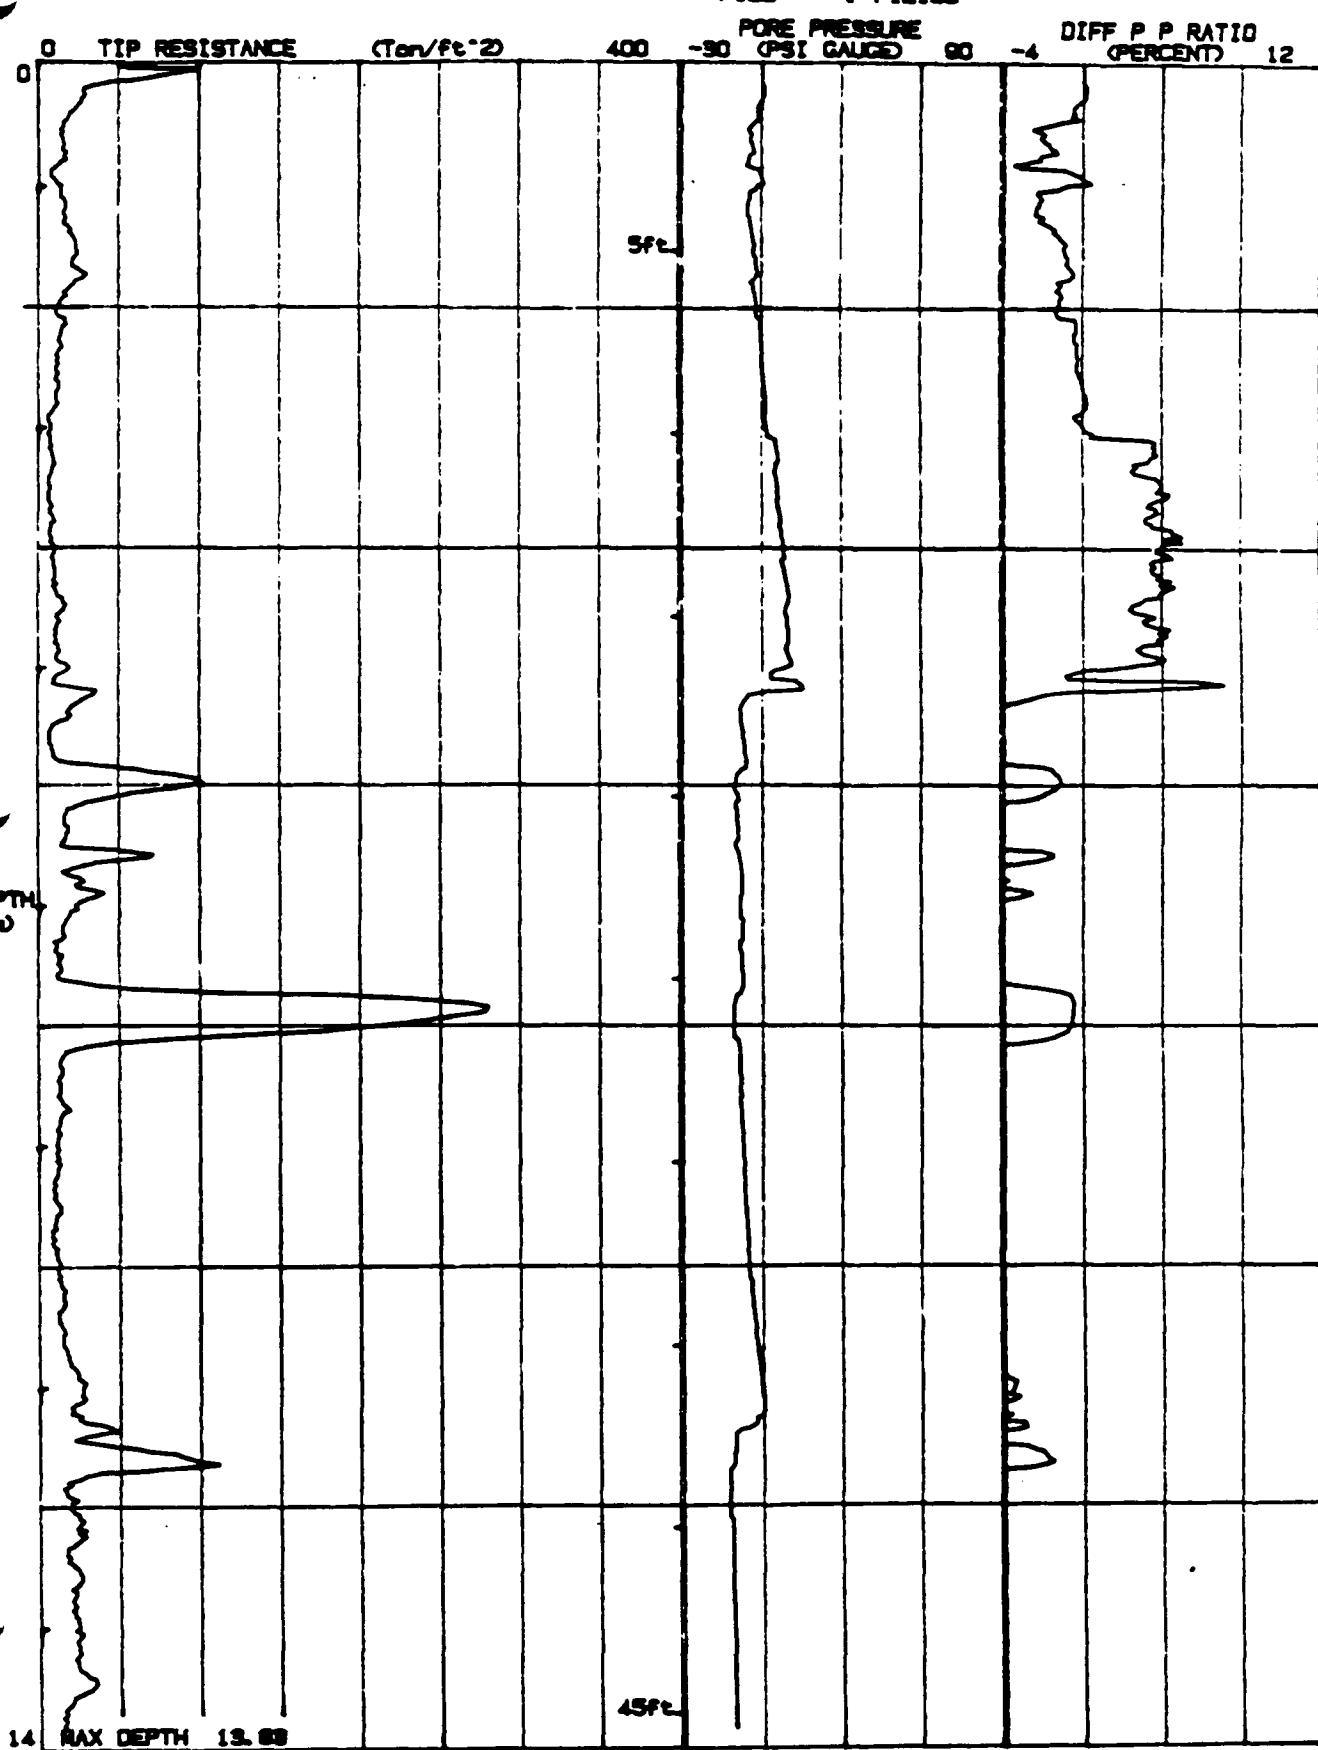


JOB # : 408700
DATE : 03/08/90/11:08
LOCATION : CPT/9-21
FILE : FIL111

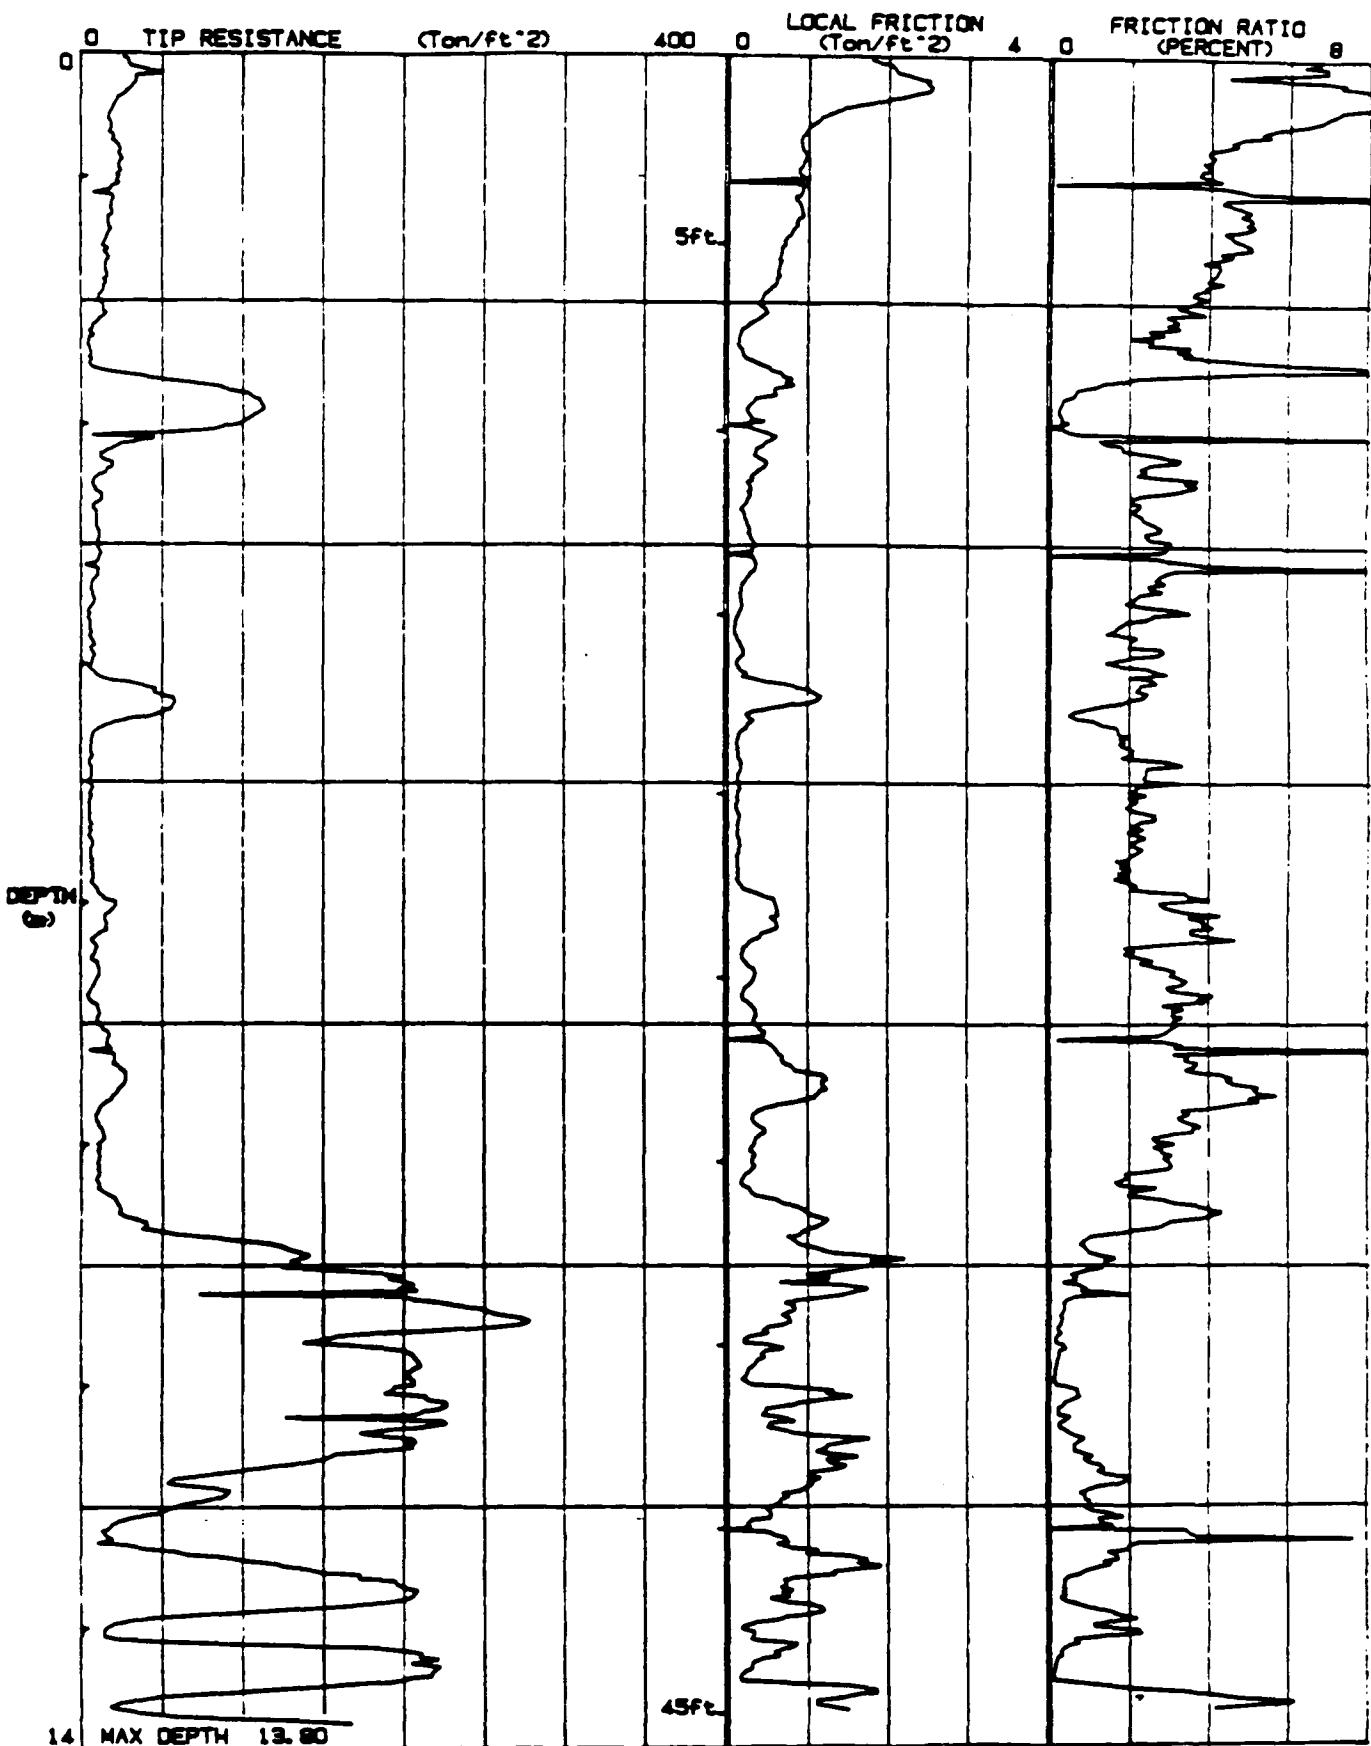


JOB # : 409700
DATE : 03/08/90/11:08
LOCATION : CPT/8-21
FILE : FIL111

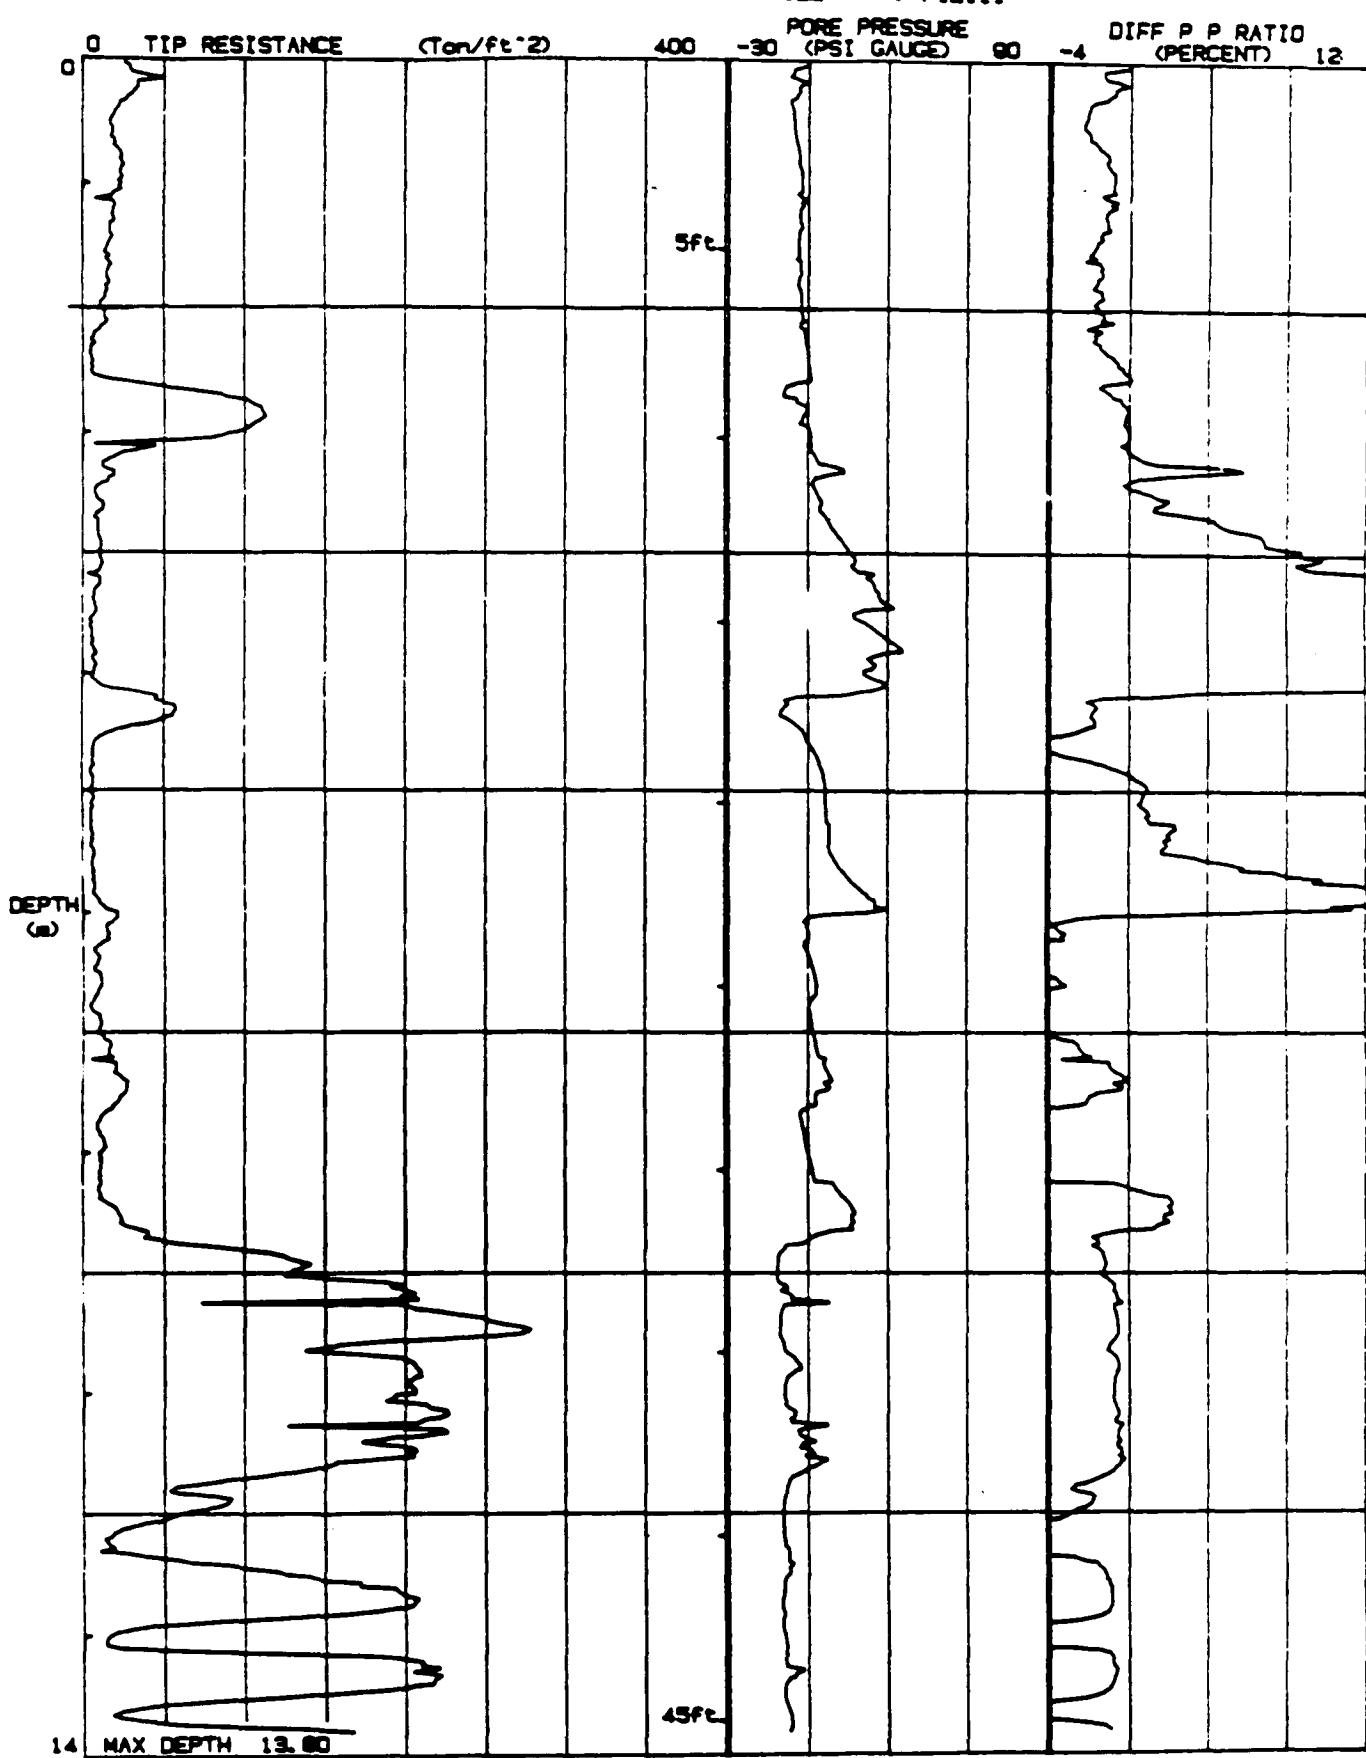


JOB # : 409700
DATE : 03/19/90/11:17
LOCATION : CPT9-22
FILE : FIL134

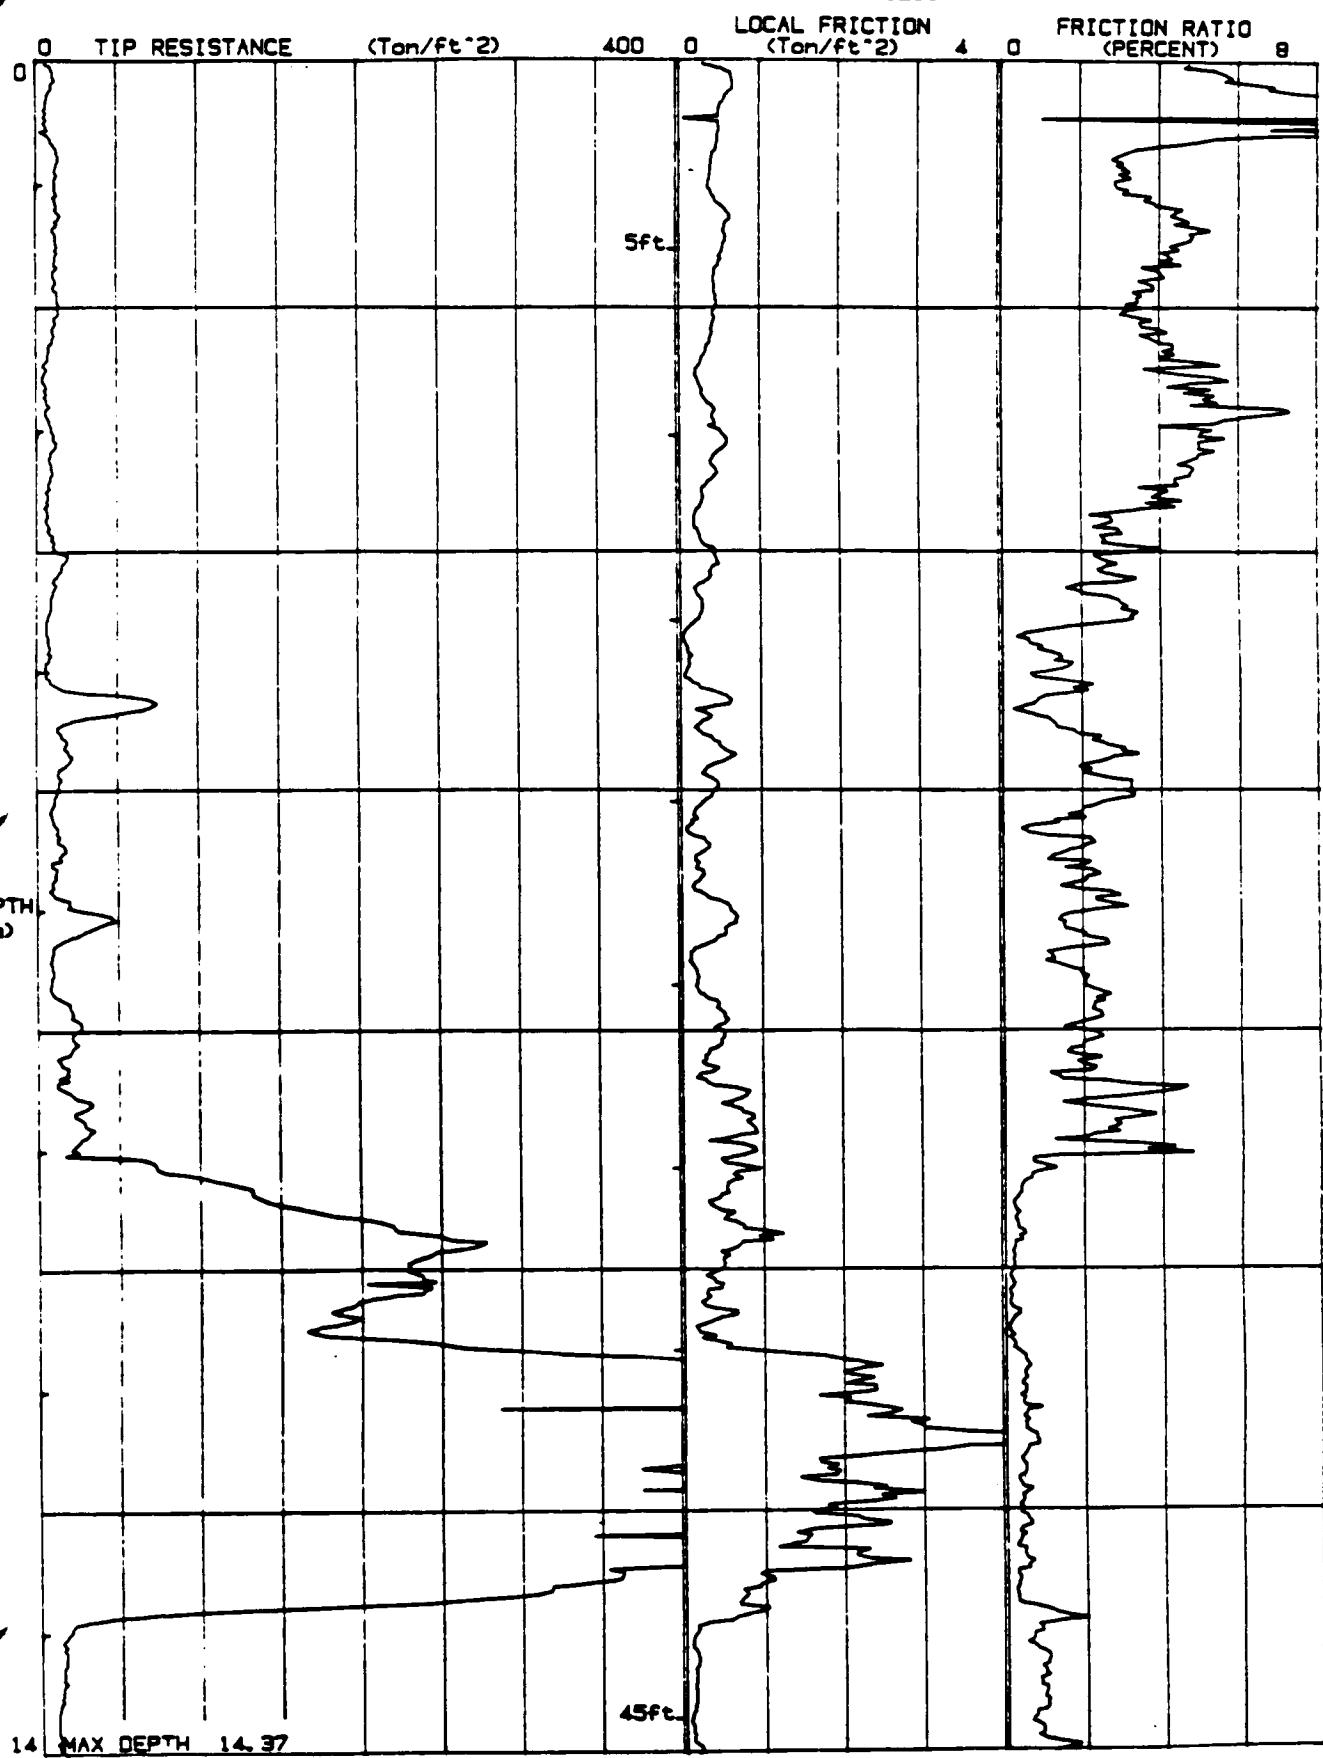

JOB # : 409700
DATE : 03/19/90 11:17
LOCATION : CPT9-22
FILE : FIL134

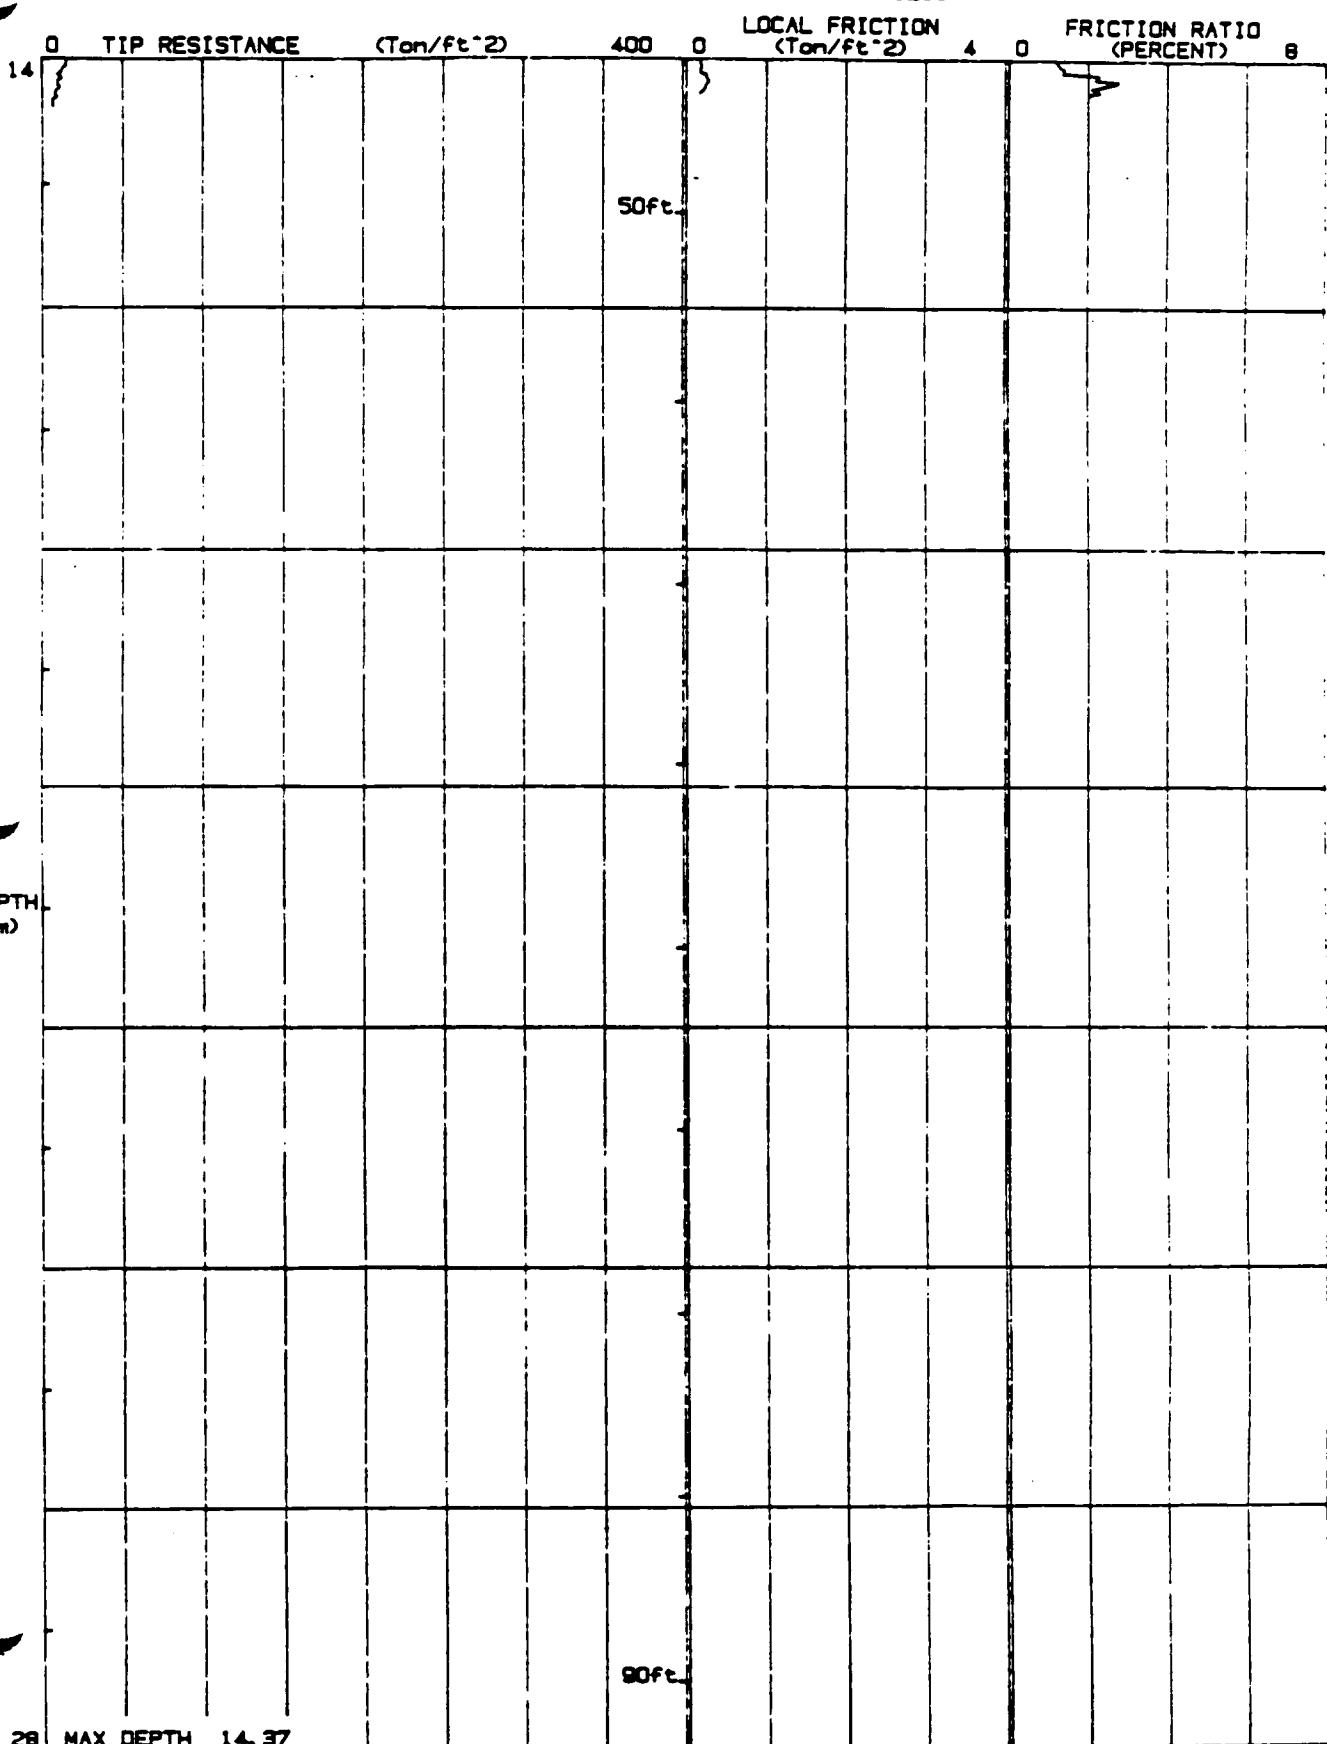


JOB # : 409700
DATE : 03/19/90/11:17
LOCATION : CPT9-22
FILE : FIL134

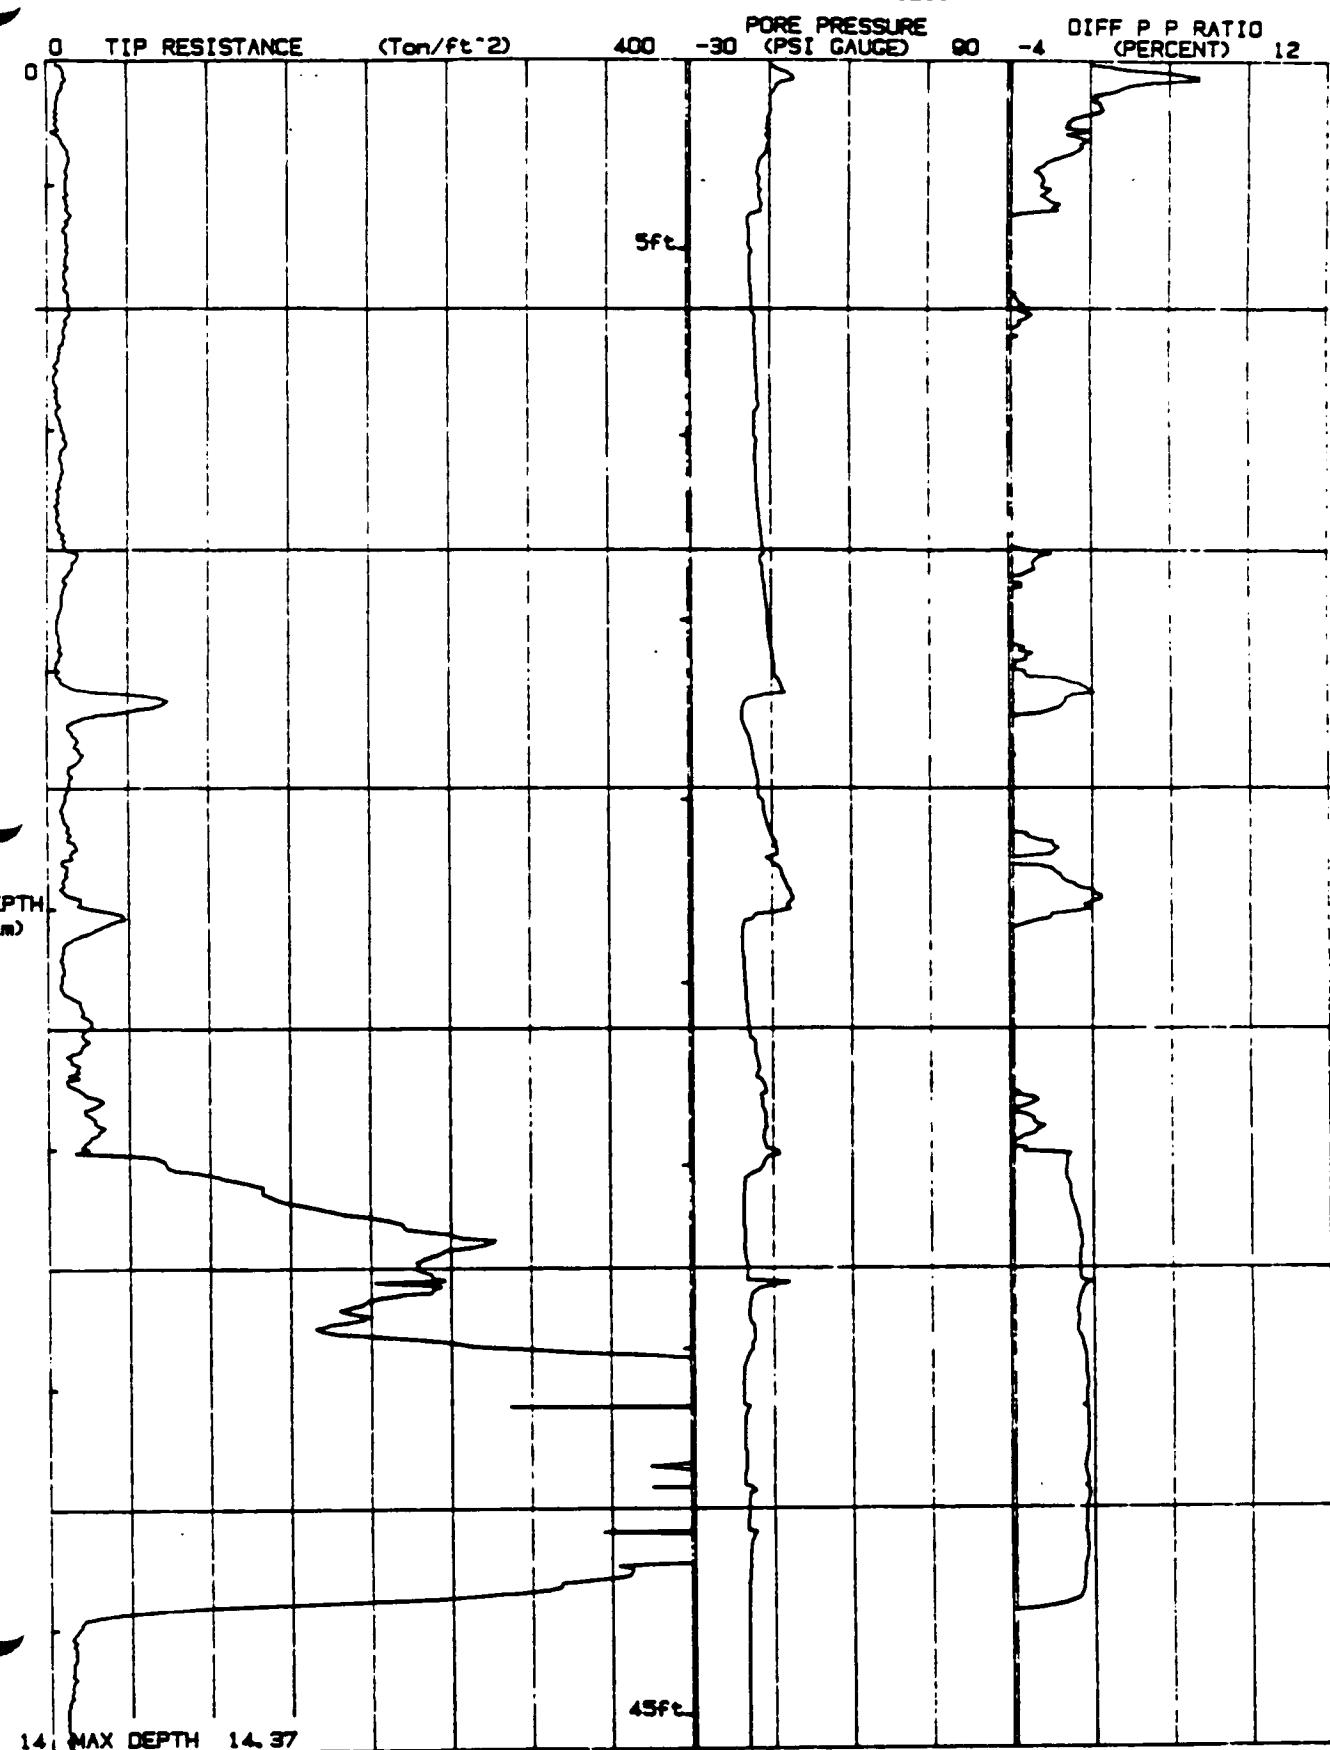


JOB # : 409700
DATE : 03/18/90 11:17
LOCATION : CPT9-22
FILE : FIL134


JOB # : 409700
DATE : 03/19/90/11:17
LOCATION : CPT9-25
FILE : FIL133

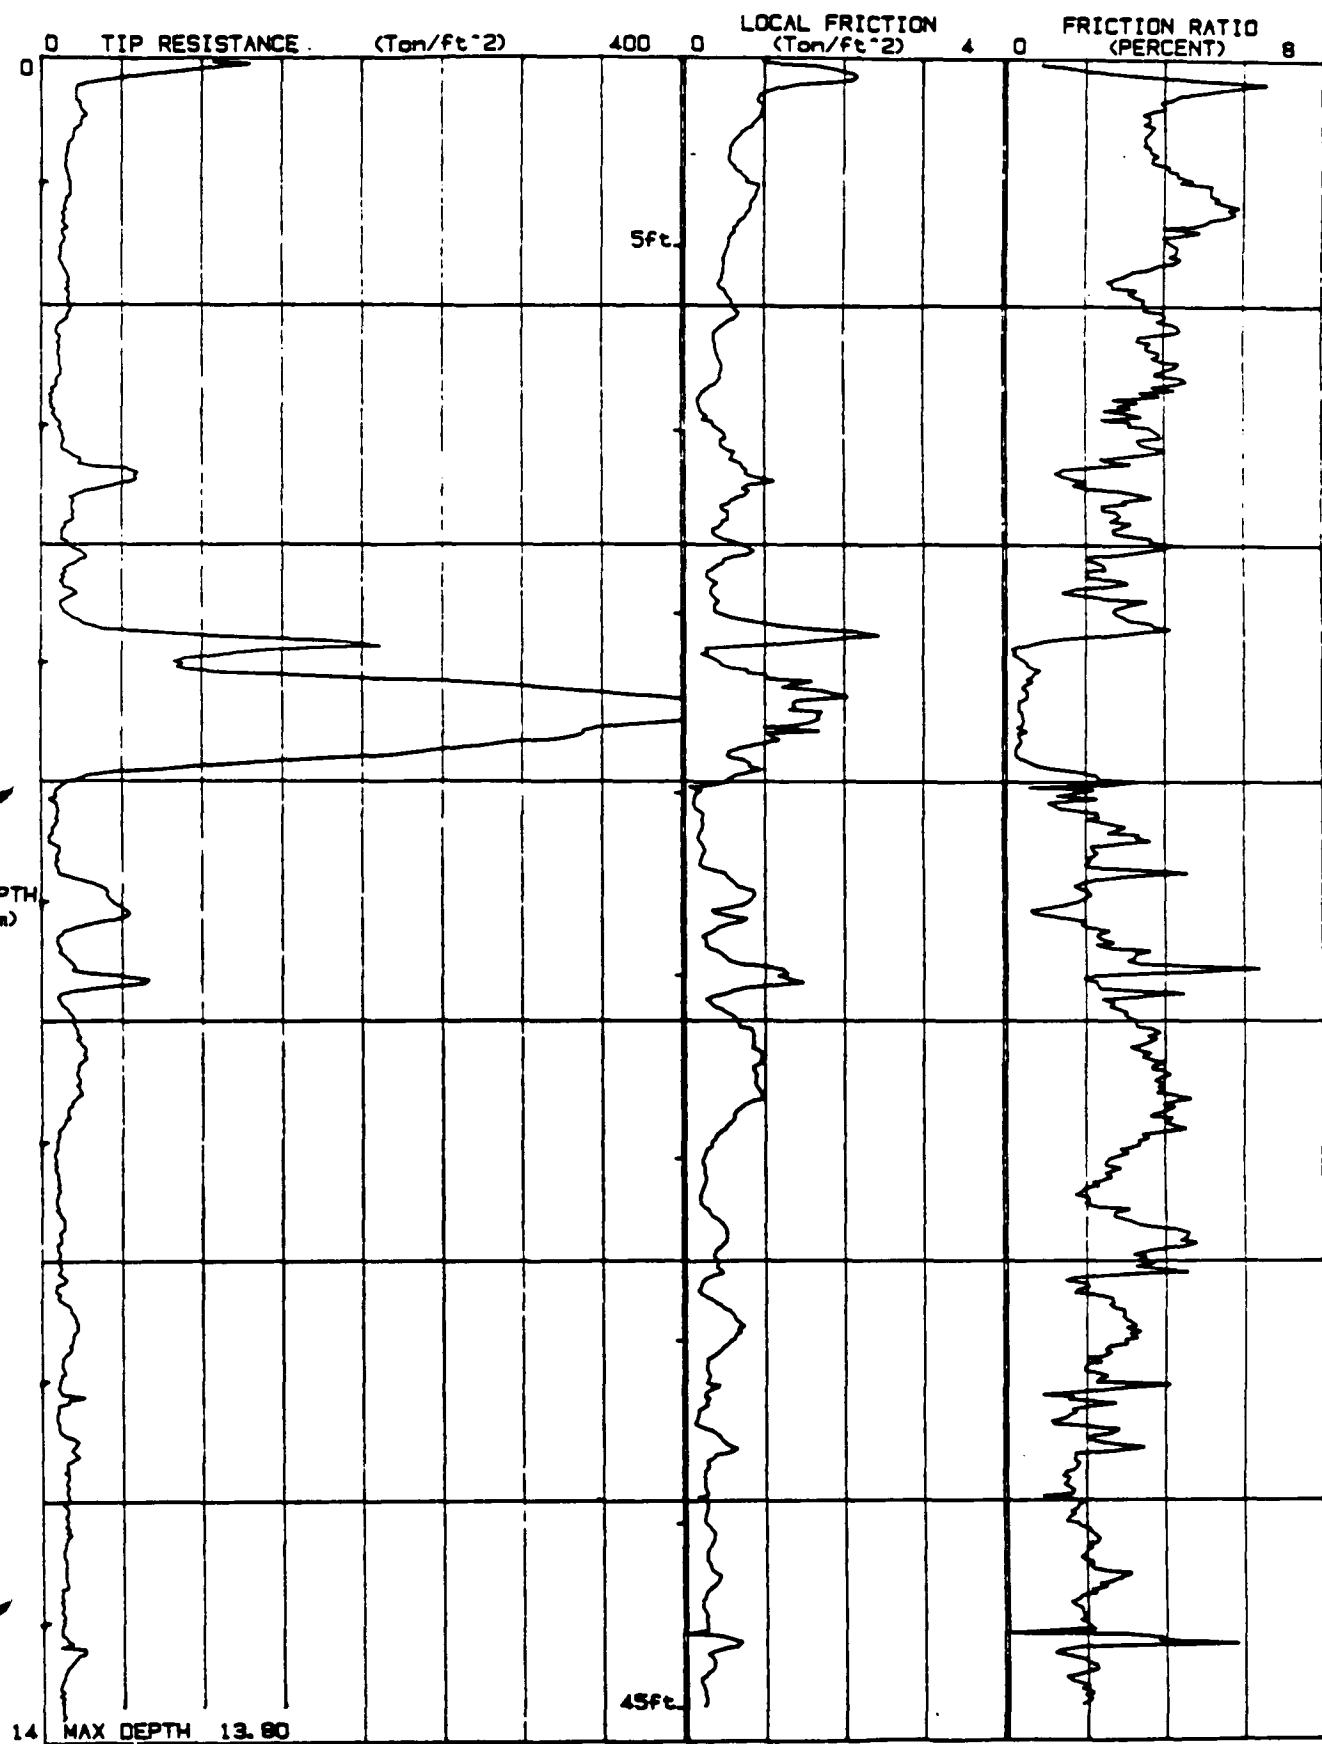


JOB # : 409700
DATE : 03/19/90 11:17
LOCATION : CPT9-25
FILE : FIL133

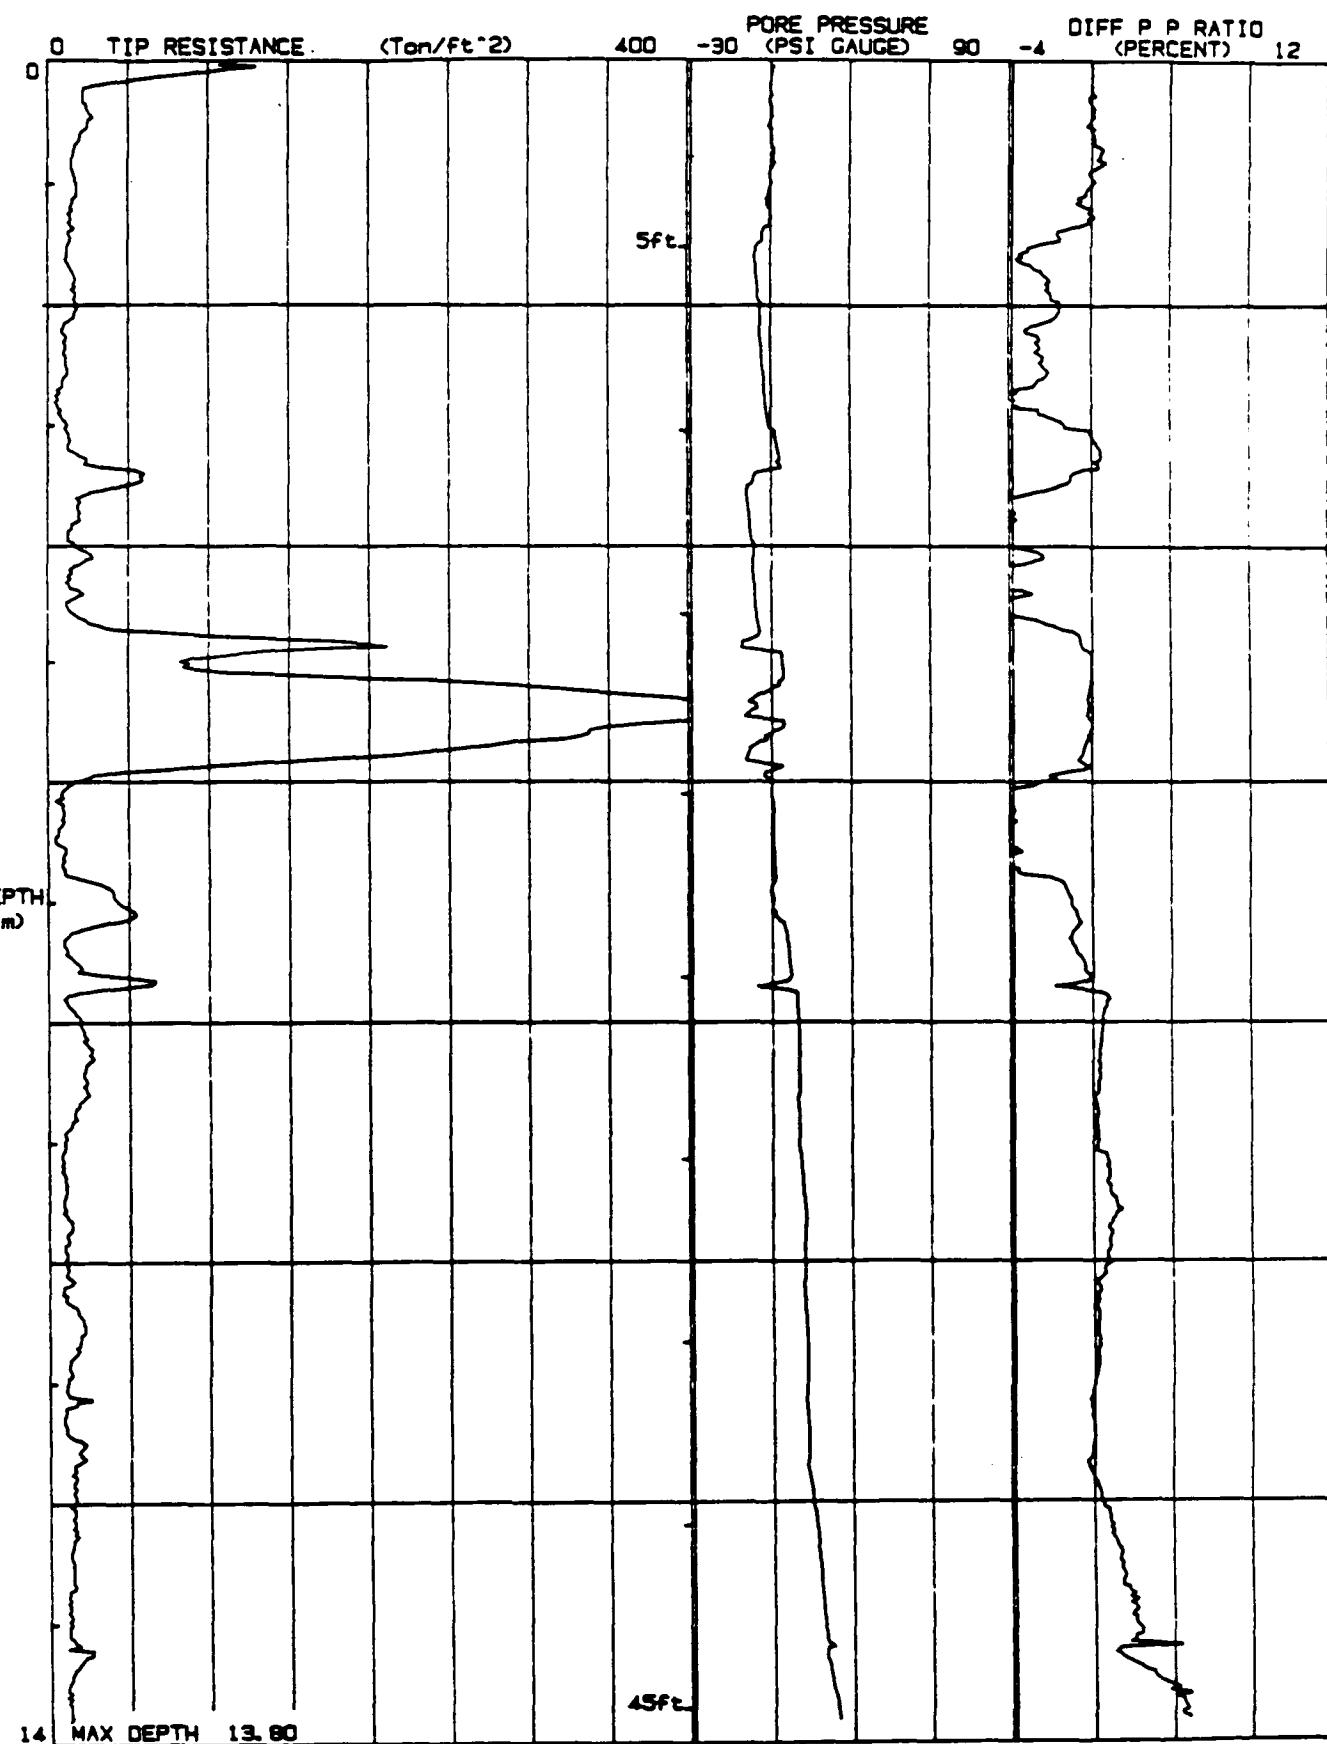


JOB # : 409700
DATE : 03/21/90 07:53
LOCATION : CPT9-26
FILE : FIL138

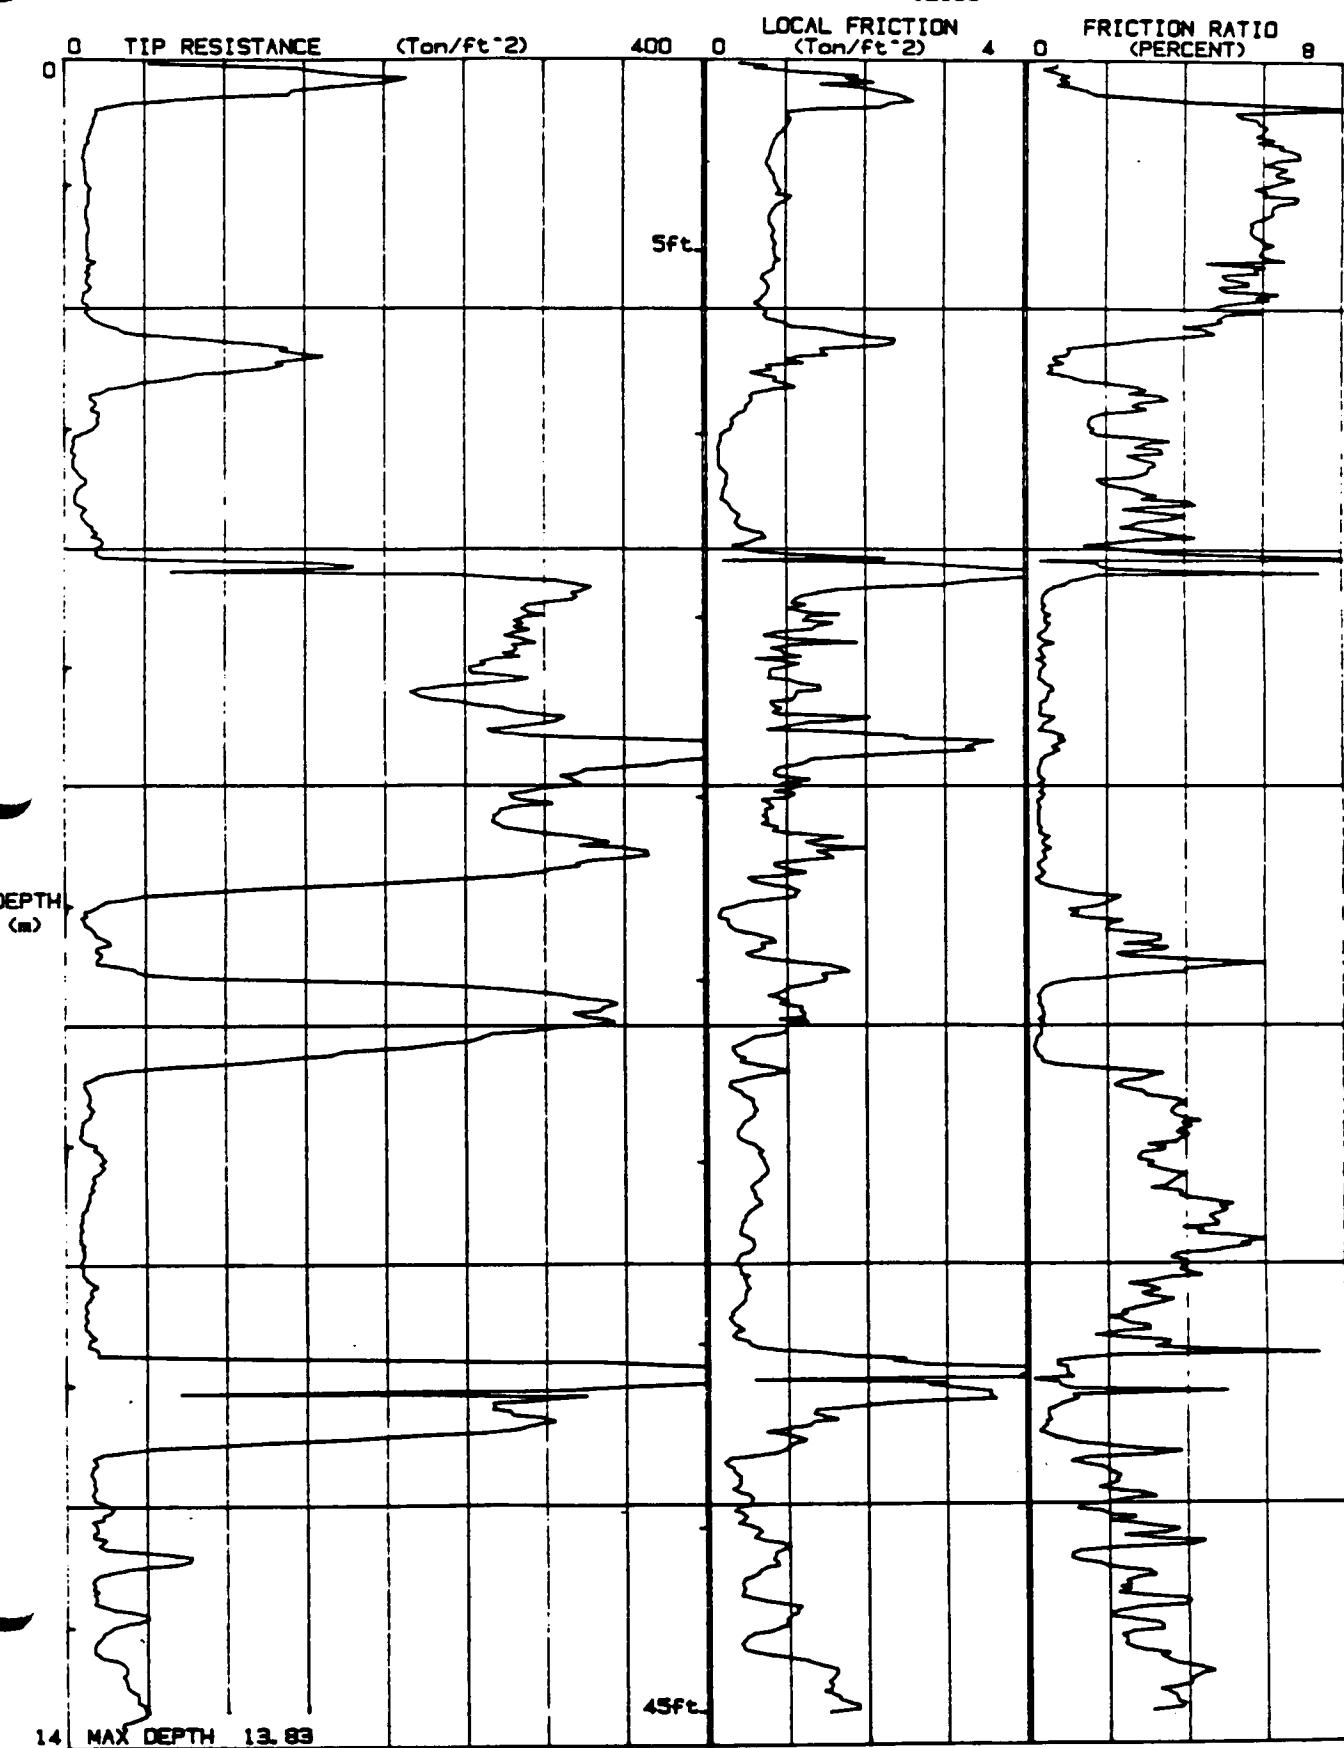


JOB # : 409700
DATE : 03/21/90/07:53
LOCATION : CPT9-28
FILE : FIL138

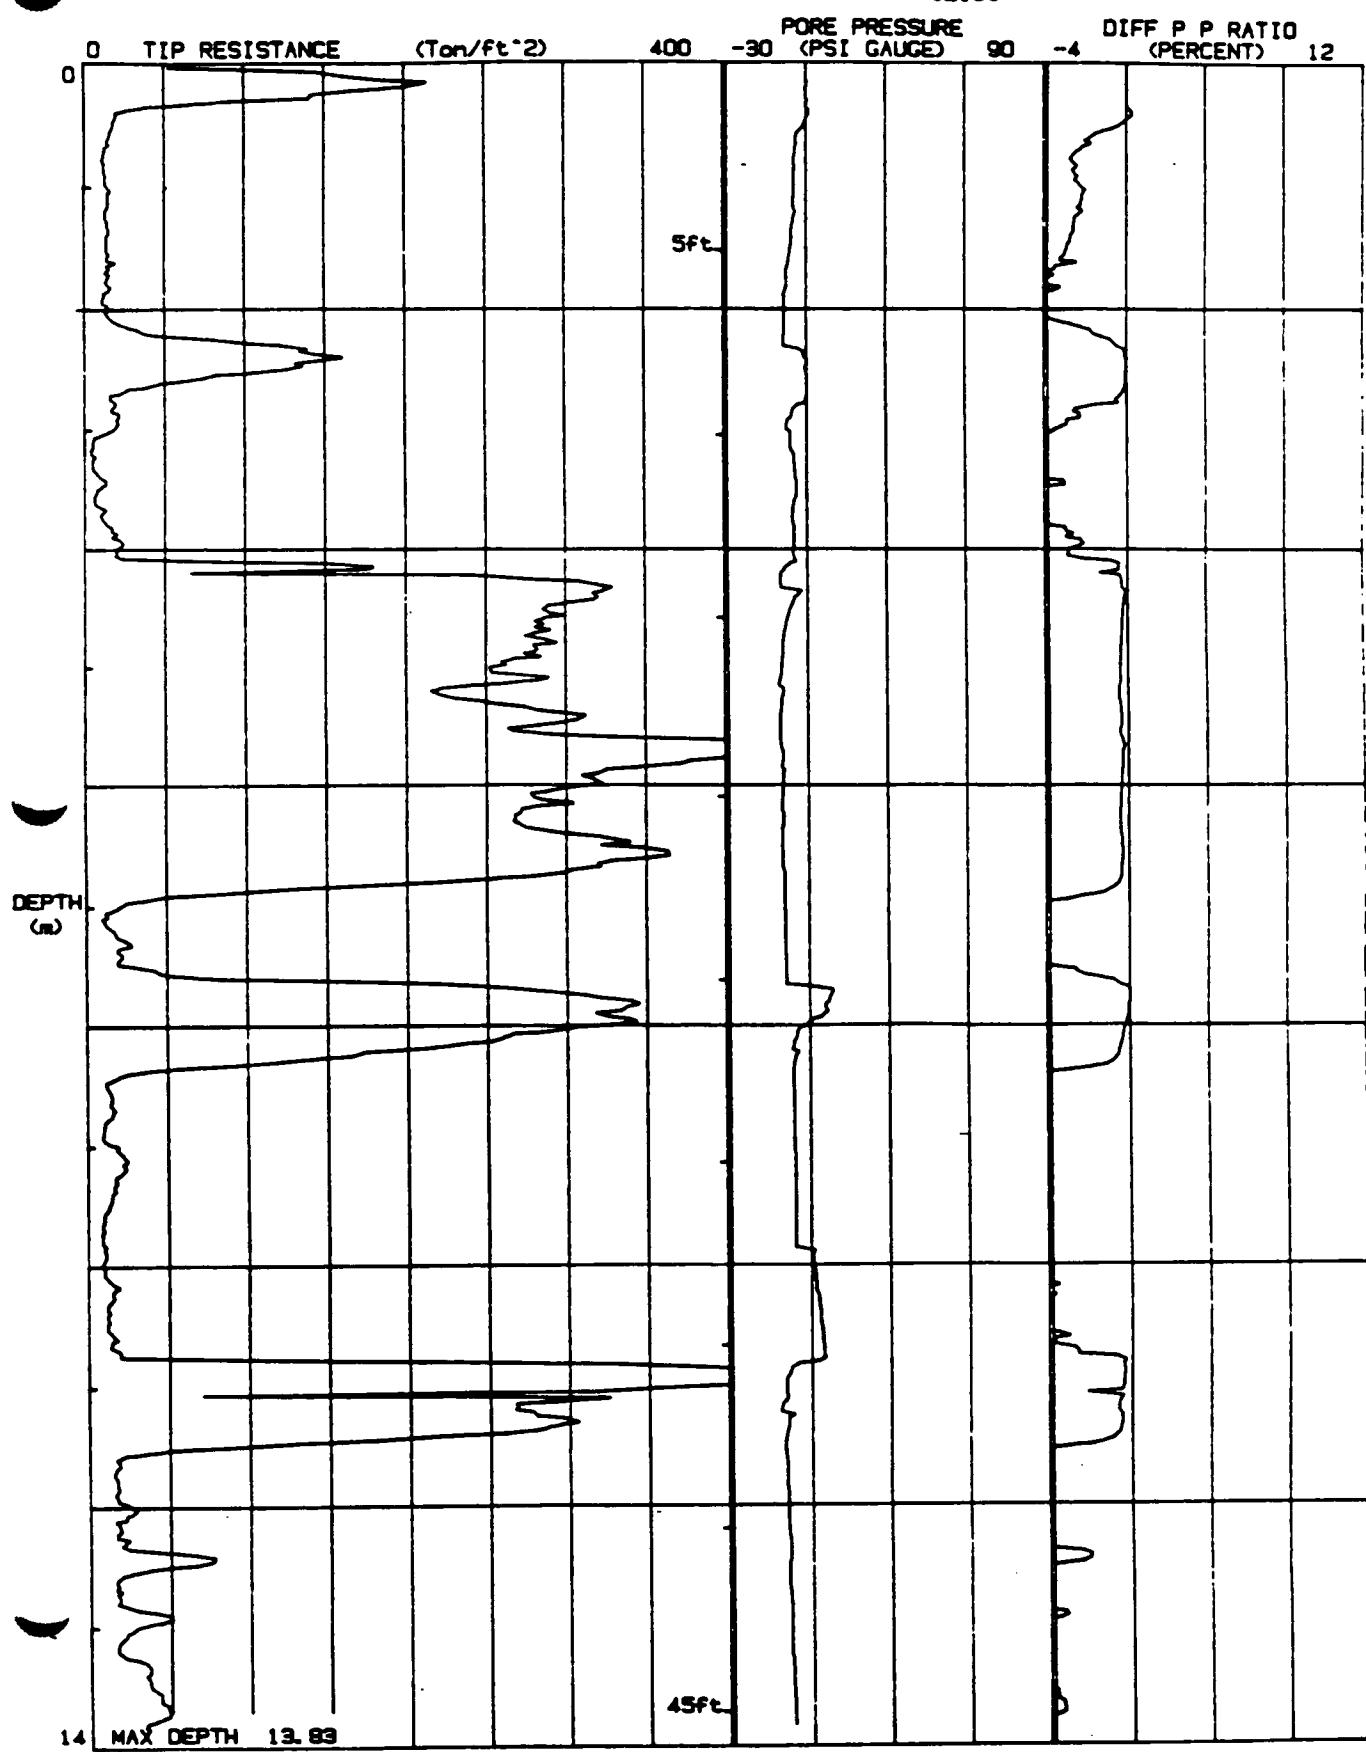

JOB # : 408700
DATE : 03/16/80 12:42
LOCATION : CPT/9-32
FILE : FIL131

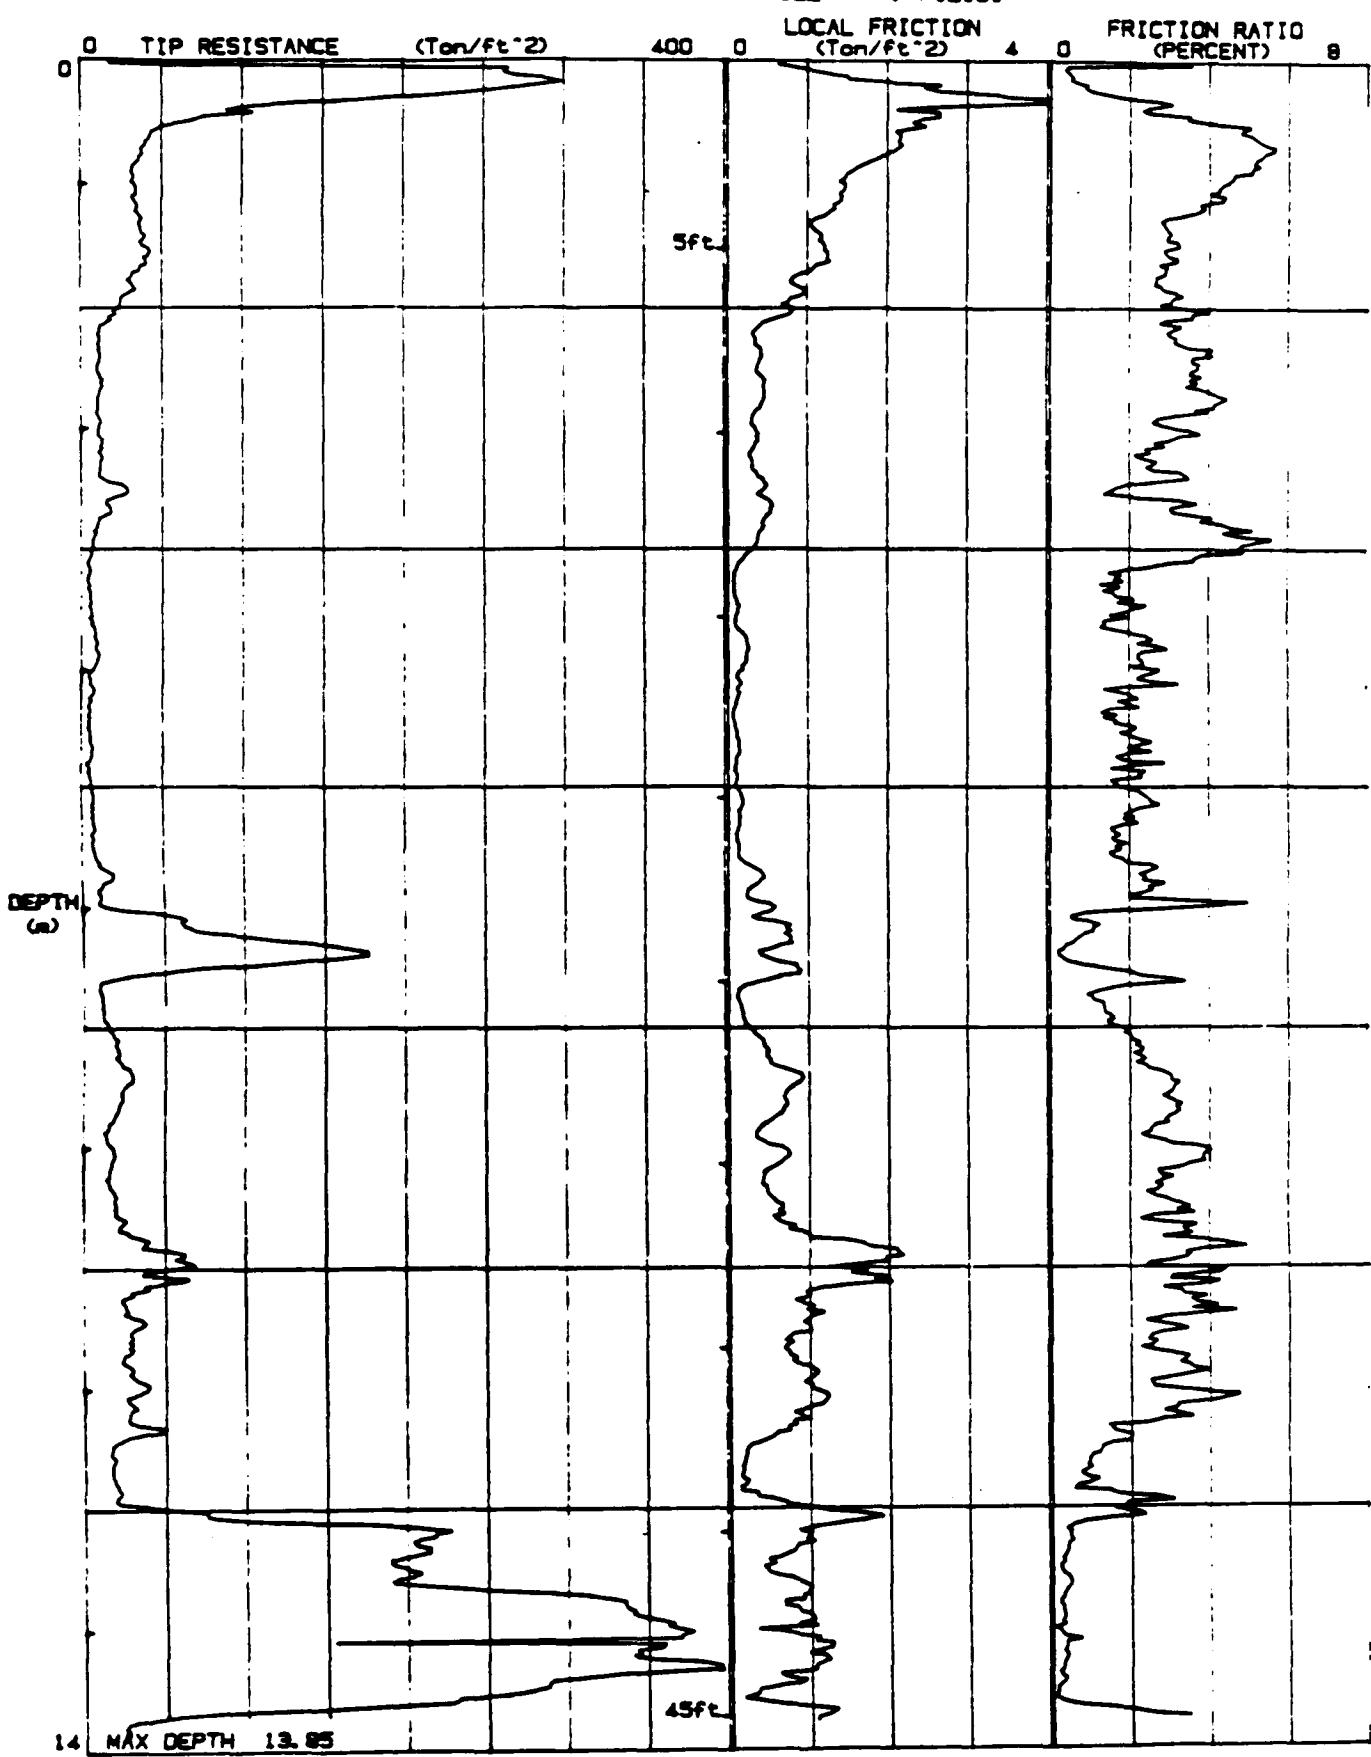


JOB # : 409700
DATE : 03/18/90 12:42
LOCATION : CPT/9-32
FILE : FIL131

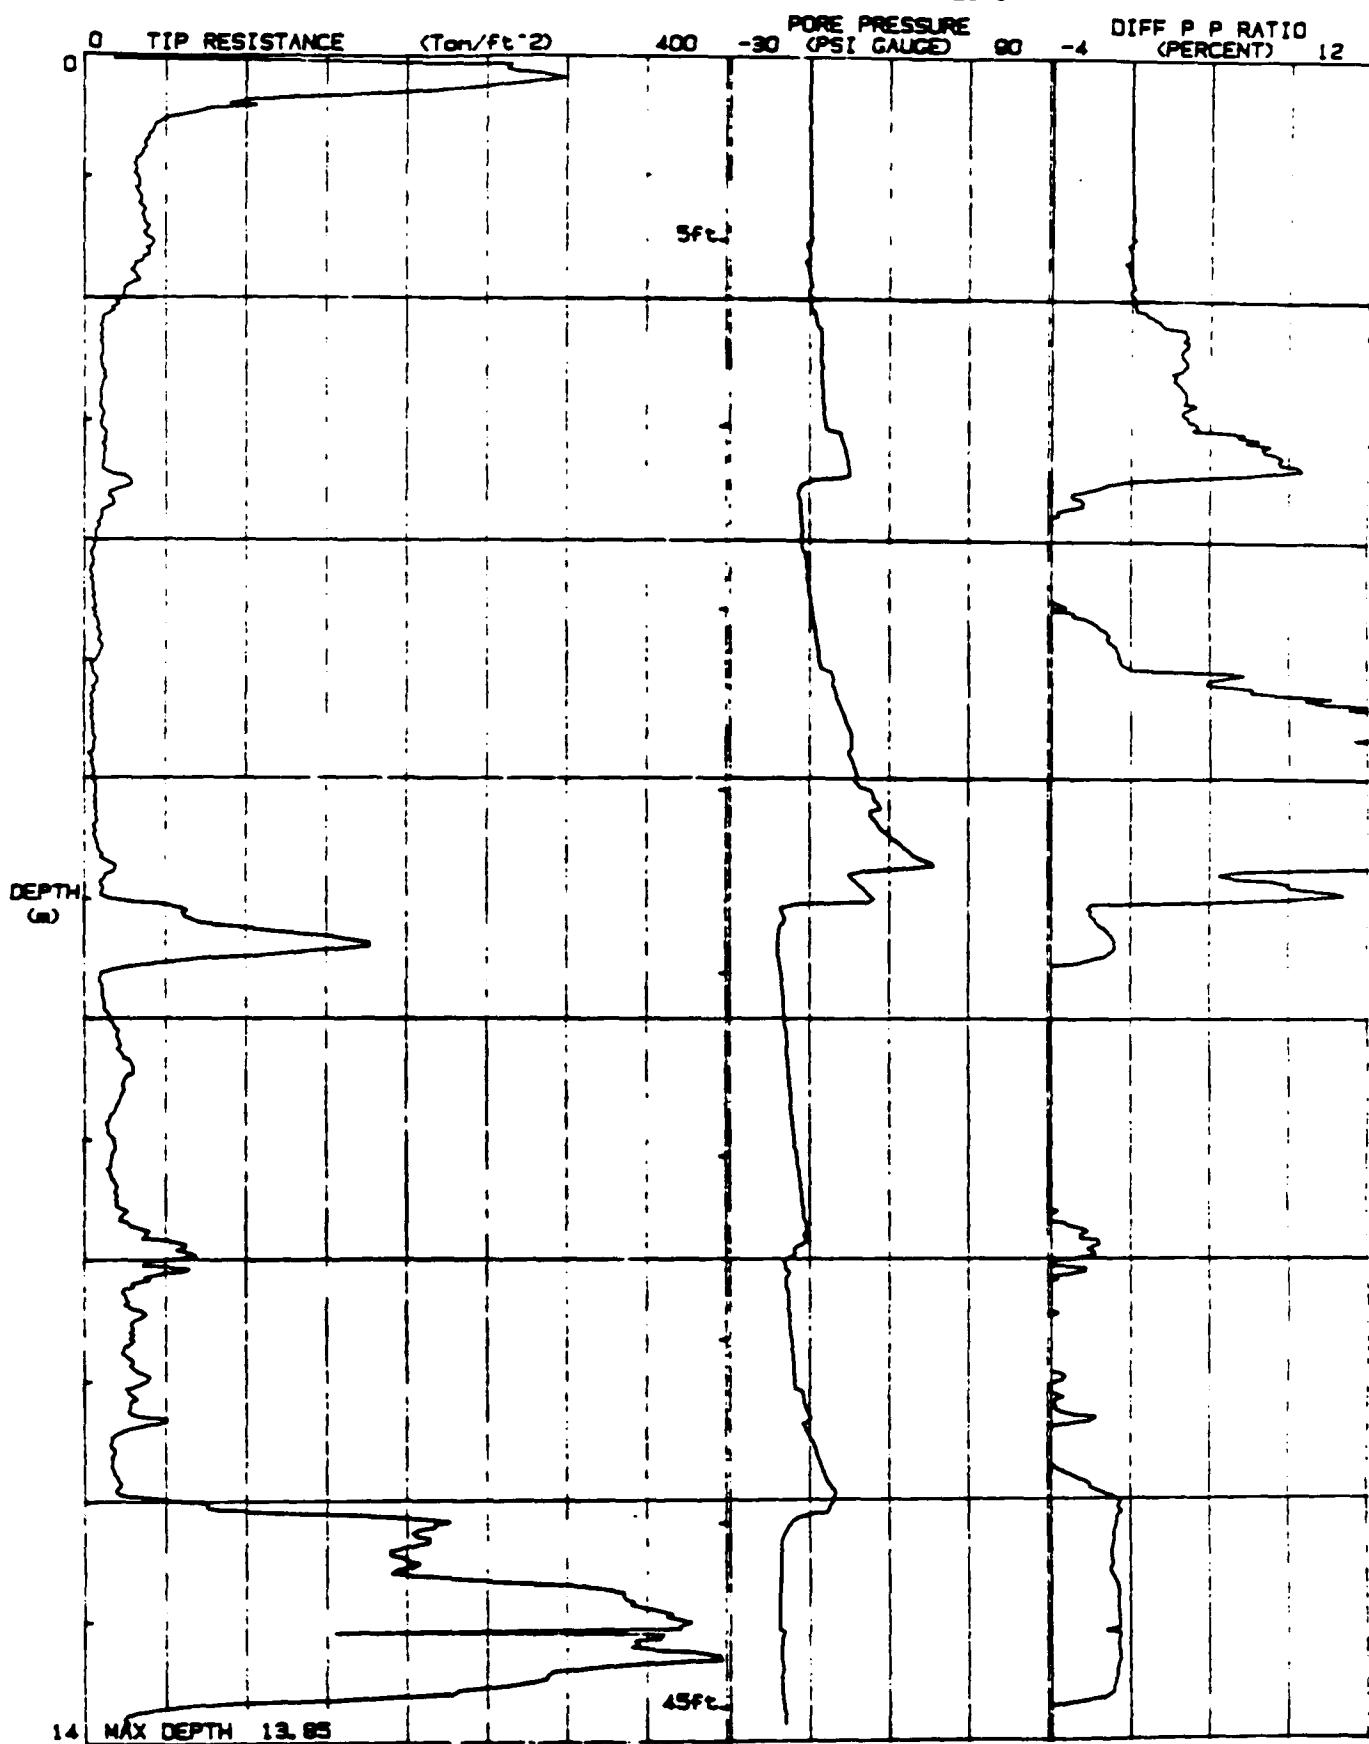


JOB # : 409700
DATE : 04/04/90/14:08
LOCATION : CPT9-38
FILE : FIL148




JOB # : 408700
DATE : 04/04/90/14:08
LOCATION : CPT9-36
FILE : FIL148

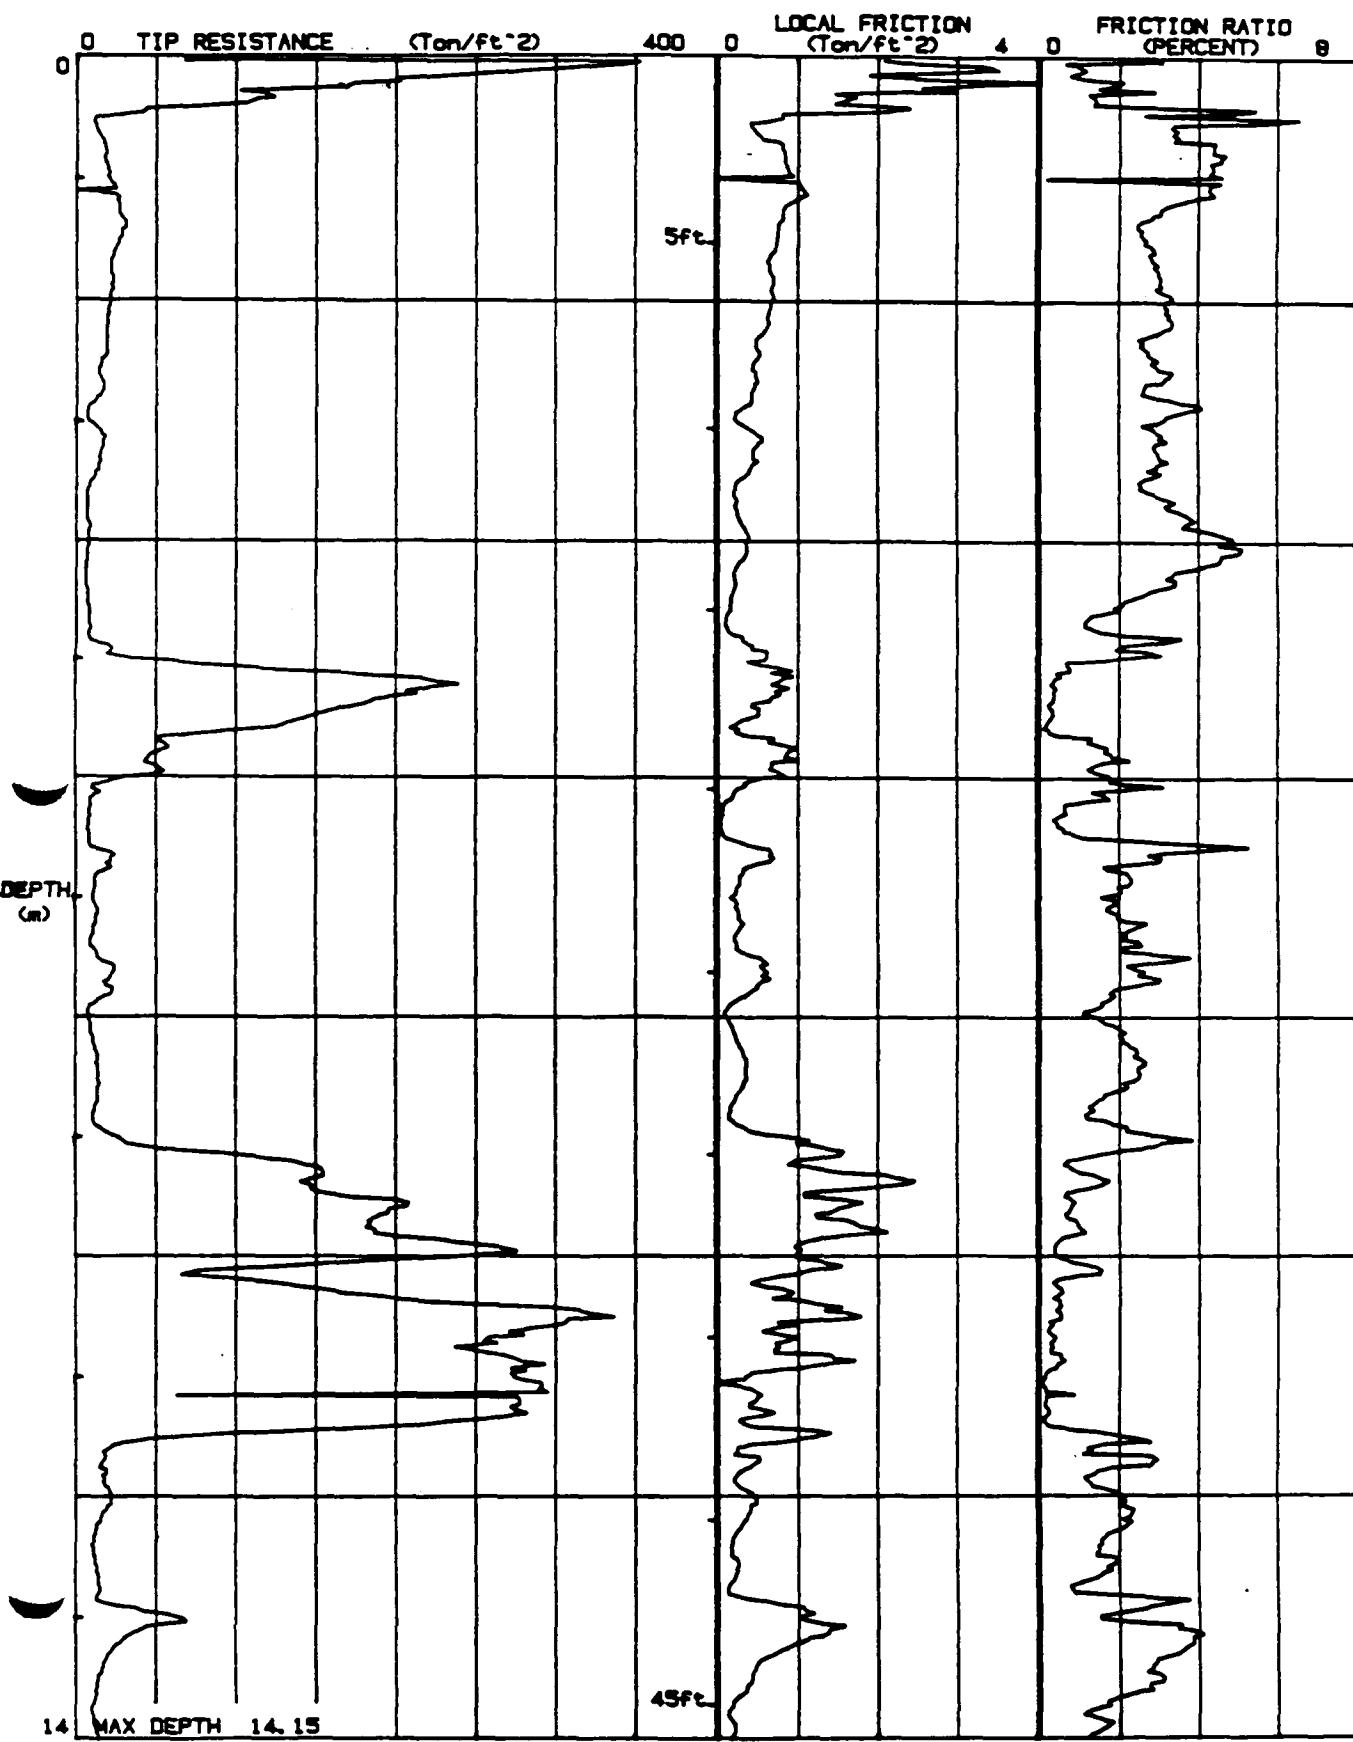


JOB # : 409700
DATE : 01/29/90
LOCATION : CPT/9-38
FILE # : 18

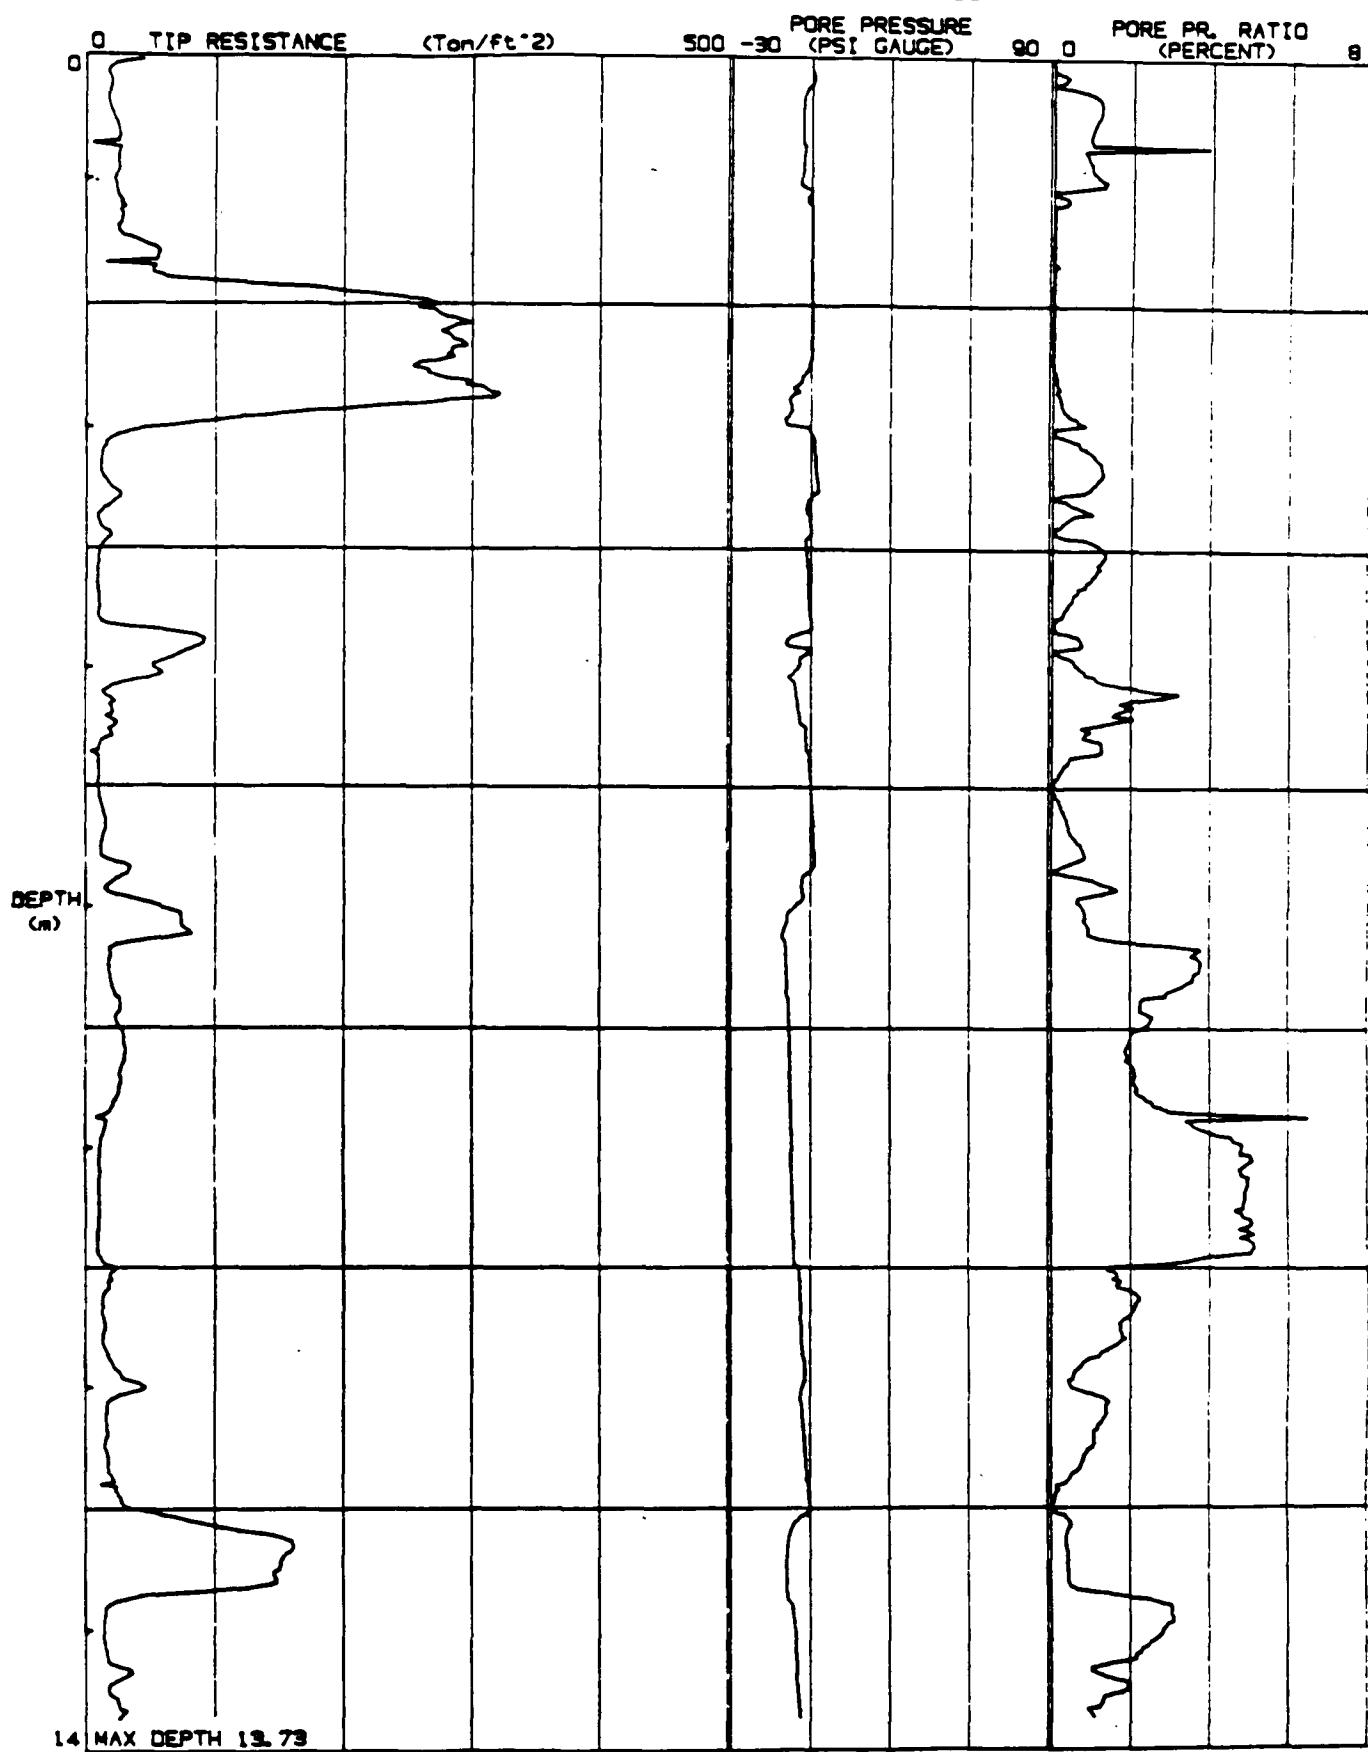


JOB # : 409700
DATE : 01/29/80
LOCATION : CPT/9-39
FILE # : 13

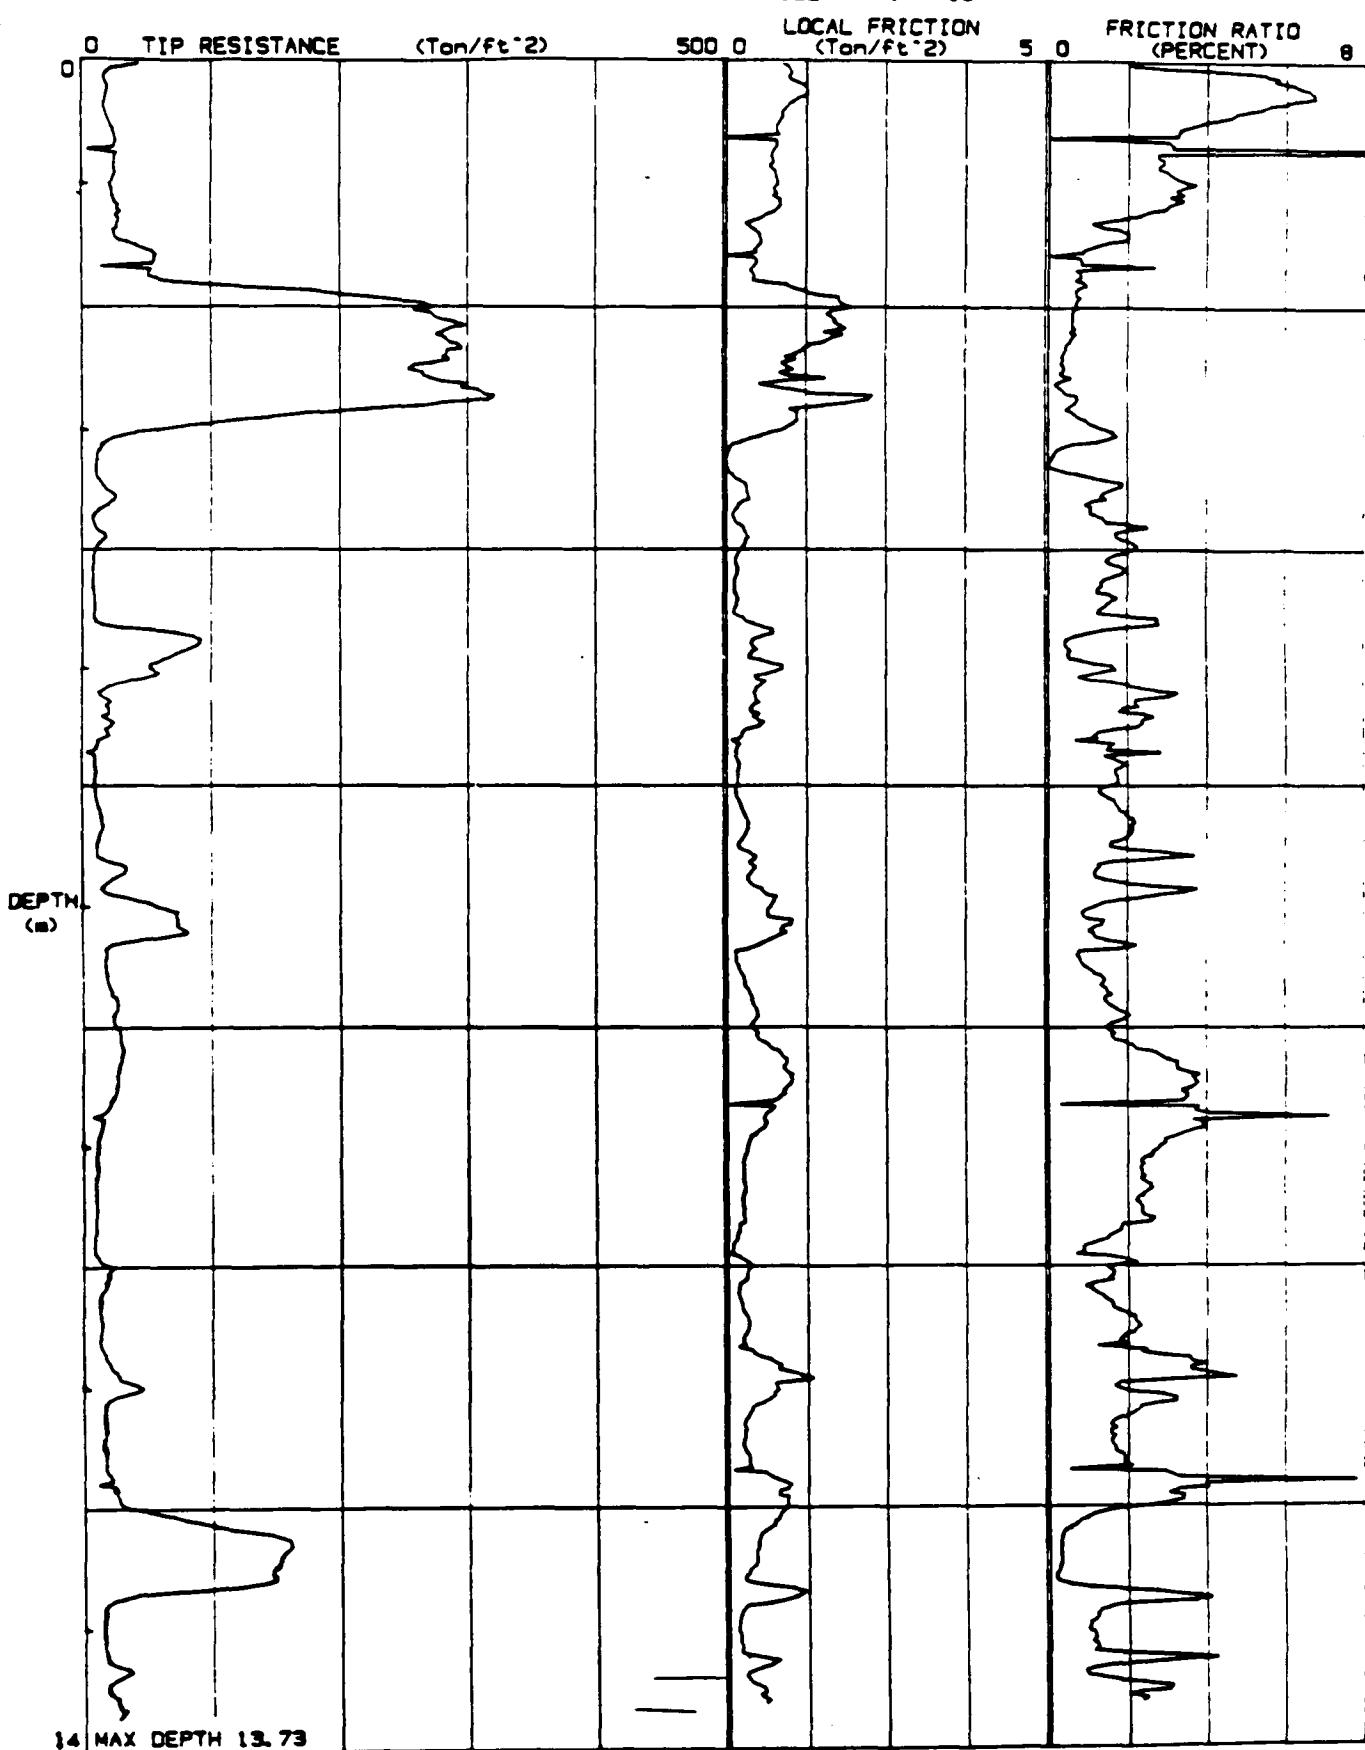


JOB # : 409700
DATE : 01/31/90
LOCATION : CPT/9-40
FILE # : 18

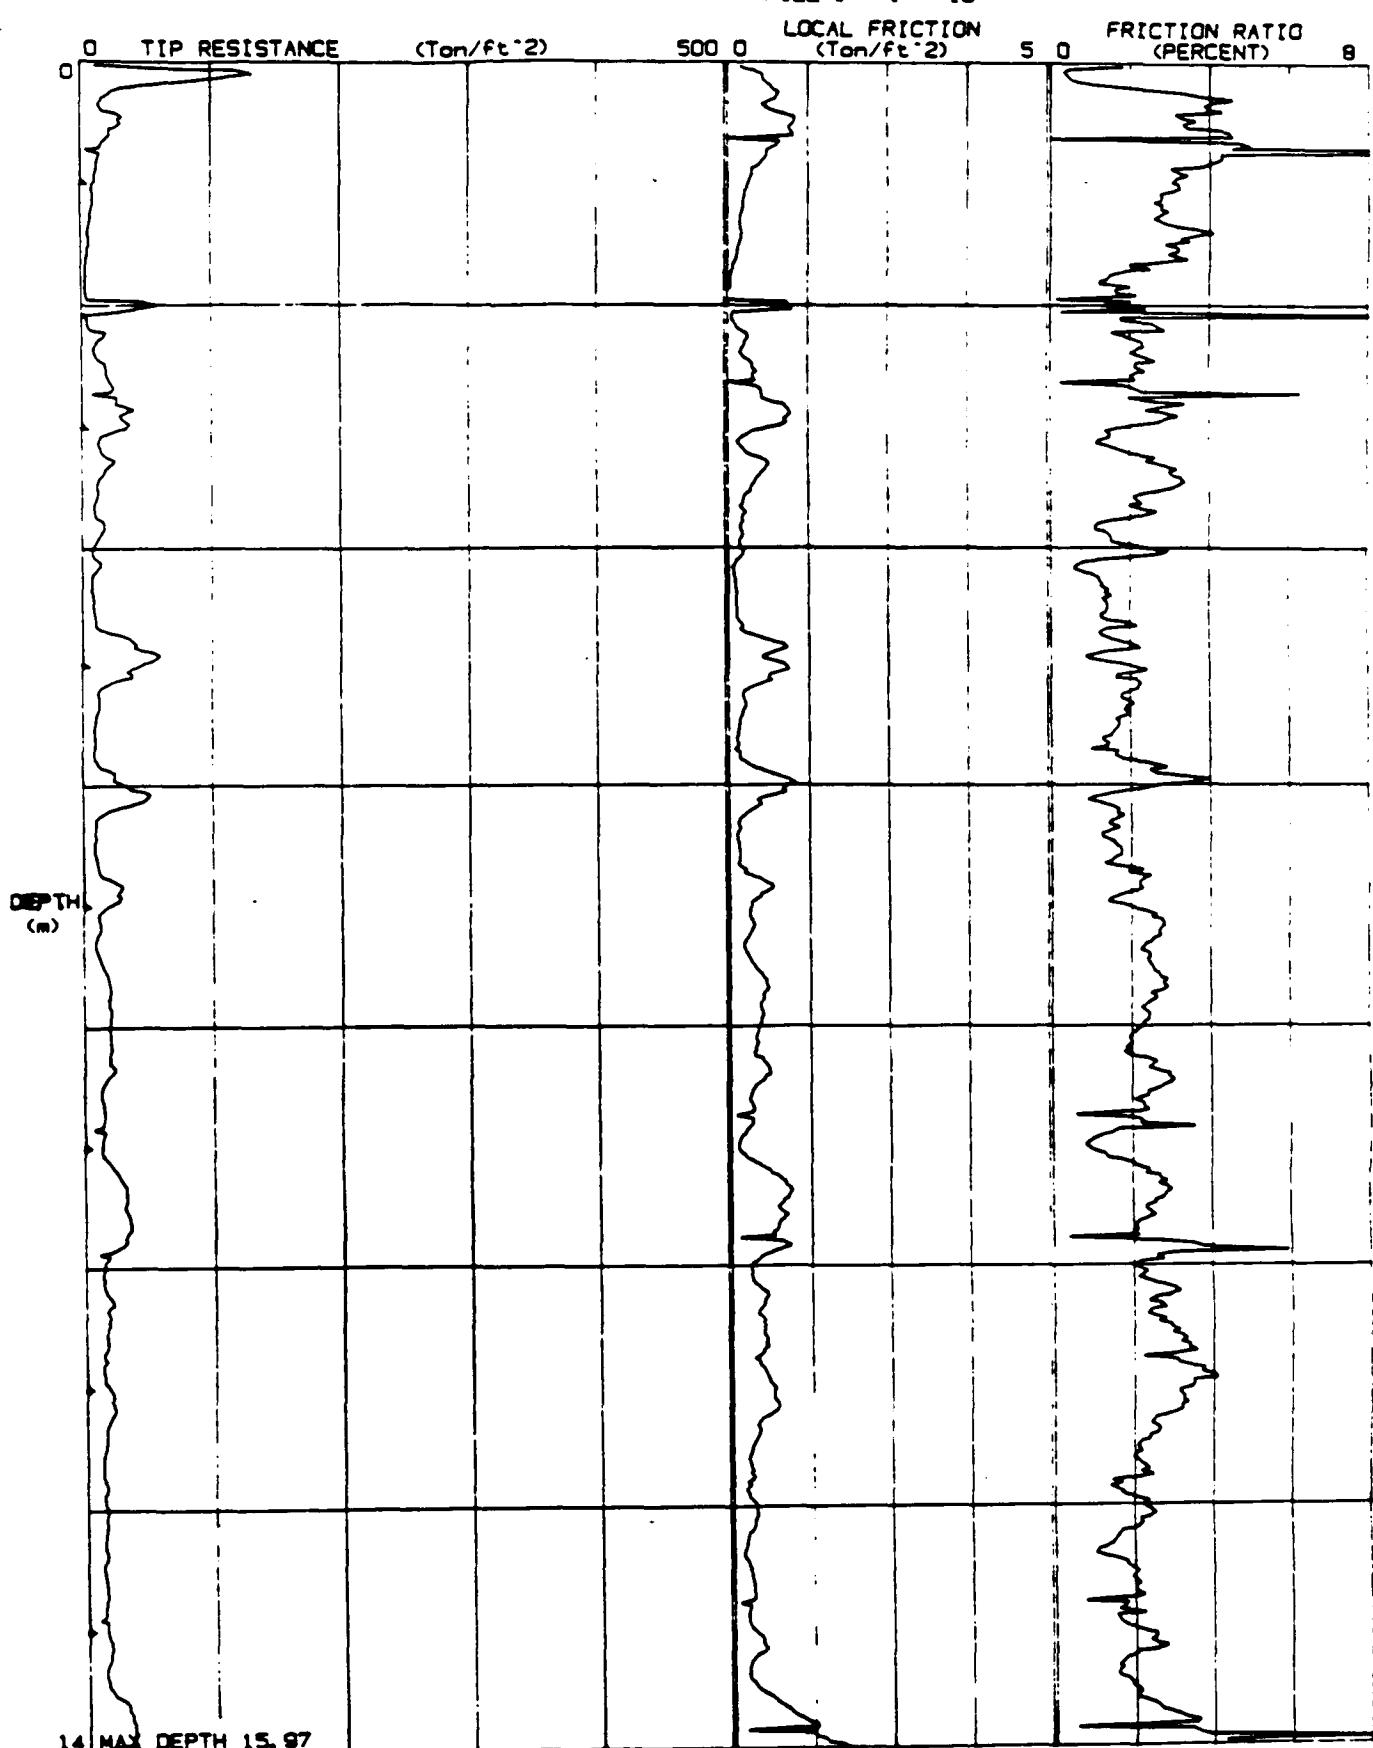


JOB # : 409700
DATE : 01/31/90
LOCATION : CPT/9-40
FILE # : 18

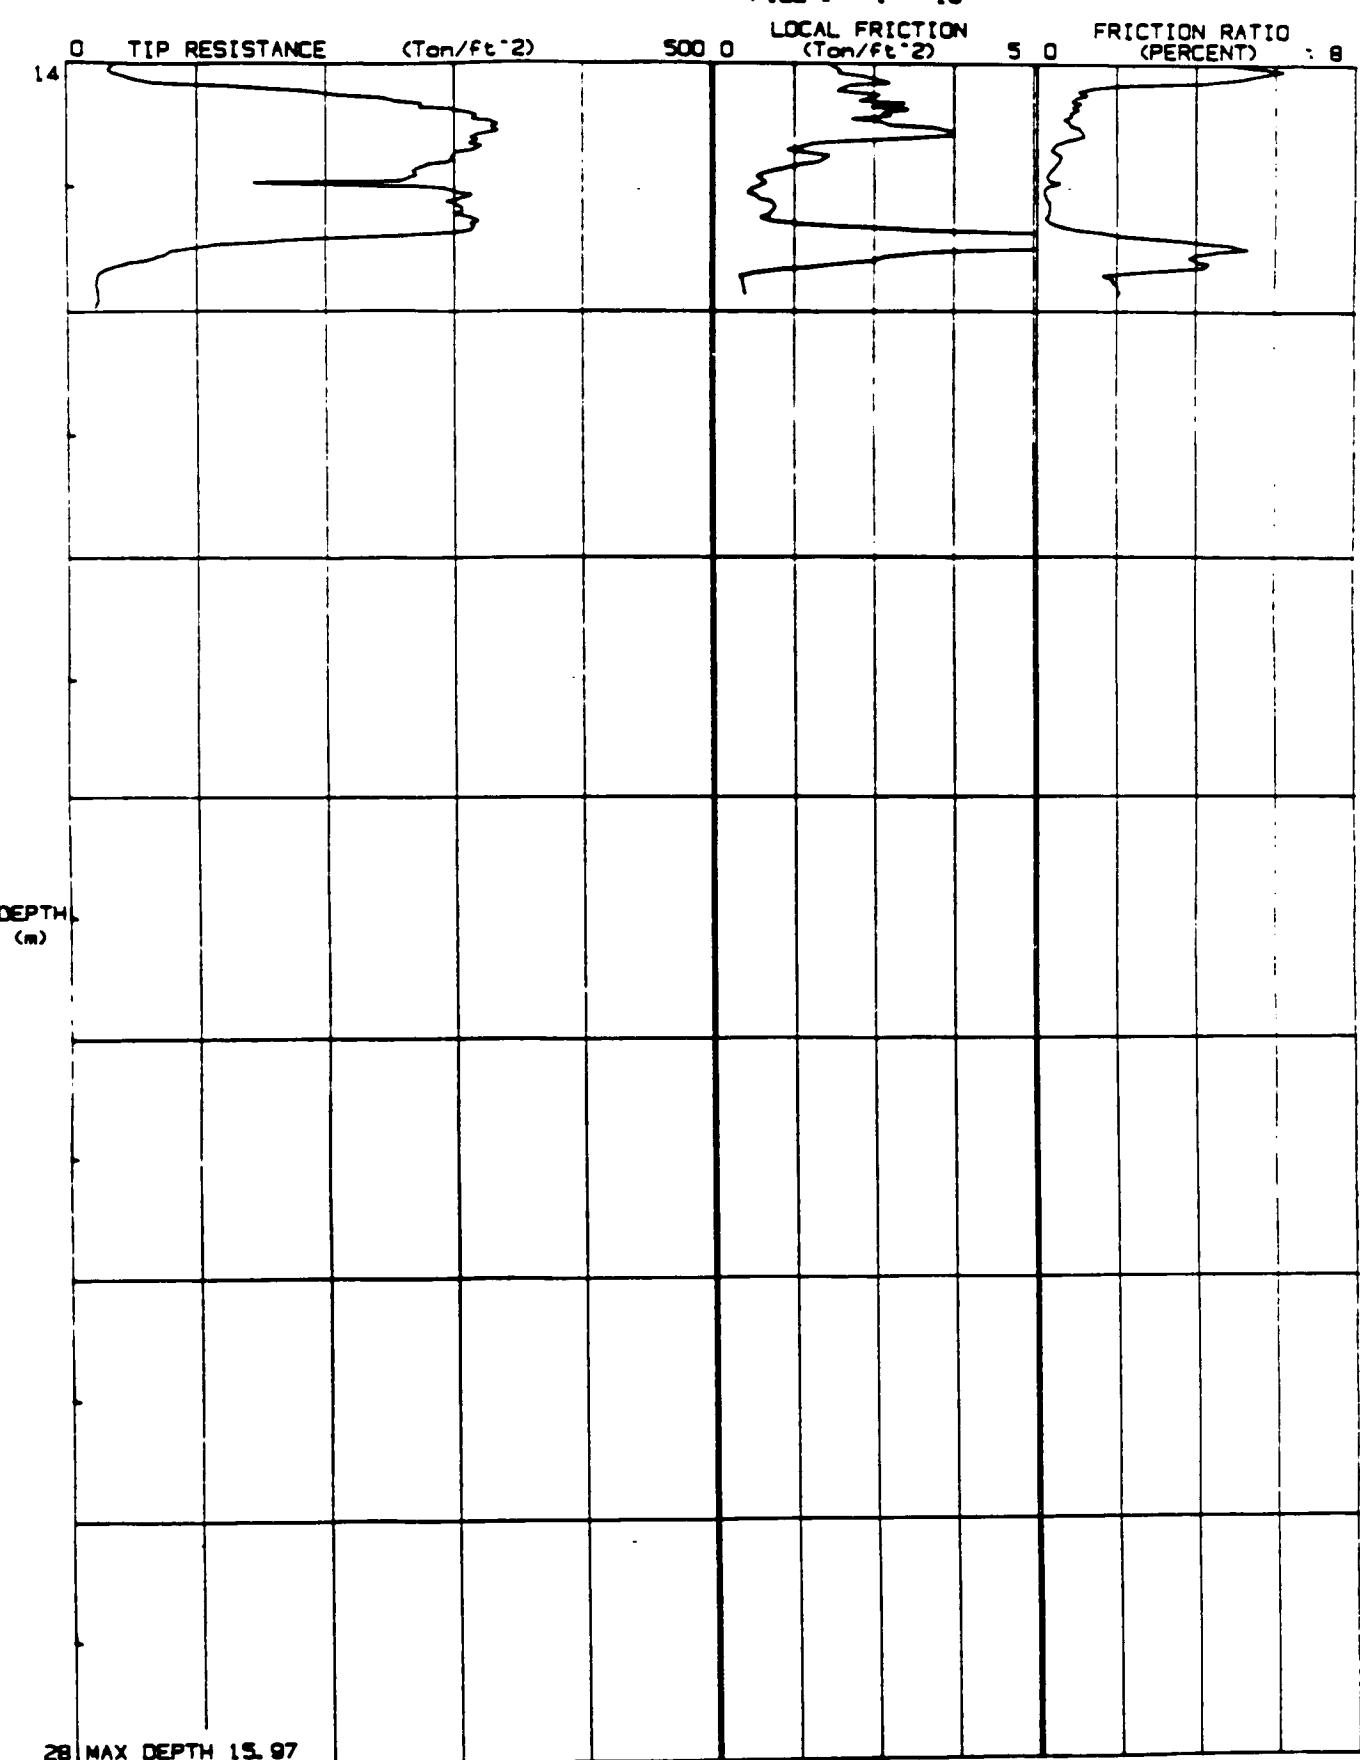


JOB # : 409700
DATE : 01/31/90
LOCATION : CPT/9-40
FILE # : 18

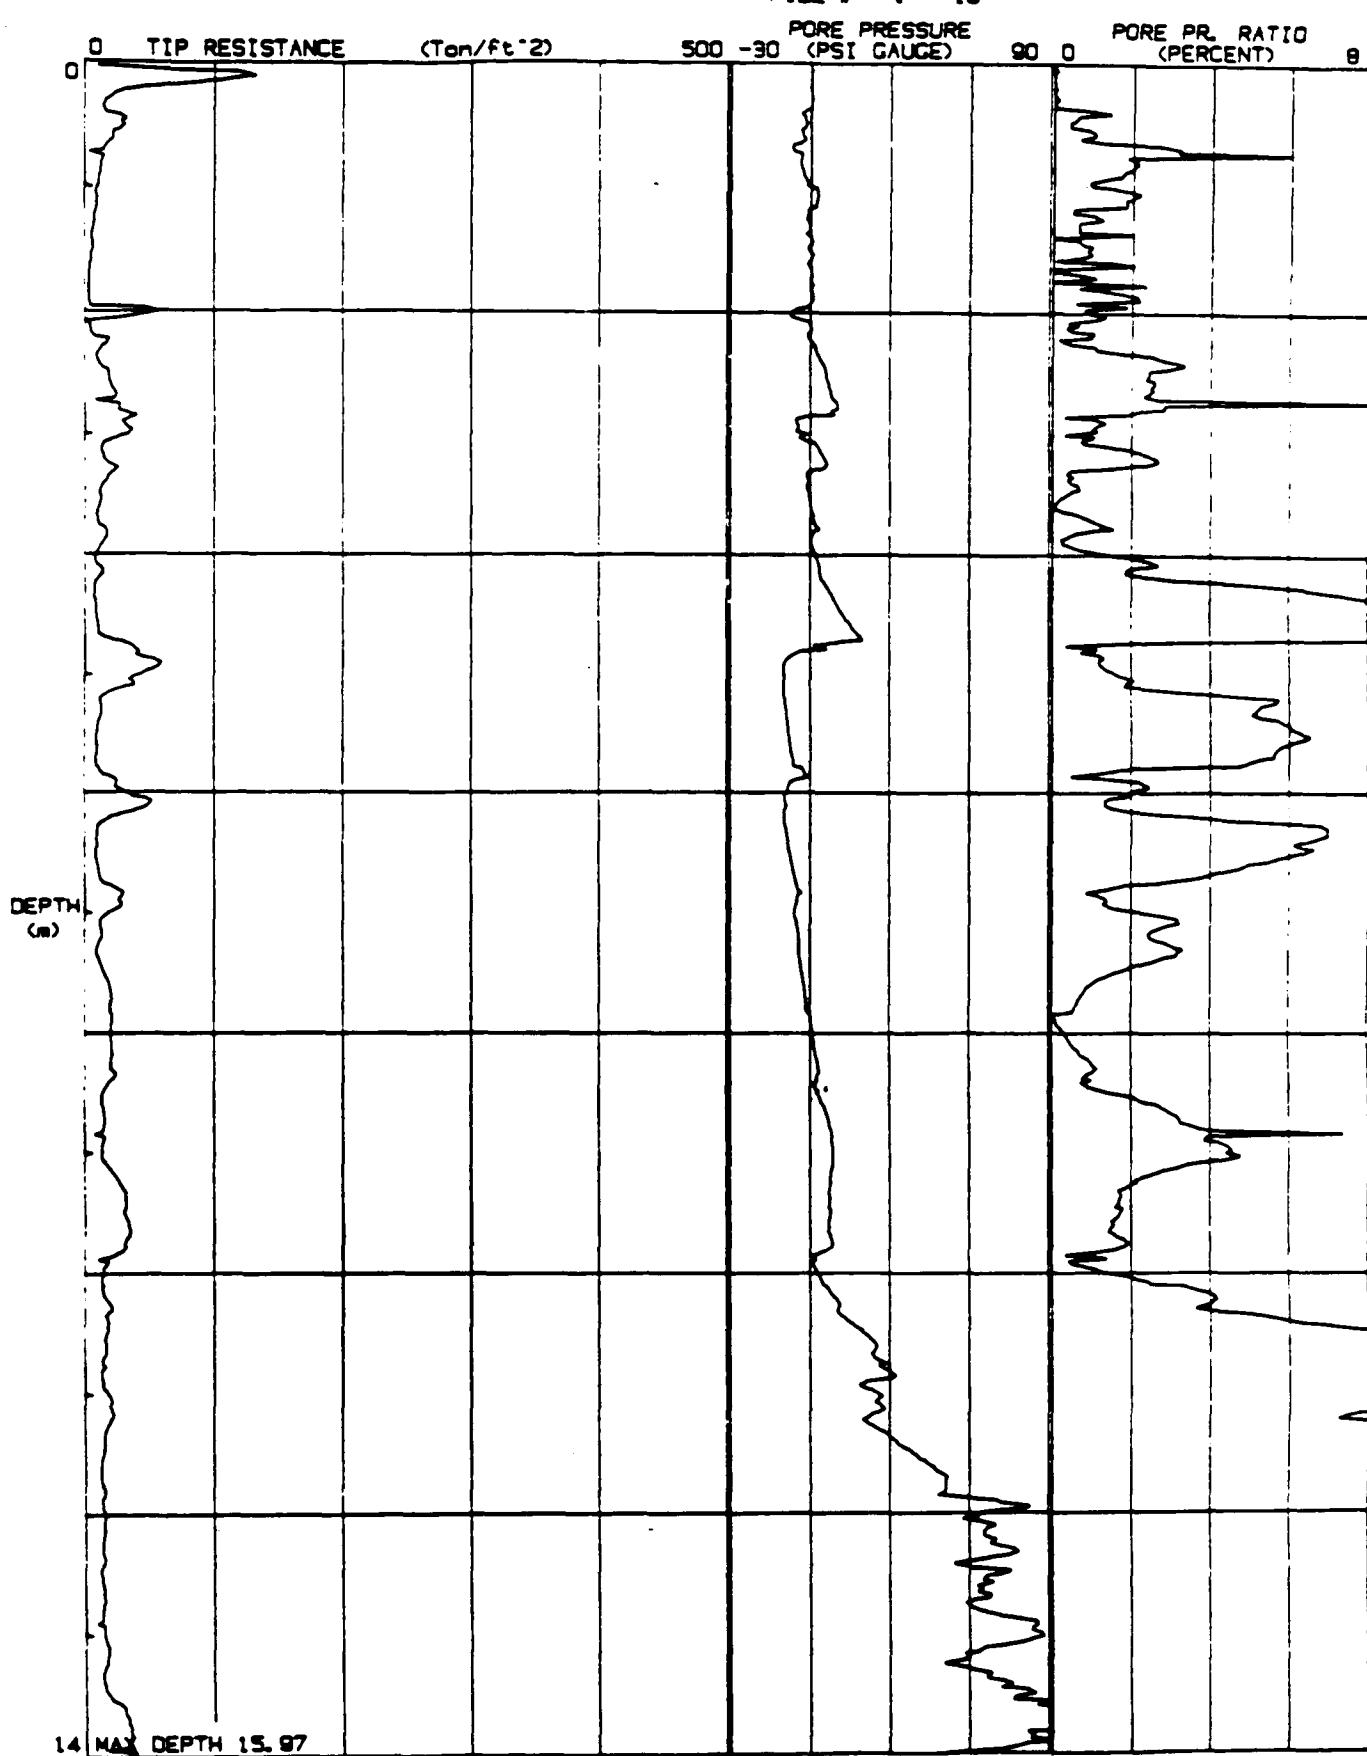

JOB # : 409700
DATE : 01/31/90
LOCATION : CPT/9-40
FILE # : 18

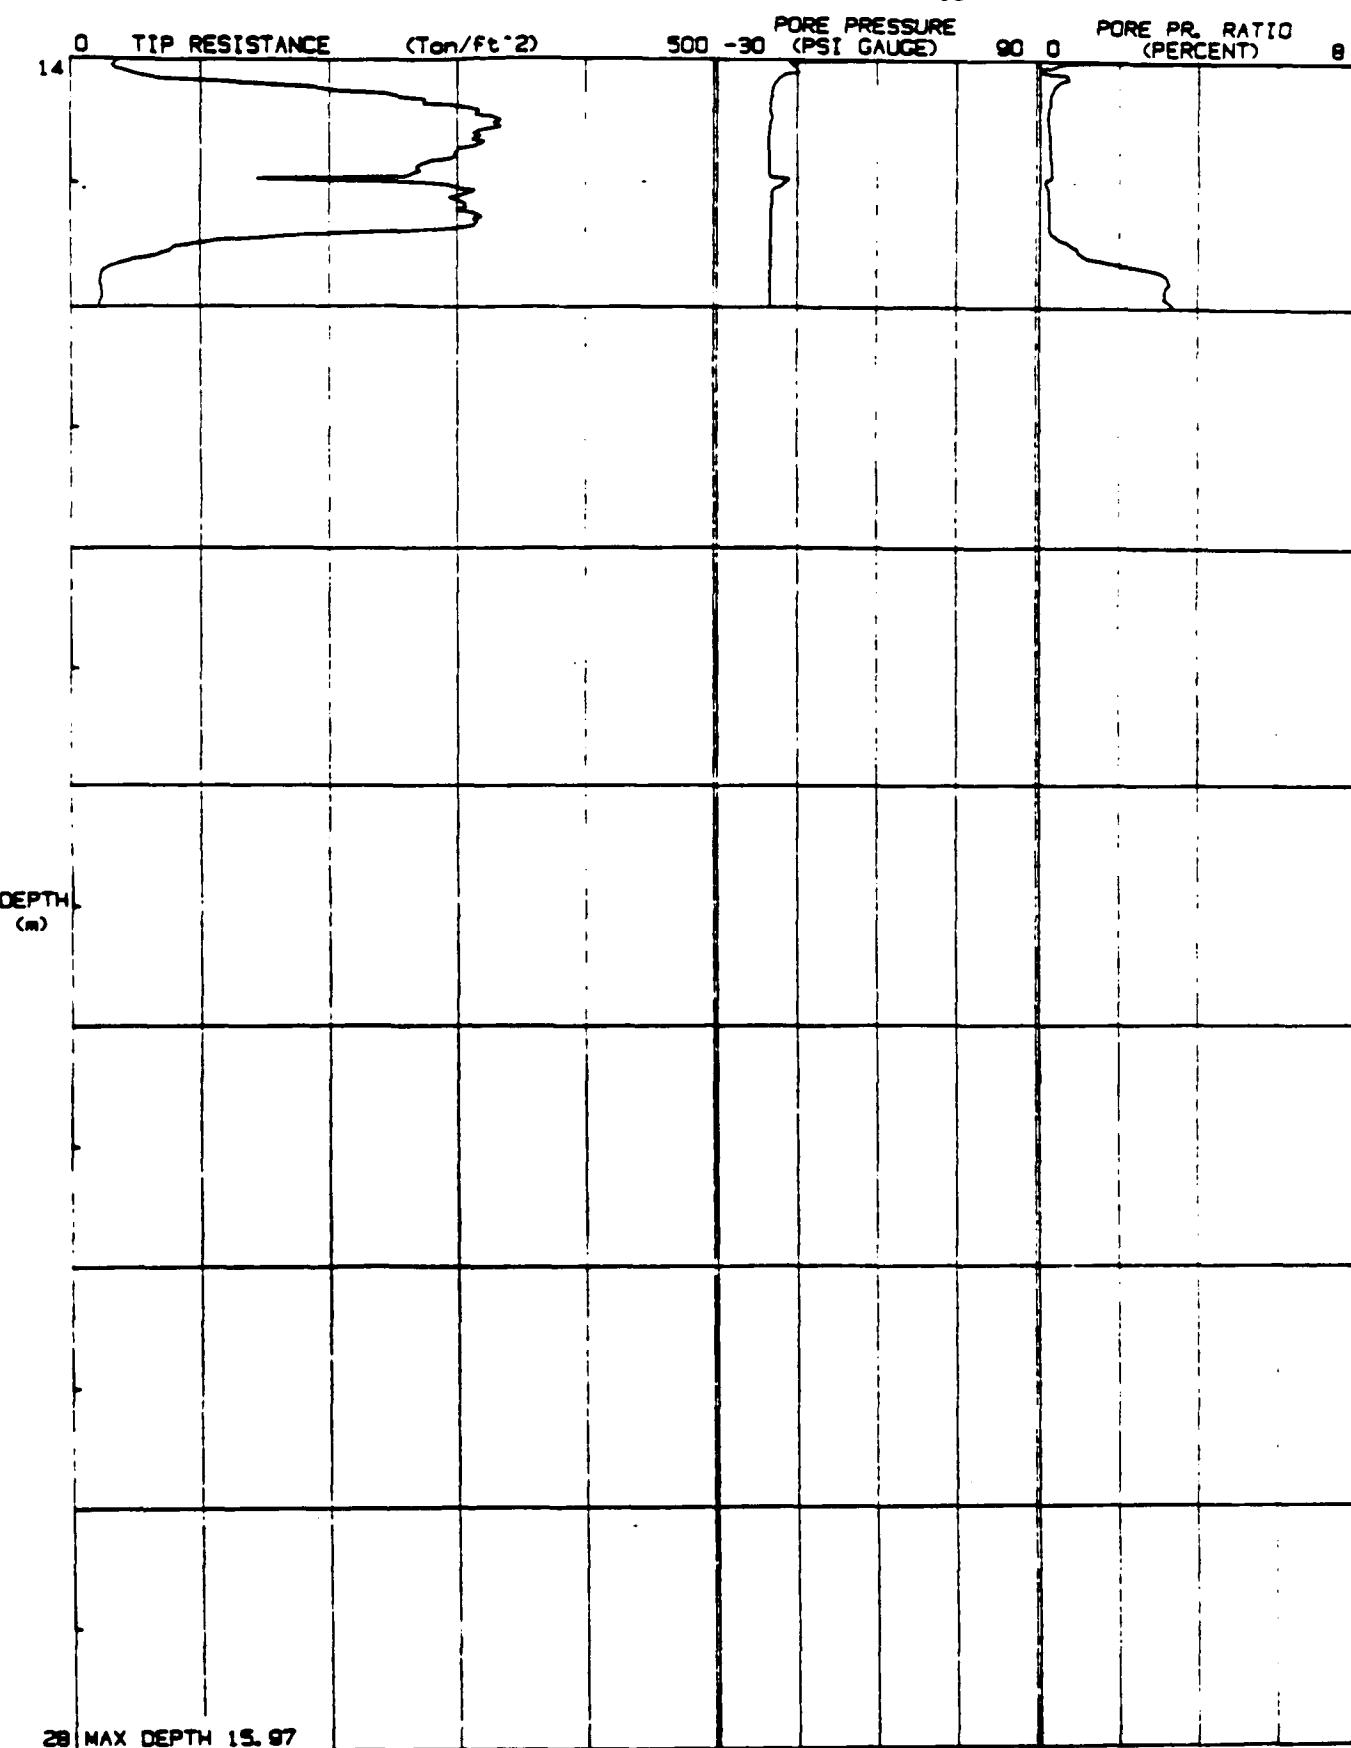

JOB # : 409700
DATE : 01/22/90
LOCATION : CPT/HG-44
FILE # : 4

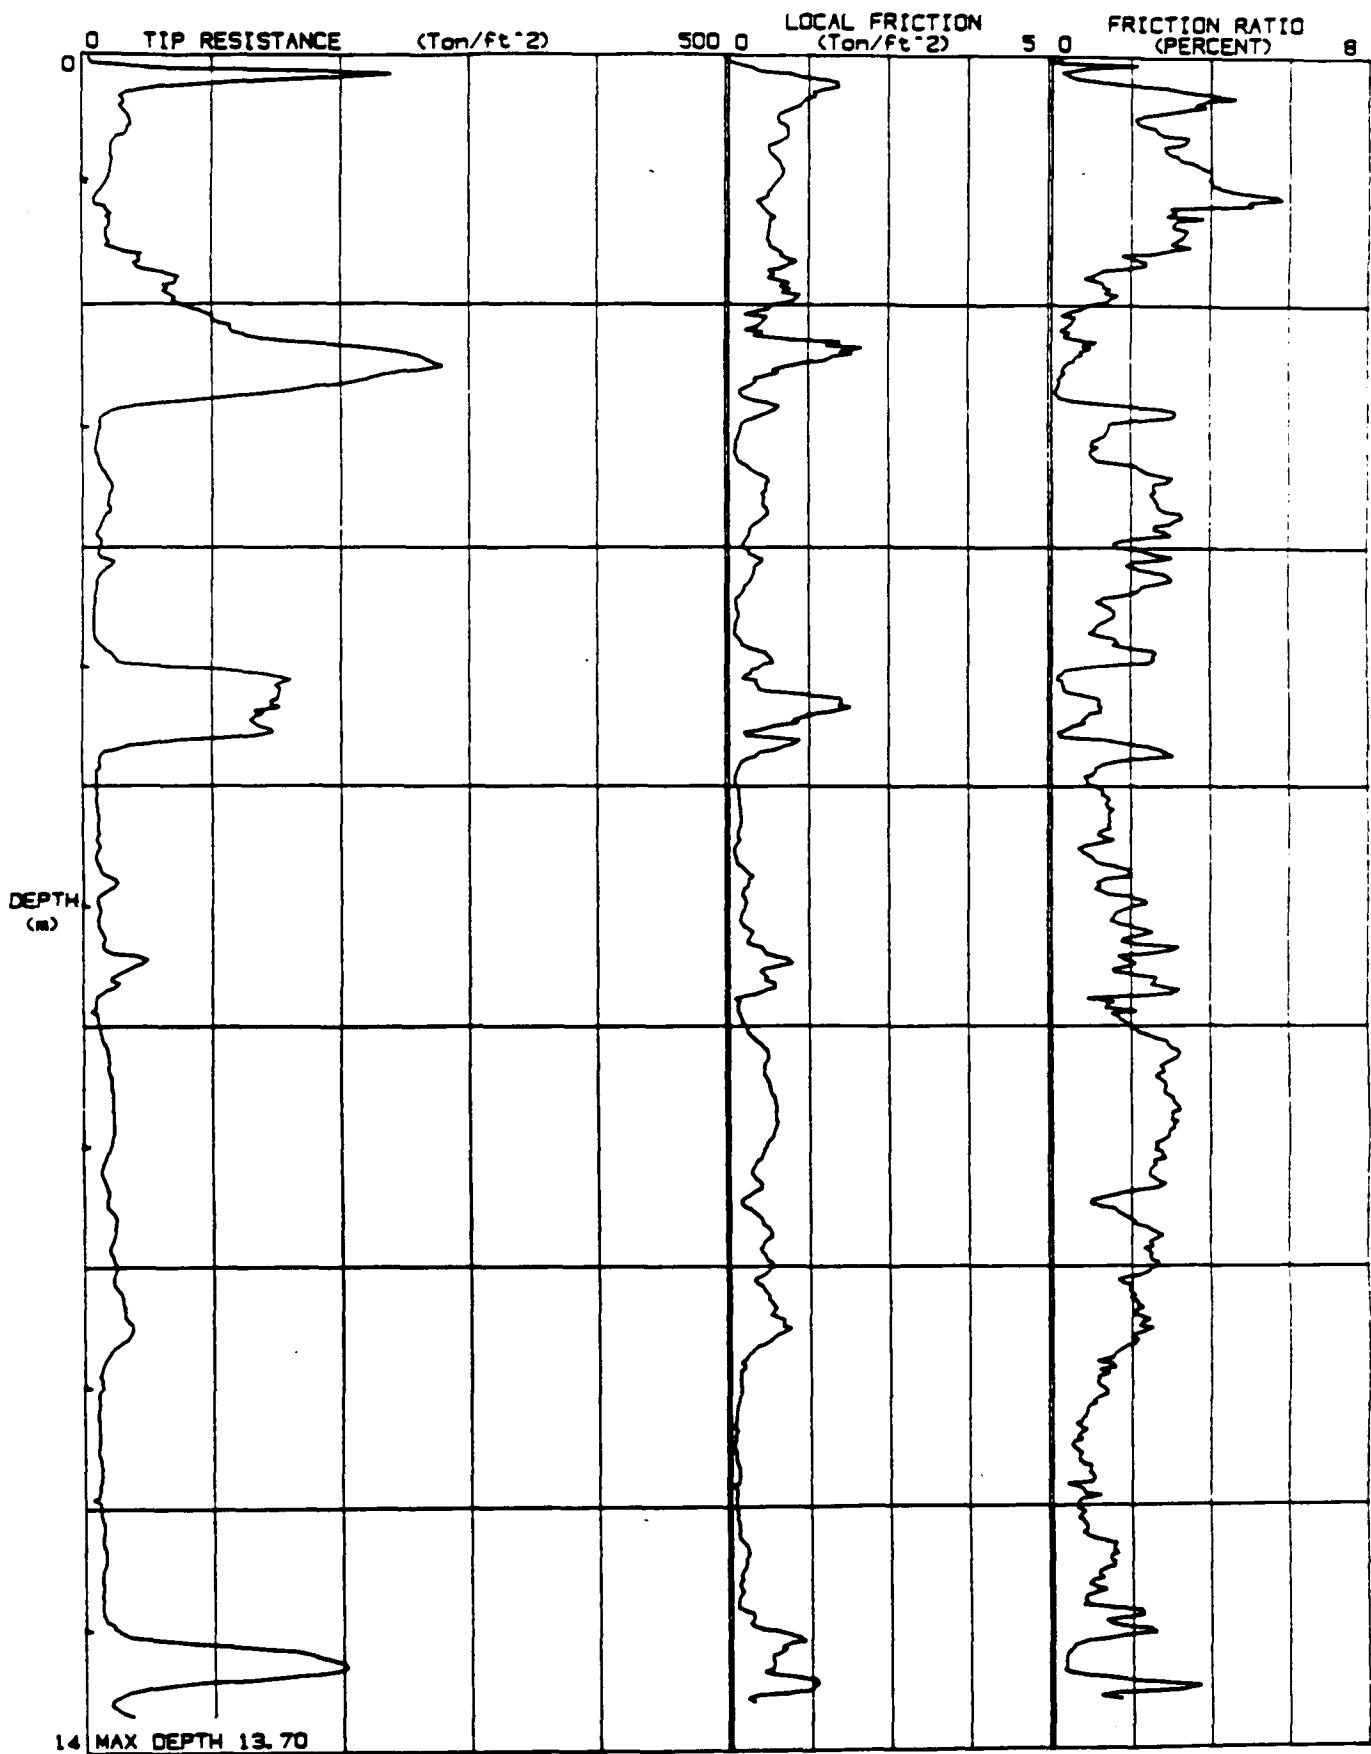

JOB # : 405700
DATE : 01/22/90
LOCATION : CPT/HB-44
FILE # : 4



N00296.001452
MOFFETT FIELD
SSIC NO. 5090.3


**APPENDIX C – BORING LOGS
GEOPHYSICAL LOGS**

SITE 9 – CPT (CLEAN)


**REMEDIAL INVESTIGATION REPORT
OPERABLE UNIT 4: WEST SIDE AQUIFERS**

DATED 01 AUGUST 1992


JOB # : 2738.0182
DATE : 10/29/90 15:27
LOCATION : CPT-08-5
FILE : FIL004

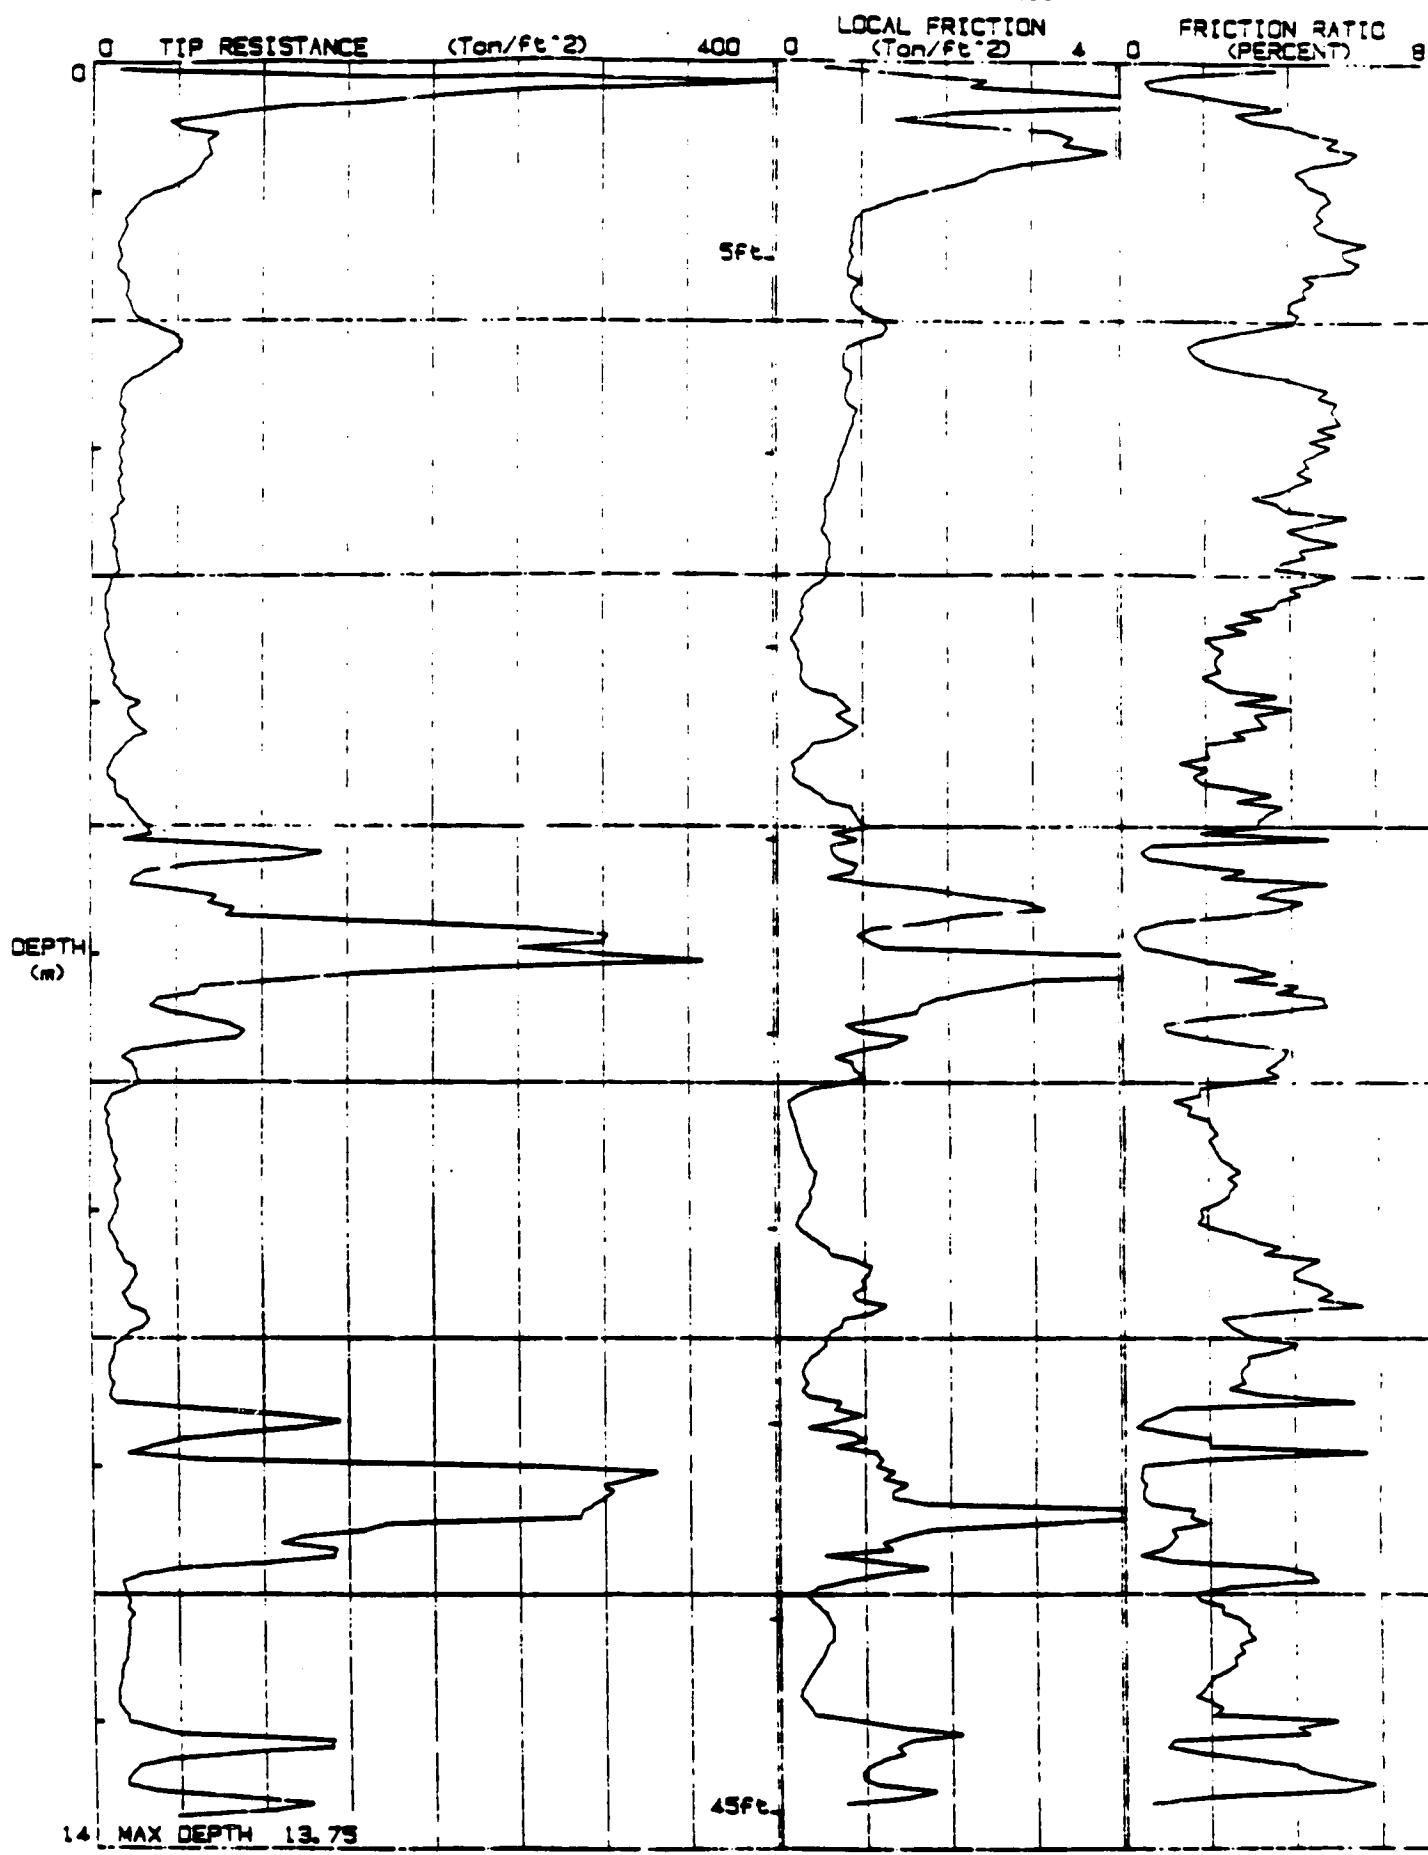


JOB # : 2738.0182
DATE : 10/29/80 15:27
LOCATION : CPT-08-3
FILE : FIL004

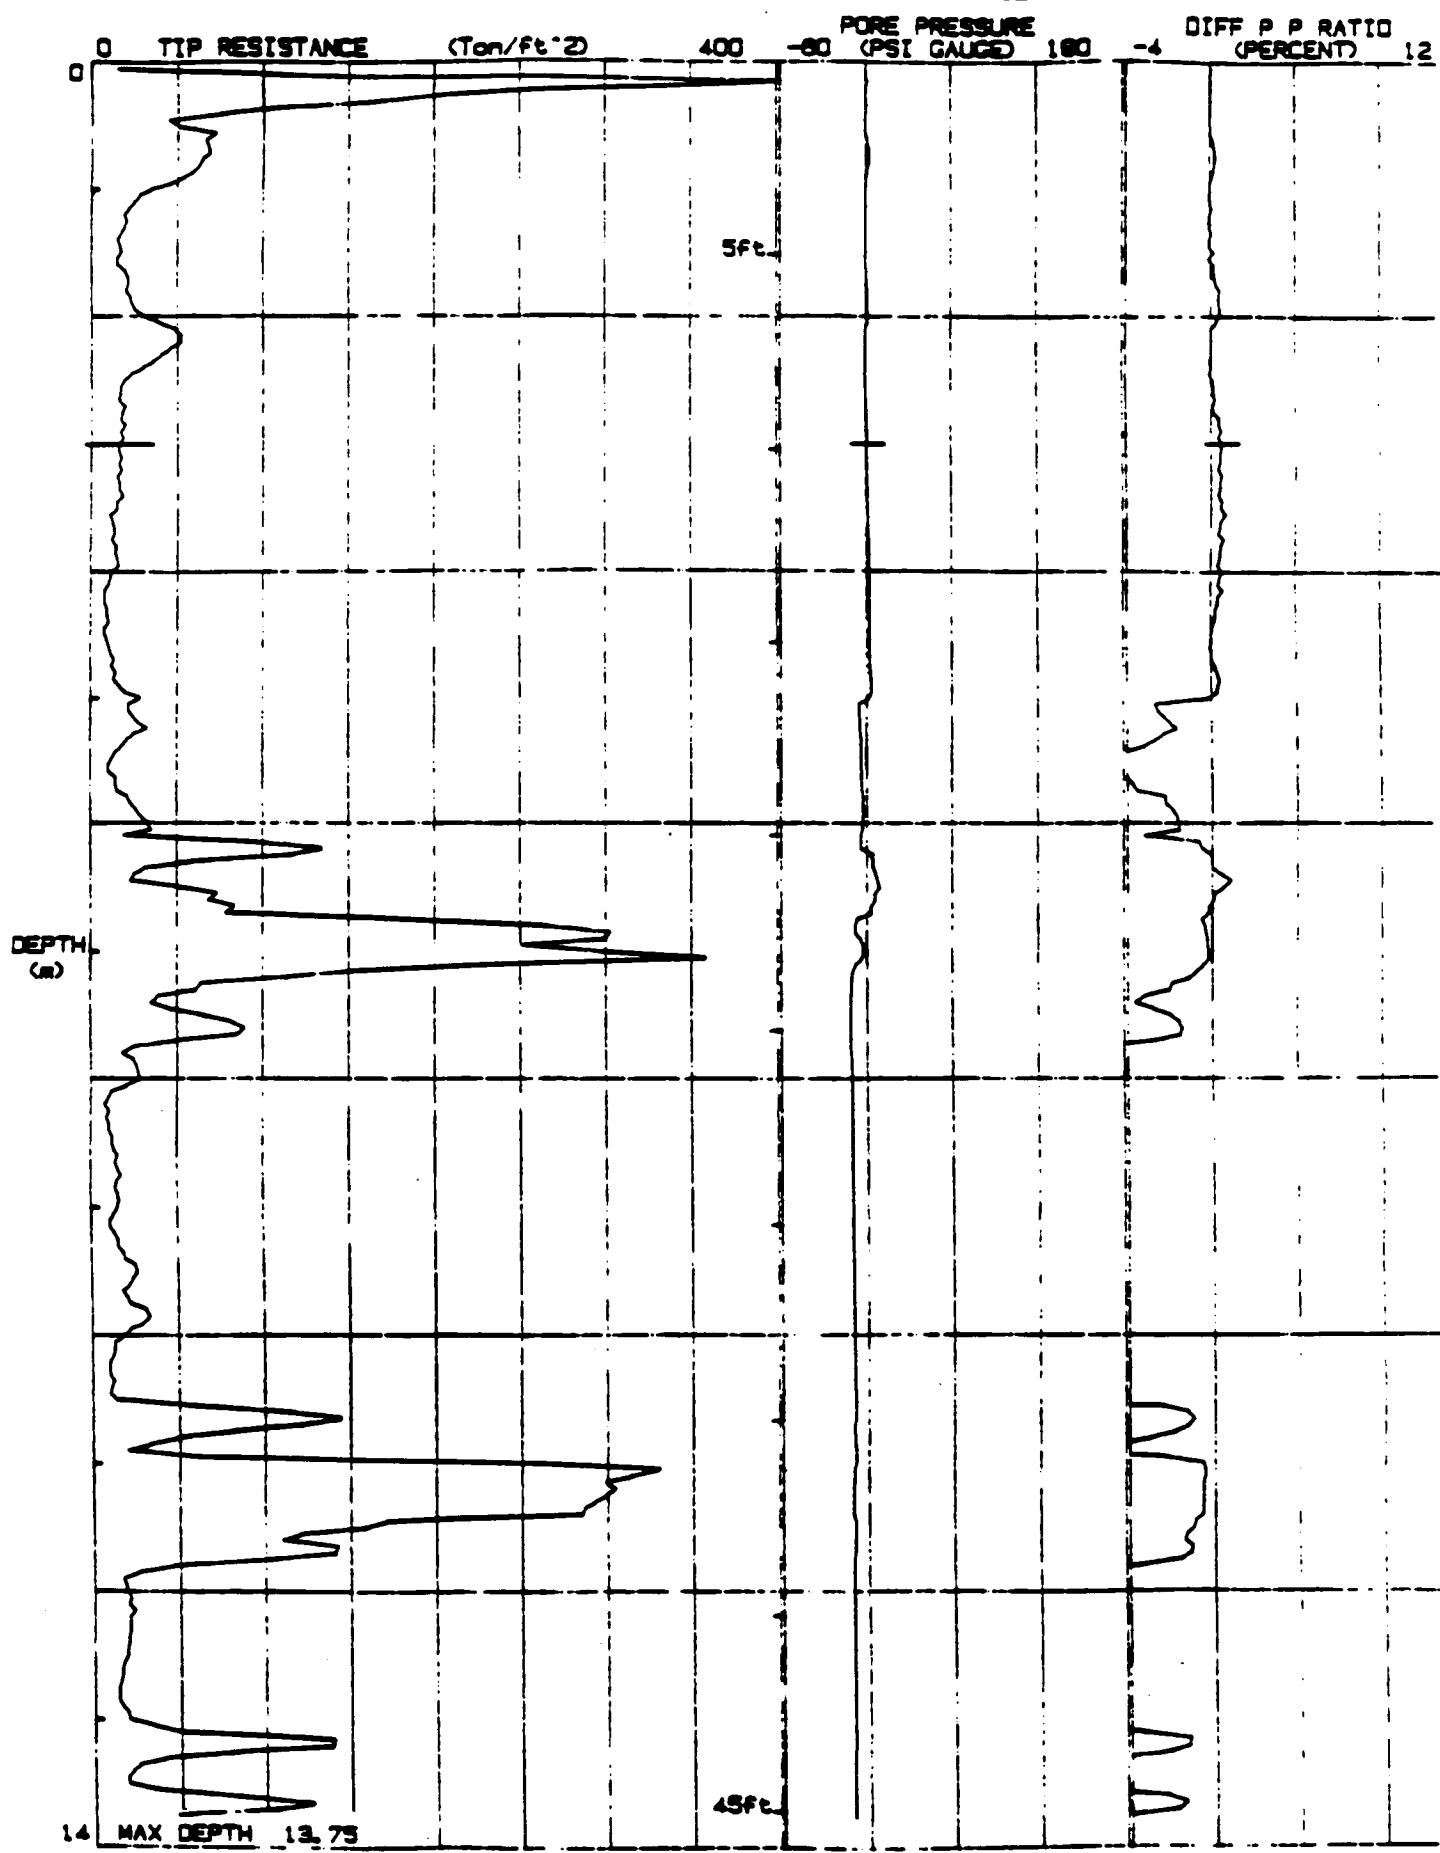


JOB # : 2738L 0182
DATE : 10/31/80 12:43
LOCATION : CPT-88-13
FILE : FIL010

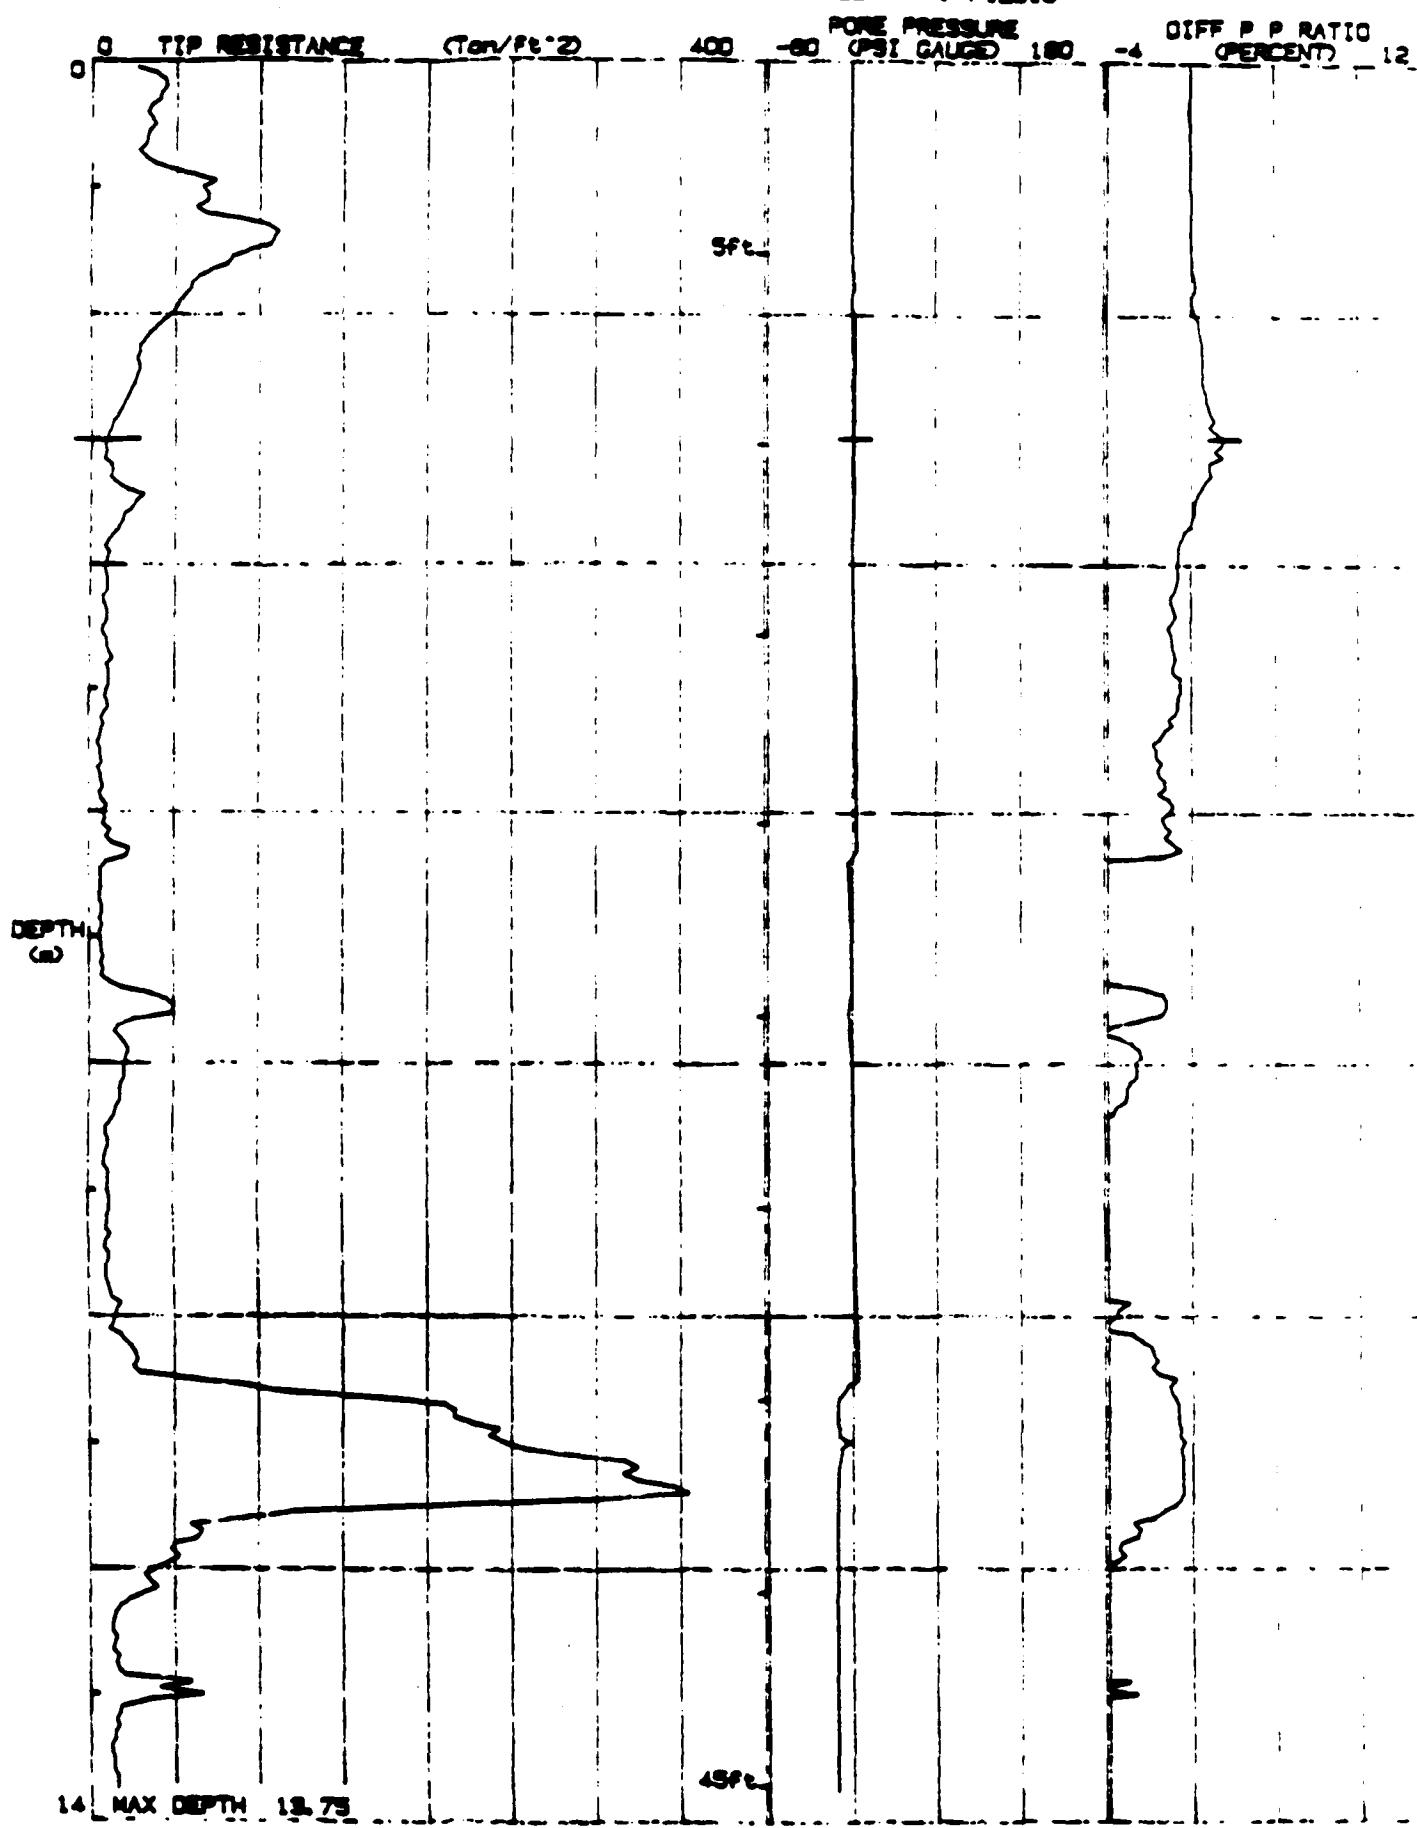


JOB # : 2738.0030
DATE : 11/27/80 15:18
LOCATION : CPT29-18
FILE : FIL029

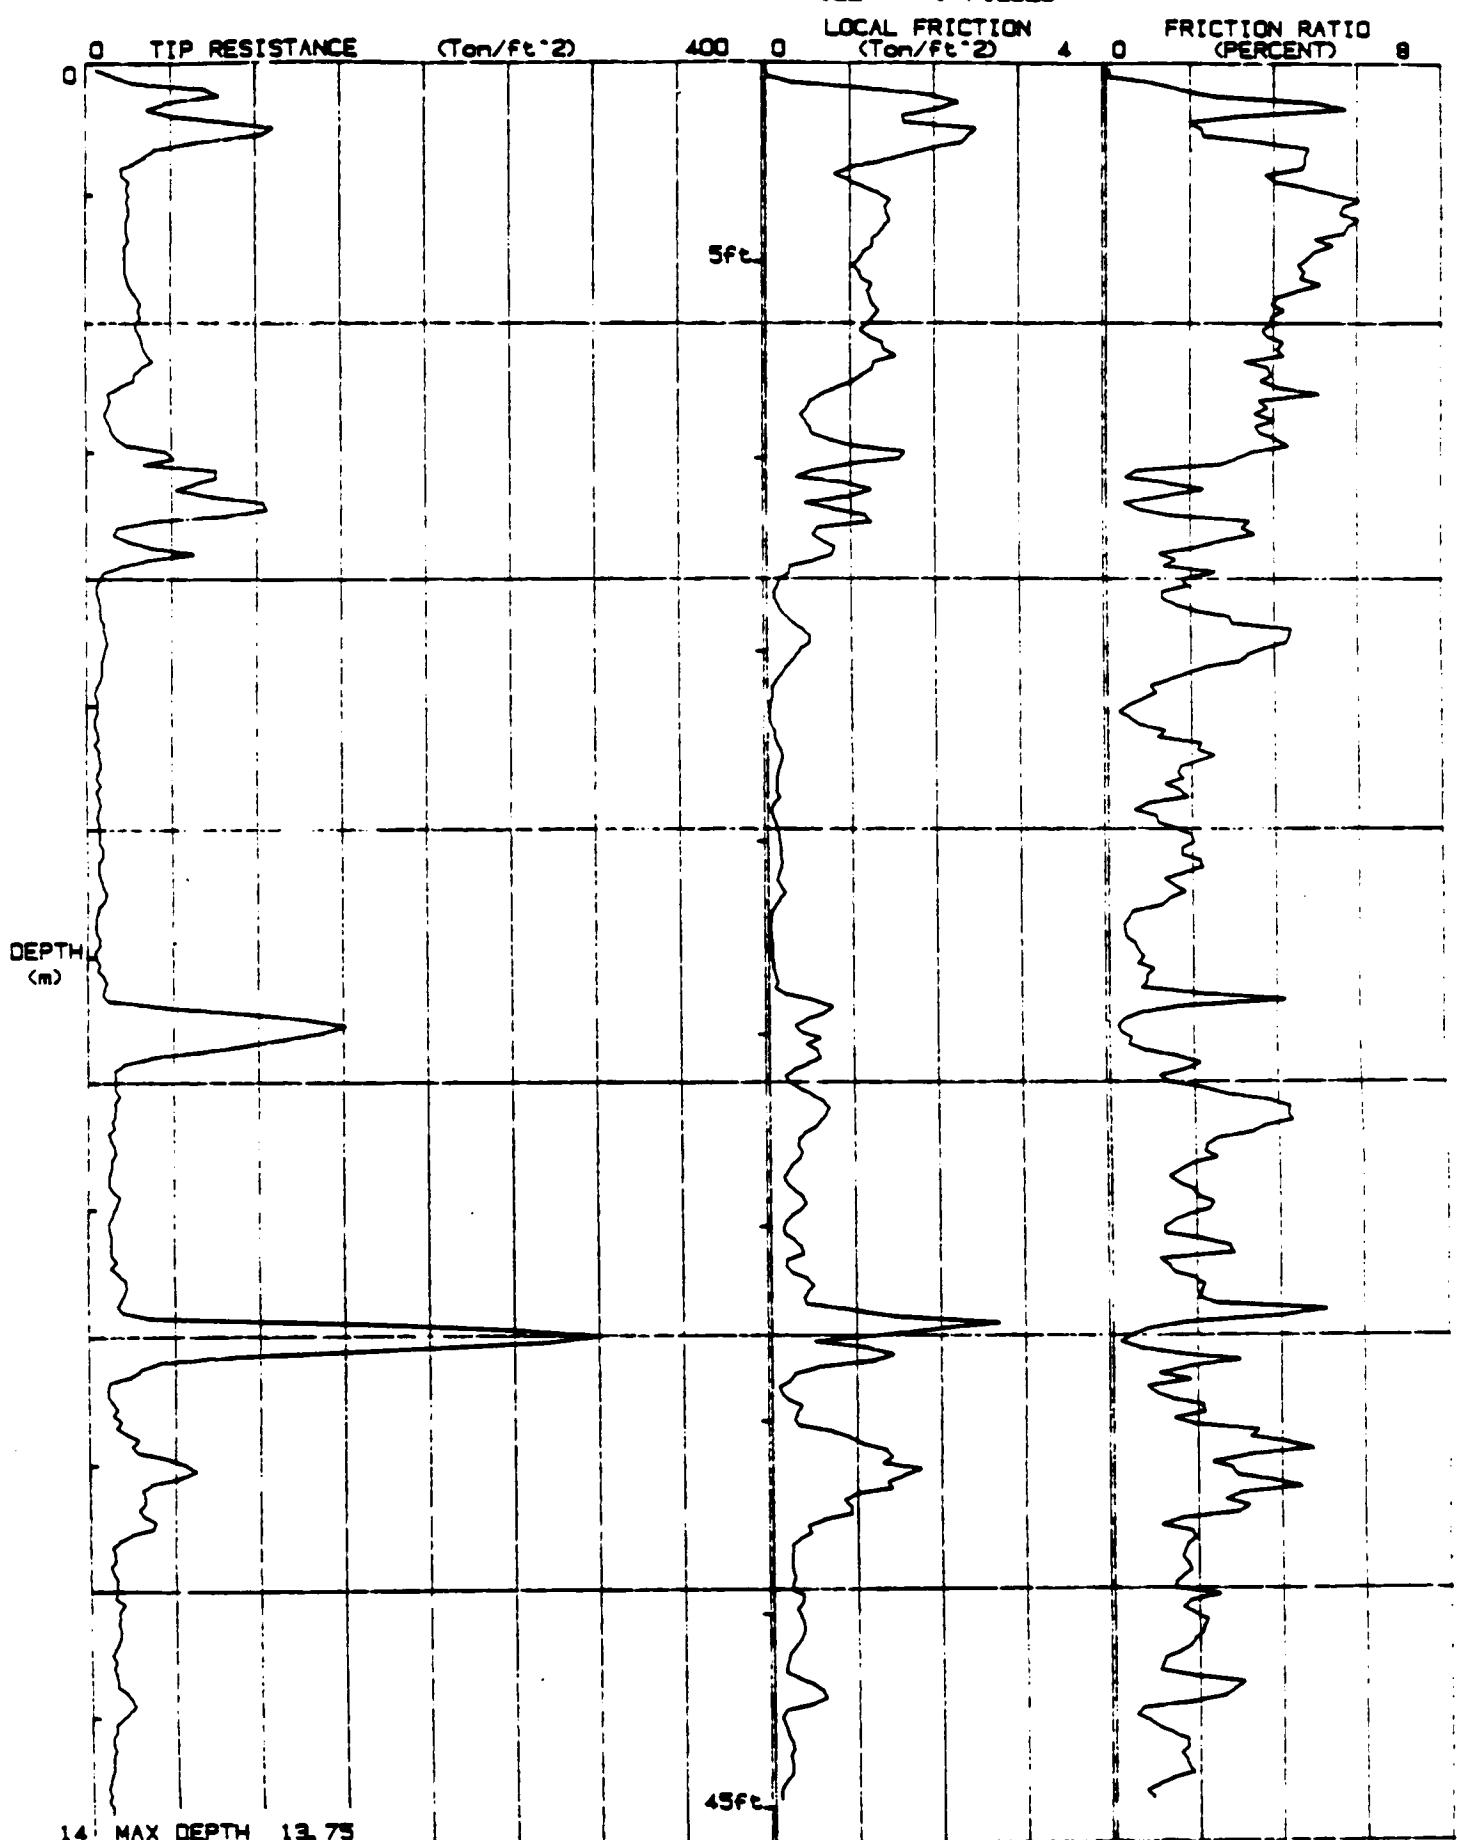

JOB # : 2730.0030
DATE : 11/27/90 15:18
LOCATION : CPT29-1B
FILE : FILO29

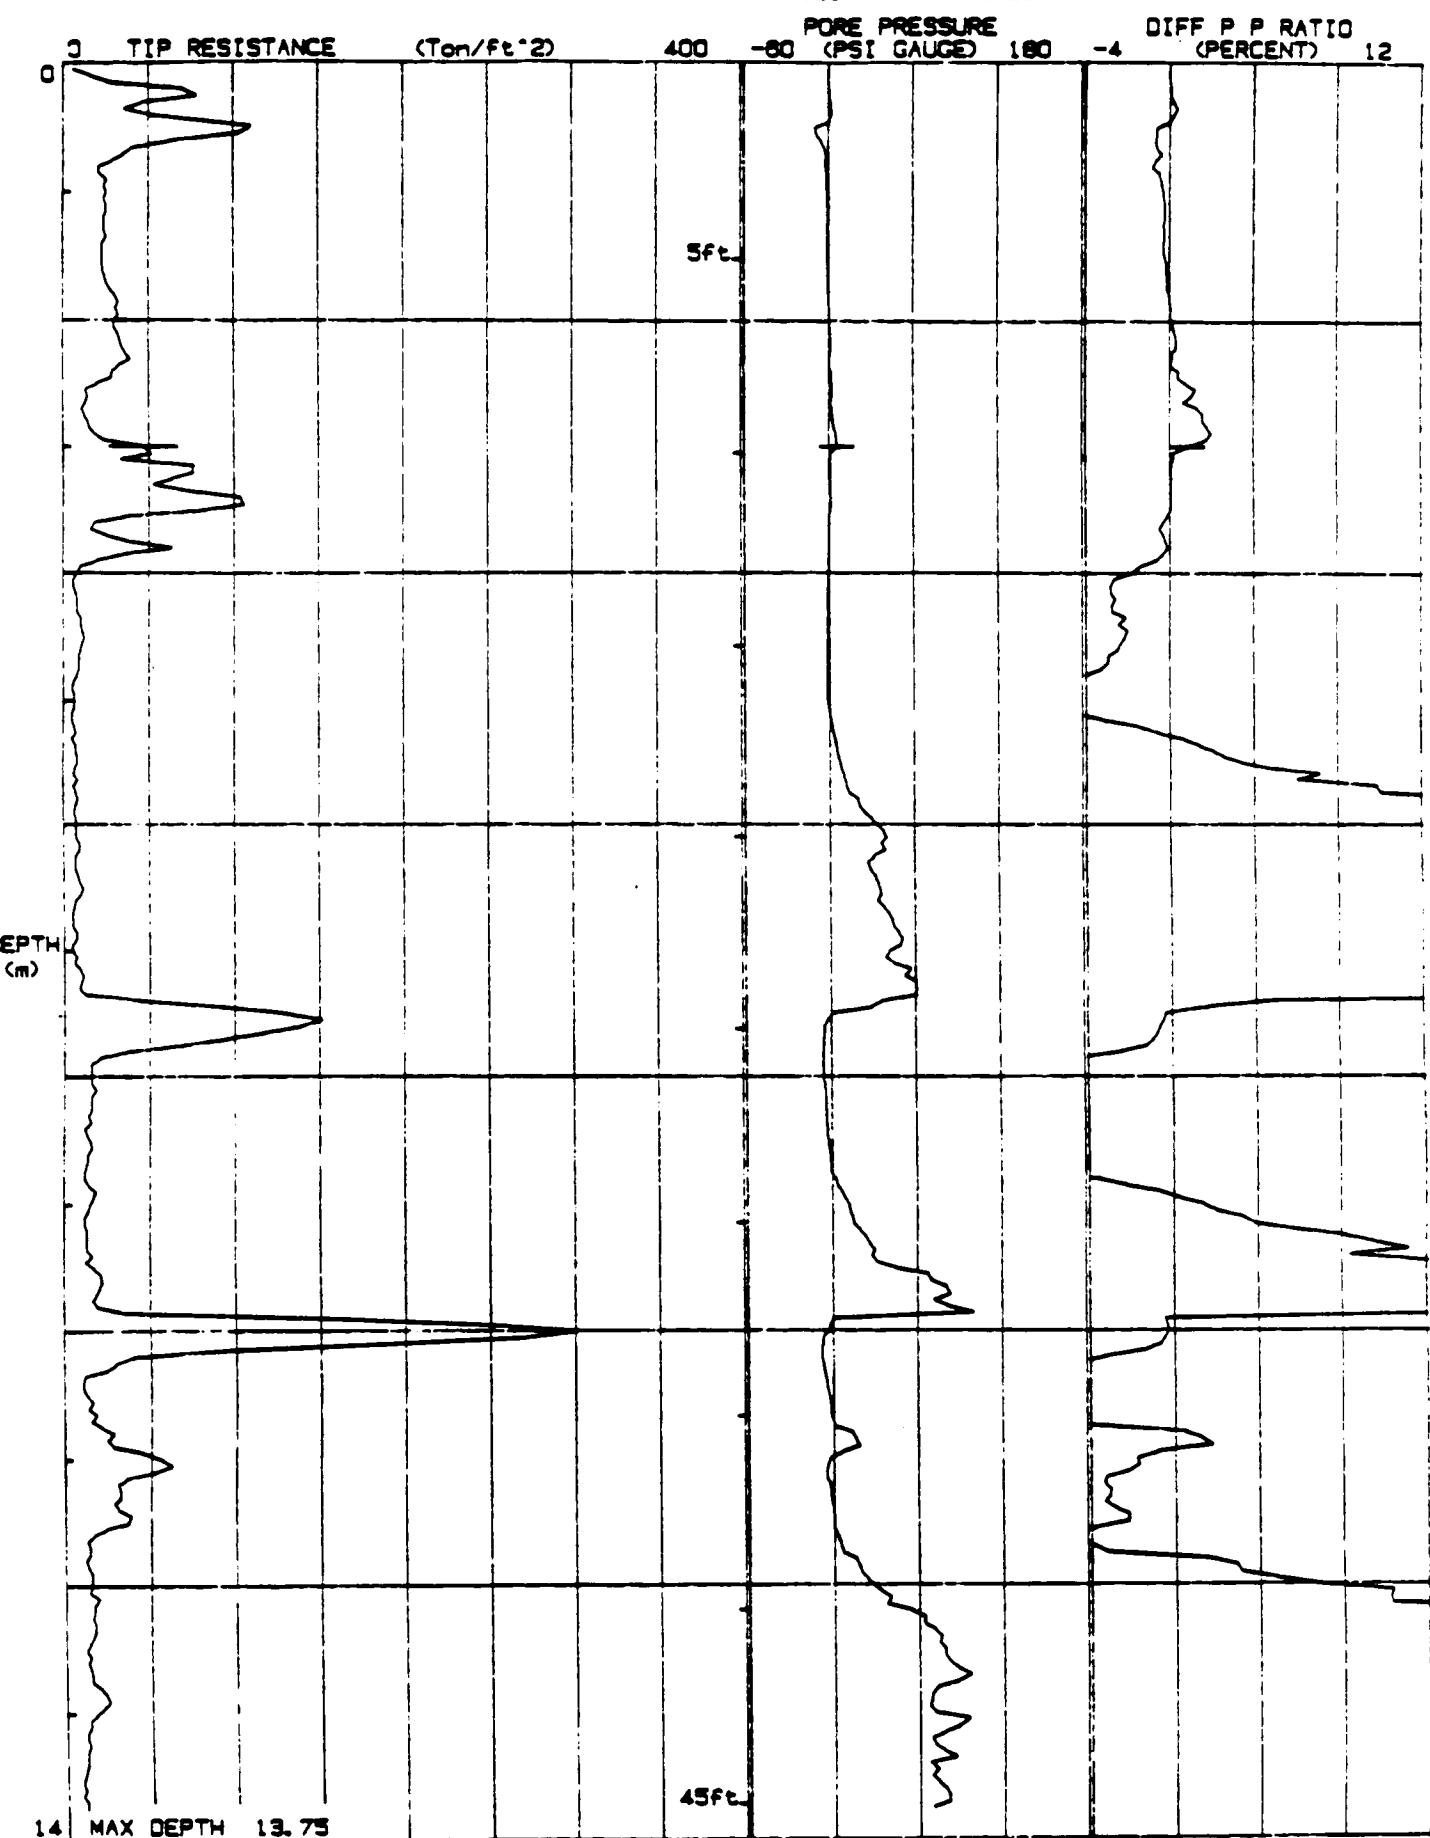


JOB # : 2730L 0030
DATE : 11/27/80 17:48
LOCATION : CPT29-40
FILE : FIL025

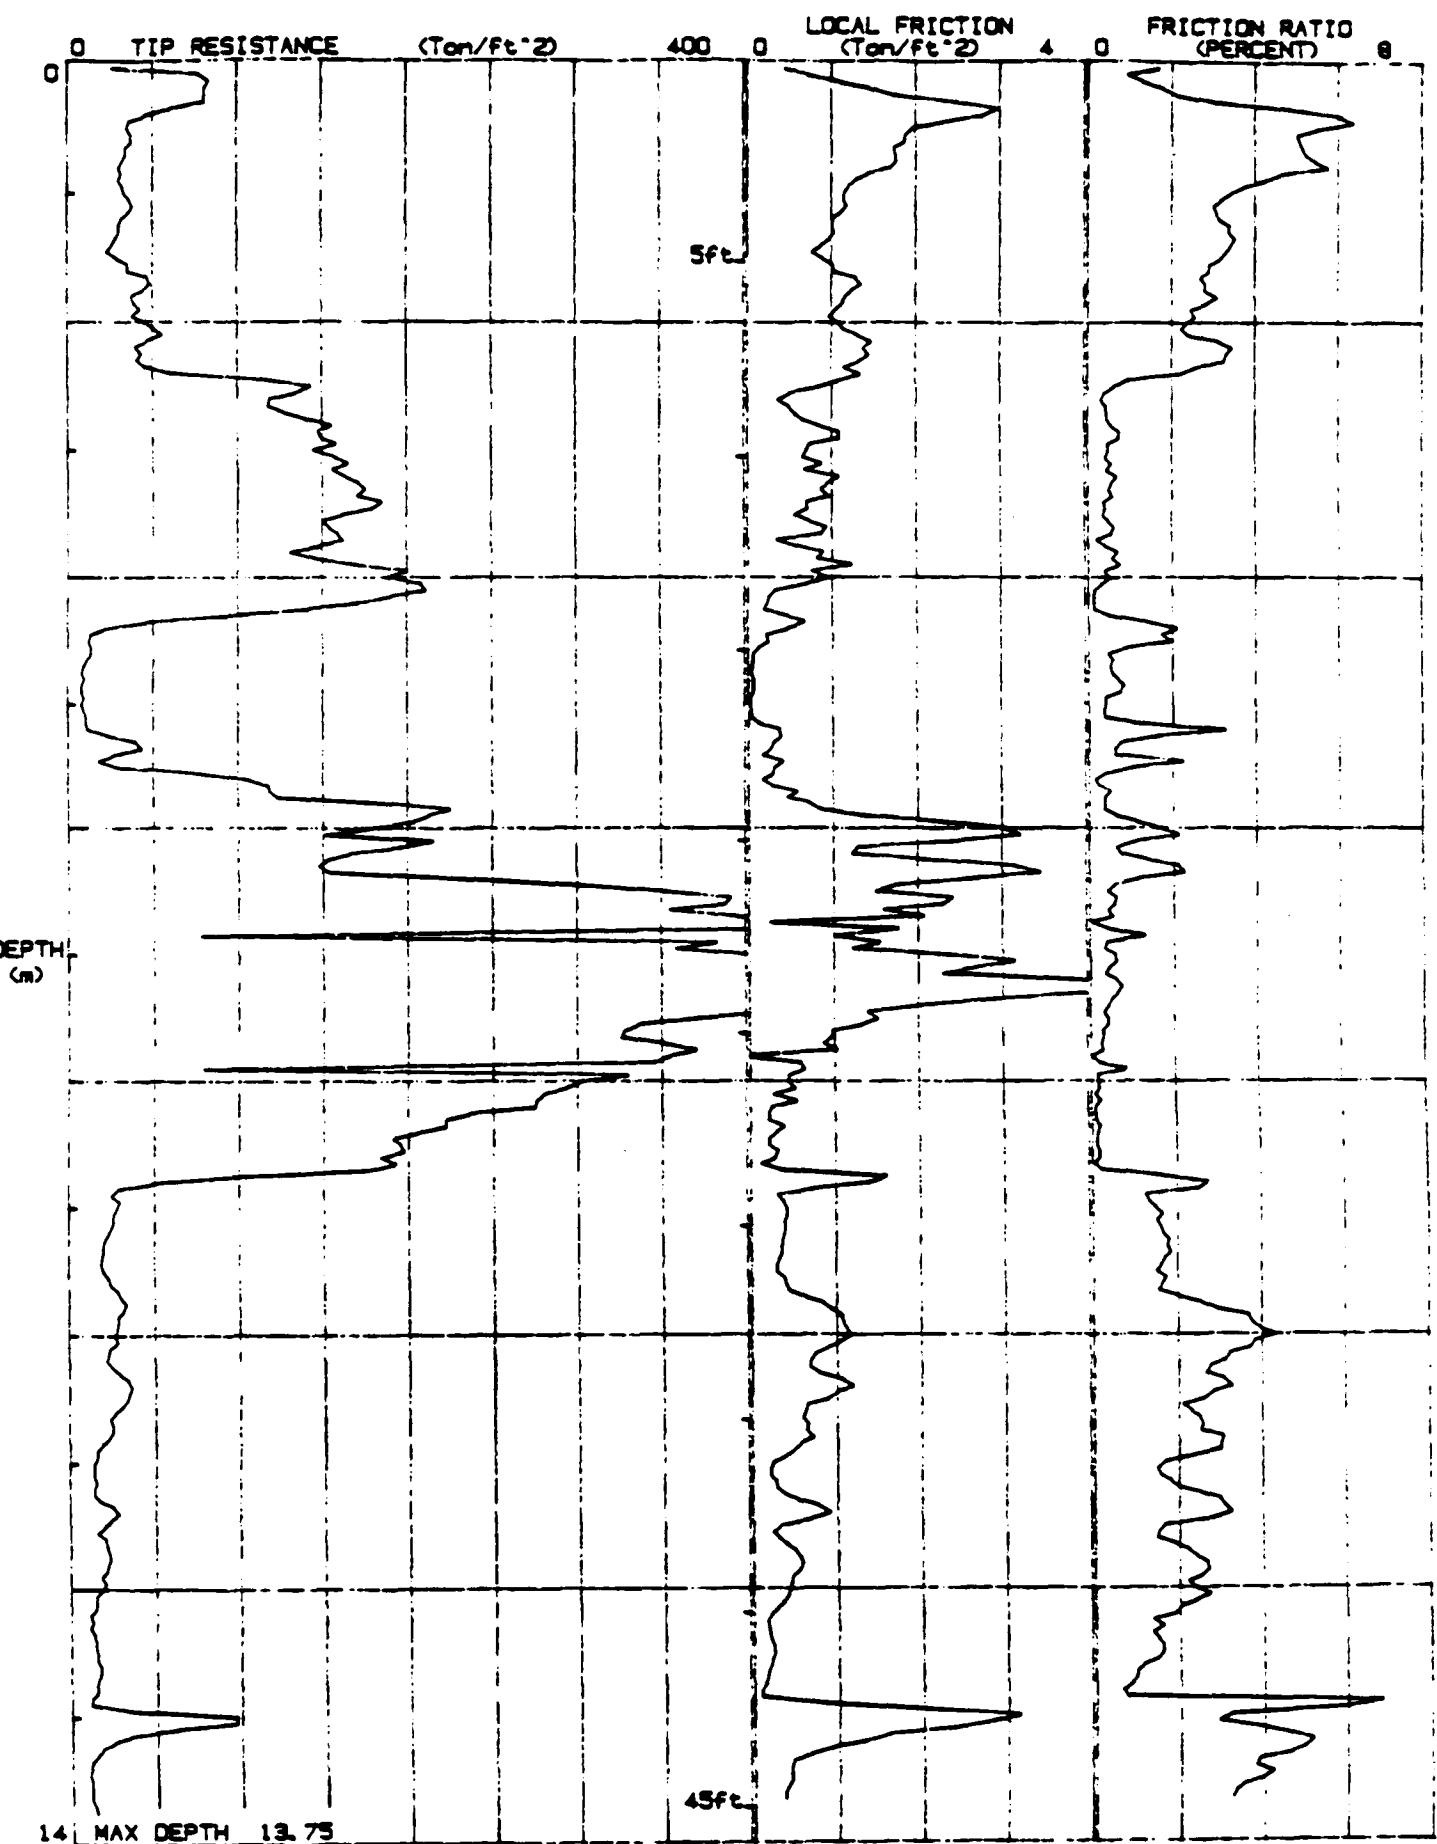

14 MAX DEPTH 13.75

45ft

JOB # : 273L 0030
DATE : 11/27/80 17:48
LOCATION : CPT28-40
FILE : FIL025

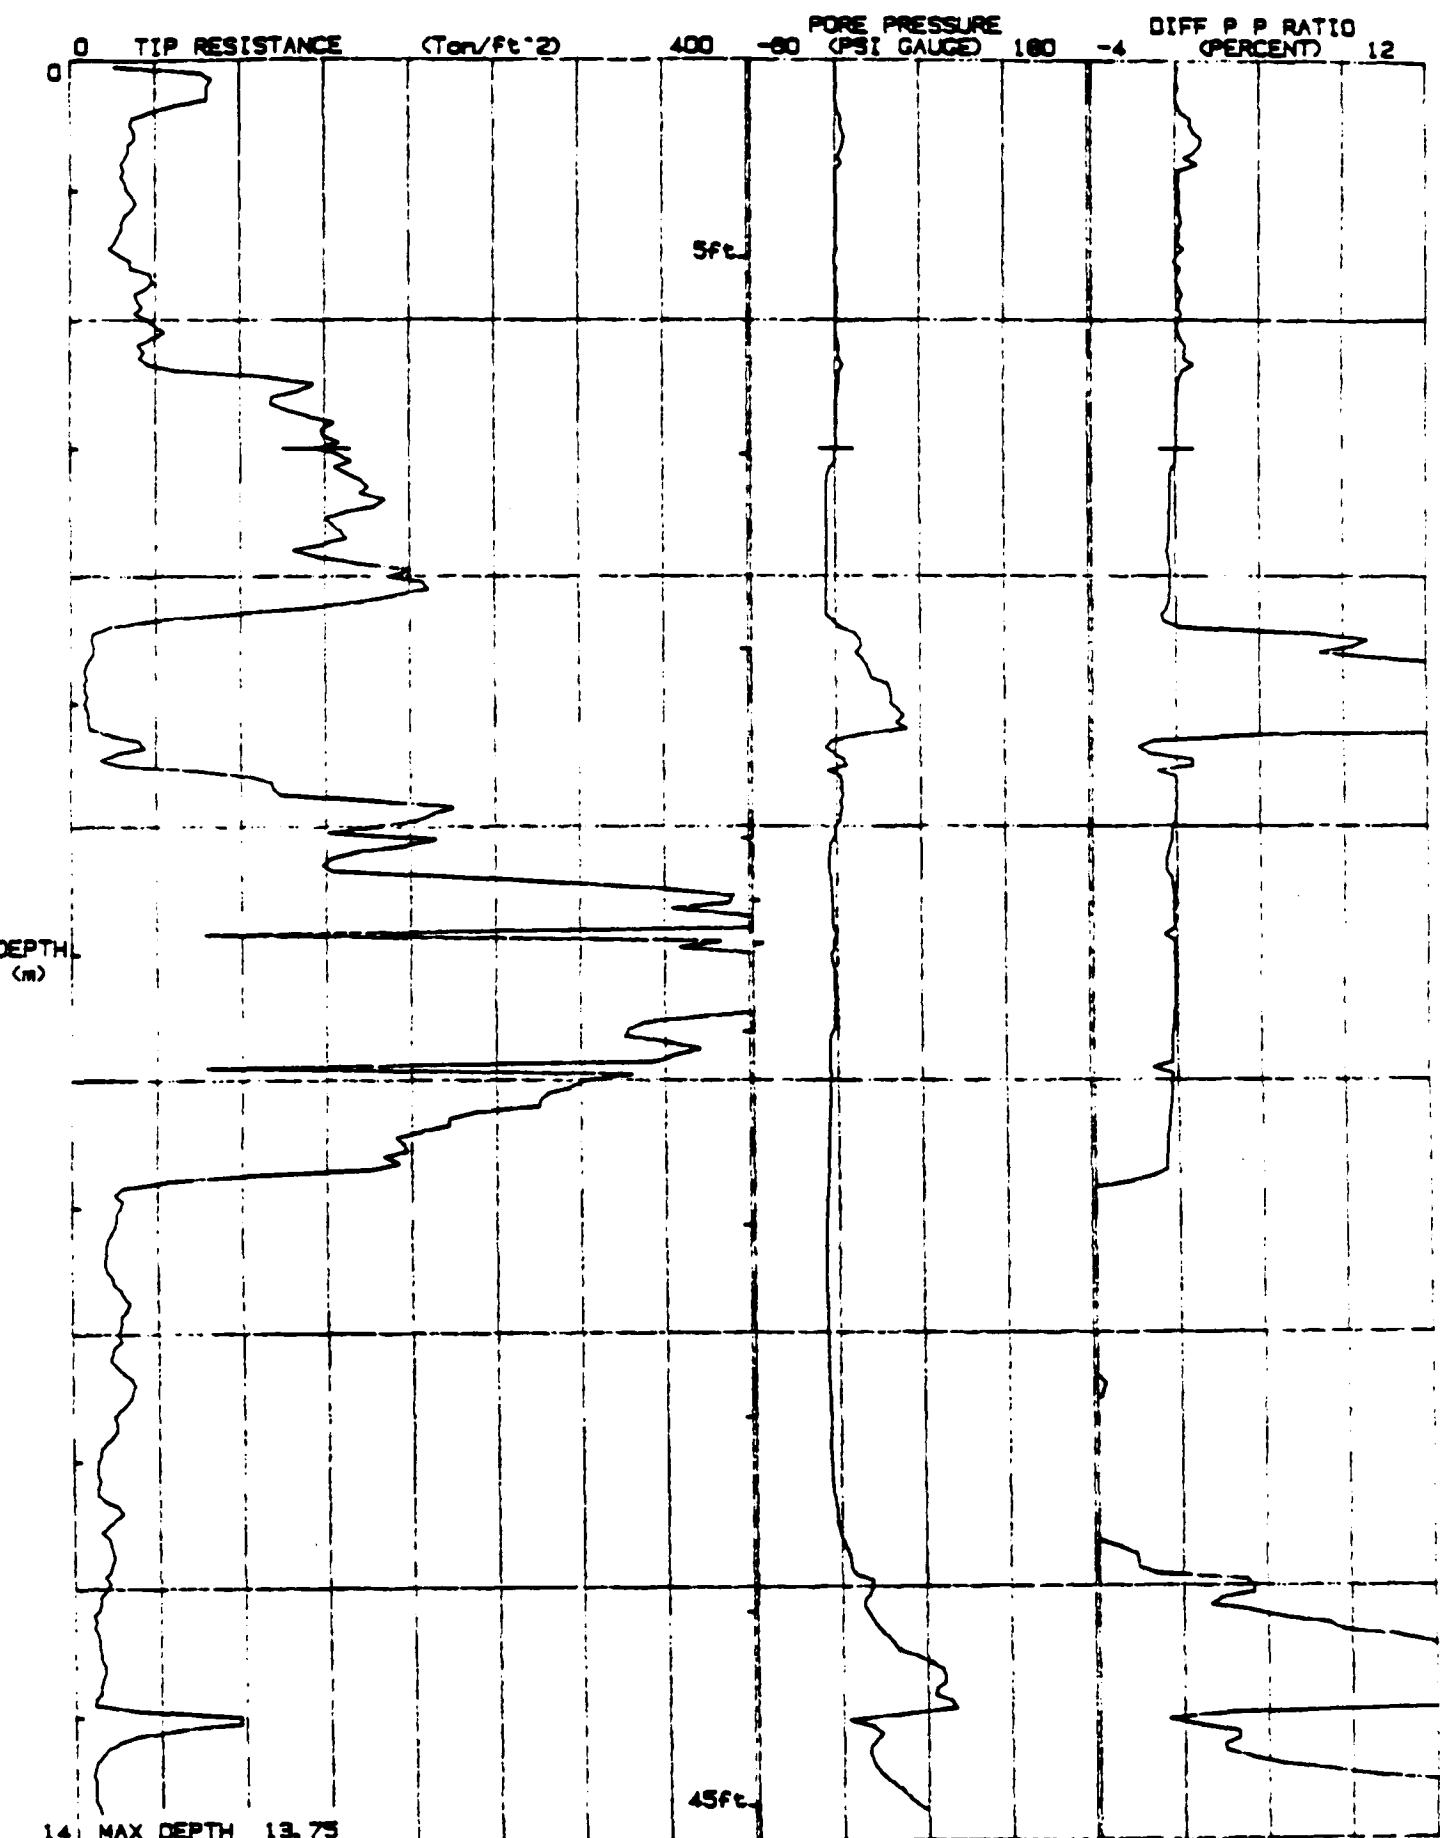

VOLUME 3, APPENDIX C

GEOPHYSICAL LOGS


N00296.001452
MOFFETT FIELD
SSIC NO. 5090.3


**APPENDIX C – BORING LOGS
GEOPHYSICAL LOGS**

SITE 1

**REMEDIAL INVESTIGATION REPORT
OPERABLE UNIT 4: WEST SIDE AQUIFERS**

DATED 01 AUGUST 1992

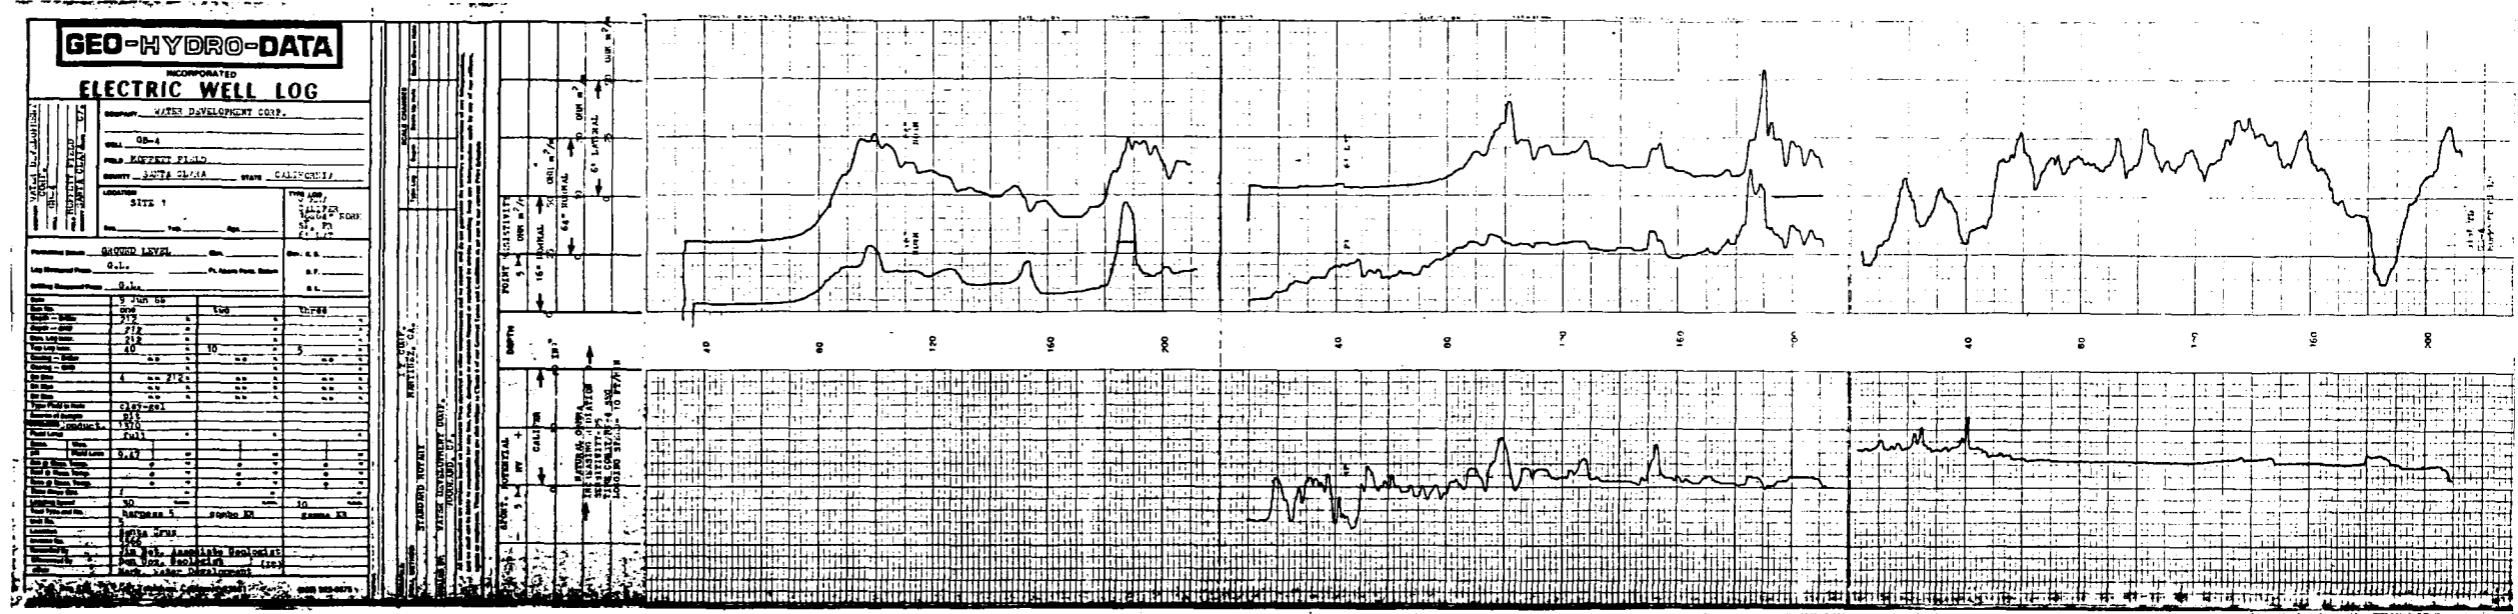

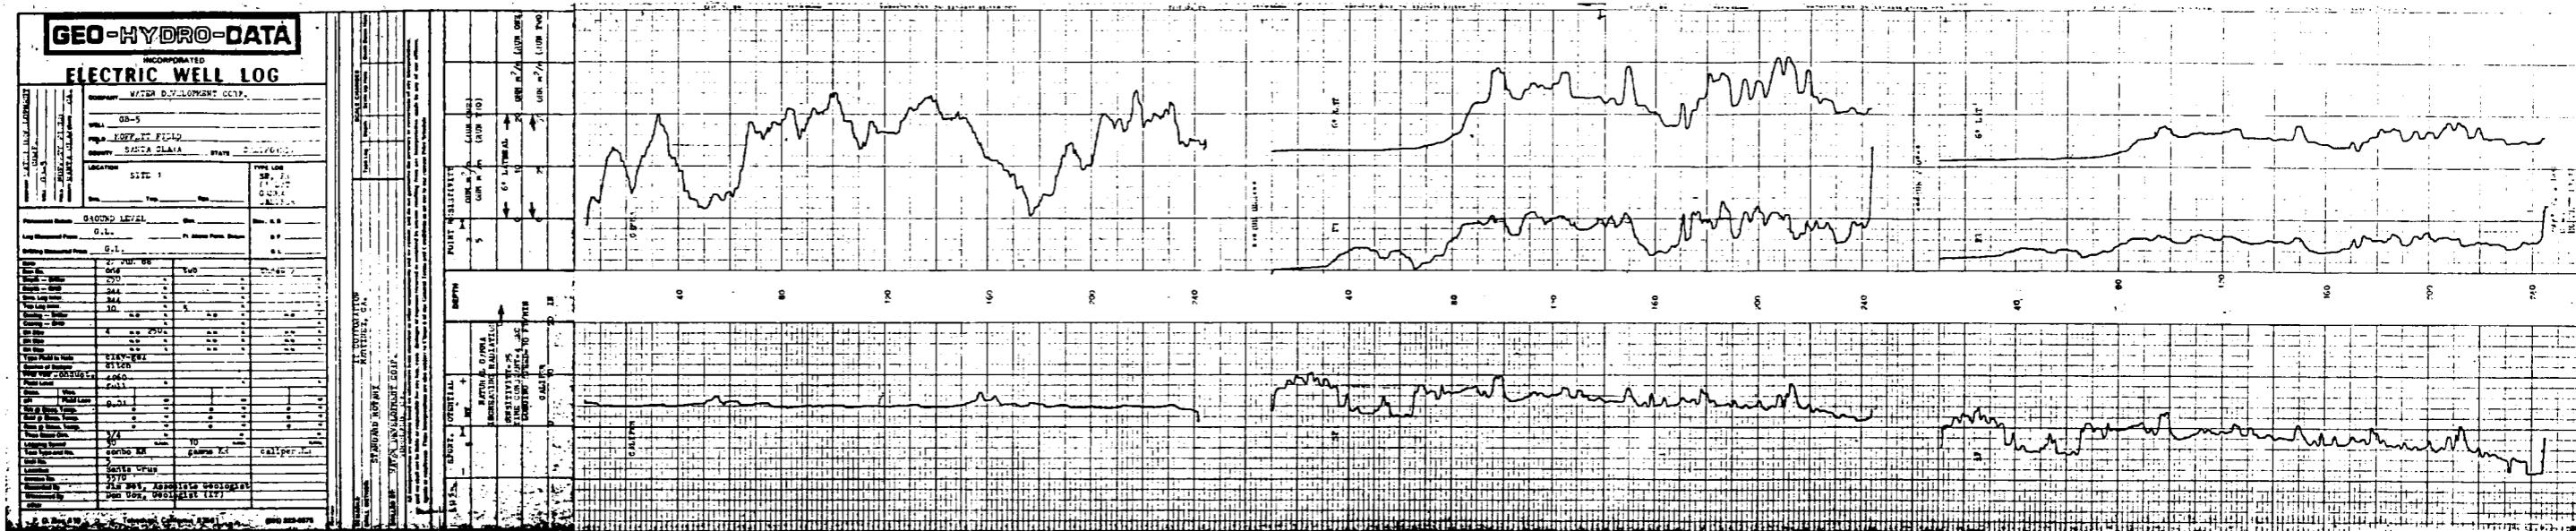


GEO-HYDRO-DATA

INCORPORATED

ELECTRIC WELL LOG

COMPANY	WATER DEVELOPMENT CORP.	
Sec.	Top	Right
Permit Number GROUND LEVEL		Site E.
Log Recovered From G.L. Pt. Above Pump. Bottom		B.P.
Drilling Recovered From GROUND LEVEL		G.L.


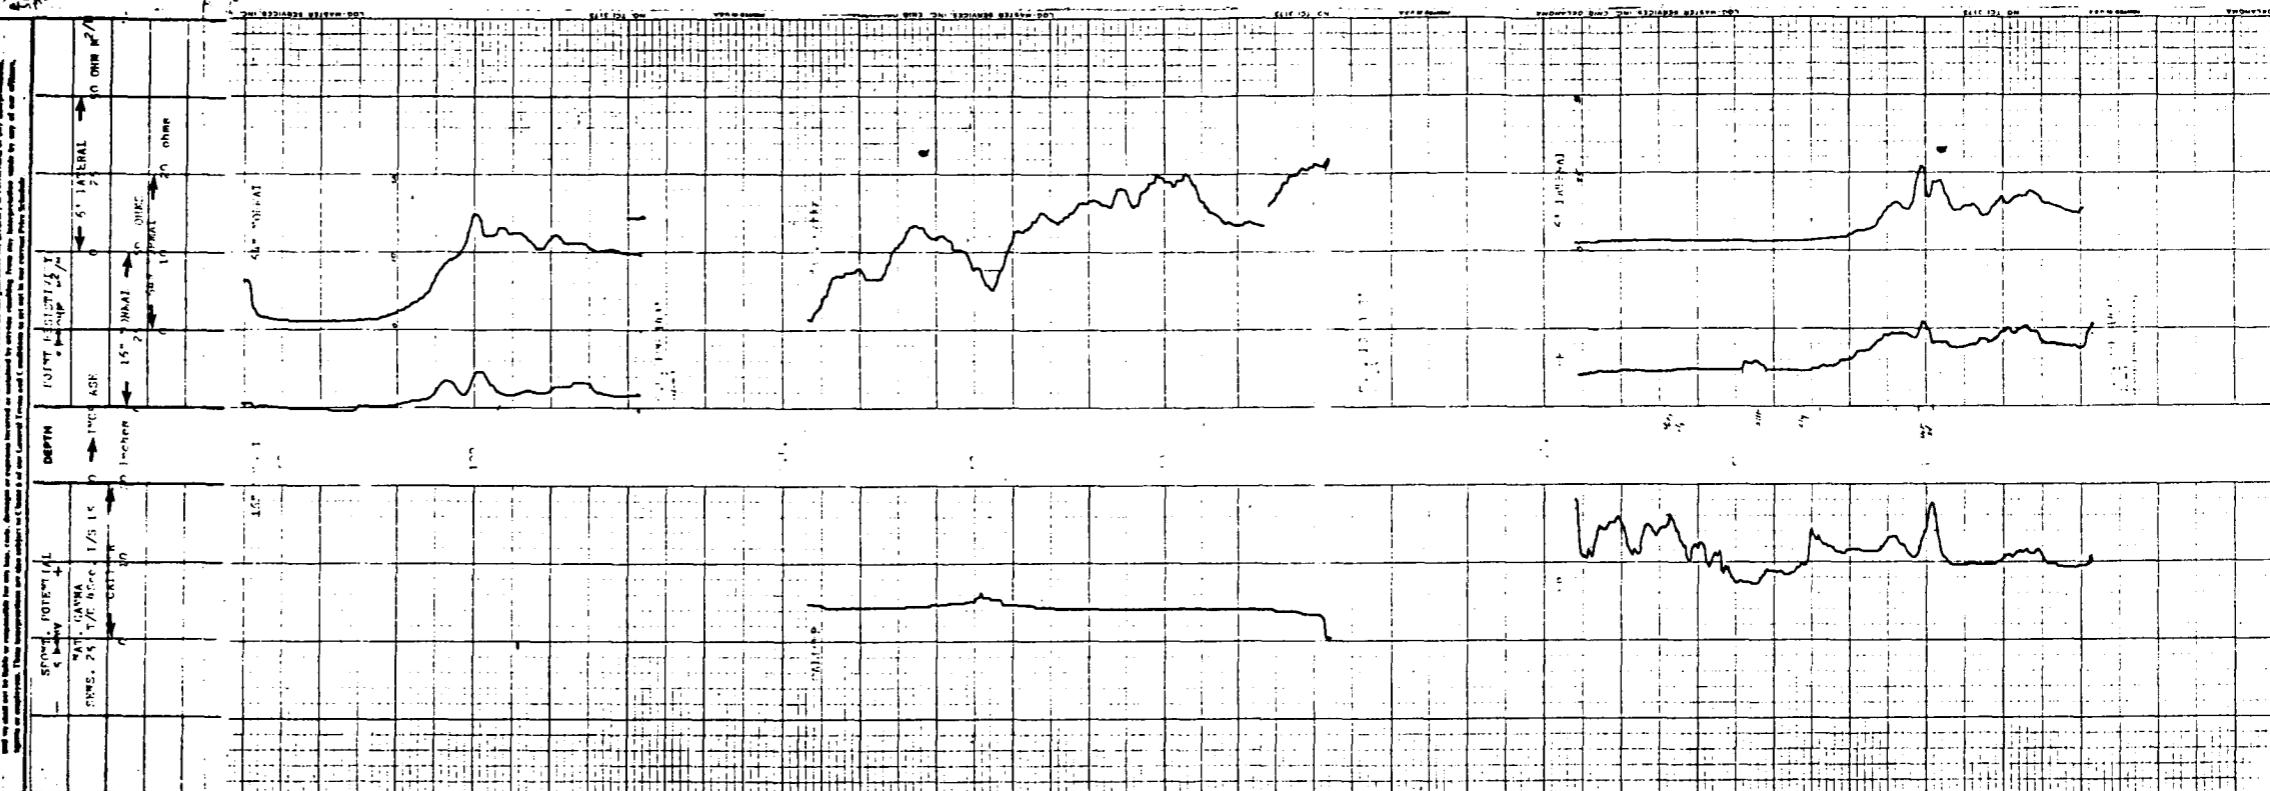


N00296.001452
MOFFETT FIELD
SSIC NO. 5090.3

**APPENDIX C – BORING LOGS
GEOPHYSICAL LOGS**

SITE 2

**REMEDIAL INVESTIGATION REPORT
OPERABLE UNIT 4: WEST SIDE AQUIFERS**


DATED 01 AUGUST 1992

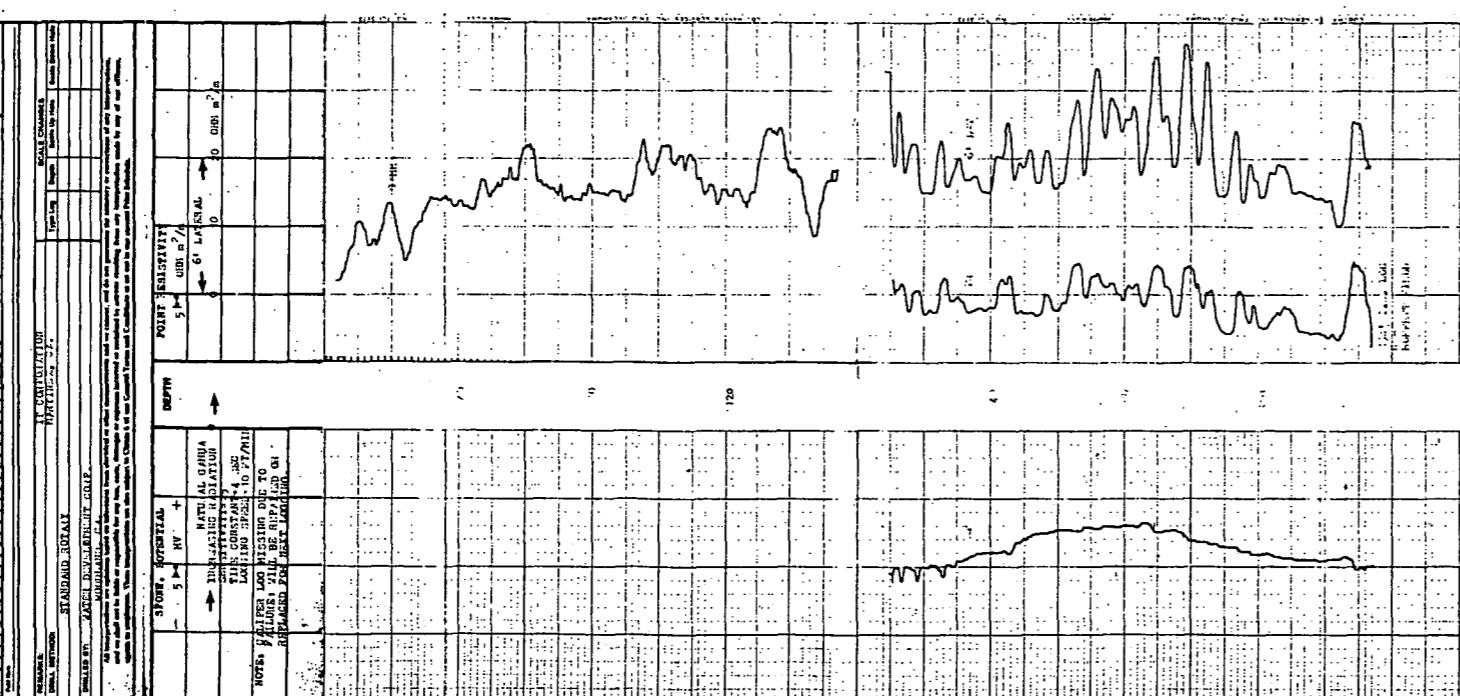

GEO-HYDRO-DATA
INCORPORATED

INCORPORATED
ELECTRIC WELL LOG

ELECTRIC WELL LOG

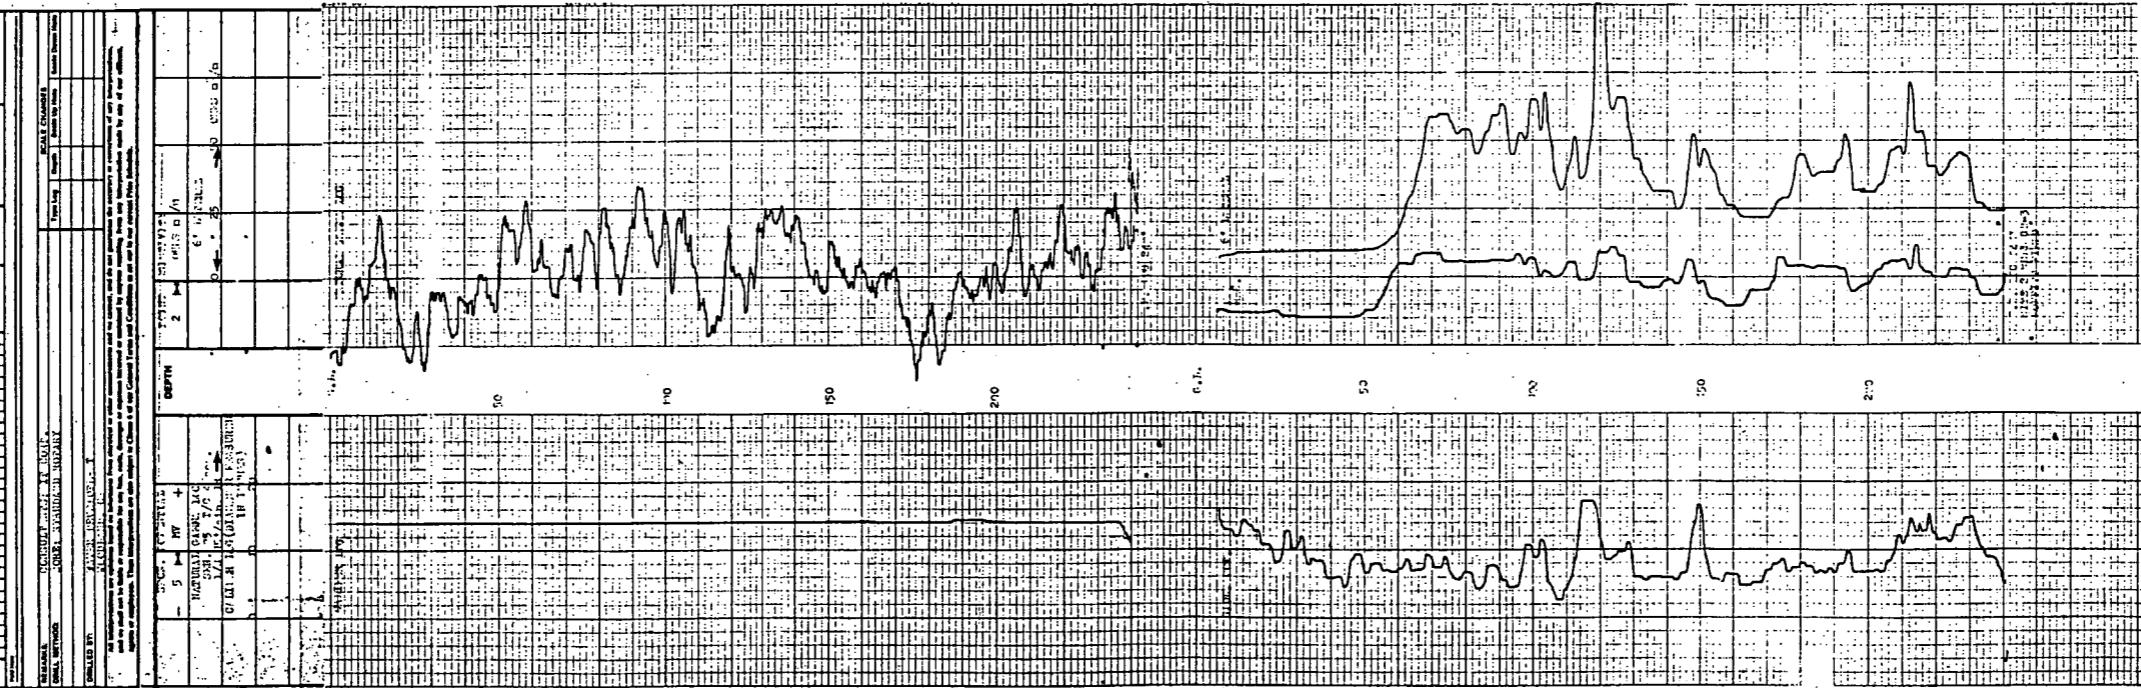


N00296.001452
MOFFETT FIELD
SSIC NO. 5090.3


**APPENDIX C – BORING LOGS
GEOPHYSICAL LOGS**

SITE 3

**REMEDIAL INVESTIGATION REPORT
OPERABLE UNIT 4: WEST SIDE AQUIFERS**

DATED 01 AUGUST 1992

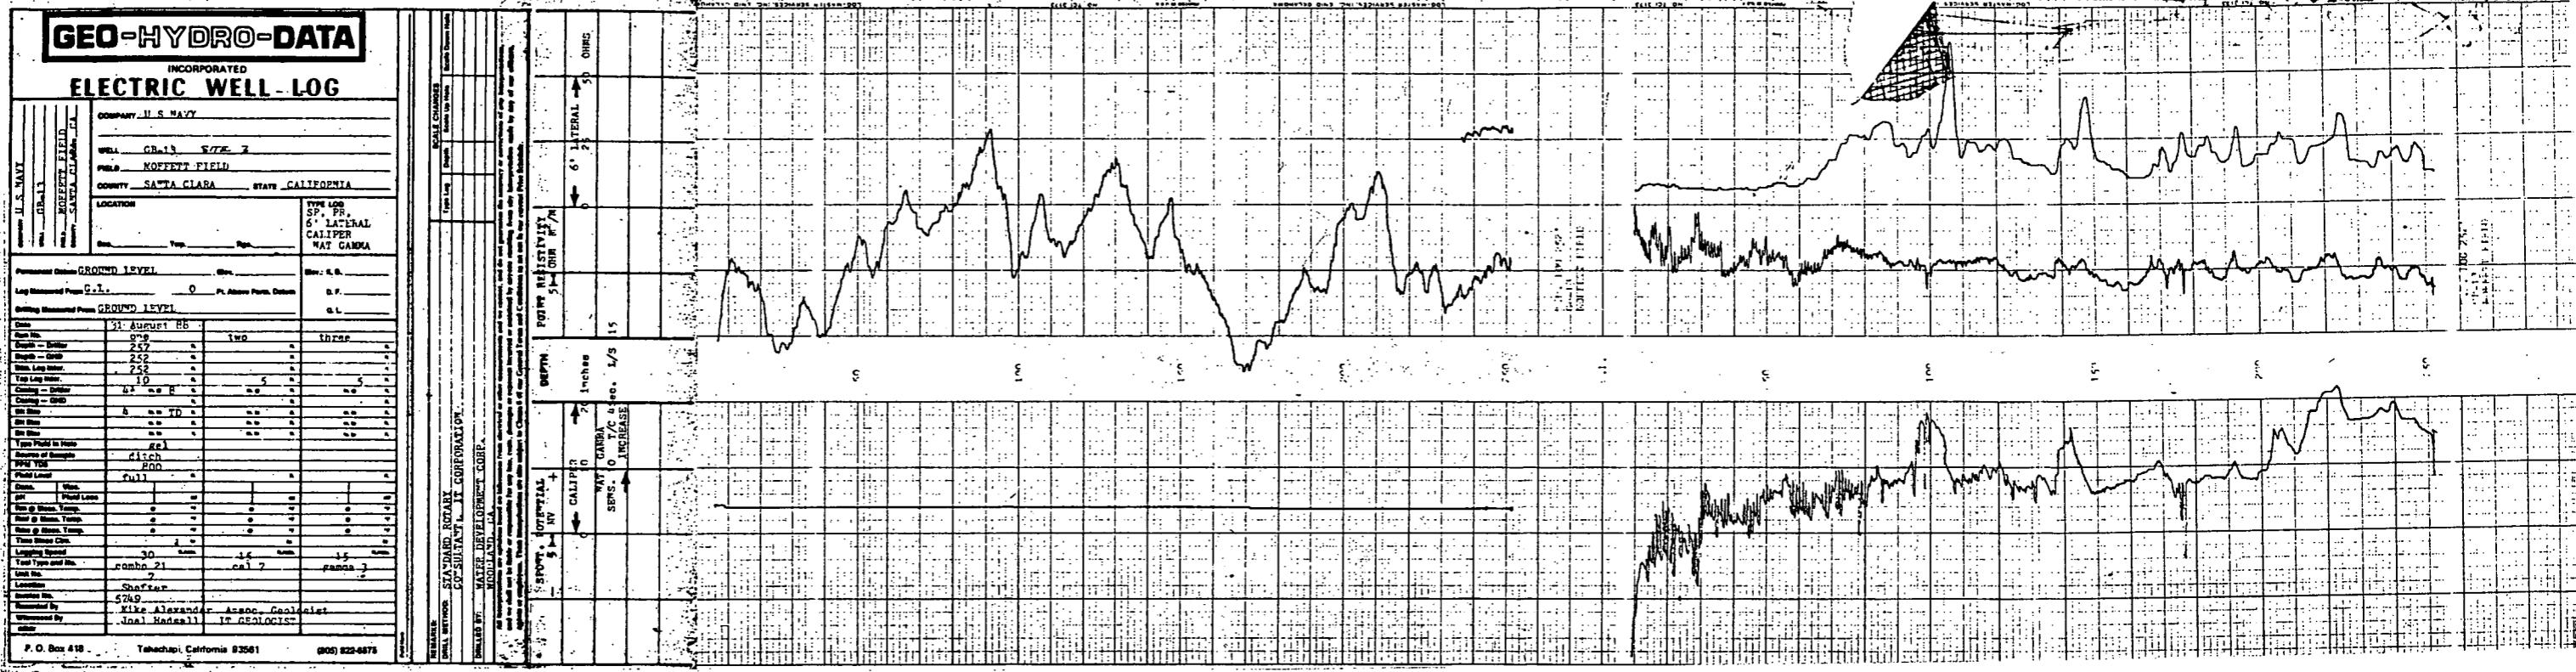


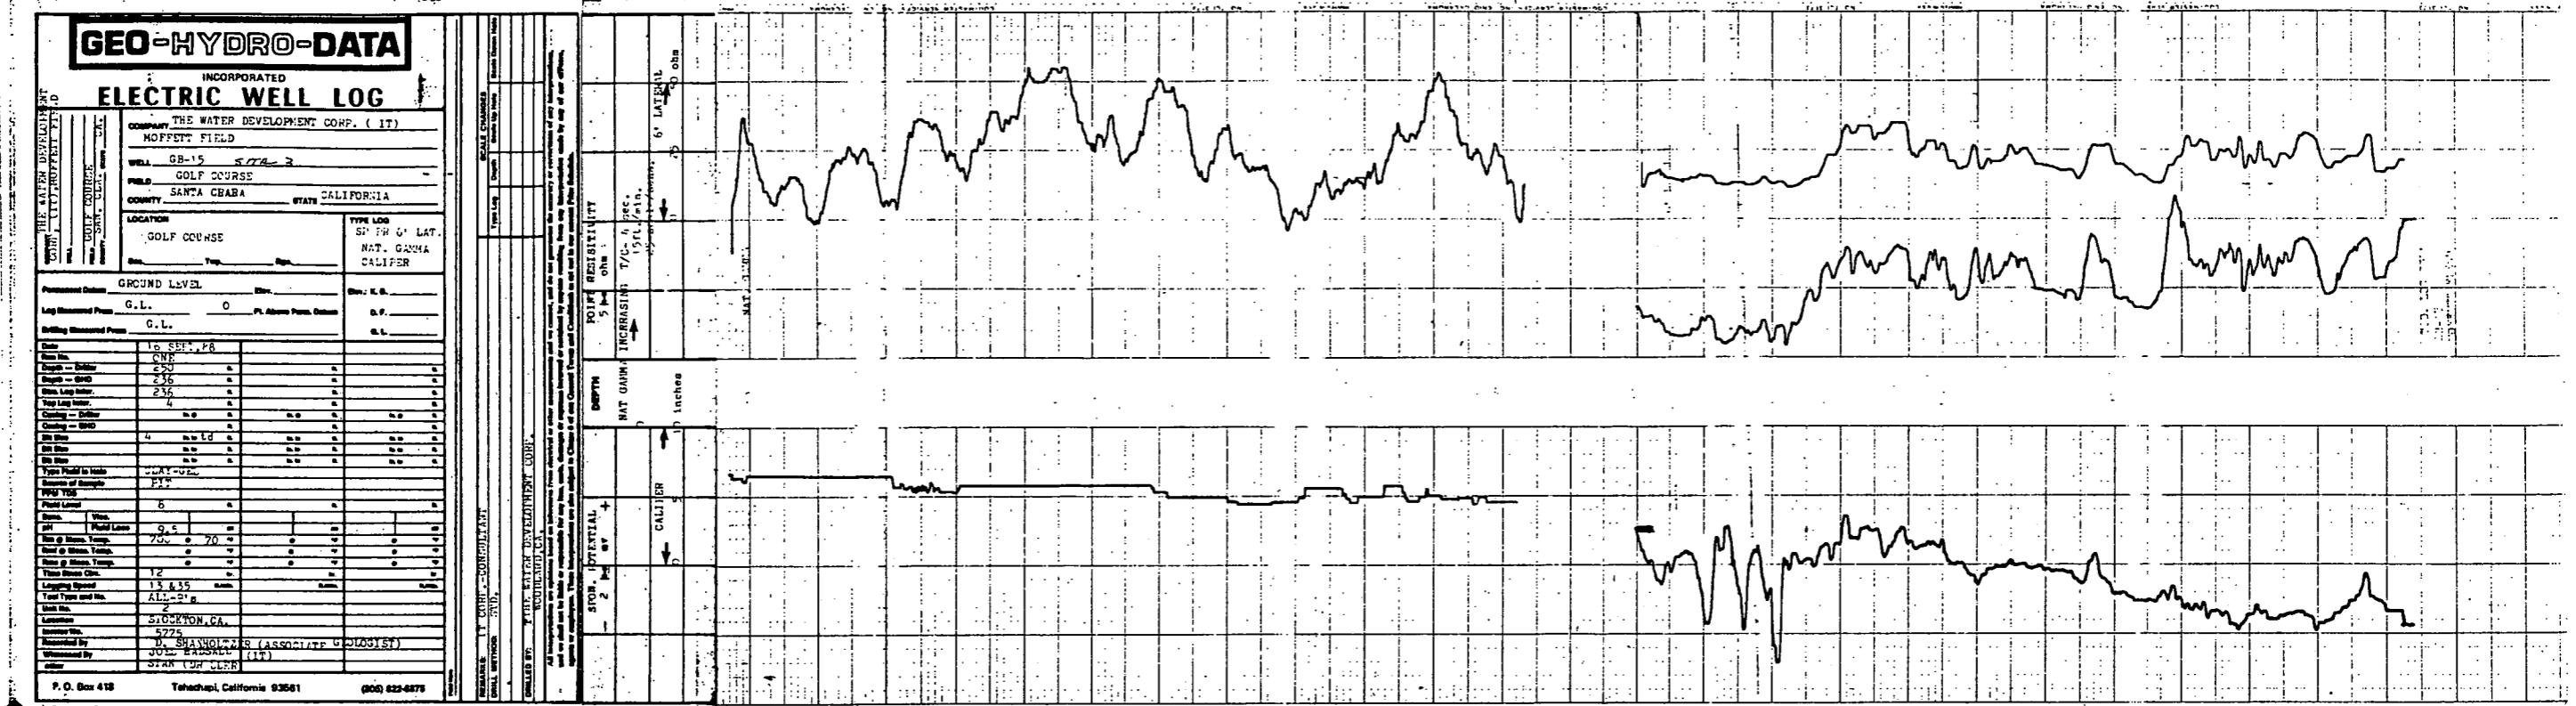


GEO-HYDRO-DATA

INCORPORATED
ELECTRIC WELL LOG

COMPANY		WATER DEVELOPMENT CORPORATION		
WELL	GE-16	SITE	3	
LOCATION		TYPE LOG		
G.L.		ft. Above Pene. Datum	G.P.	
Log Measured From		G.L.	G.L.	
Drilling Measured From		G.L.	G.L.	
Date	8-10-68			
Perf No.	one	1-0		
Depth - Drill	557	ft.		
Depth - SHD	551	ft.		
Shd. Log Interv.	254	ft.		
Top Log Interv.	12	ft.		
Drilling - Driller	W.G.	ft.	W.G.	ft.
Drilling - H.D.		ft.		ft.
Drill Bits	3	in.	2 1/2	in.
Bit Size	in.	in.	in.	in.
Bit Size	in.	in.	in.	in.
Type Field In Hole	CLAY-FO			
Source of Sample	pit			
PPM TDS	780			
Field Level	full			
Down.	West.			
pH	Field Lens	7.80		
At & Below Temp.		°		
At & Below Temp.		°		
Through Casing	1	ft.		
Logging Speed	50	ft/min.	10	sec/ft
Tool Type and Size	combo 5		Carrie 1	Reeliper 1
Tool No.	5			
Location	Santa Mtn.			
Location No.	5509			
Recovered By	Jim Bat., Associate Geologist			
Recovered By	Jogl Madson, M.T. Corp.			
other				

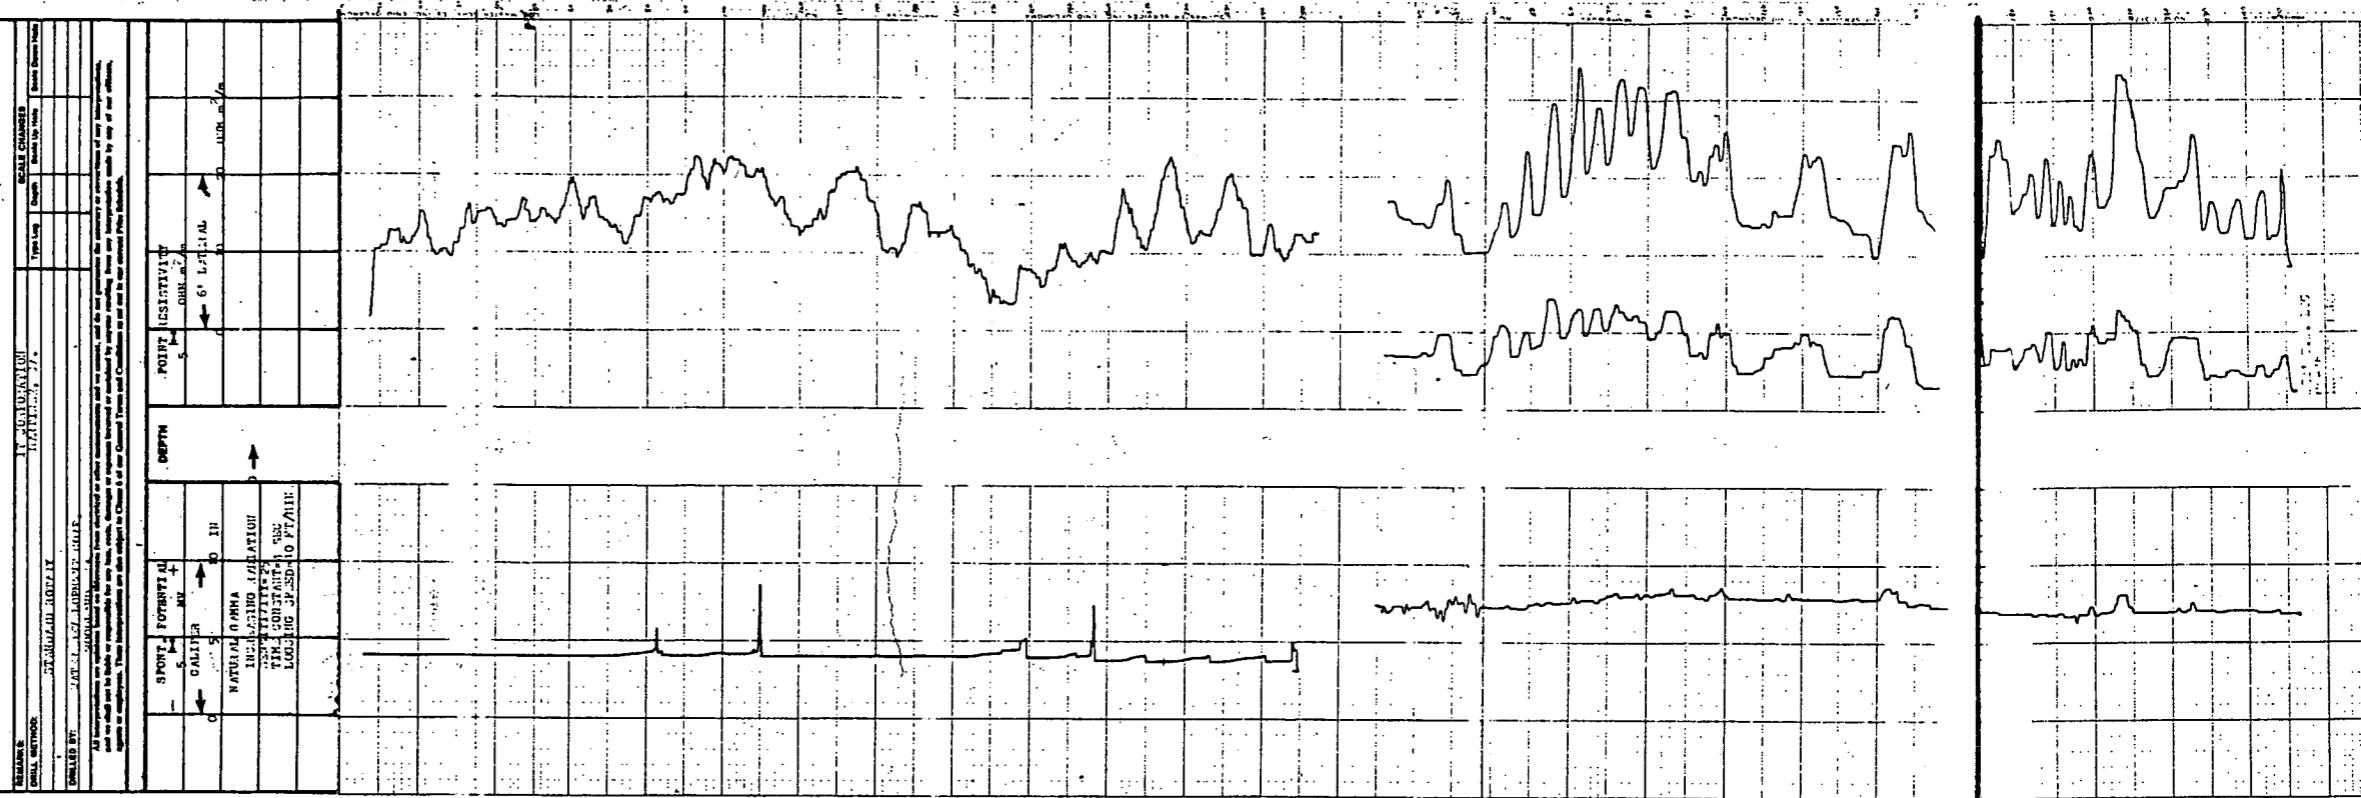

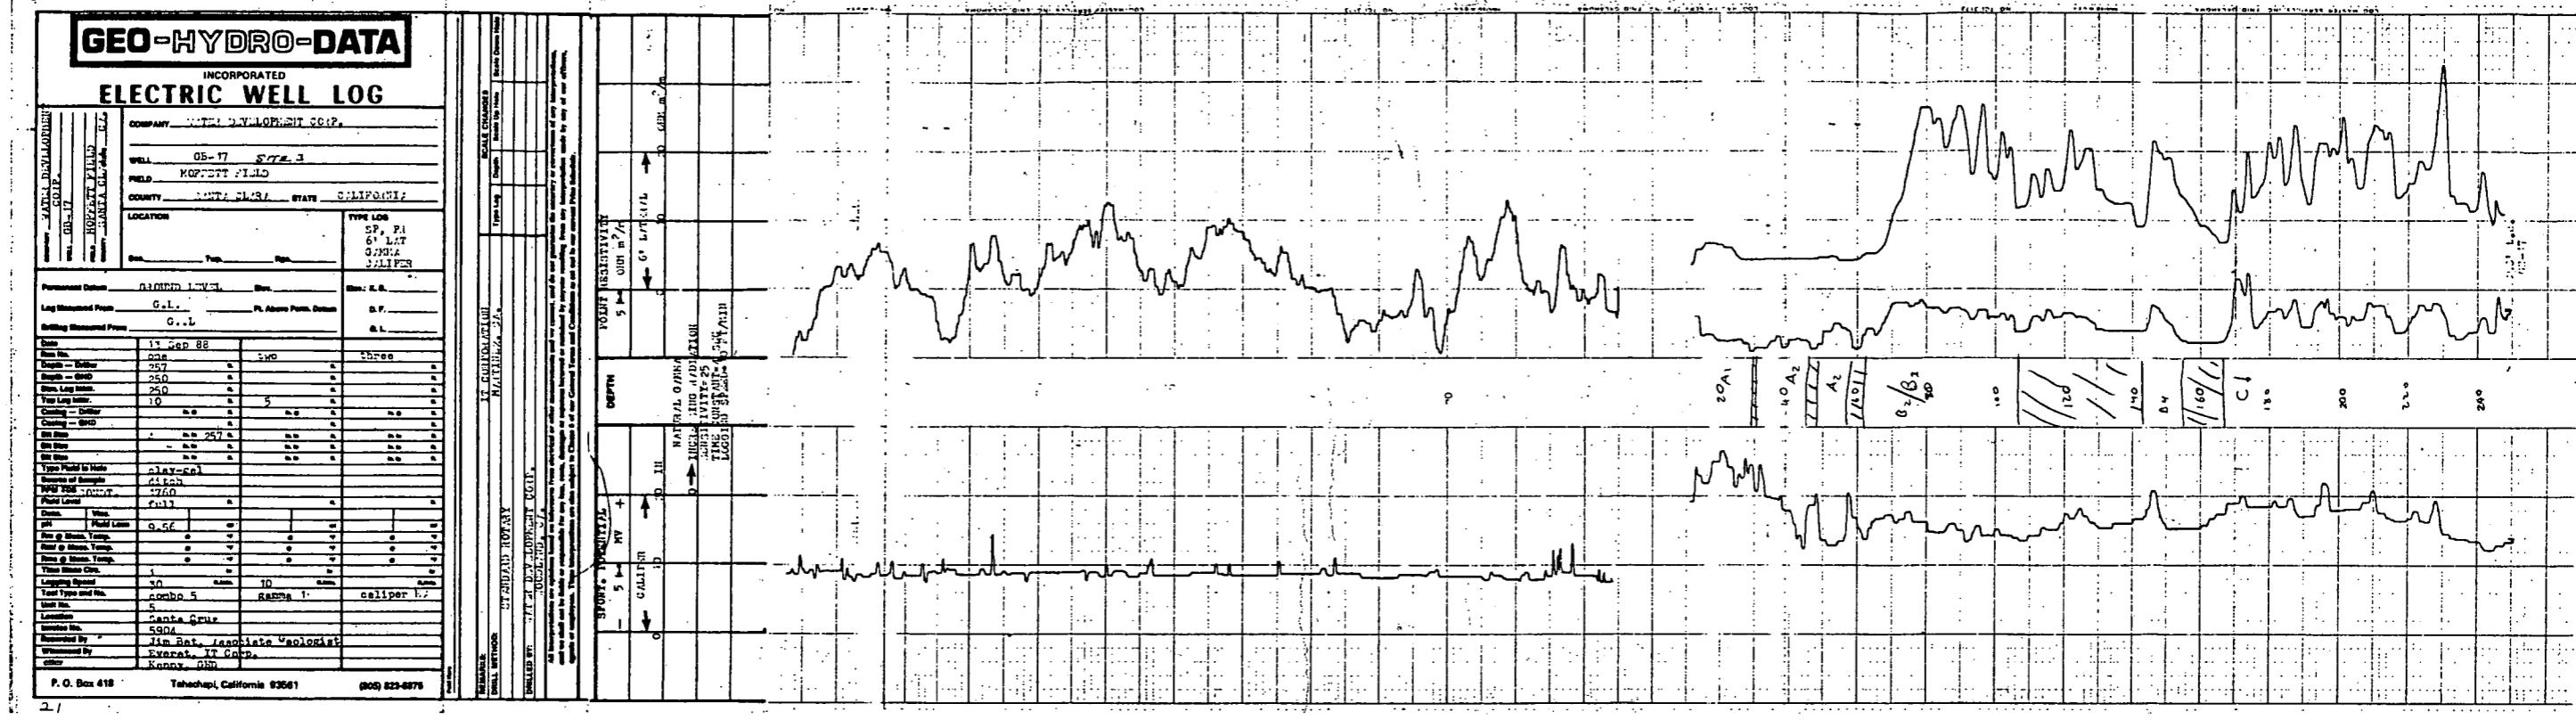

N00296.001452
MOFFETT FIELD
SSIC NO. 5090.3

**APPENDIX C – BORING LOGS
GEOPHYSICAL LOGS**

SITE 4


**REMEDIAL INVESTIGATION REPORT
OPERABLE UNIT 4: WEST SIDE AQUIFERS**

DATED 01 AUGUST 1992

GEO-HYDRO-DATA

INCORPORATED
TRIC WELL 100

ELECTRIC WELL LOG

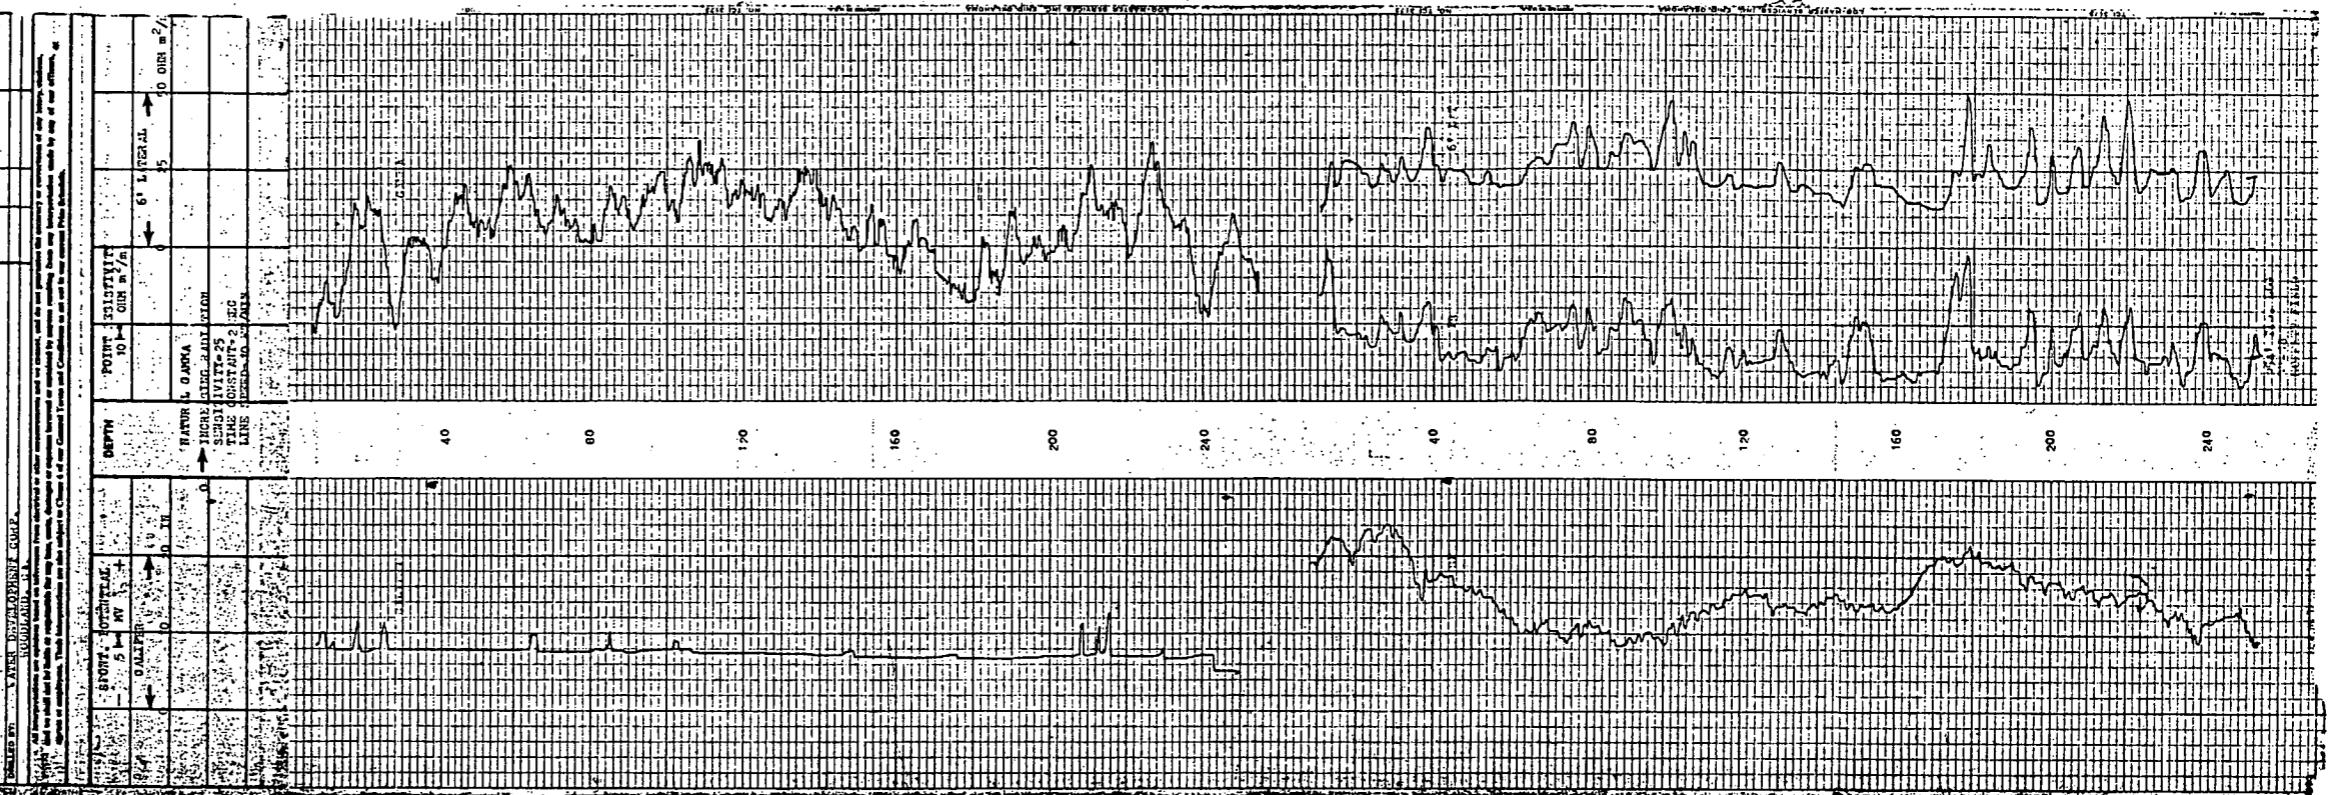


GEO-HYDRO-DATA

INCORPORATED

ELECTRIC WELL LOG

COMPANY		WATER DEVELOPMENT CORPORATION		
WELL NO.	GR-19	SITES 4		
COUNTY	SANTA CLARA	STATE	CALIFORNIA	
LOCATION				
Sec.	Top.	Rgt.		
Permanent Grade	GROUNDS LEVEL		Elev.:	
Log Measured Press	G.L.	Pt. Above Press. Datum		
Drilling Measured Press	G.L.	G.L.		
Date	26 Sep 68			
Test No.	one			
Test Type -- Driller	Twin			
Depth -- GRAD	250	ft.		
Shank Log Inter.	24.8	in.		
Top Log Inter.	10	in.		
Coating -- Driller	0.0	in.		
Coating -- GRAD	0	in.		
SH Size	A	257		
SH Size	N	in.		
SH Size	N	in.		
SH Size	N	in.		
Type Fluid in Hole	clay-sal			
Source of Sample	bit			
PPM TDS (GROUT)	874			
Poss Leve	full			
Date	Vern.			
Flow Rate	Flow Loss			
Flow @ Head, Temp.	Q. 34	-		
Flow @ Head, Temp.	0	-		
Flow @ Head, Temp.	0	-		
Flow @ Head, Temp.	0	-		
Time Since C.R.	1	hr.		
Logging Started	30	min.		
Test Type and No.	omega 5	10 min.		
Unit No.	5	gamma 1		
Location	Santa Cruz			
Institute No.	5814			
Reported By	Jim Rat. Associate Geologist			
Witnessed By	Joel Kedwell, IT Corp.			
other				

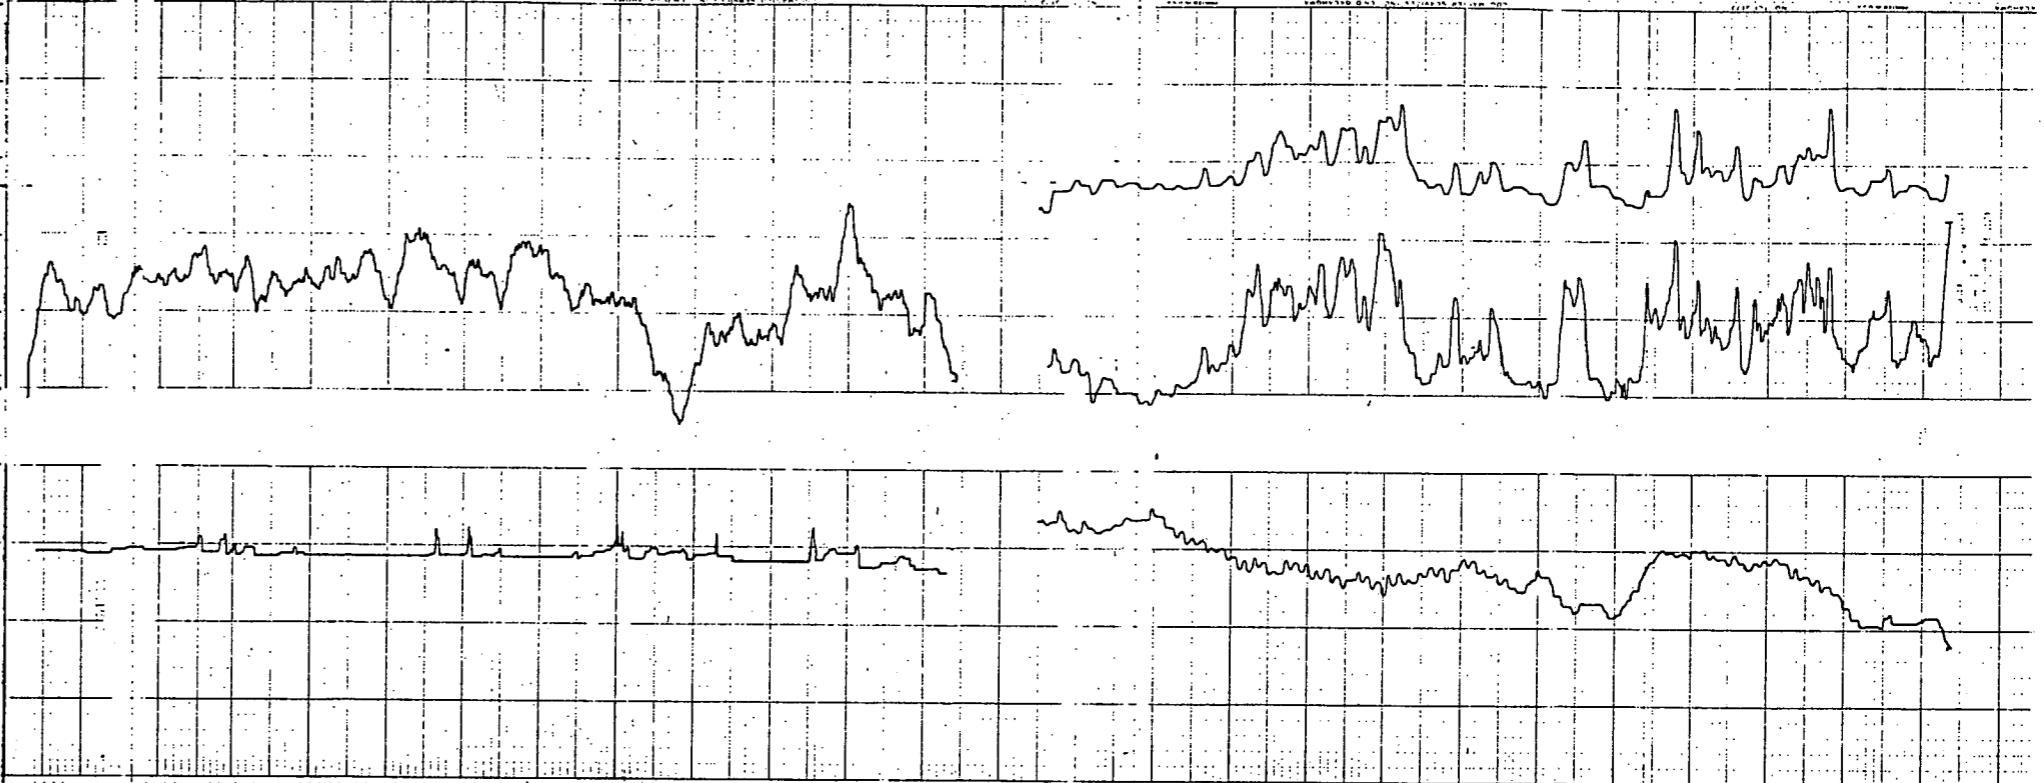

GEO-HYDRO-DATA

INCORPORATED
ELECTRIC WELL LOG

NAME DRAFTER CONFIRMED BY DATE	COMPANY		WATER DEVELOPMENT BOARD, CALIFORNIA		
	WELL	GS-20	SITE	4	
	FIELD	HOPELT FIELD			
	COUNTY	SANTA CLARA		STATE	CALIFORNIA
	LOCATION				TYPE LOG
					6' - 14'
					6' - 18'
					GAMA
					CALIFER
GROUND LEVEL		Date		Draw No.	
Log Measured From		G.L.		PL Above Perv. Datum	
Drill Measured From		G.L.		G.L.	
Date	6 Oct 88				
Run No.	one		100		
Depth -- Driller	267		ft.		
Depth -- GAMA	254		ft.		
Run Log Interv.	254		ft.		
Top Log Interv.	10		ft.		
Check -- Driller	0.0		0.0		
Check -- GAMA	0.0		0.0		
PL Interv.	4		m to 257.0		
PL Interv.	4		m to 257.0		
PL Interv.	4		m to 257.0		
PL Interv.	4		m to 257.0		
Type Field in Hole	Clay-Sol				
Source of Samples	ditch				
WATER TEST CONSTA.	A33				
Field Level	full				
Draw	1		Wells		
PL	5.76		Perv. Datum		
Run & Draw Temp.	50		°C		
Temp & Draw Pressure	0		PSI		
Water Temp. Draw	50		°C		
Loggers Serial	30		Serial		
Log Type and No.	gamma 5		Gamma 1		
Shut Off	50		Caliper 3		
Location	Santa Clara				
Run No.	5824				
Measured By	Jim Betz - Associate Geologist				
Witnessed By	Everett Weinger - VT Corp.				
Entered By					


N00296.001452
MOFFETT FIELD
SSIC NO. 5090.3

**APPENDIX C – BORING LOGS
GEOPHYSICAL LOGS**


SITE 5


**REMEDIAL INVESTIGATION REPORT
OPERABLE UNIT 4: WEST SIDE AQUIFERS**

DATED 01 AUGUST 1992

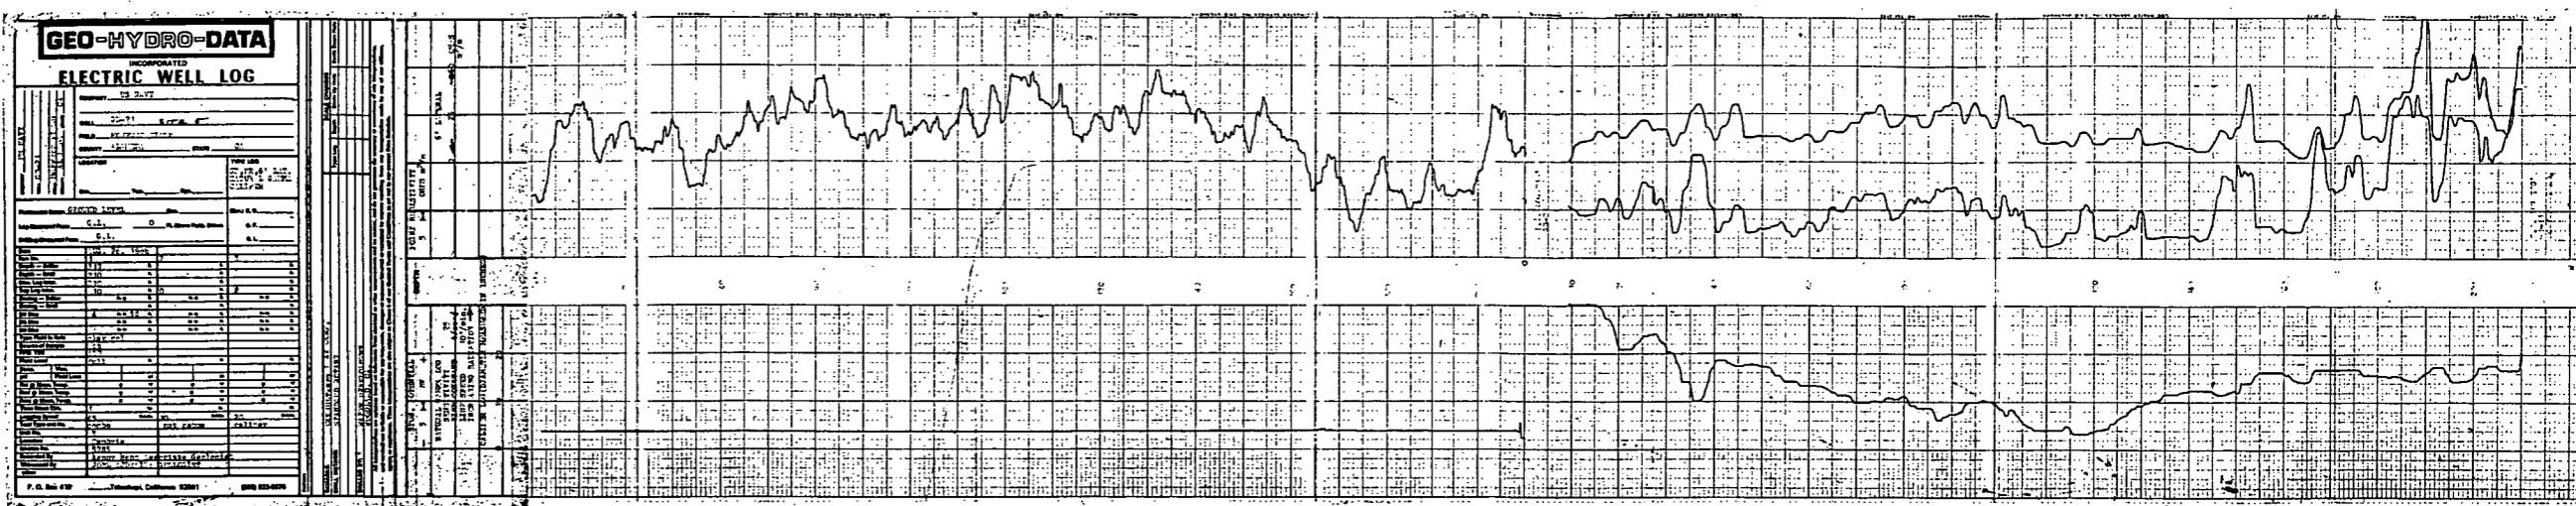

GEO-HYDRO-DATA		INCORPORATED	
ELECTRIC WELL LOG			
LOCATION		TYPE LOG CF, FR CA, LST GJM, P CALIF. I	
Ground Level		Elev. S. N.	
Log Shaded Press G.L.		P. Above Press, Datum D.F.	
Drilling Measured Press G.L.		G.L.	
Date	5-3-11 85		
Res No.	000	Time	
Depth - Drill	228	ft.	
Depth - GHD	238	m.	
Res. Log Inter.	228	m.	
Top Log Inter.	10	5	
Drilling - Drill	no	no	
Core - GHD	1	1	
Drill Bits	4	0.56	
Drill Bits	4	0.56	
Drill Bits	4	0.56	
Type Fluid in Hole	clean	m.	
Source of Sample	ditch		
PPM-PSL	24.5		
Fluid Level	221	m.	
Dens.	1.01		
pH	5.67		
Res. at Room Temp.	0	°F	
Res. at Room Temp.	0	°C	
Res. at Room Temp.	0	°F	
Res. at Room Temp.	0	°C	
Location Survey	30	ft.	
Total Depth and Res.	combo 5	gamma 5	
Depth to Res.	5	caliper 1	
Location	Santa Cruz		
Inventor No.	5705		
Measured By	Jim Bef. Geologic Geologist		
Witnessed By	Don Cox, P.G.C.P.		
Other			
P.O. Box 418	Tehachapi, California 93561	(805) 822-8875	

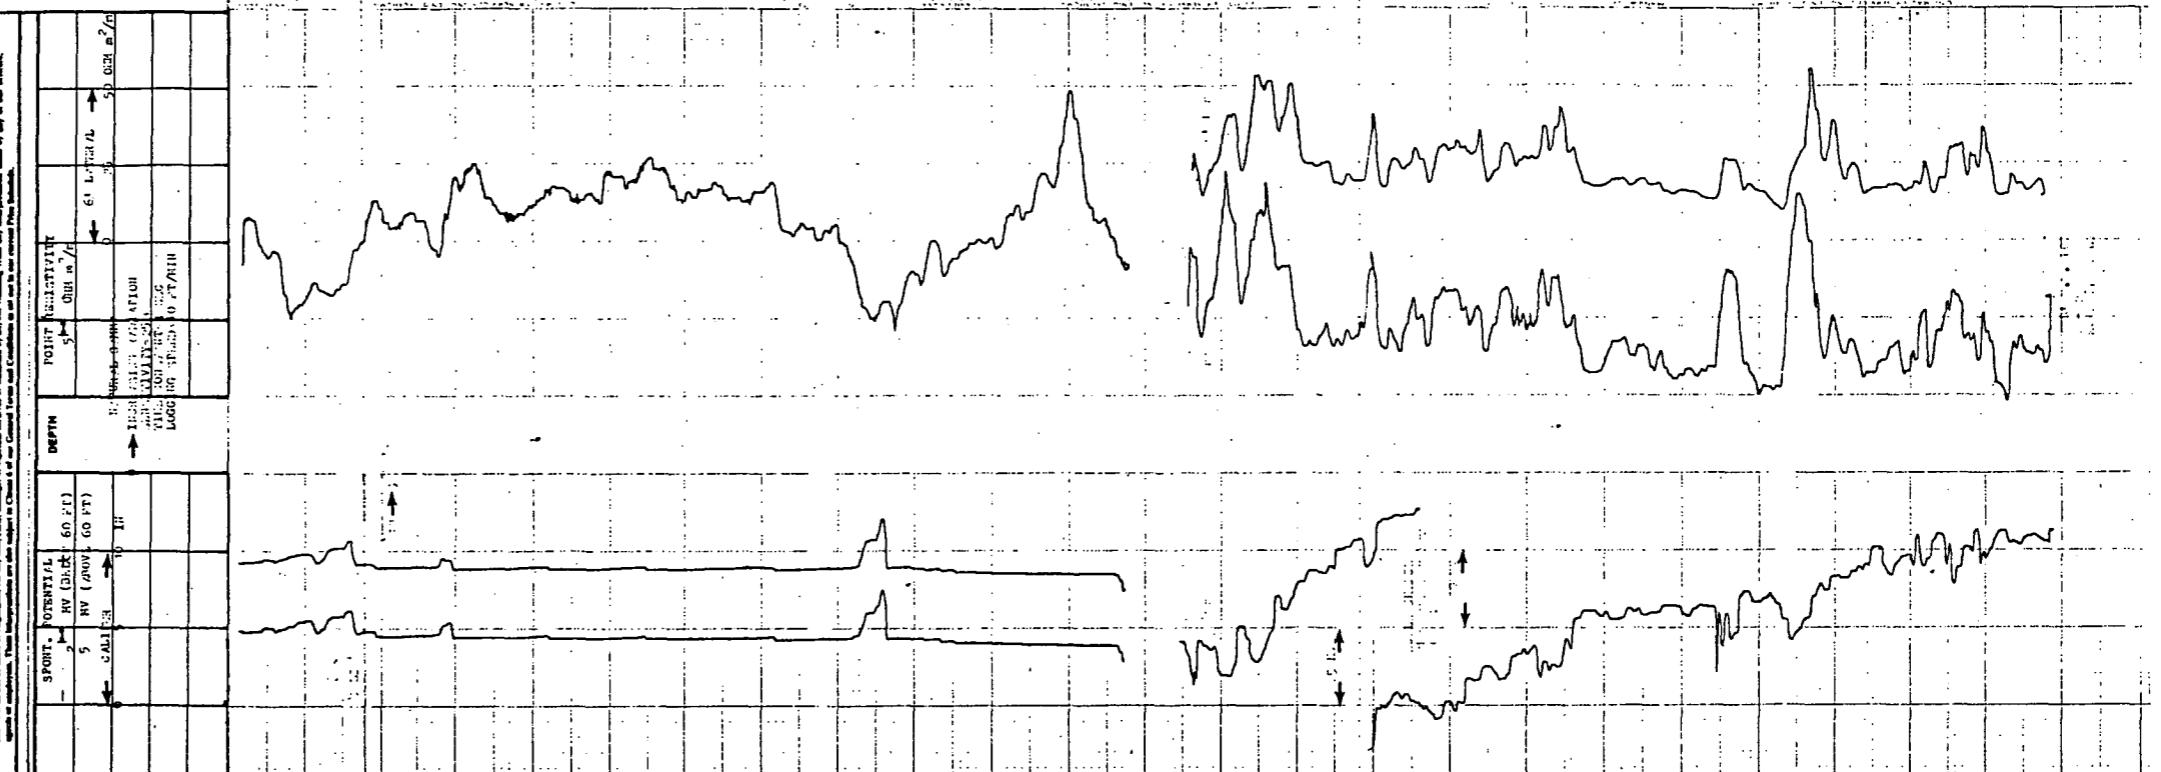

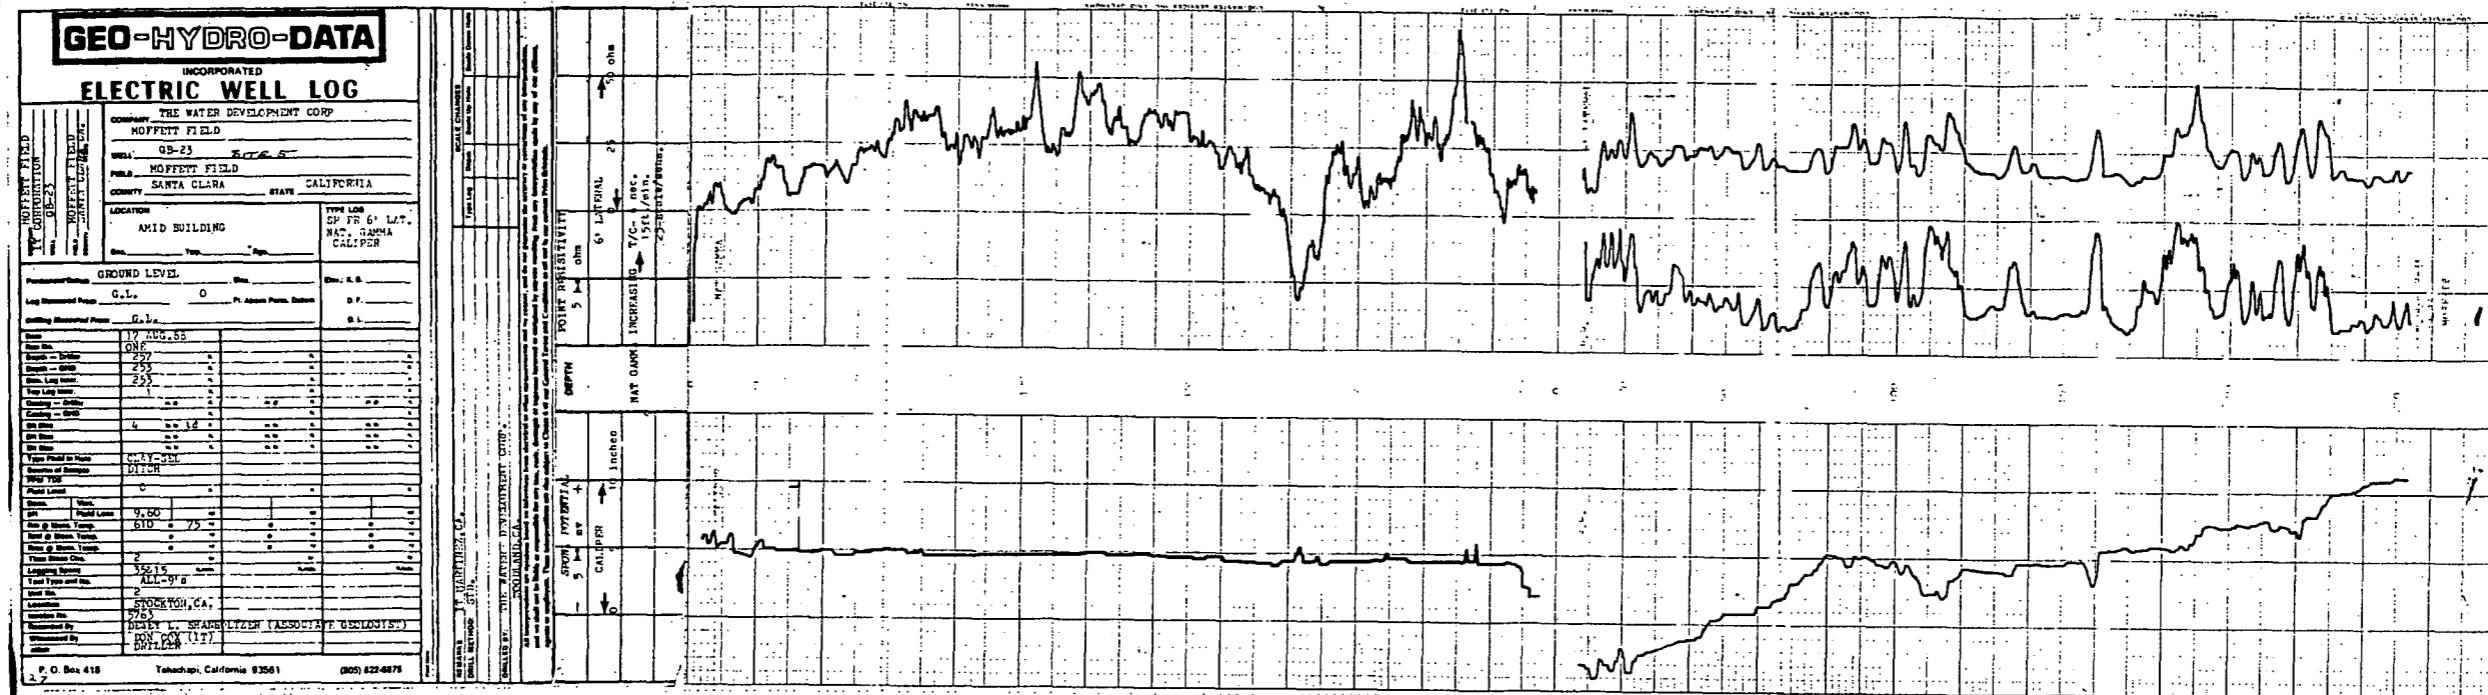

N00296.001452
MOFFETT FIELD
SSIC NO. 5090.3

**APPENDIX C – BORING LOGS
GEOPHYSICAL LOGS**

SITE 6

**REMEDIAL INVESTIGATION REPORT
OPERABLE UNIT 4: WEST SIDE AQUIFERS**

DATED 01 AUGUST 1992

NO GEOPHYSICAL LOGGING WAS CONDUCTED AT SITE 6


N00296.001452
MOFFETT FIELD
SSIC NO. 5090.3

**APPENDIX C – BORING LOGS
GEOPHYSICAL LOGS**

SITE 7

**REMEDIAL INVESTIGATION REPORT
OPERABLE UNIT 4: WEST SIDE AQUIFERS**

DATED 01 AUGUST 1992

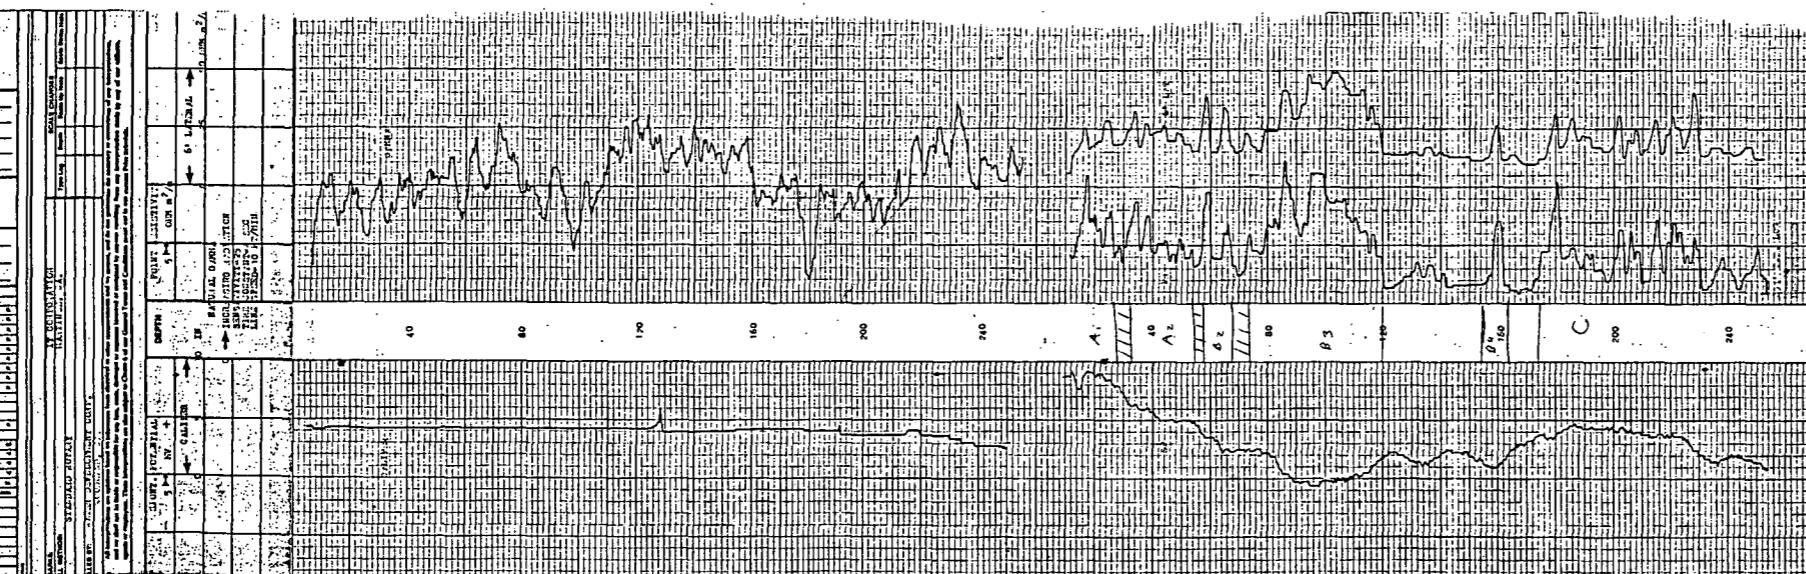


N00296.001452
MOFFETT FIELD
SSIC NO. 5090.3

**APPENDIX C – BORING LOGS
GEOPHYSICAL LOGS**

SITE 8

**REMEDIAL INVESTIGATION REPORT
OPERABLE UNIT 4: WEST SIDE AQUIFERS**

DATED 01 AUGUST 1992

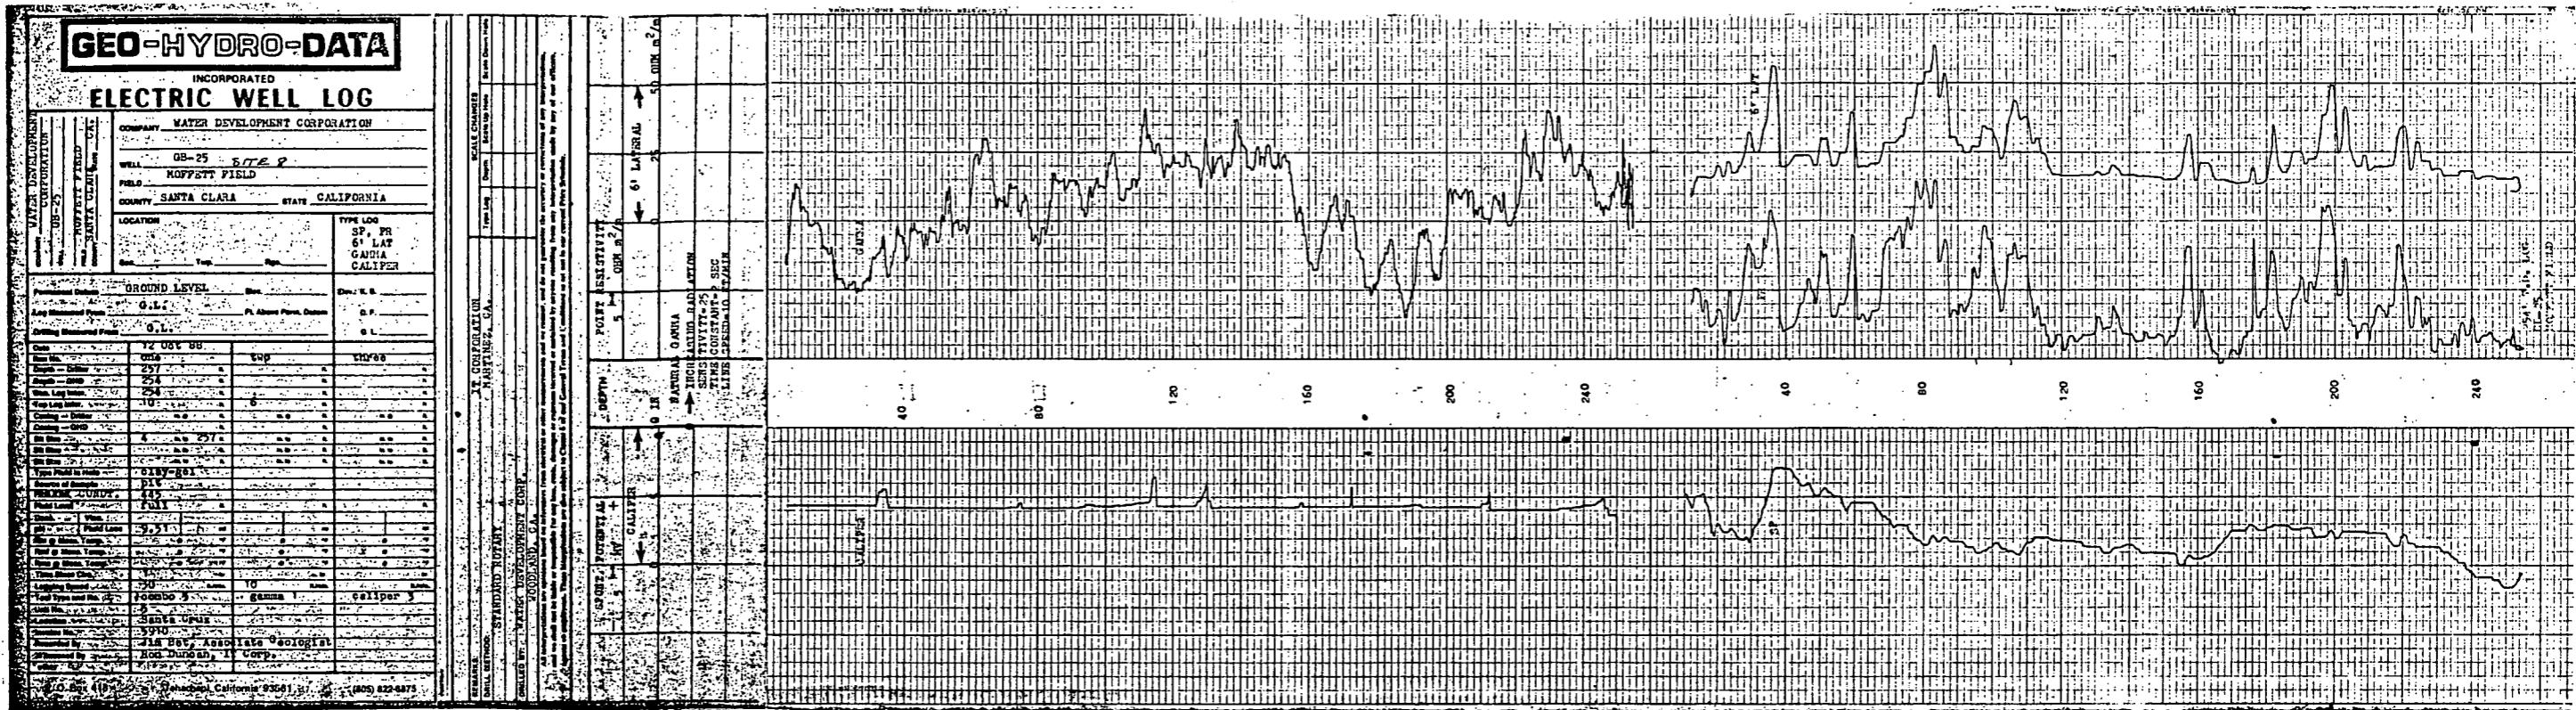

GEO-HYDRO-DATA

INCORPORATED

ELECTRIC WELL LOG

WATER DEVELOPMENT CORPORATION

SANTA CLARA COUNTY, CALIFORNIA
TYPE LOG: SP. PR.
S. LAT.
GAMA
CALIPER

GROUND LEVEL: 0.00 ft.

G.L.: 0.00 ft.








































N00296.001452
MOFFETT FIELD
SSIC NO. 5090.3


**APPENDIX C – BORING LOGS
GEOPHYSICAL LOGS**

SITE 9

**REMEDIAL INVESTIGATION REPORT
OPERABLE UNIT 4: WEST SIDE AQUIFERS**

DATED 01 AUGUST 1992

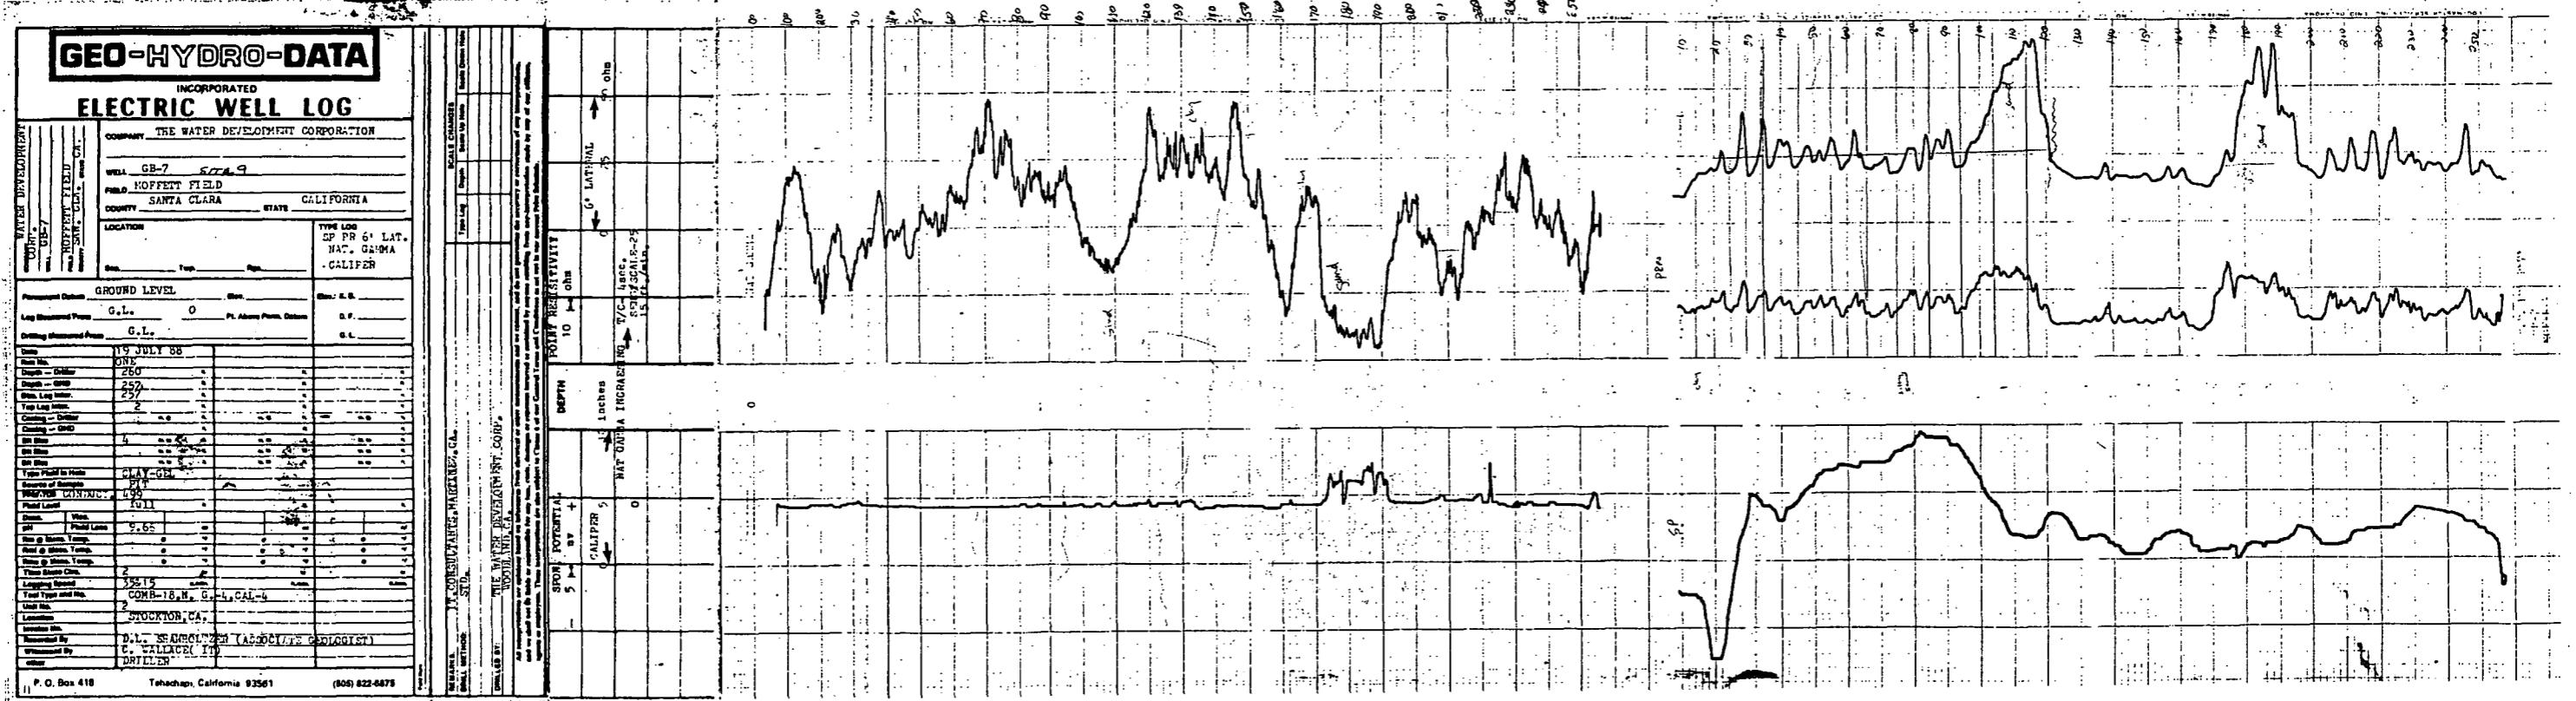

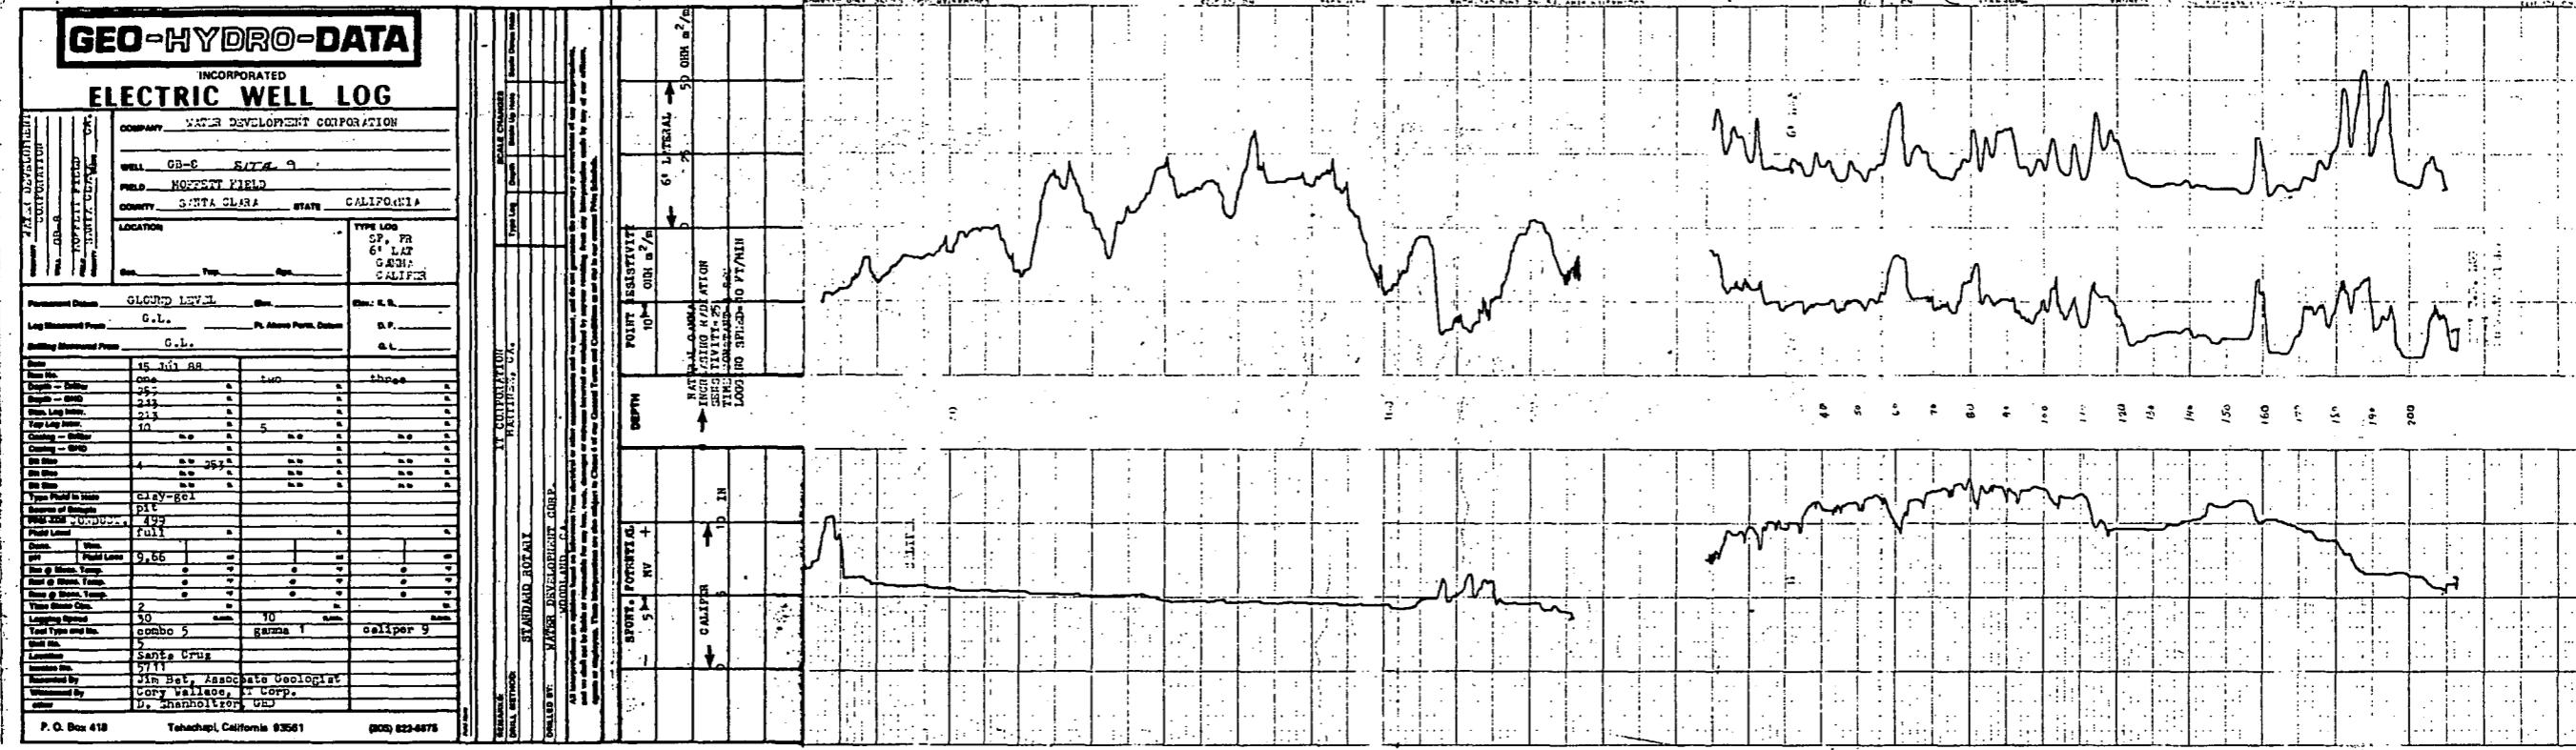


GEO-HYDRO-DATA

INCORPORATED

ELECTRIC WELL LOG

GROUNDS LEVEL		WELL		GROUNDS LEVEL		
Log Measured From		G.L.	Pl. Above Form. Datum		G.F.	
Drilling Measured From		G.L.			G.L.	
P. O. Box 418	Tehachapi, California 93561					(661) 822-

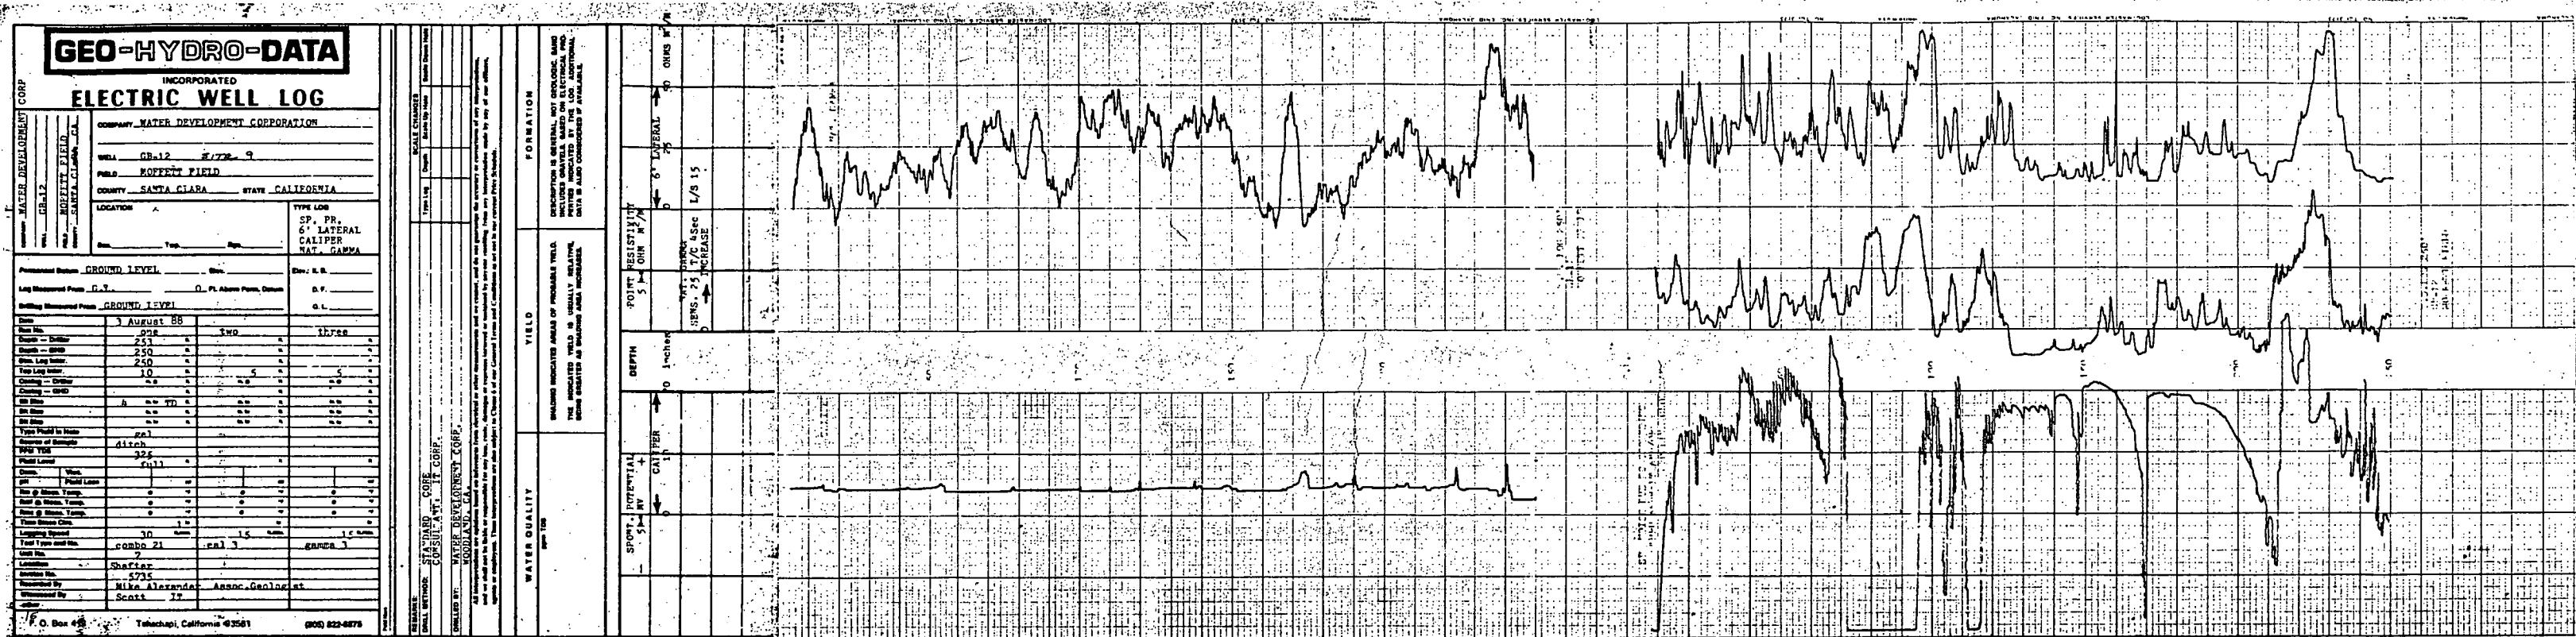


N00296.001452
MOFFETT FIELD
SSIC NO. 5090.3


**APPENDIX C – BORING LOGS
GEOPHYSICAL LOGS**

SITE 10

**REMEDIAL INVESTIGATION REPORT
OPERABLE UNIT 4: WEST SIDE AQUIFERS**

DATED 01 AUGUST 1992

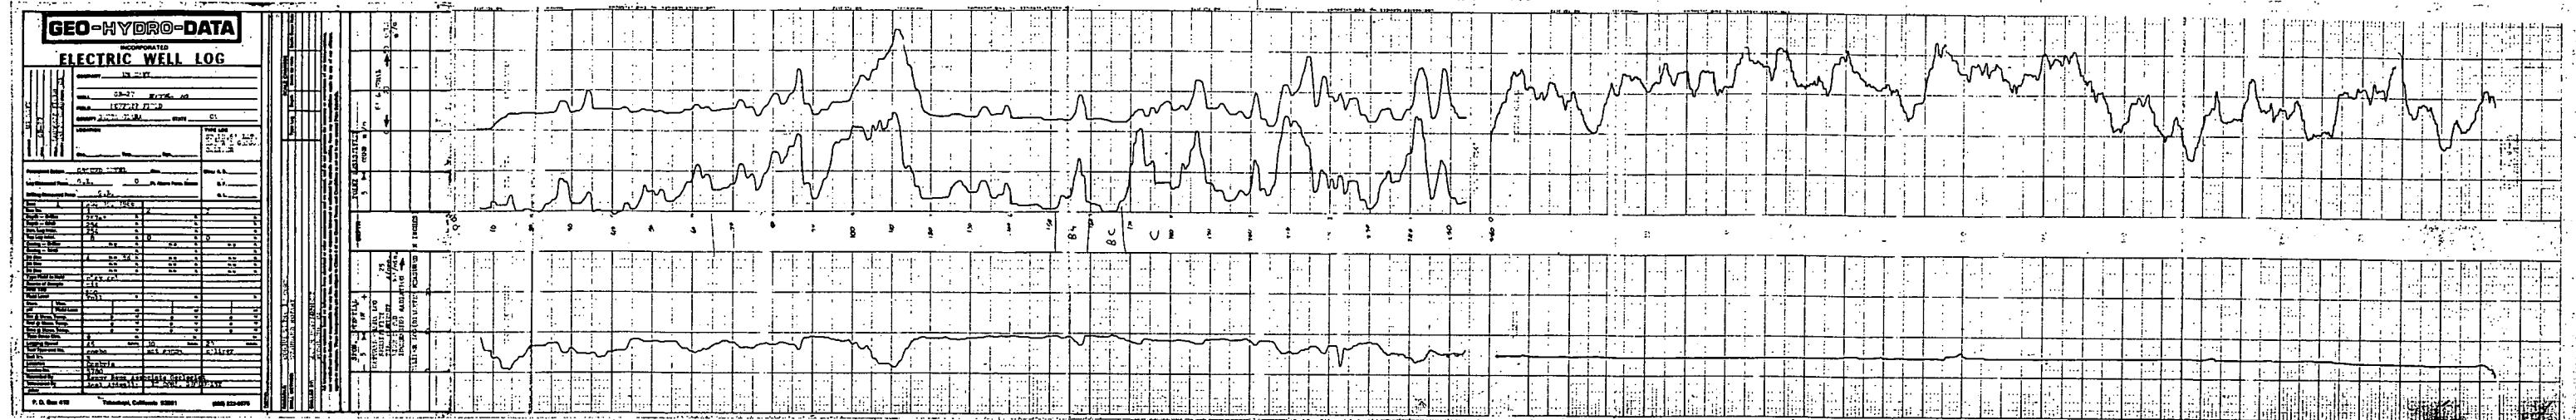

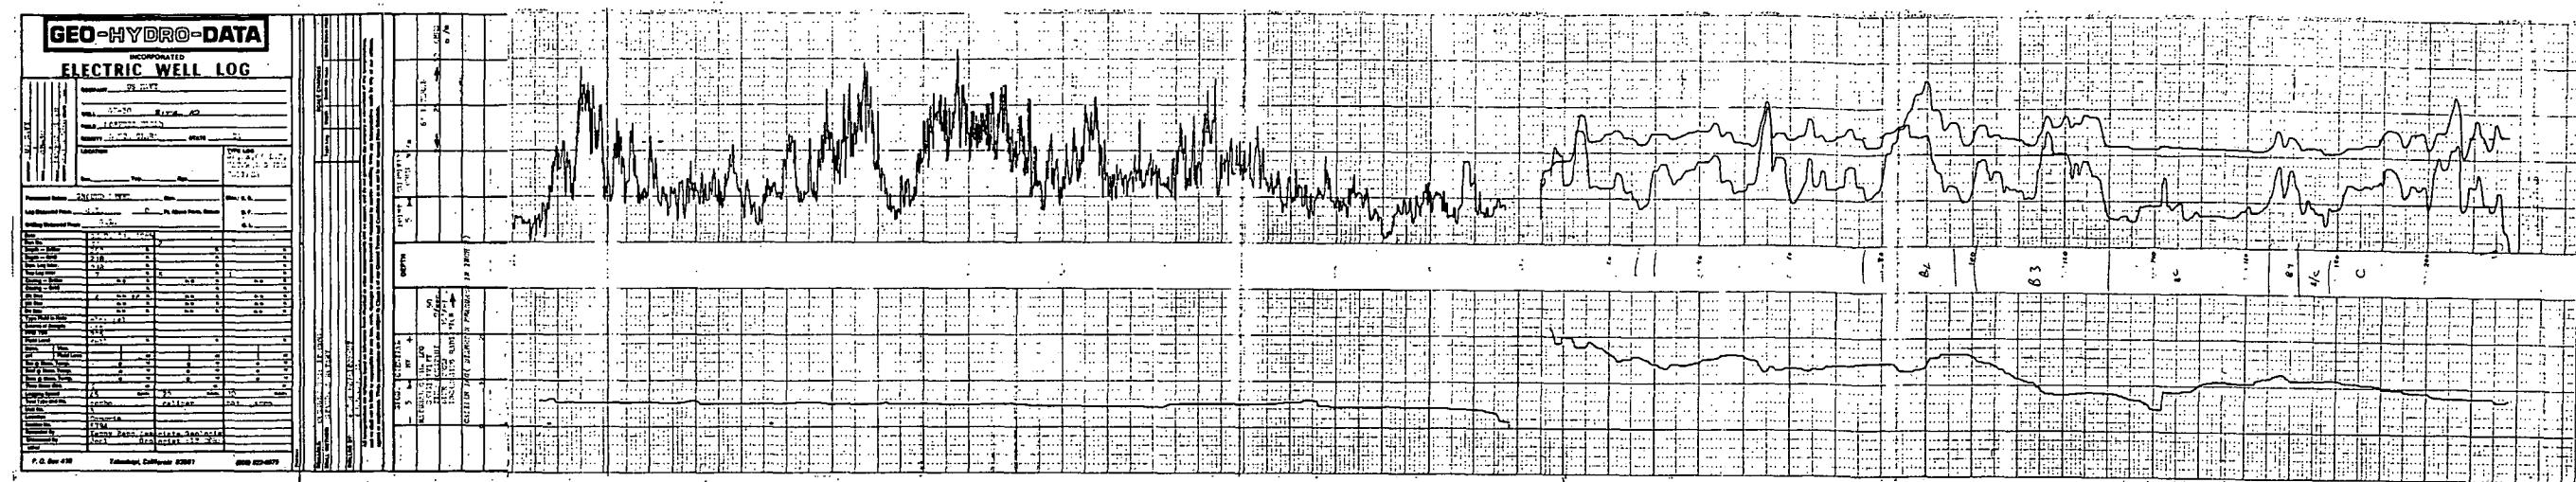

N00296.001452
MOFFETT FIELD
SSIC NO. 5090.3

**APPENDIX C – BORING LOGS
GEOPHYSICAL LOGS**

SITE 11

**REMEDIAL INVESTIGATION REPORT
OPERABLE UNIT 4: WEST SIDE AQUIFERS**

DATED 01 AUGUST 1992

NO GEOPHYSICAL LOGGING WAS CONDUCTED AT SITE 11

N00296.001452
MOFFETT FIELD
SSIC NO. 5090.3

**APPENDIX C – BORING LOGS
GEOPHYSICAL LOGS**

SITE 12

**REMEDIAL INVESTIGATION REPORT
OPERABLE UNIT 4: WEST SIDE AQUIFERS**

DATED 01 AUGUST 1992

NO GEOPHYSICAL LOGGING WAS CONDUCTED AT SITE 12

N00296.001452
MOFFETT FIELD
SSIC NO. 5090.3

**APPENDIX C – BORING LOGS
GEOPHYSICAL LOGS**

SITE 13

**REMEDIAL INVESTIGATION REPORT
OPERABLE UNIT 4: WEST SIDE AQUIFERS**

DATED 01 AUGUST 1992

NO GEOPHYSICAL LOGGING WAS CONDUCTED AT SITE 13

N00296.001452
MOFFETT FIELD
SSIC NO. 5090.3

**APPENDIX C – BORING LOGS
GEOPHYSICAL LOGS**

SITE 14


**REMEDIAL INVESTIGATION REPORT
OPERABLE UNIT 4: WEST SIDE AQUIFERS**

DATED 01 AUGUST 1992

GEO-HYDRO-DATA

INCORPORATED
ELECTRIC WELL LOG

WATER DEVELOPMENT CORPORATION	
WELL ID#	GS-28
FIELD	SITE 1A HOFFETT FIELD
COUNTY	SANTA CLARA
STATE	CALIFORNIA
LOCATION	
TYPE LOG	CP, PI E, LST G, H, P LIL, LCH
Top	
Bottom	
GROUND LEVEL	
Bottomed Depth	0.0
Log Measured From	G.L.
Pl. Above Pump. Datum	0.0
Bottomed From	G.L.
Drilling Measured From	G.L.
Date	9-14-88
Well No.	one
Depth - Drill	360
Depth - GHD	259
Min. Log Inter.	259
Top Log Inter.	10
Drilling - Drill	0.0
Drilling - GHD	0.0
Min. Int.	4
Max. Int.	0.0
Min. Diam.	0.0
Type Field in Hole	clay-sil
Source of Sample	pl
PWD FWD	CONDUIT
Field Level	full
Depth	1
pH	6.9
Rate of Flow, Temp.	0
Drill Bit Size	1
Logging Speed	30
Log Type and Min.	combo 5
Min. Int.	5
Location	Santa Cruz
Interval	5' to
Described By	SEPT LOGN, 12 LCH
Whitened By	CLAY, WATER DEVELOPMENT
Other	

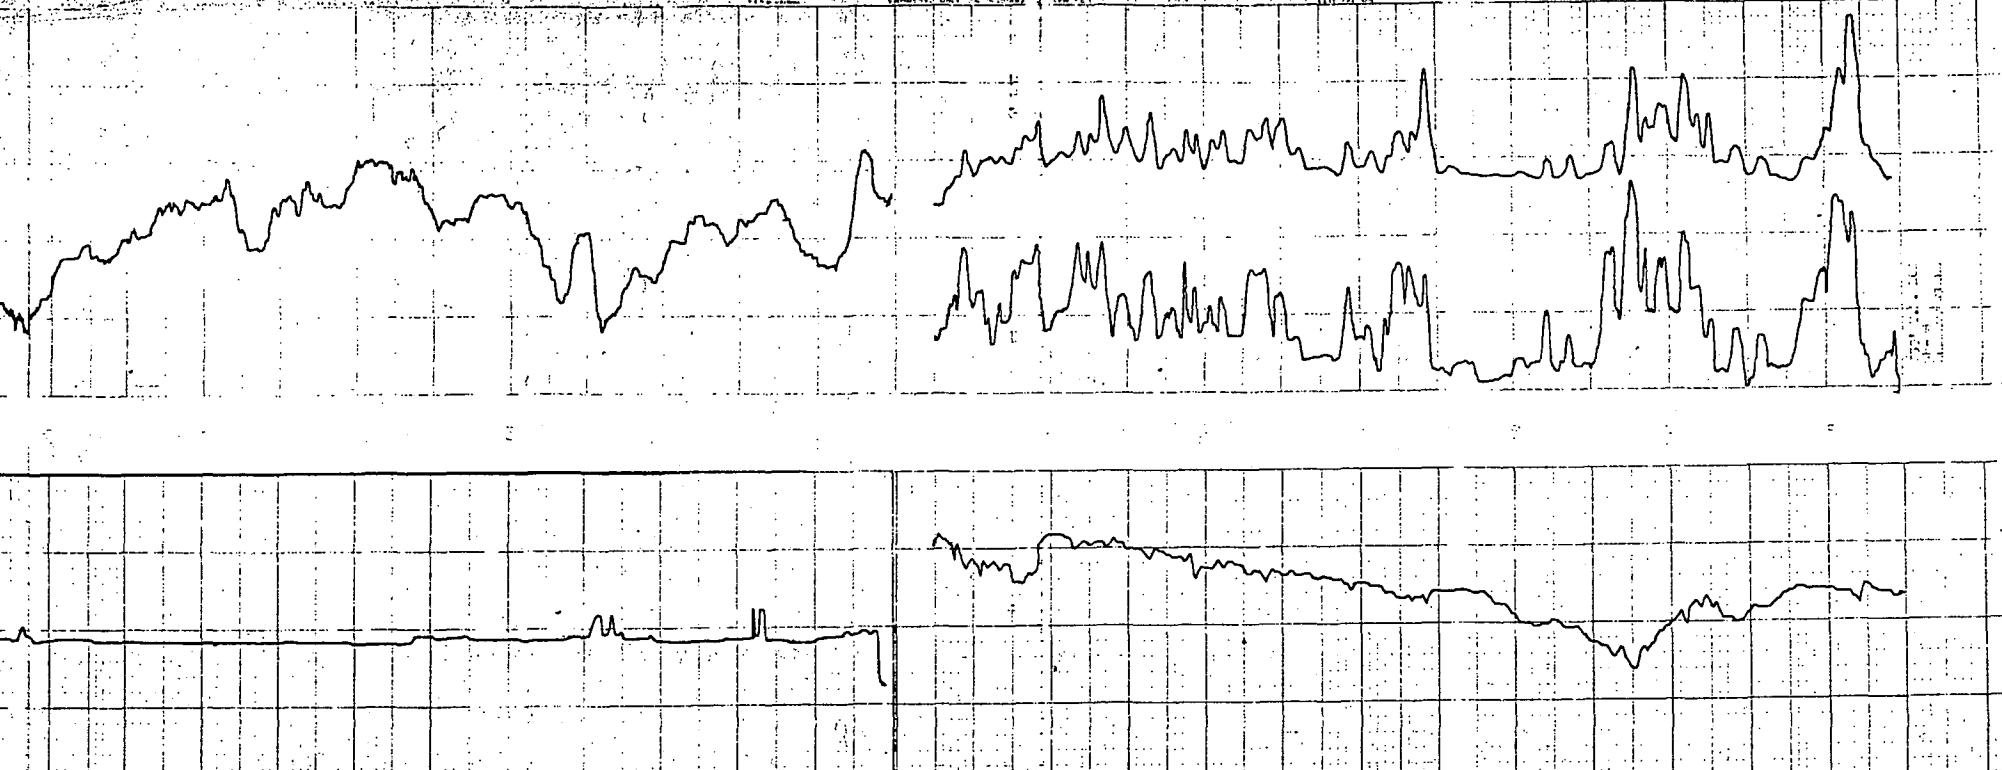

N00296.001452
MOFFETT FIELD
SSIC NO. 5090.3

**APPENDIX C – BORING LOGS
GEOPHYSICAL LOGS**

SITE 15

**REMEDIAL INVESTIGATION REPORT
OPERABLE UNIT 4: WEST SIDE AQUIFERS**

DATED 01 AUGUST 1992

NO GEOPHYSICAL LOGGING WAS CONDUCTED AT SITE 15

N00296.001452
MOFFETT FIELD
SSIC NO. 5090.3

**APPENDIX C – BORING LOGS
GEOPHYSICAL LOGS**

SITE 16

**REMEDIAL INVESTIGATION REPORT
OPERABLE UNIT 4: WEST SIDE AQUIFERS**

DATED 01 AUGUST 1992

NO GEOPHYSICAL LOGGING WAS CONDUCTED AT SITE 16

N00296.001452
MOFFETT FIELD
SSIC NO. 5090.3

**APPENDIX C – BORING LOGS
GEOPHYSICAL LOGS**

SITE 17

**REMEDIAL INVESTIGATION REPORT
OPERABLE UNIT 4: WEST SIDE AQUIFERS**

DATED 01 AUGUST 1992

NO GEOPHYSICAL LOGGING WAS CONDUCTED AT SITE 17

N00296.001452
MOFFETT FIELD
SSIC NO. 5090.3

**APPENDIX C – BORING LOGS
GEOPHYSICAL LOGS**

SITE 18

**REMEDIAL INVESTIGATION REPORT
OPERABLE UNIT 4: WEST SIDE AQUIFERS**

DATED 01 AUGUST 1992

NO GEOPHYSICAL LOGGING WAS CONDUCTED AT SITE 18

N00296.001452
MOFFETT FIELD
SSIC NO. 5090.3

**APPENDIX C – BORING LOGS
GEOPHYSICAL LOGS**

SITE 19

**REMEDIAL INVESTIGATION REPORT
OPERABLE UNIT 4: WEST SIDE AQUIFERS**

DATED 01 AUGUST 1992

